


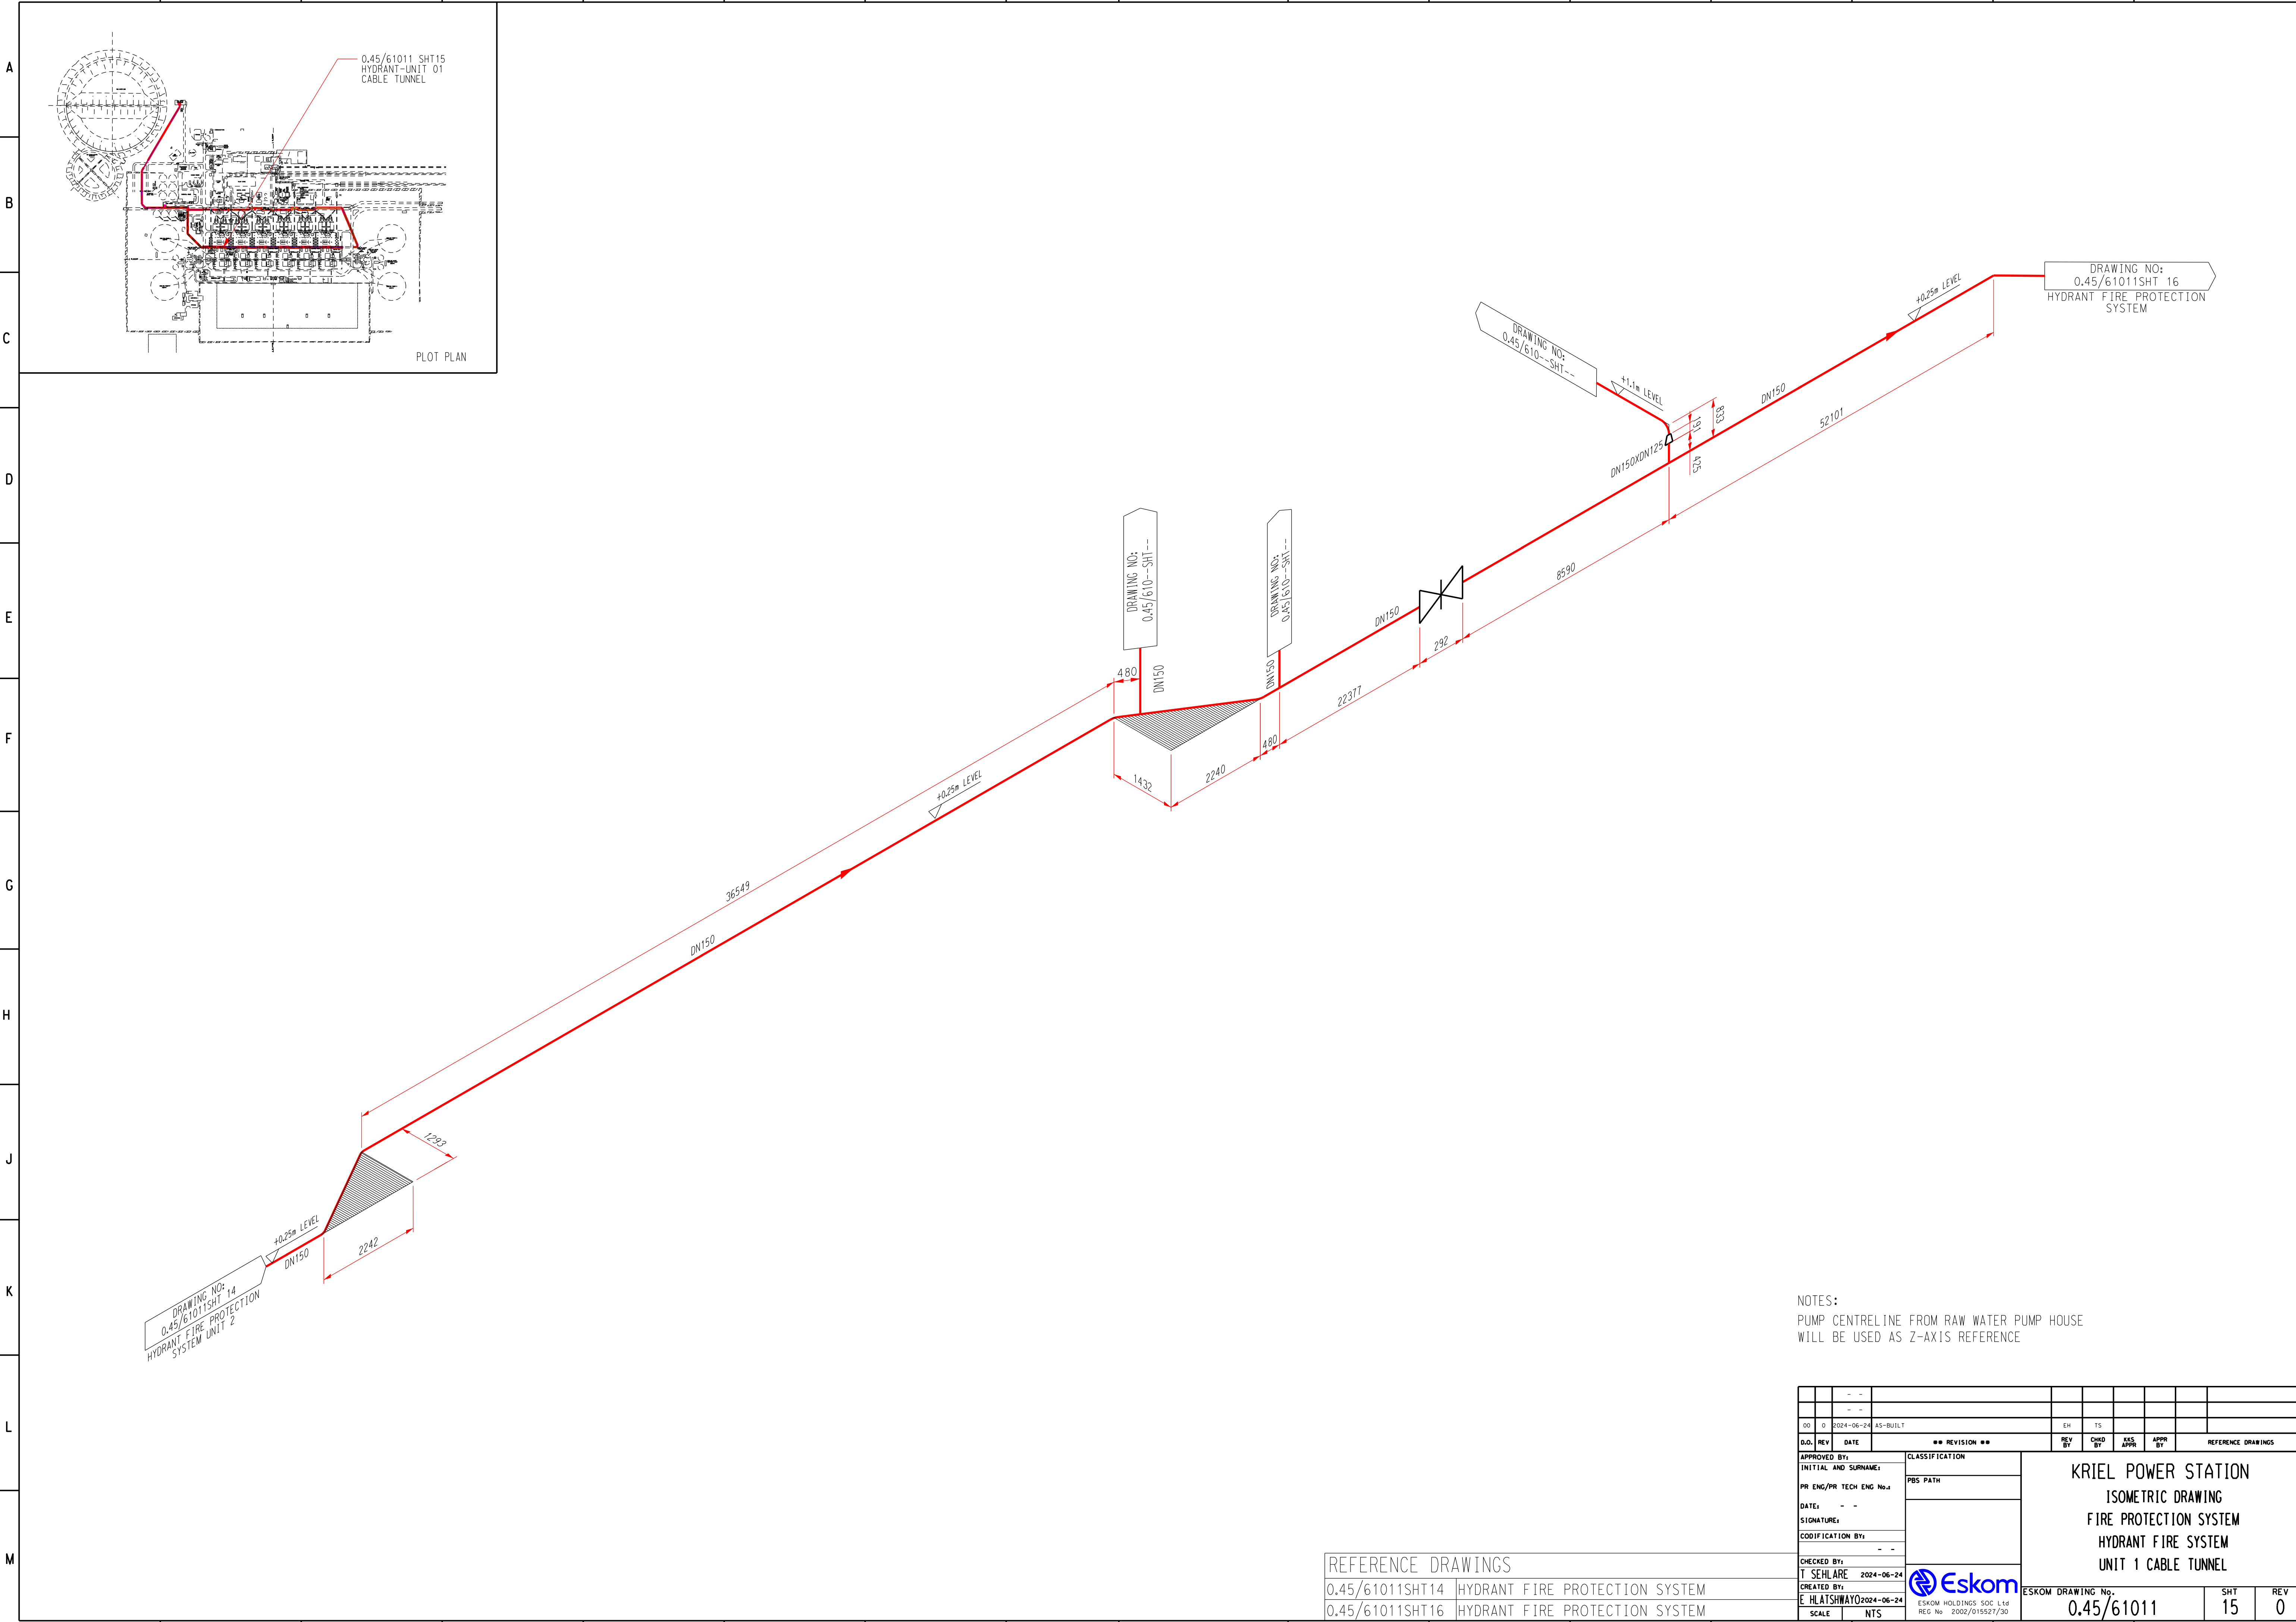

NOTES:
PUMP CENTRELINE FROM RAW WATER PUMP HOUSE
WILL BE USED AS Z-AXIS REFERENCE

REFERENCE DRAWINGS	
0.45/61011SHT14	HYDRANT FIRE PROTECTION SYSTEM
0.45/61011SHT16	HYDRANT FIRE PROTECTION SYSTEM

00		0	2024-06-24	AS-BUILT	EH	TS													
D.O.		REV	DATE	** REVISION **		REV BY	CHKD BY	ISS APPR	APPR BY	REFERENCE DRAWINGS									
APPROVED BY:				CLASSIFICATION		KRIEL POWER STATION ISOMETRIC DRAWING FIRE PROTECTION SYSTEM HYDRANT FIRE SYSTEM UNIT 1 CABLE TUNNEL ESKOM ESKOM HOLDINGS SOC. LTD REG No: 2002/015521/30 DRAWING No. 0.45/61011 SHT 15 REV 0													
INITIAL AND SURNAME:				PBS PATH															
PR. ENG/PR. TECH. ENG. No.:																			
DATE:				-															
SIGNATURE:																			
CODIFICATION BY:				-															
CHECKED BY:				T. SEHLARE		2024-06-24		 Eskom ESKOM HOLDING No. 0.45/61011											
CREATED BY:				E. HLATSHWAYO		2024-06-24													
SCALE				NTS															