


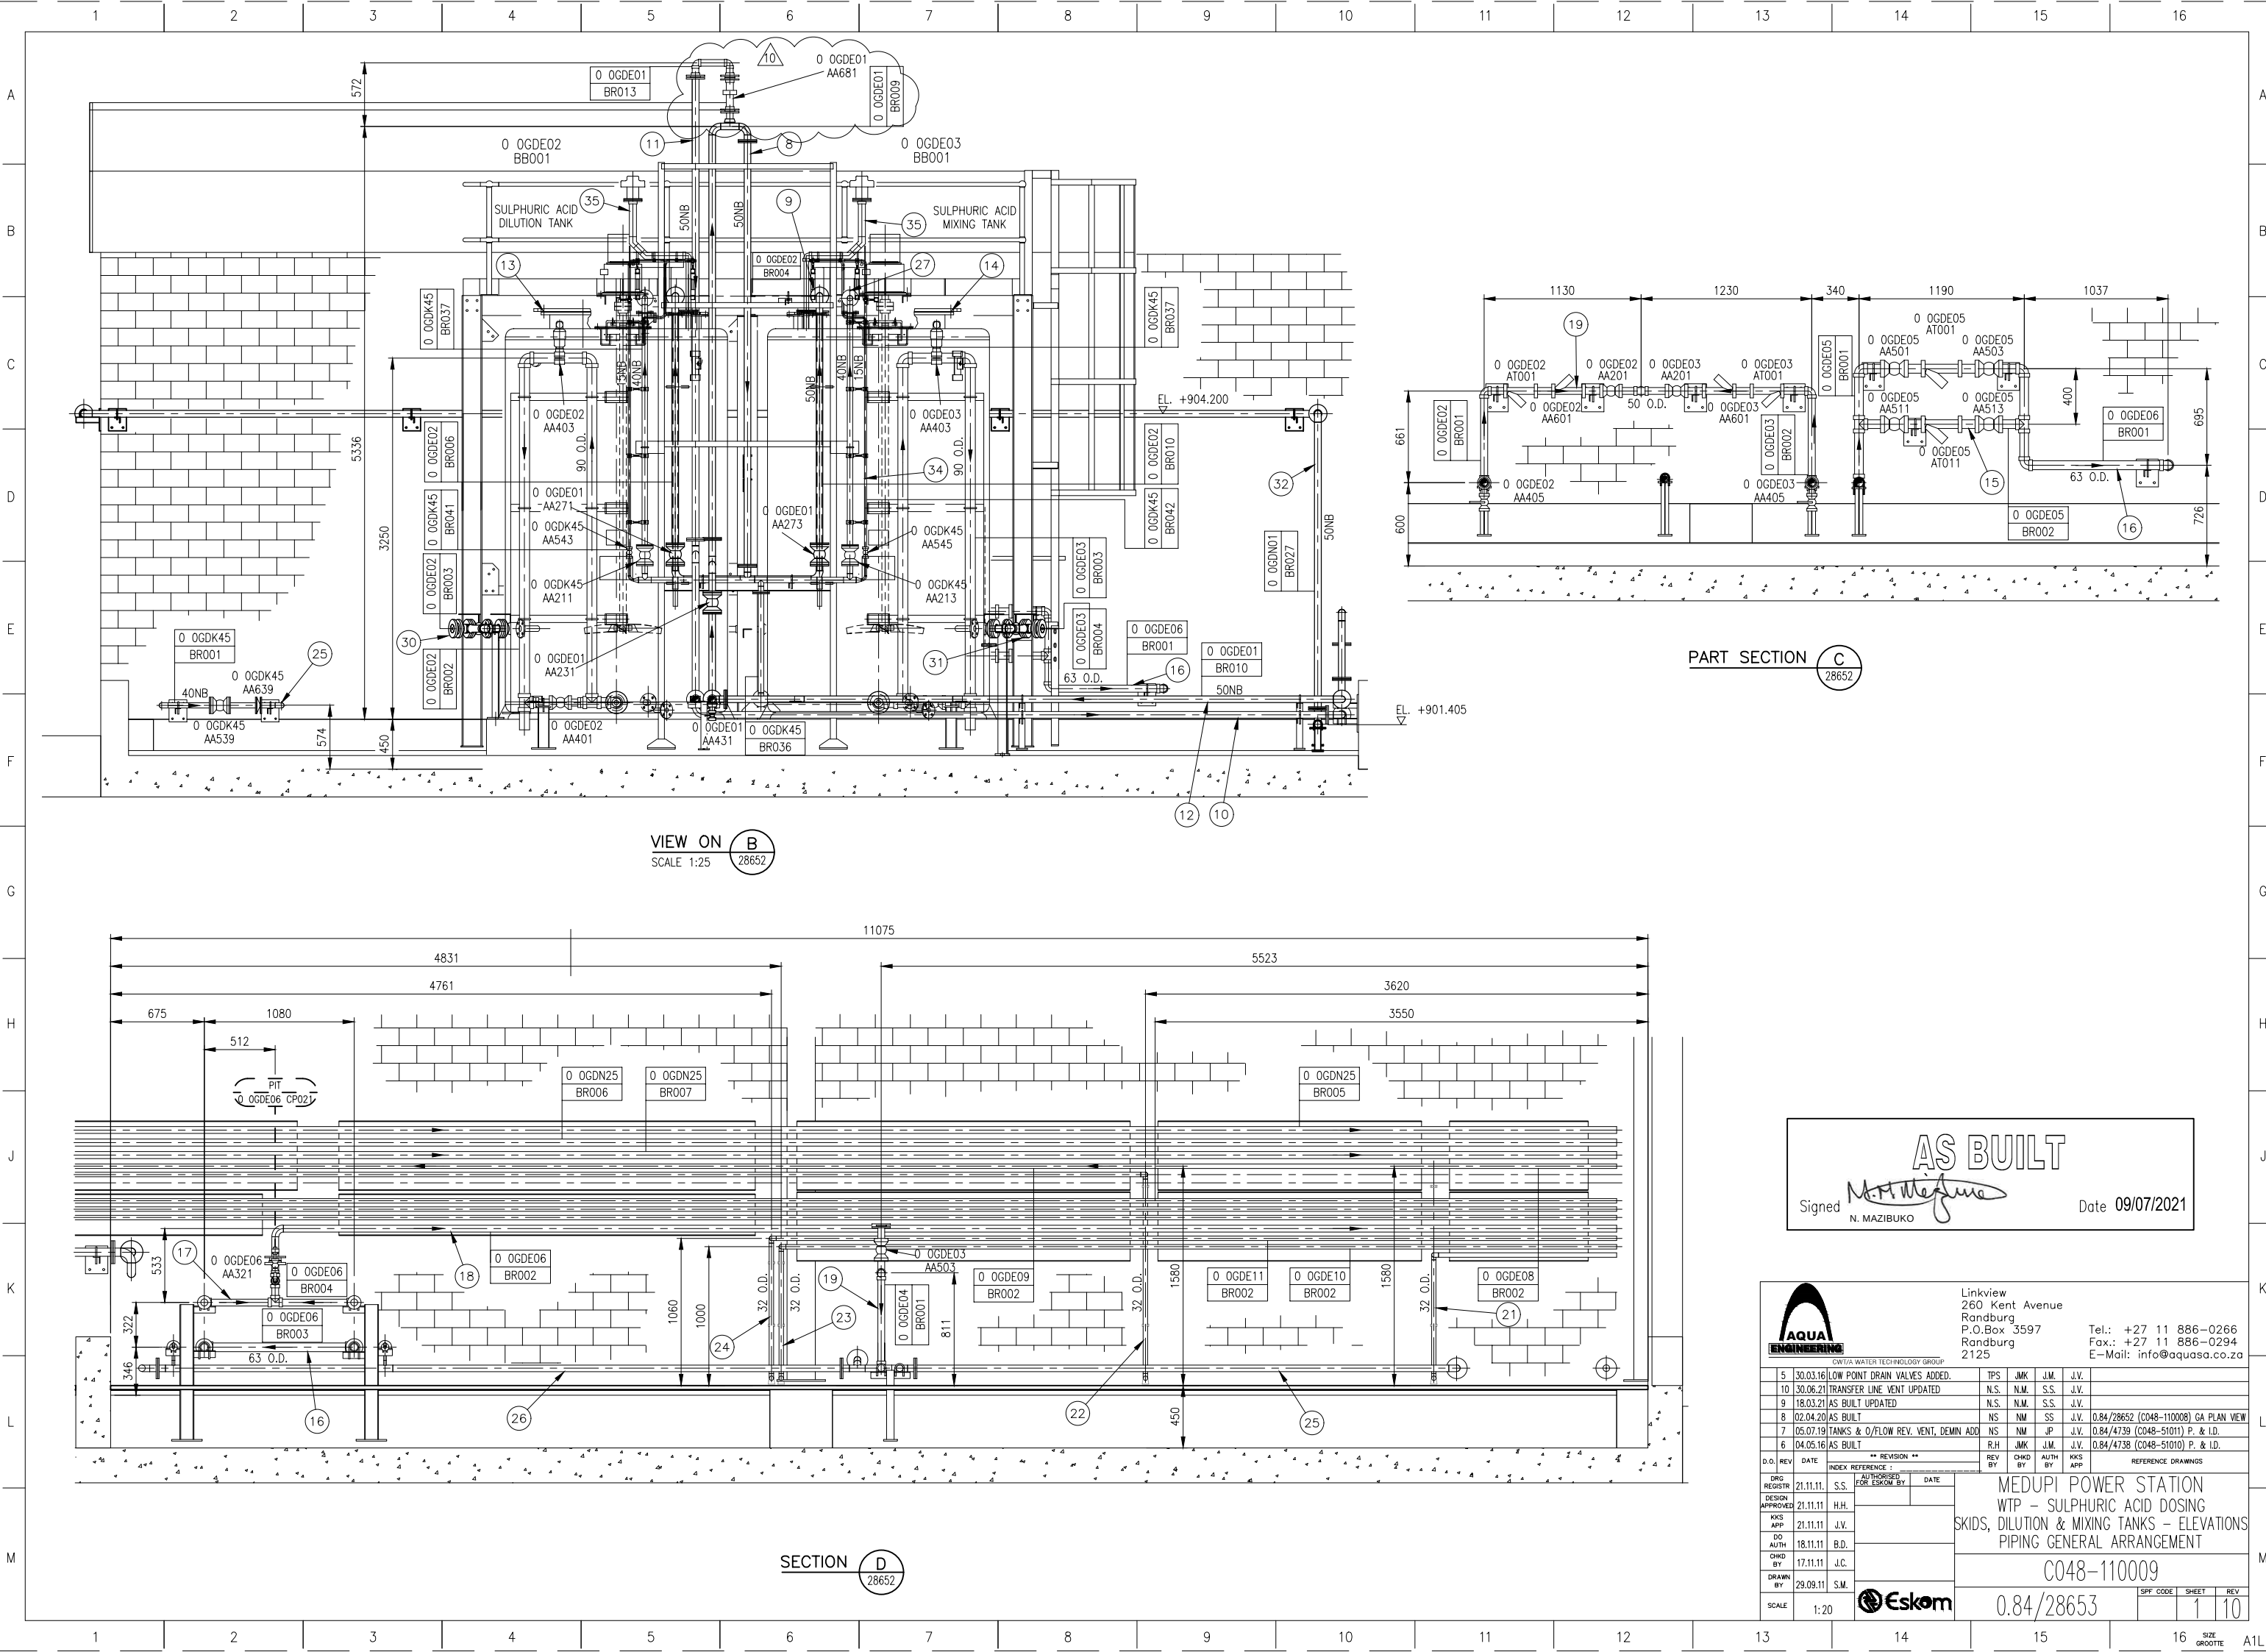

VIEW ON B
SCALE 1:25
28652

PART SECTION C
28652

SECTION D
28652

AS BUILT
Signed *N. Mazibuko*
N. MAZIBUKO
Date 09/07/2021



AQUA
ENGINEERING

Linkview
260 Kent Avenue
Randburg
P.O.Box 3597
Randburg
2125

Tel.: +27 11 886-0266
Fax.: +27 11 886-0294
E-Mail: info@aquas.co.za

CWTA WATER TECHNOLOGY GROUP

5	30.03.16	LOW POINT DRAIN VALVES ADDED.	TPS	JMK	J.M.	J.V.	
10	30.06.21	TRANSFER LINE VENT UPDATED	N.S.	N.M.	S.S.	J.V.	
9	18.03.21	AS BUILT UPDATED	N.S.	N.M.	S.S.	J.V.	
8	02.04.20	AS BUILT	NS	NM	SS	J.V.	0.84/28652 (C048-110008) GA PLAN VIEW
7	05.07.19	TANKS & O/FLOW REV. VENT, DEMIN ADD	NS	NM	JP	J.V.	0.84/4739 (C048-51011) P. & I.D.
6	04.05.16	AS BUILT	R.H.	JMK	J.M.	J.V.	0.84/4738 (C048-51010) P. & I.D.
** REVISION **			REV BY	CHKD BY	AUTH BY	KKS APP	REFERENCE DRAWINGS
D.O. REG	DATE	INDEX REFERENCE :					
DESIGN REGISTER	21.11.11	S.S.					
ORIGIN APPROVED	21.11.11	H.H.					
KKS APP	21.11.11	J.V.					
DO AUTH	18.11.11	B.D.					
CHKD BY	17.11.11	J.C.					
DRAWN BY	29.09.11	S.M.					
SCALE	1:20						



MEDUPI POWER STATION
WTP – SULPHURIC ACID DOSING
SKIDS, DILUTION & MIXING TANKS – ELEVATIONS
PIPING GENERAL ARRANGEMENT

C048-110009

0.84/28653

SPP CODE	SHEET	REV
	1	10