

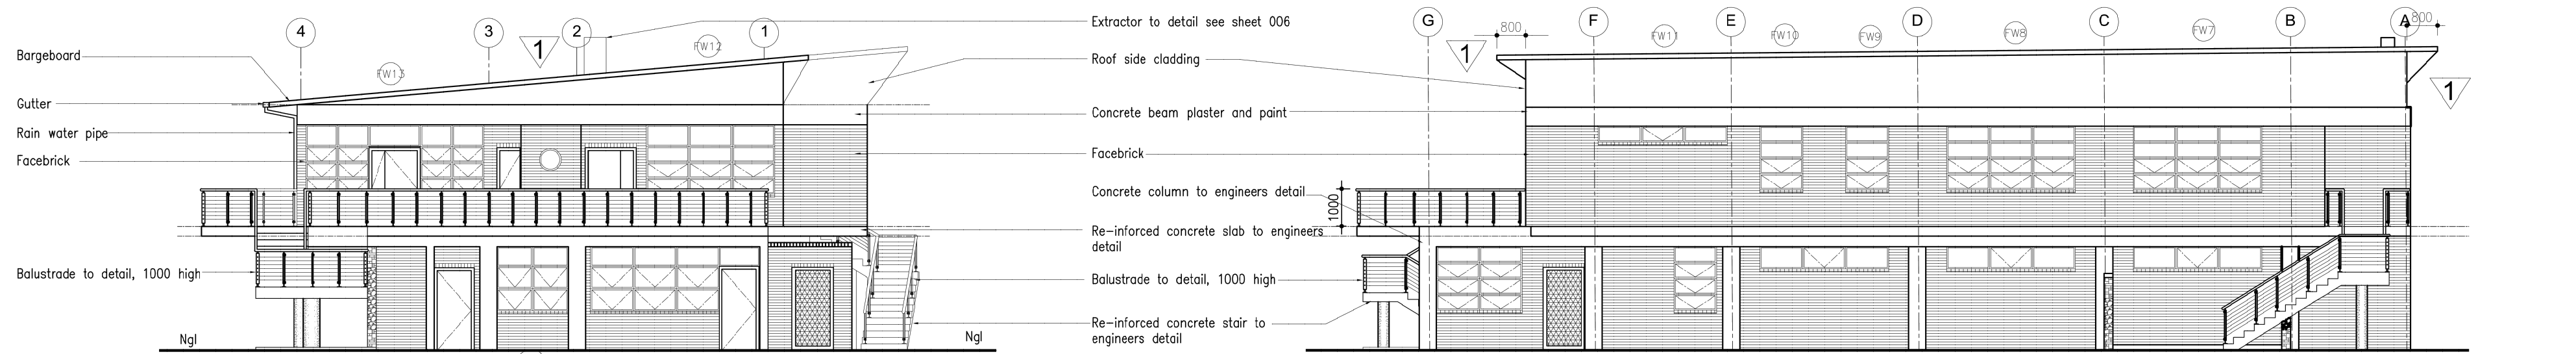


DO NOT SCALE - IF IN DOUBT, ASK

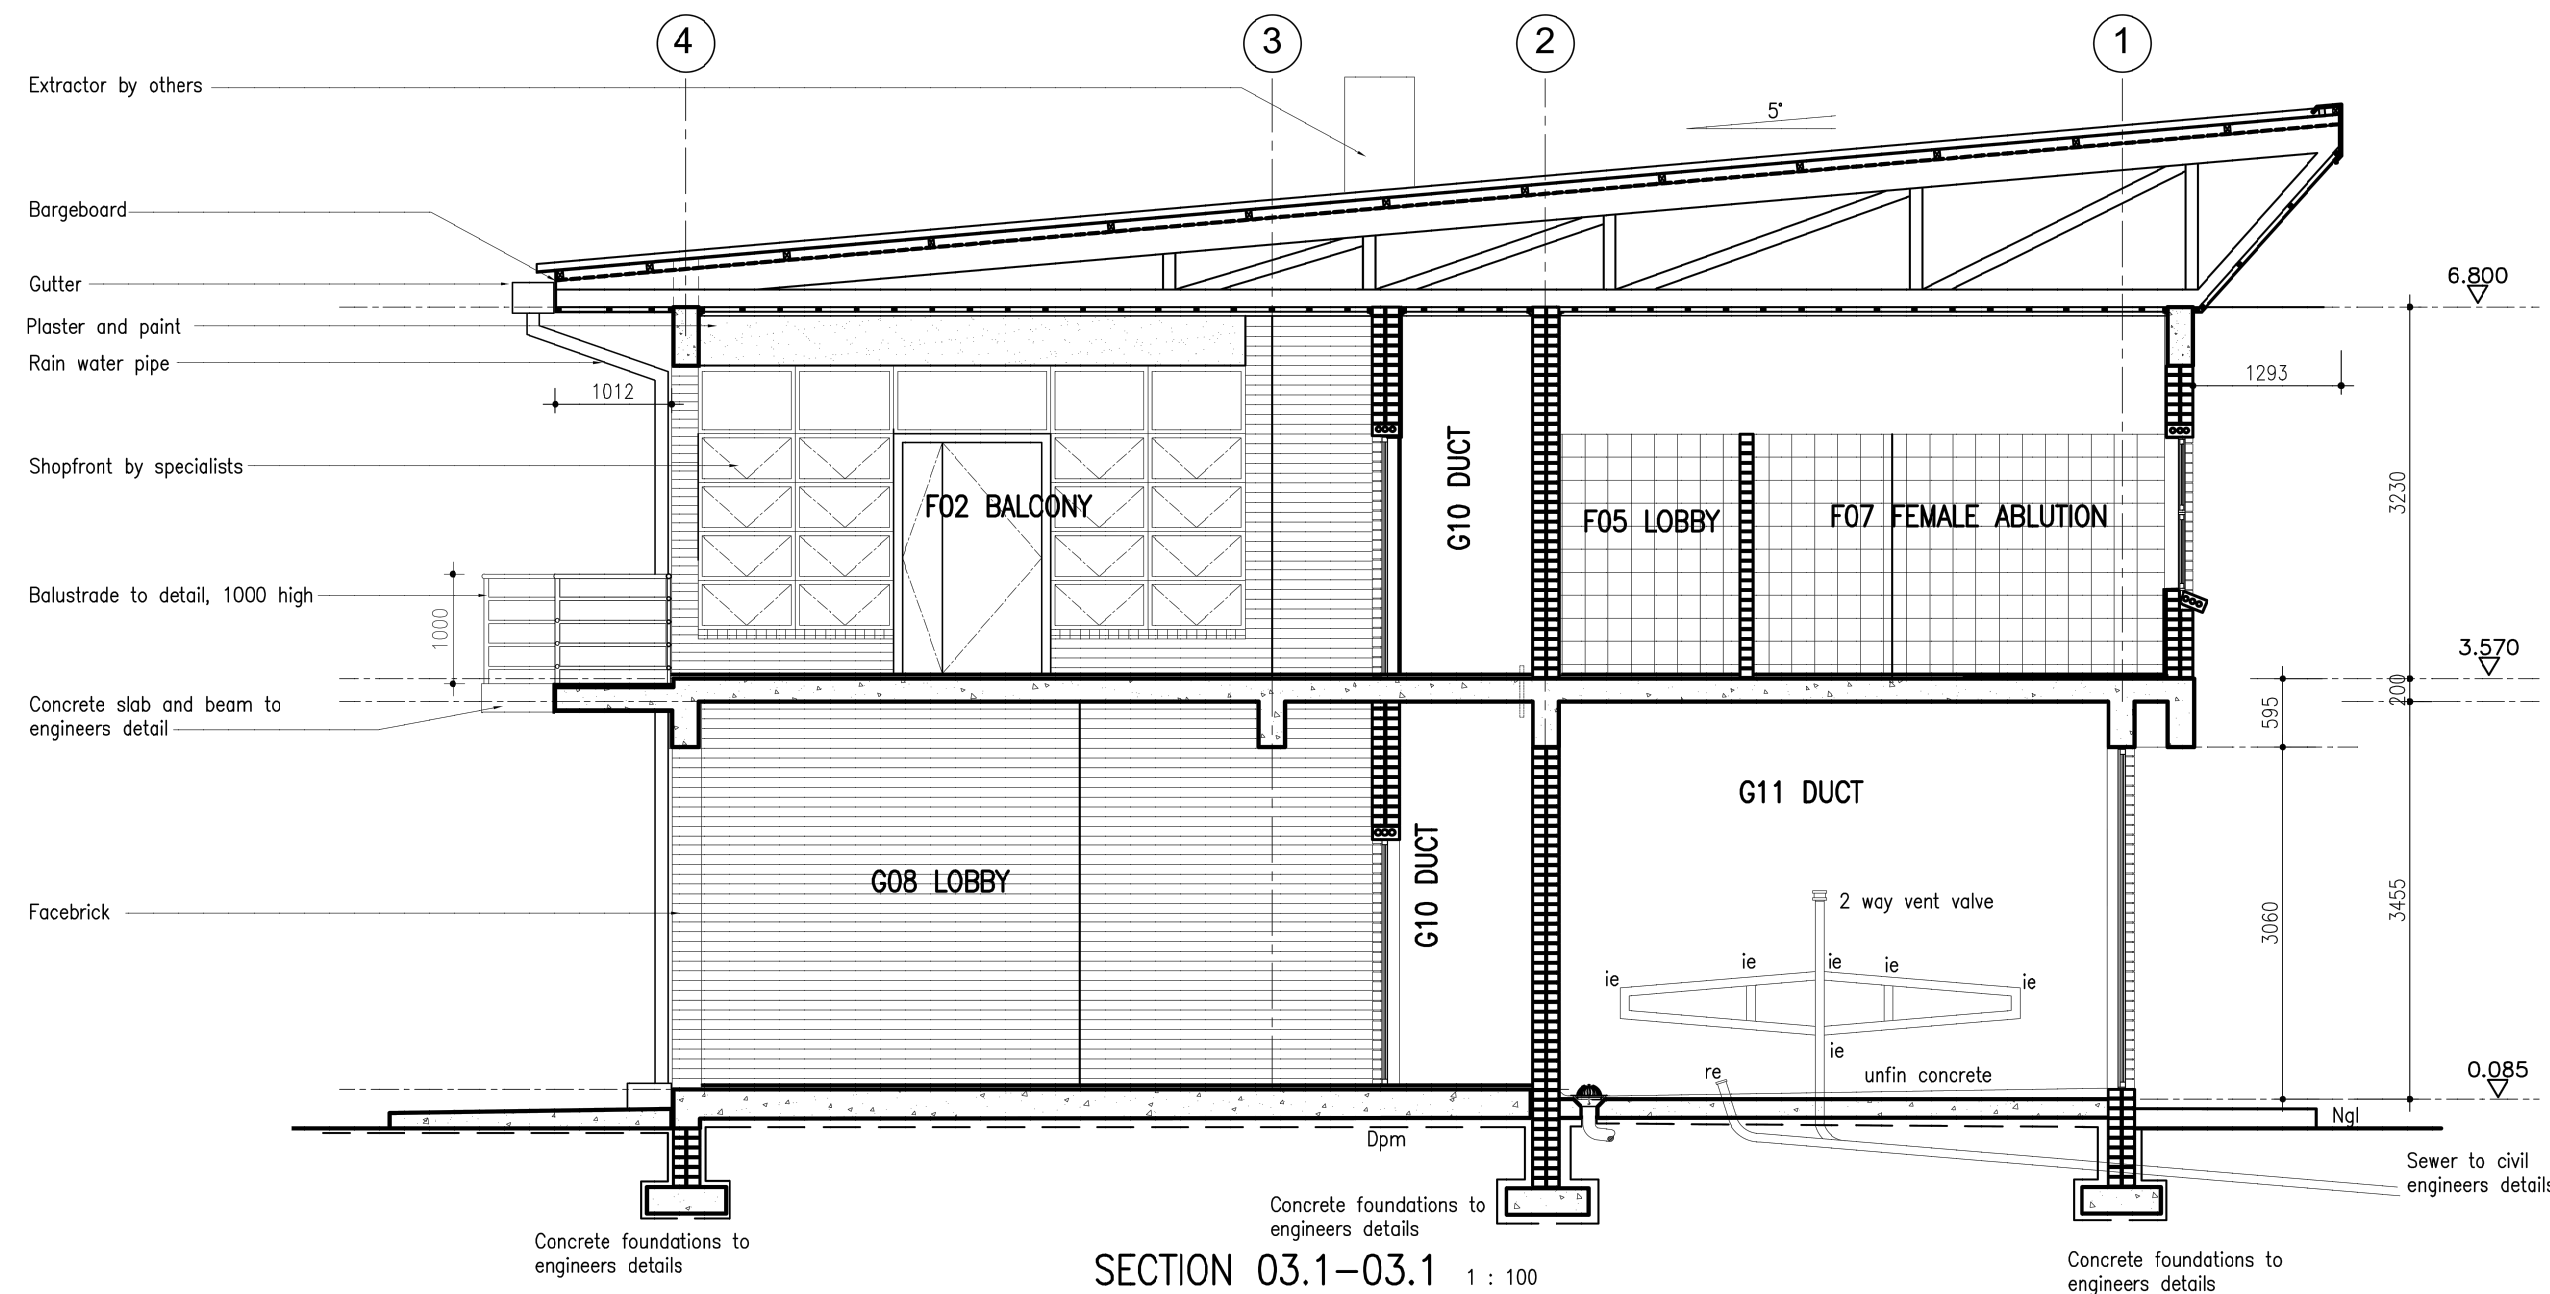

NOTES:

REFER TO SPECIFICATION 1785-C0-000-C-SPC-0018 FOR DETAILS OF DISPOSAL OF ITEMS AND MATERIALS FOR DEMOLITIONS.

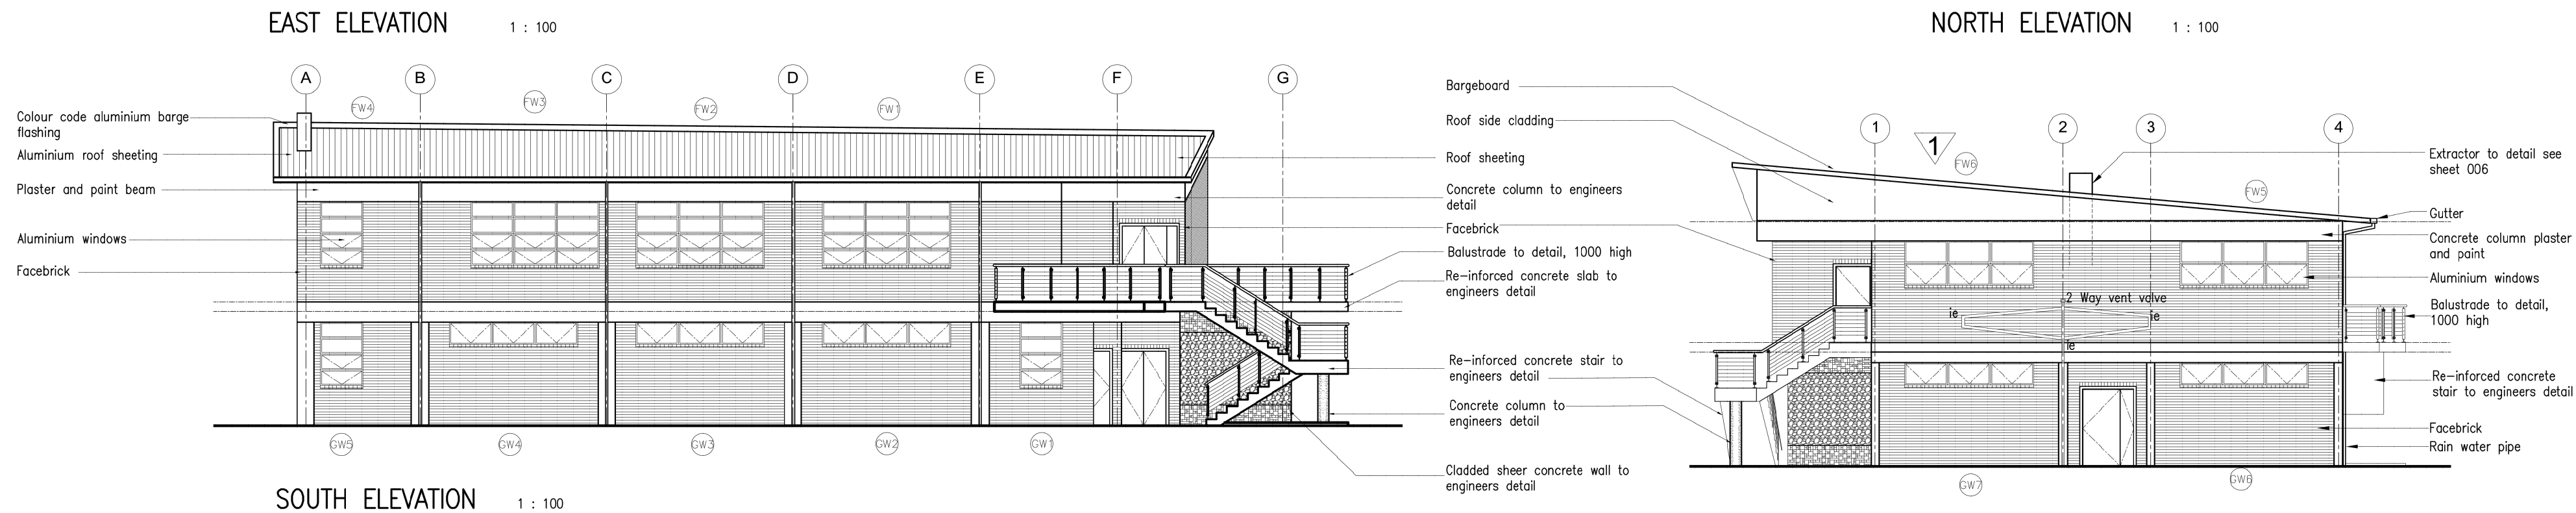

EXISTING 205 ABLUTIONS TO BE DEMOLISHED: AS BUILT DRAWING

N.T.S

		Engineers				EPCM CONSULTANT: <b>TNPA</b>		ORIGINATOR: <b>ZAA</b>		Transnet National Ports Authority	
						TITLE		TITLE		237 MAHATMA GANDHI ROAD	
						LEAD DES. ENG.		DRAWN		DURBAN	
						ENG. COORD.		CHECKED		P.O. BOX 31683, DURBAN	
						ENG. MANAGER		SIGNATURE		TEL: 031 261 8852	
						AREA MANAGER		DISCIP. ENG.		<b>PORT OF DURBAN</b>	
						PROJECT MGR.		ENG. MANAGER			
						DIVISION		AREA MANAGER		<b>DCT BERTHS 203 to 205 RECONSTRUCTION</b>	
						NO.		PR.ENG. / PR.TECH.		<b>DEEPPENING AND LENGTHENING</b>	
						DESCRIPTION		NAME		<b>DEMOLITIONS</b>	
						BY		SIGNATURE		<b>BERTH 205 ABLUTION FACILITY DETAILS</b>	
						DATE		DATE		<b>SHEET 1 OF 3</b>	
						REVISIONS / ISSUE AUTHORIZATION		REG. NUMBER		PROJECT NUMBER	
								760293		2122830	
								SCALE : 1:750		DV	
								NOTED		1	
										FBS	
										050	
										DIS	
										C	
										TYPE	
										G A	
										DRG NO.	
										1002	
										SHT.	
										01	
										REV.	
										0A	
										ID	
										AS	