

Diagram illustrating the 66/11kV Transformers Cable Block Diagram, showing the arrangement of cables and components for TRFR 1 and TRFR 2.

**Legend:**

- 1. \* INDICATES CABLES USED.
- 2. # INDICATES LOOPING.
- 3. 1B IS FOR TRFR 1 & 1C FOR TRFR 2.
- 4. ALL RSA NUMBERED CABLES ARE TO BE TYPE, 4Pr, 1.5mm<sup>2</sup>, XLPE, ISO, PVC.
- 5. 1A IS FOR TRFR 1 & 1B IS FOR TRFR 2

**Diagram Components:**

- 66kV BUSBAR 1B/1C ISOLATOR MB
- 66kV CTs
- 66kV BKR MB
- 66kV CTJB
- PROTECTION RELAY PANEL
- NEC/R AUX TRFR MB
- NOTE 5 11kV BUSBAR 1A/1B ISOLATOR MB
- TRFR MARSHALLING KIOSK
- 11kV BREAKER MB
- NEUTRAL CT

**Cable Designation Table:**

CABLE No.	DESIGNATION	TRFR 1 66/11kV	TRFR 2 66/11kV
401	BVX12DCV	*	*
402	BVX12DCV	*	*
403	BVX12DCV	*	*
404	BVX12DCV	*	*
405	BVX4ECV	*	*
406	BVX12DCV	*	*
407	BVX19DCV	*	*
408	BVX12DCV	*	*
409	BVX4ECV	*	*
410	BVX12DCV	*	*
411	TPH5OAX	*	*
412	BVX19DCV	*	*
413	BVX4ECV	*	*
414	BVX19DCV	*	*
415	BVX12DCV	*	*
416	BVX12DCV	*	*
417	BVX4KCV	*	*
418	BVX12DCV	*	*
419	BVX19ECV	*	*
420	BVX4ECV	*	*
421	BVX4ECV	*	*
422	BVX12DCV	*	*
423	BVX4ECV	*	*
424	BVX12DCV	*	*
436	BVX2DCV	*	*

**Diagram Labels:**

- 66kV BUSZONE PANEL
- 11kV BUSSECTION RP
- KWT 1 11kV FEEDER 1 RP
- 11kV BUSSECTION RP
- KWT 2 11kV FEEDER 2 RP
- MEASUREMENTS PANEL 1
- AC DISTRIBUTION PANEL
- OLTC CONTROL PANEL
- DC DISTRIBUTION PANEL
- 11kV BUSBAR 1A VTJB
- STATISTICAL MEASUREMENTS PANEL (MEAS CT)
- 66kV BUSZONE PANEL
- LOOP BETWEEN TRFR 2 & TRFR 3 RP
- LOOP BETWEEN TRFR 2 & TRFR 3 RP
- LOOP BETWEEN TRFR 1 & TRFR 2 RP
- LOOP BETWEEN TRFR 1 & TRFR 2 RP
- 66kV FDR 3
- RECORDER INTERFACE PANEL FOR TRFR 1 ONLY
- RECORDER INTERFACE PANEL FOR TRFR 2 ONLY

**Notes:**

- NOTE 3
- NOTE 5

**Revision History:**

REV	REVISION DESCRIPTION	BY	CHKD	AUTH	DATE
5	RECORDER PANEL ADDED	MH	SBT	AMAC	12/03/2013
4	CHANGED 66kV BREAKER FROM OSM10 TO ABB	MT	EN	AMAC	30/11/2012
3	INDOOR SWITCHGEAR REPLACEMENT	BSA	BSA	AMAC	10/07/2007
2	COMMISSIONING MARKUPS	MG	LLZ	LLZ	29/05/2005
1	TRFR 3 INSTALLED	LLZ	GHC	AMAC	24/12/2004

**Authorisation:**

AUTHORISED BY: S.TSHOBENI  
DATE: 27/02/2002  
CHECKED BY: S.TSHOBENI  
DATE: 27/02/2002  
DRAWN BY: JMB  
DATE: 30/01/2002

**Project Information:**

KING WILLIAMS TOWN S/S  
66/11kV TRANSFORMERS  
CABLE BLOCK DIAGRAM


**Scale:** 1 : 113  
THIS DRAWING IS THE PROPERTY OF ESKOM

**Revision:** 5

This figure is a detailed cable block diagram for a power distribution system at King Williams Town. The diagram illustrates the connections between various electrical components, including busbars, breakers, isolators, CTs, relays, TRFRs, and control panels, all interconnected via a network of cables.

The diagram is organized into a grid with columns numbered 1 to 16 and rows labeled A to M. Key components and their associated cable numbers are as follows:

- 66kV ISOLATOR MB**: Connected to cable 406.
- 66kV BREAKER MB**: Connected to cables 407 and 408.
- 66kV CTs**: Connected to cables 409, 410, and 411.
- 66kV CTJB**: Connected to cable 412.
- RELAY PANEL**: Connected to cables 413, 414, and 415.
- TRFR MARSHALLING KIOSK**: Connected to cables 416, 417, 418, 999, 1000.

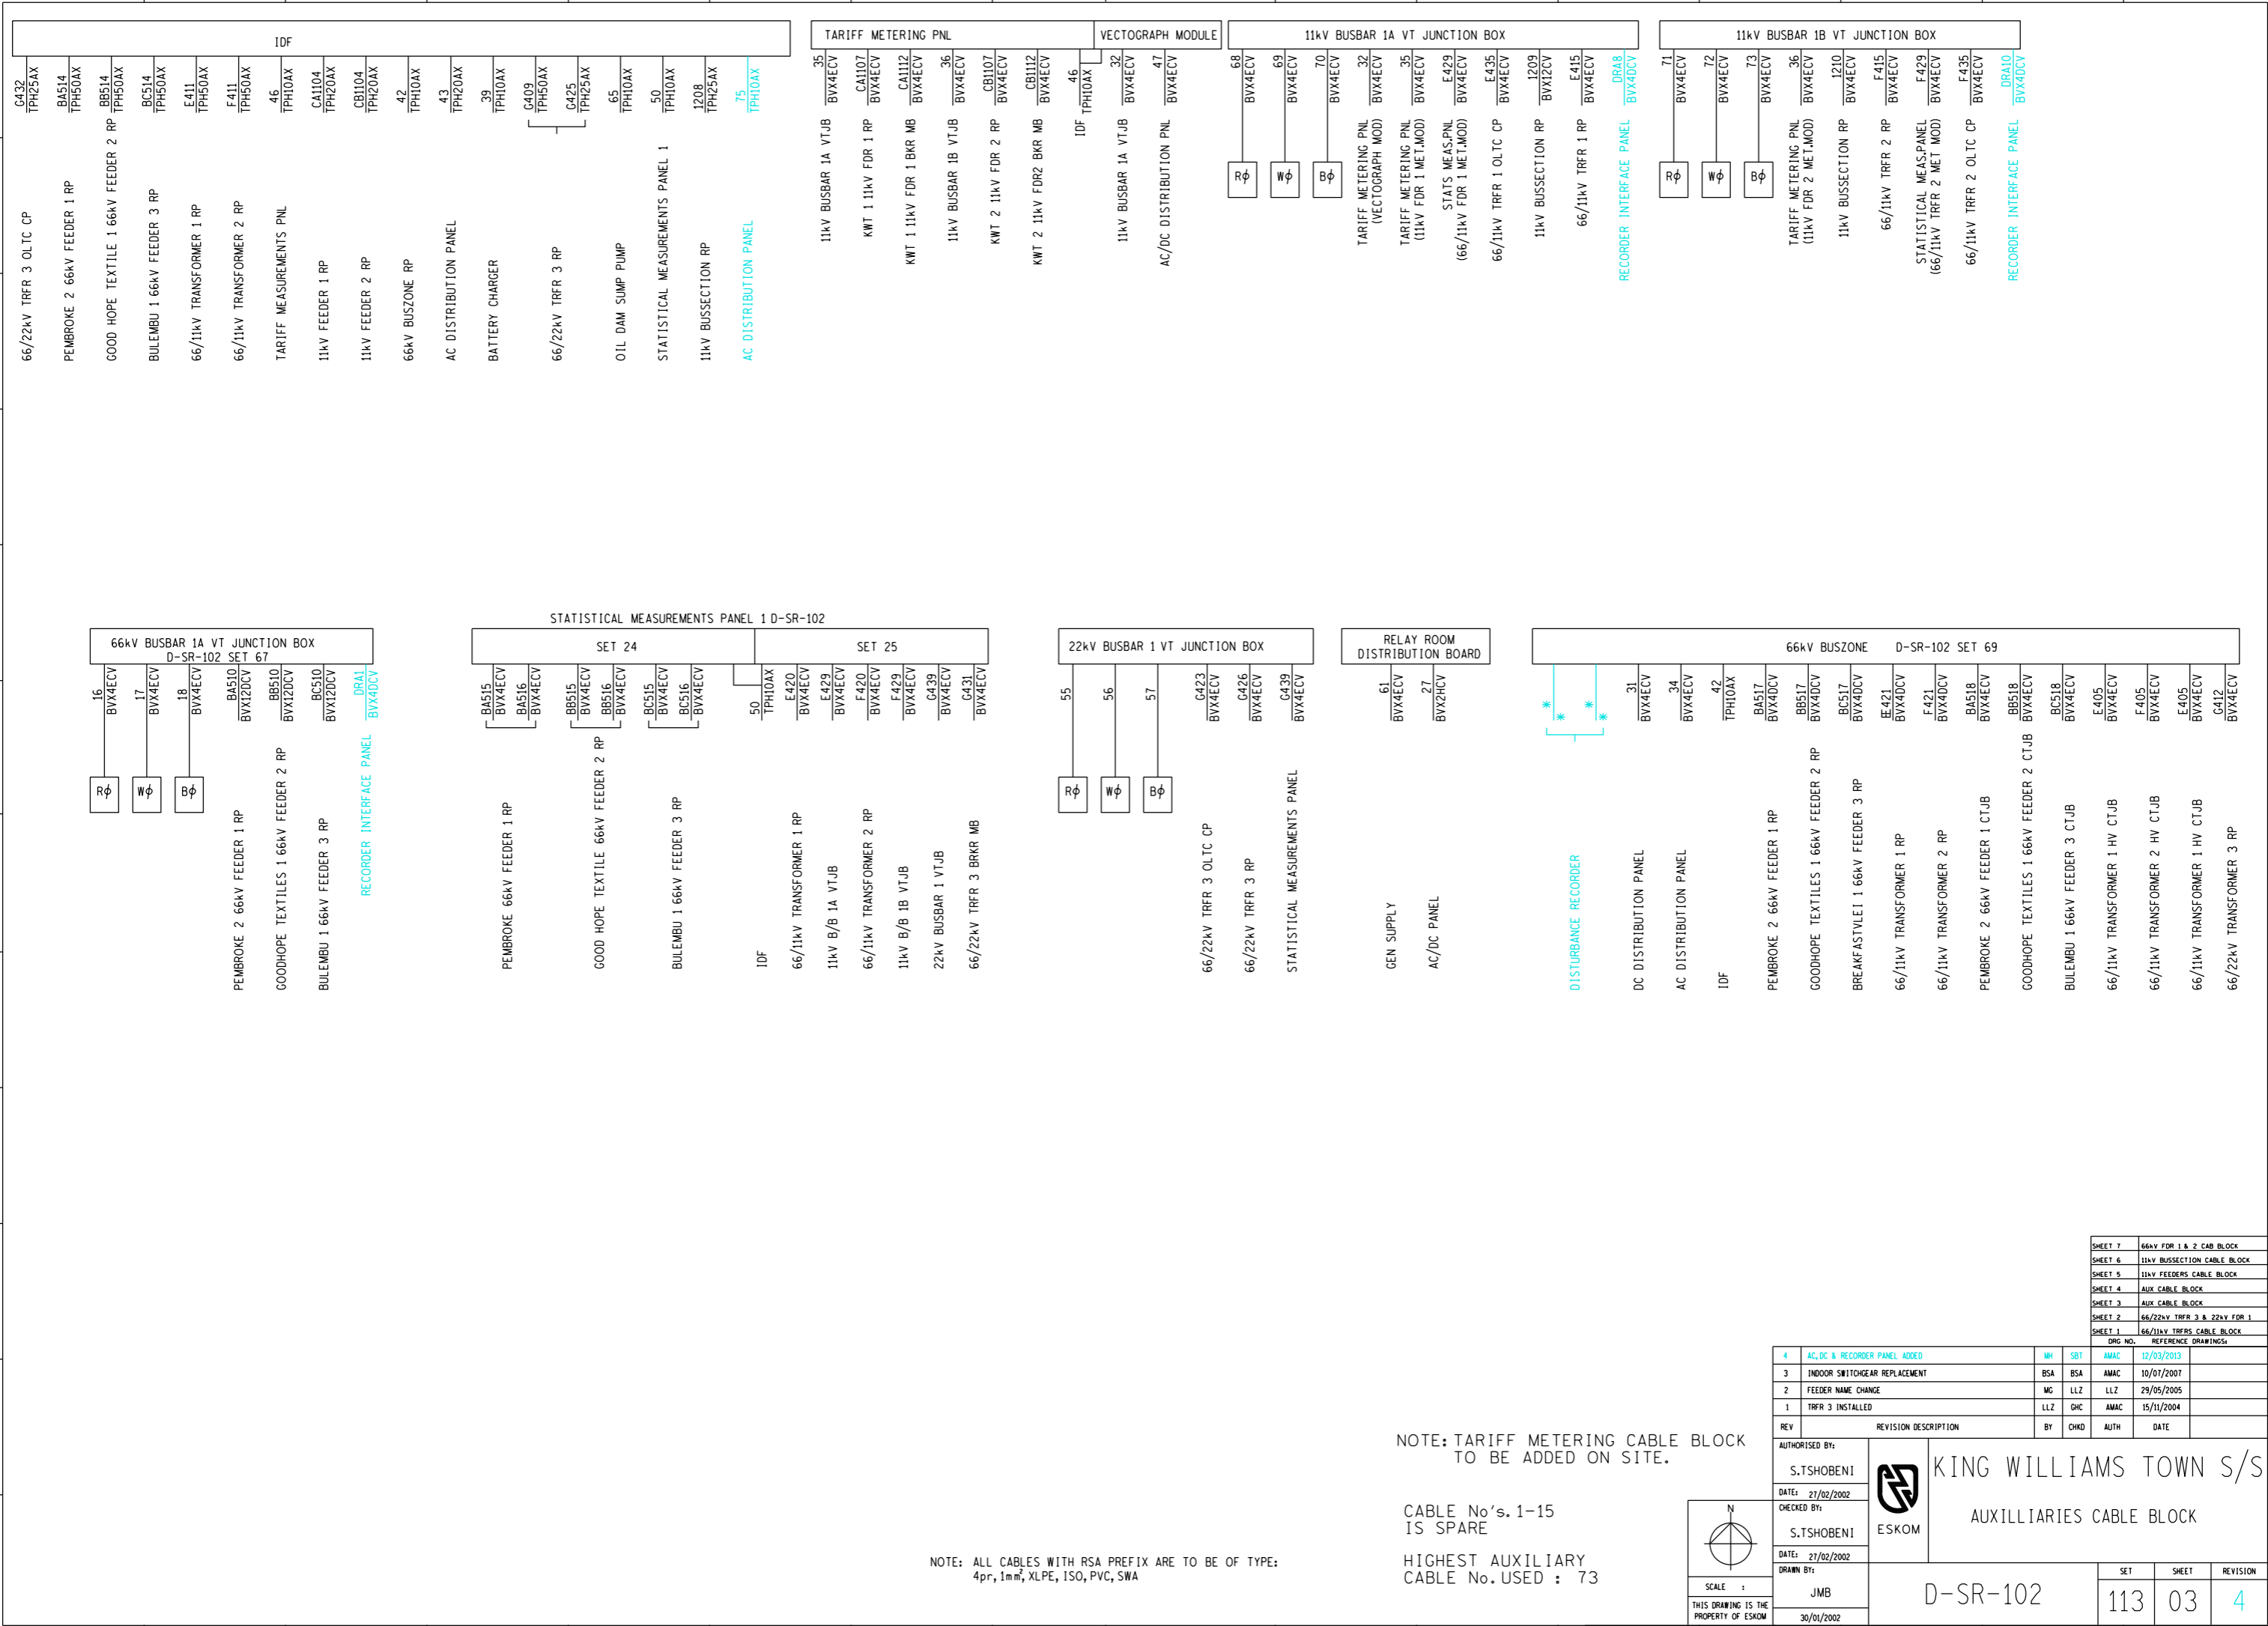



NOTE: ALL CABLES WITH RSA PREFIX ARE TO BE OF TYPE:  
4pr, 1mm<sup>2</sup>, XLPE, ISO, PVC, SWA

NOTE: TARIFF METERING CABLE BLOCK  
TO BE ADDED ON SITE.


CABLE No's. 1-15  
IS SPARE

HIGHEST AUXILIARY  
CABLE No. USED : 73

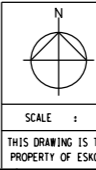


4	AC, DC & RECORDER PANEL ADDED	NH	SBT	AMAC	12/03/2013	
3	INDOOR SWITCHGEAR REPLACEMENT	BSA	BSA	AMAC	10/01/2007	
2	FEEDER NAME CHANGE	MG	LLZ	LLZ	29/05/2005	
1	TRFR 3 INSTALLED	LLZ	GHC	AMAC	15/11/2004	
REV	REVISION DESCRIPTION		BY	CHKD	AUTH	DATE
AUTHORISED BY:		 ESKOM	KING WILLIAMS TOWN S/S			
S.TSHOBENI			AUXILIARIES CABLE BLOCK			
DATE: 27/02/2002						
CHECKED BY:						
S.TSHOBENI						
DATE: 27/02/2002						
DRAWN BY:						
JMB		D-SR-102		SET	SHEET	REVISION
30/01/2002				113	03	4

SHEET 7	66kV FOR 1 & 2 CAB BLOCK
SHEET 6	11kV BUSSECTION CABLE BLOCK
SHEET 5	11kV FEEDERS CABLE BLOCK
SHEET 4	AUX CABLE BLOCK
SHEET 3	AUX CABLE BLOCK
SHEET 2	66/22kV TRFR 3 & 22kV FOR 1
SHEET 1	66/11kV TRFRS CABLE BLOCK
DRG NO.	REFERENCE DRAWINGS:

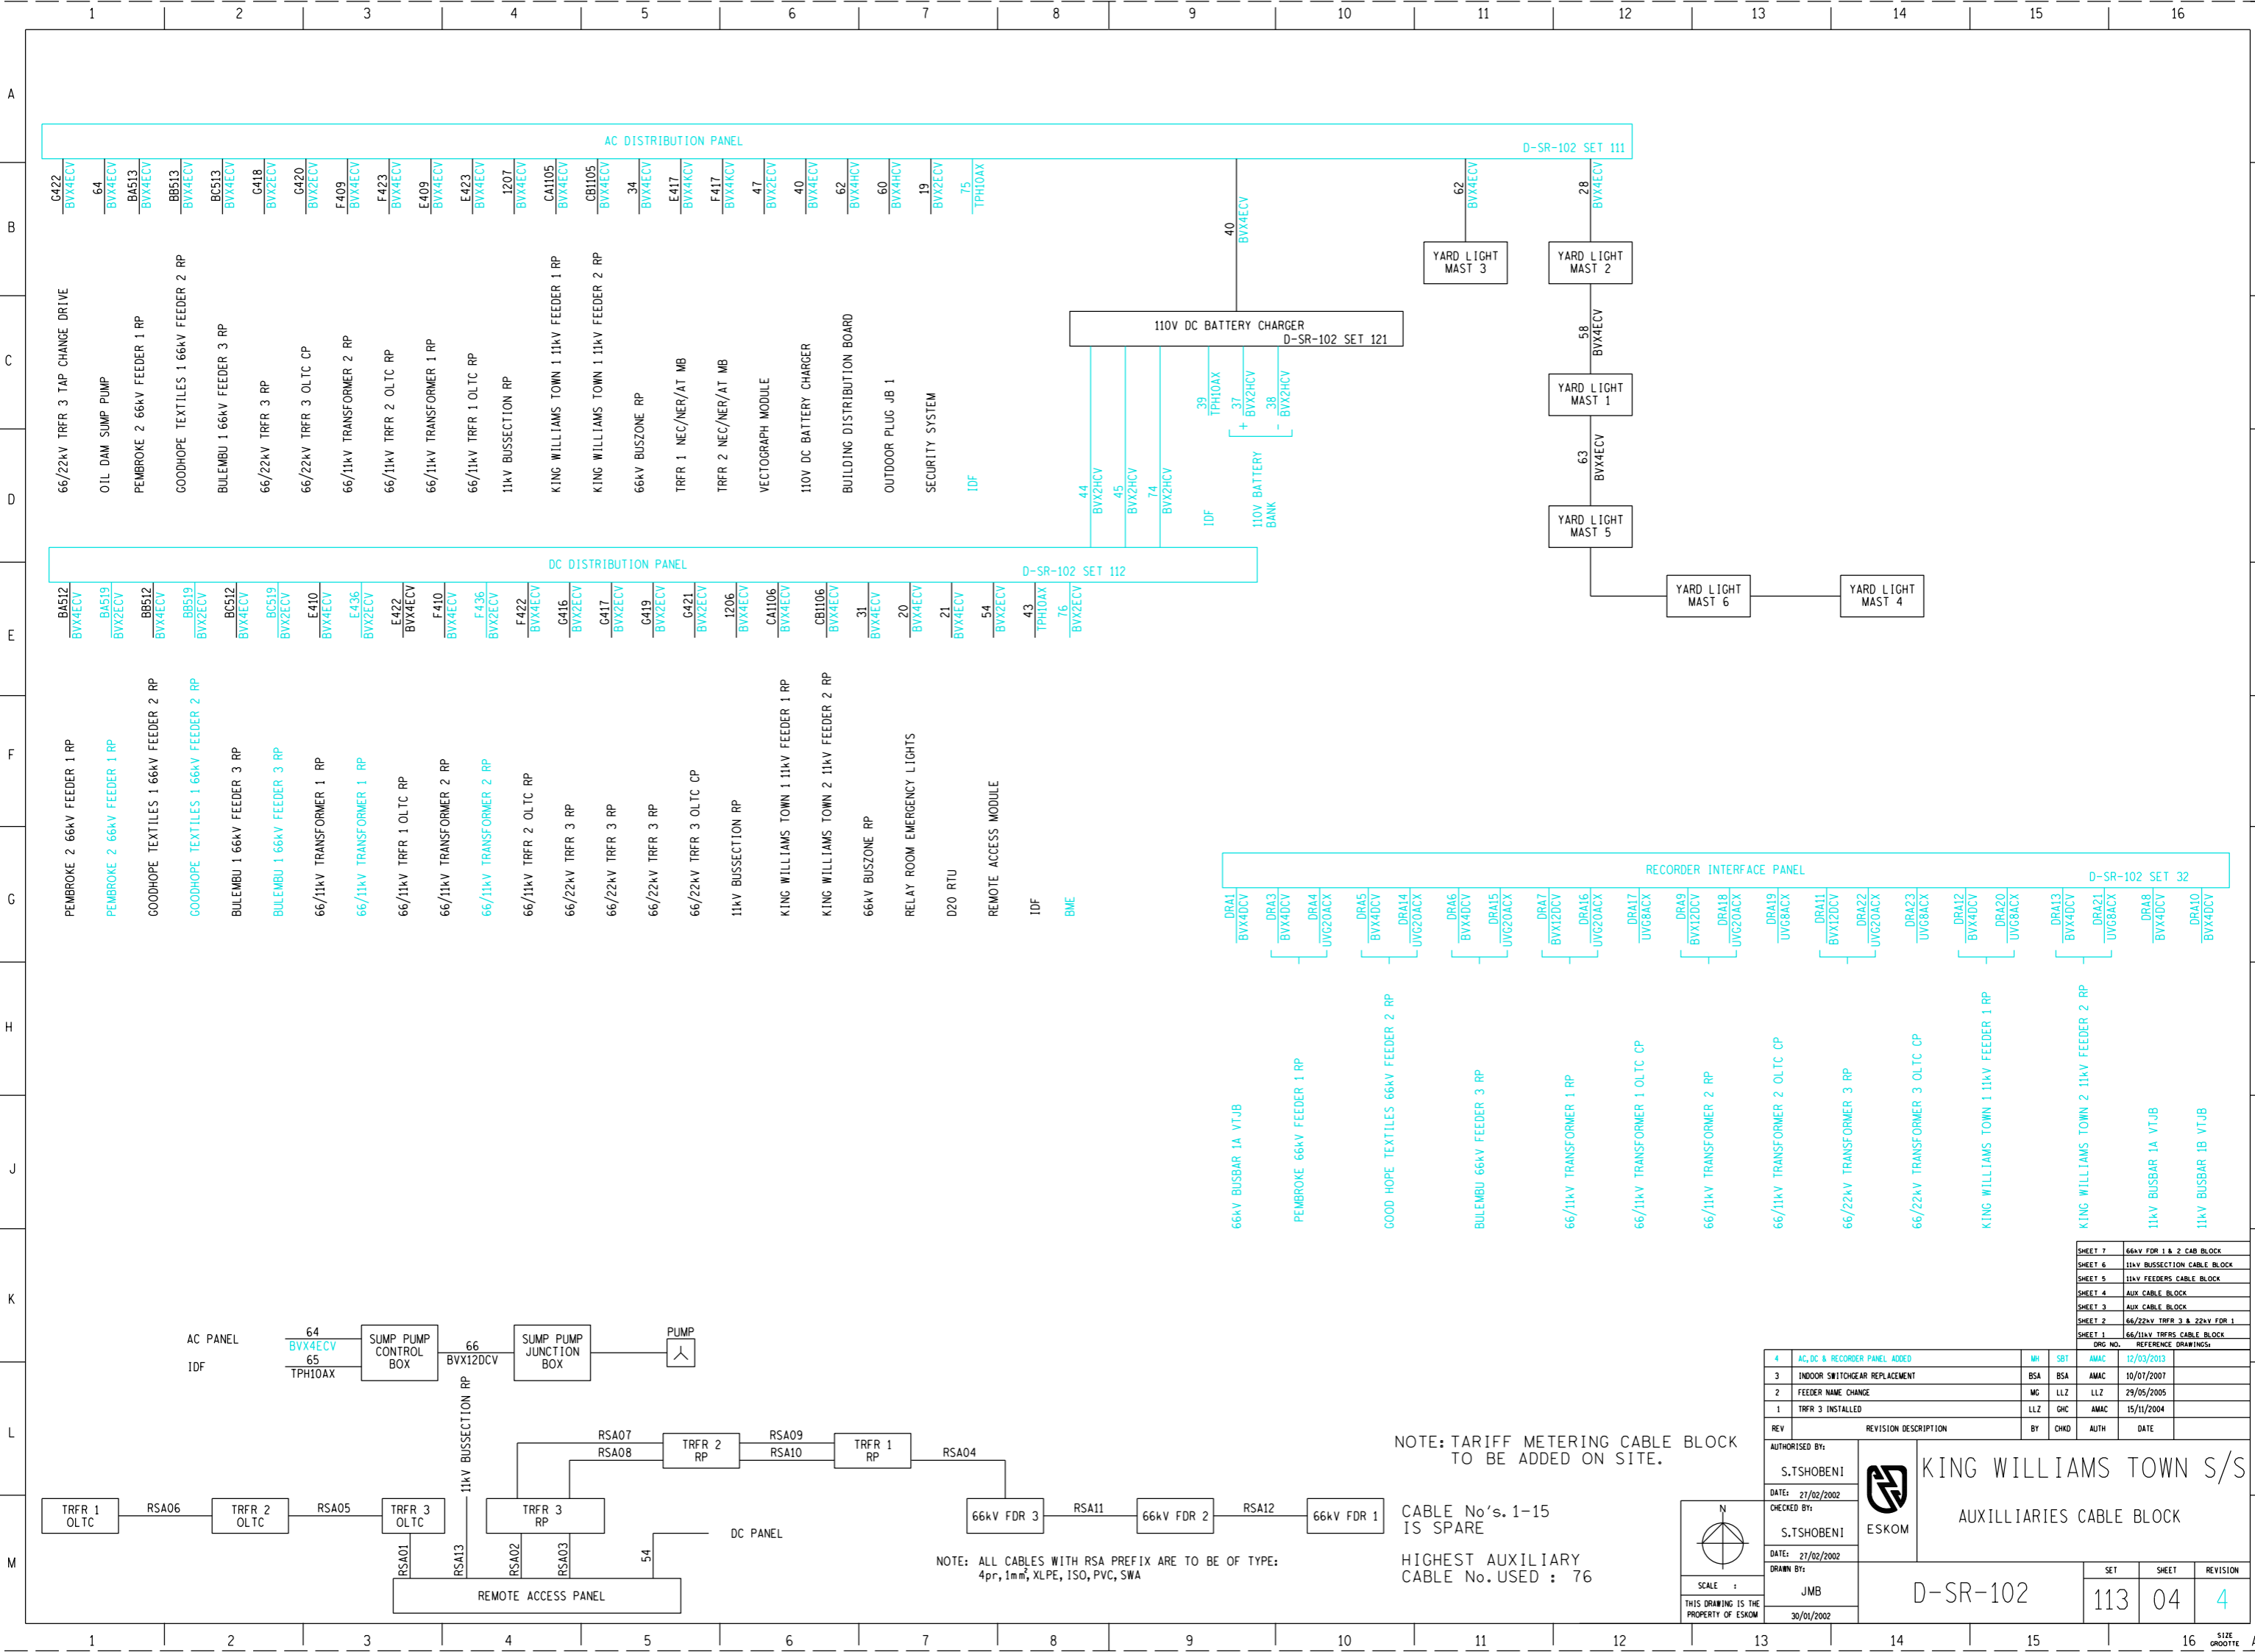

REV	REVISION DESCRIPTION	BY	CHKD	AUTH	DATE
4	AC, DC & RECORDER PANEL ADDED	NH	SBT	AMAC	12/03/2013
3	INDOOR SWITCHGEAR REPLACEMENT	BSA	BSA	AMAC	10/07/2007
2	FEEDER NAME CHANGE	MG	LLZ	LLZ	29/05/2005
1	TRFR 3 INSTALLED	LLZ	GHC	AMAC	15/11/2004
DRG NO. REFERENCE DRAWINGS:					
SHEET 7	66kV FOR 1 & 2 CAB BLOCK				
SHEET 6	11kV BUSSECTION CABLE BLOCK				
SHEET 5	11kV FEEDERS CABLE BLOCK				
SHEET 4	AUX CABLE BLOCK				
SHEET 3	AUX CABLE BLOCK				
SHEET 2	66/22kV TRFR 3 & 22kV FOR 1				
SHEET 1	66/11kV TRFRS CABLE BLOCK				
AUTHORISED BY: S.TSHOBENI					
DATE: 27/02/2002					
CHECKED BY: S.TSHOBENI					
DATE: 27/02/2002					
DRAWN BY: JMB					
30/01/2002					
KING WILLIAMS TOWN S/S				SET	SHEET
AUXILLIARIES CABLE BLOCK				113	04
D-SR-102				REVISION	4

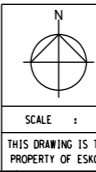

NOTE: TARIFF METERING CABLE BLOCK TO BE ADDED ON SITE.

CABLE No's. 1-15 IS SPARE

HIGHEST AUXILIARY CABLE No. USED : 76

NOTE: ALL CABLES WITH RSA PREFIX ARE TO BE OF TYPE: 4pr, 1mm<sup>2</sup>, XLPE, ISO, PVC, SWA



