
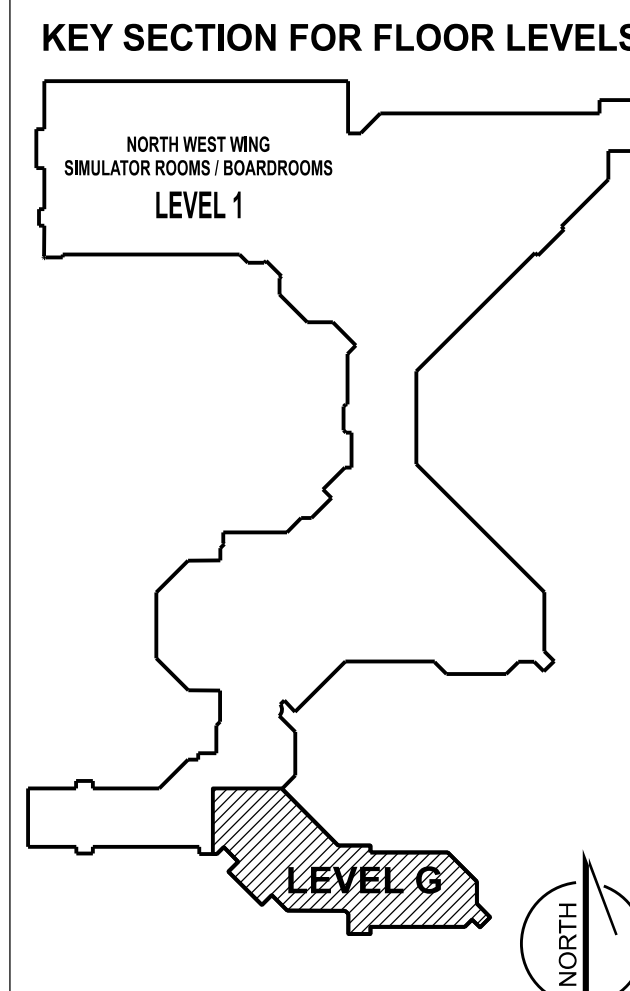


SOUTH EAST WING; SYNDICATE ROOMS
SCALE 1:100

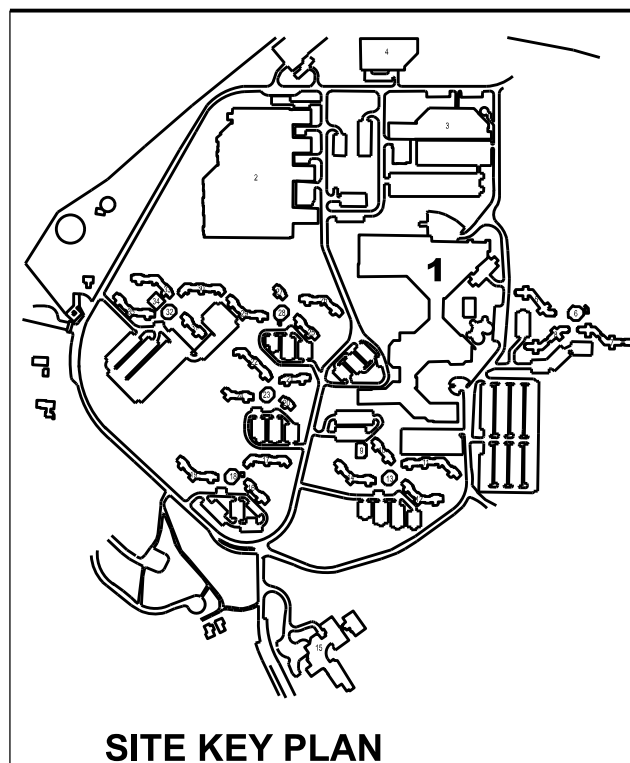

BUILDING KEY PLAN

AREAS SCHEDULE:

EXISTING BASEMENT FLOOR AREA	3 990 m²
EXISTING GROUND FLOOR AREA	11 455 m²
EXISTING FIRST FLOOR AREA	17 335 m²
EXISTING SECOND FLOOR AREA	1 907 m²
TOTAL AREA	24 687 m²

ISSUED FOR REVIEW

REVISION	CLASSIFICATION	REFERENCE	DRAWINGS
AS BUILT	CLASSIFICATION	REFERENCE	DRAWINGS
COPIATION BY:	CLASSIFICATION	REFERENCE	DRAWINGS
APPROVED BY:	CLASSIFICATION	REFERENCE	DRAWINGS
CHECKED BY:	CLASSIFICATION	REFERENCE	DRAWINGS
CREATED BY:	CLASSIFICATION	REFERENCE	DRAWINGS
SCALE	AS SHOWN	REFERENCE	DRAWINGS

Eskom
ESKOM HOLDINGS LTD
REG NO: 2002/00207-08

**ESKOM ACADEMY OF LEARNING
MAIN BUILDING
SOUTH EAST WING (SYNDICATE ROOMS)
GROUND FLOOR LEVEL
SHEET 1**

SHT	REV
1	0

100/111