


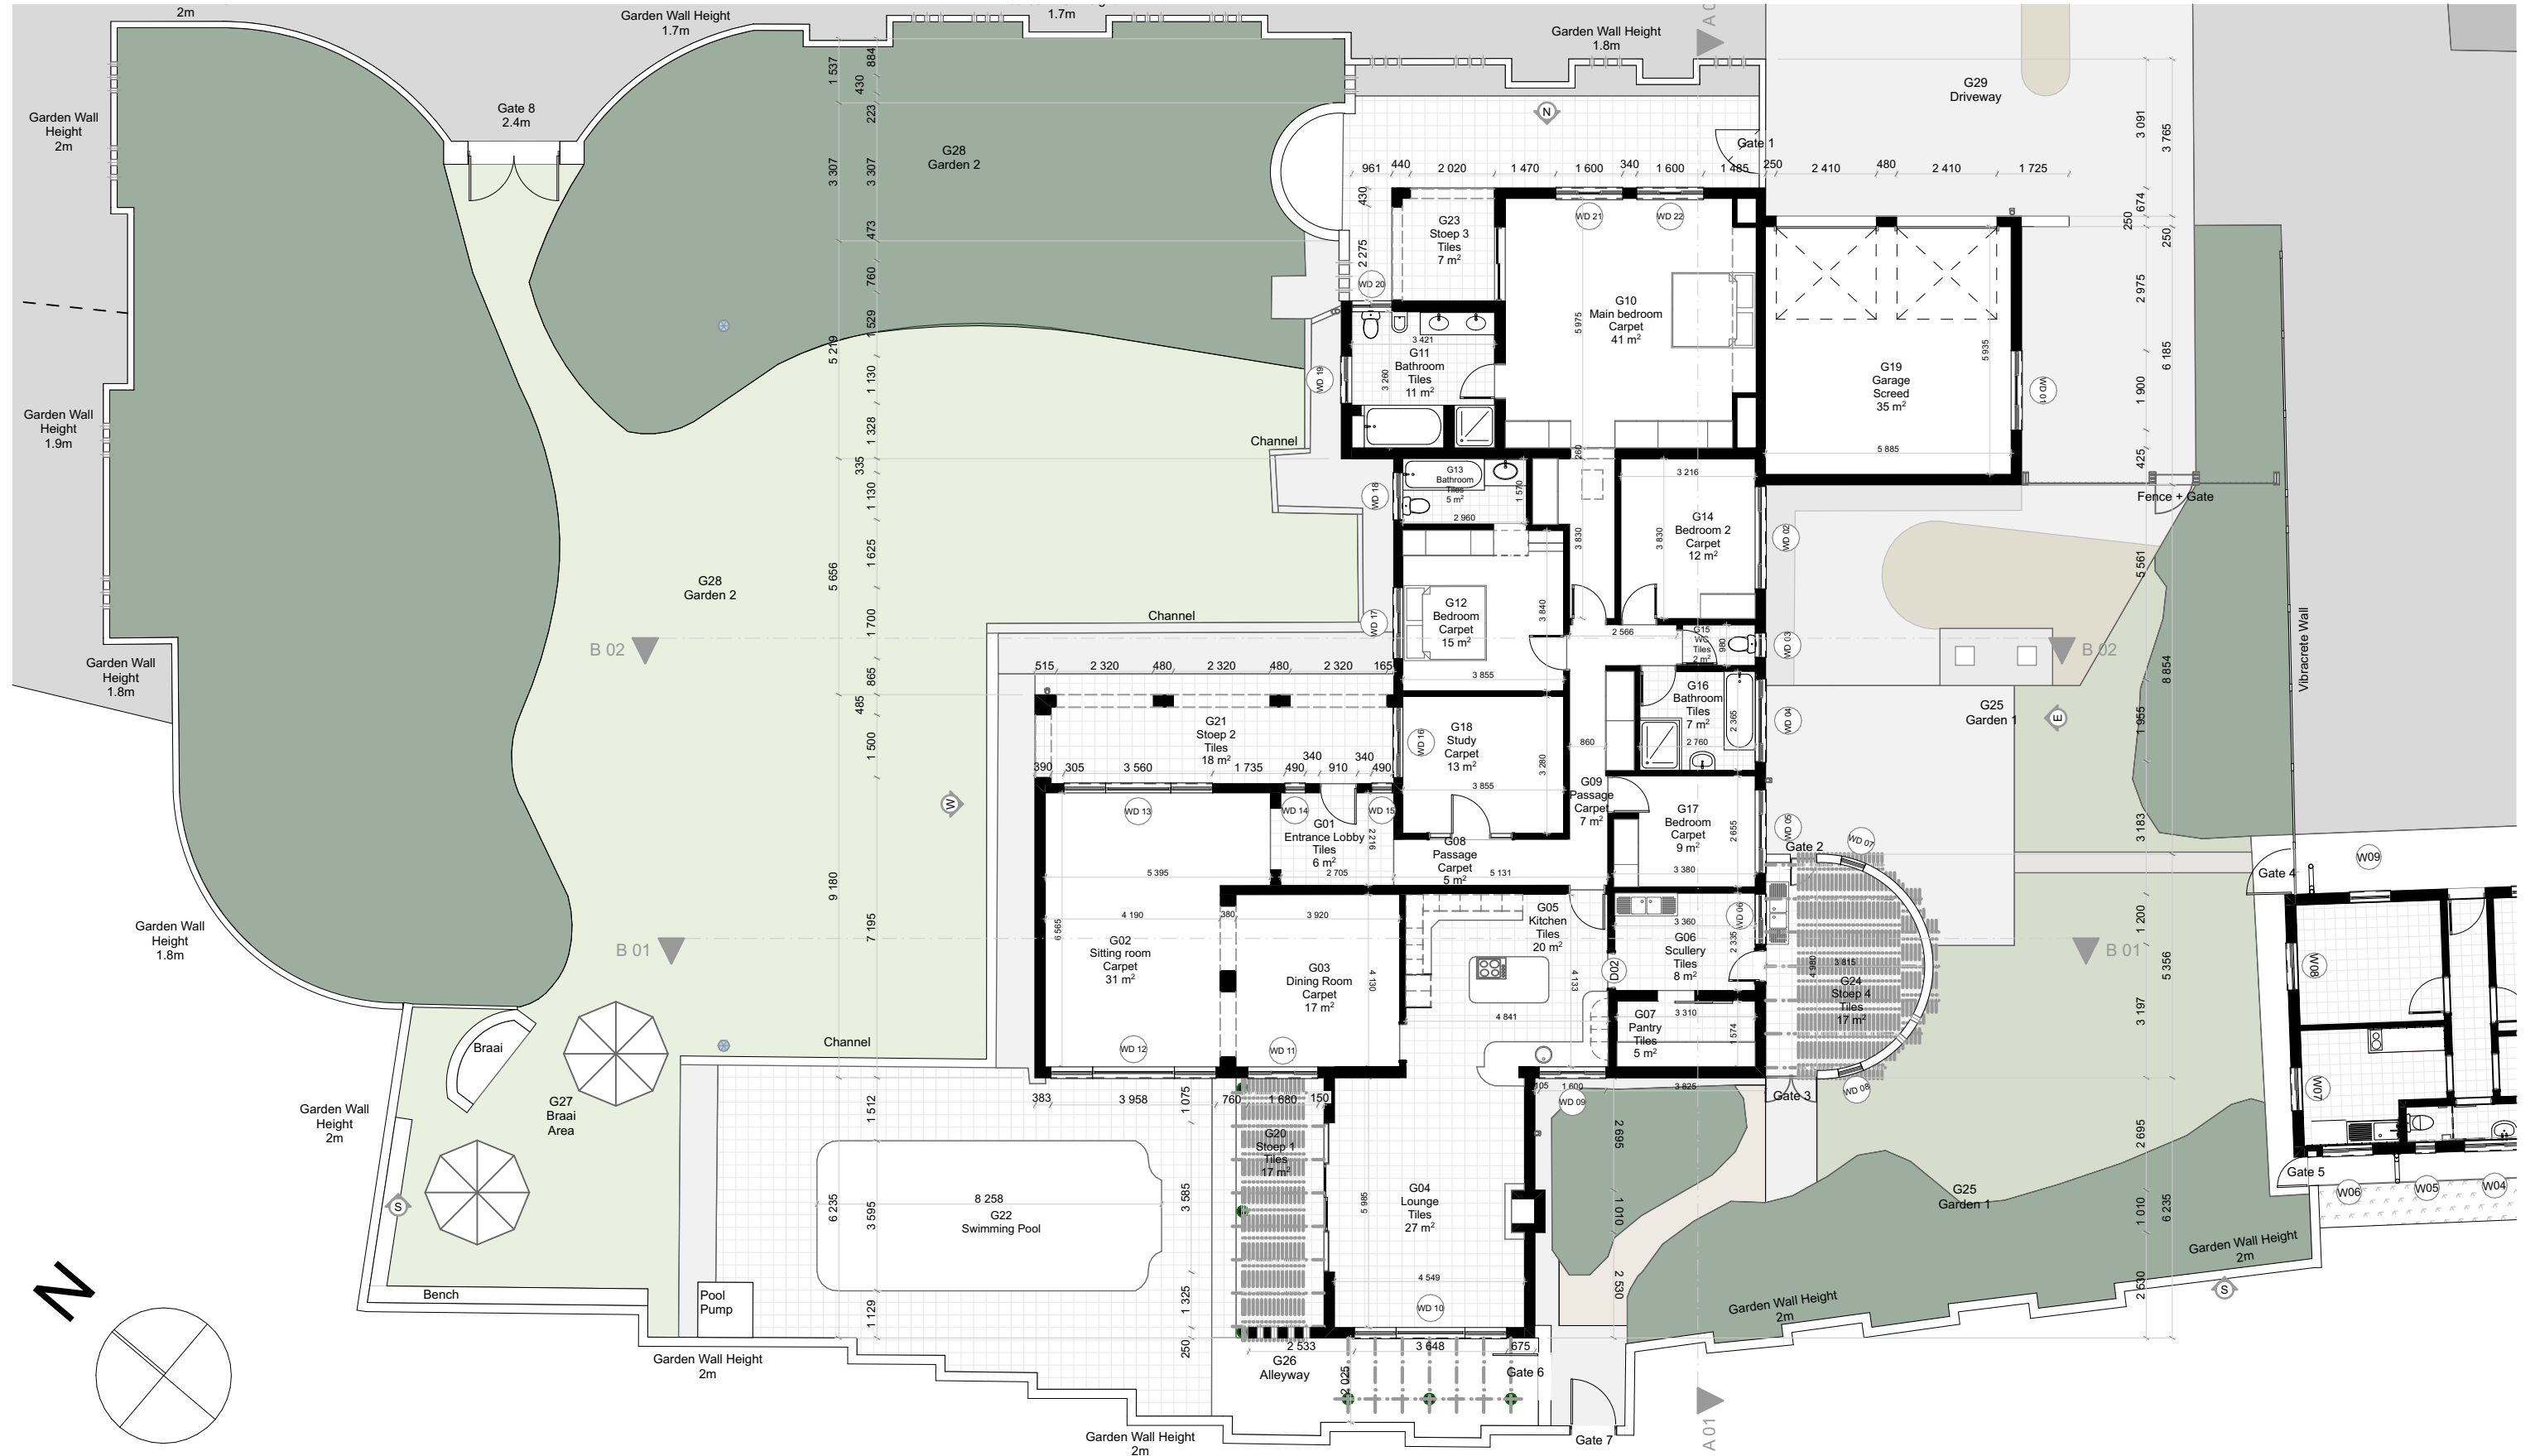
0.

Site Diagram

1:1500

 <div>OSMOND LANGE ARCHITECTS + PLANNERS</div>	ARCHITECT: Osmond Lange Architects and Planners (Pty) Ltd Cape Town		BUILDING CLASSIFICATION ####		CLIMATIC ZONE ####		<table><tr><th>RevID</th><th>ChID</th><th>Change Description</th><th>Date</th><th>IssID</th></tr><tr><td> </td><td> </td><td> </td><td> </td><td> </td></tr><tr><td> </td><td> </td><td> </td><td> </td><td> </td></tr><tr><td> </td><td> </td><td> </td><td> </td><td> </td></tr><tr><td> </td><td> </td><td> </td><td> </td><td> </td></tr><tr><td> </td><td> </td><td> </td><td> </td><td> </td></tr></table>				RevID	ChID	Change Description	Date	IssID																									
	RevID	ChID	Change Description	Date	IssID																																			
Postal: PO Box 499, Bellville, 7535 Address: Tyger Terraces II, DJ Wood Way, Bellville, Cape Town E-mail: cpt@o-l.co.za Tel: +27 (0) 21 948 1877 Fax: +27 (0) 21 948 3455		RESPONSIBLE PERSON		DATE	APPROVED																																			
DESIGN		BL / JDV		2025/08/13																																				
DRAWN		BL / MK																																						

PROJECT: Nelson Mandela Prison House As Built FOR Iziko Capitol Works ON ERF: Portion 2 of Farm Watervliet No 942		
PROJECT No. 220233	DRAWING NUMBER	REVISION



Ground Floor Plan

1:150



ARCHITECT:
**Osmond Lange
Architects and Planners
(Pty) Ltd
Cape Town**

Postal: PO Box 499, Bellville, 7535
Address: Tyger Terraces II, DJ Wood Way, Bellville, Cape Town
E-mail: cpt@o-l.co.za
Tel: +27 (0) 21 948 1877
Fax: +27 (0) 21 948 3455

BUILDING CLASSIFICATION
####

CLIMATIC ZONE
####

RESPONSIBLE PERSON

DATE APPROVED

DESIGN BL / JDV

2025/08/13

DRAWN BL / MK

RevID	ChID	Change Description	Date	IssID


PROJECT:
Nelson Mandela Prison House As Built
FOR Iziko Capital Works
ON ERF: Portion 2 of Farm Watervliet No 942

PROJECT No.

DRAWING NUMBER

REVISION


220233

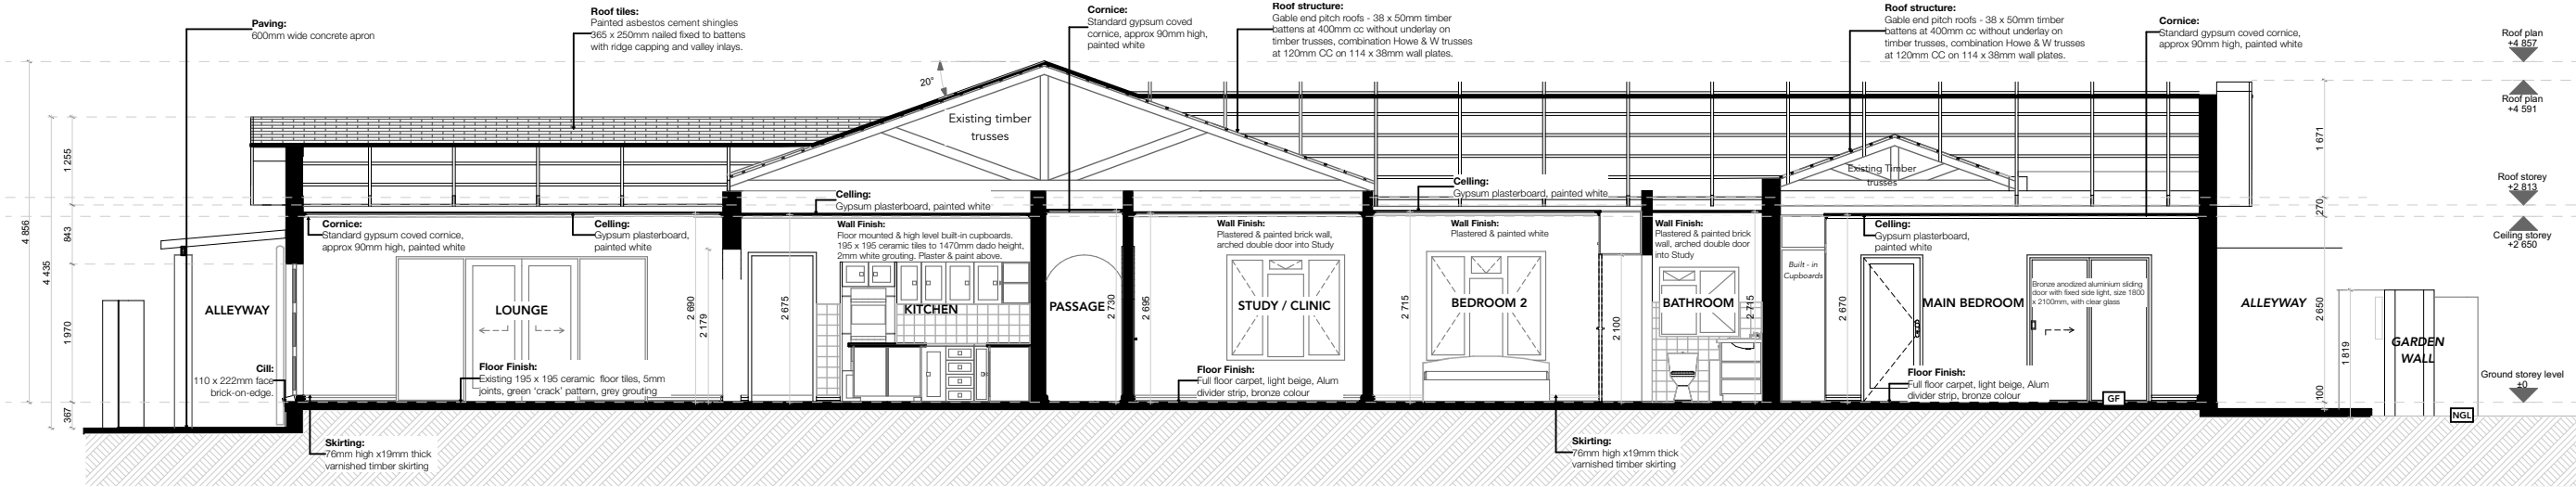

A 02

Building Section A 02


1:100

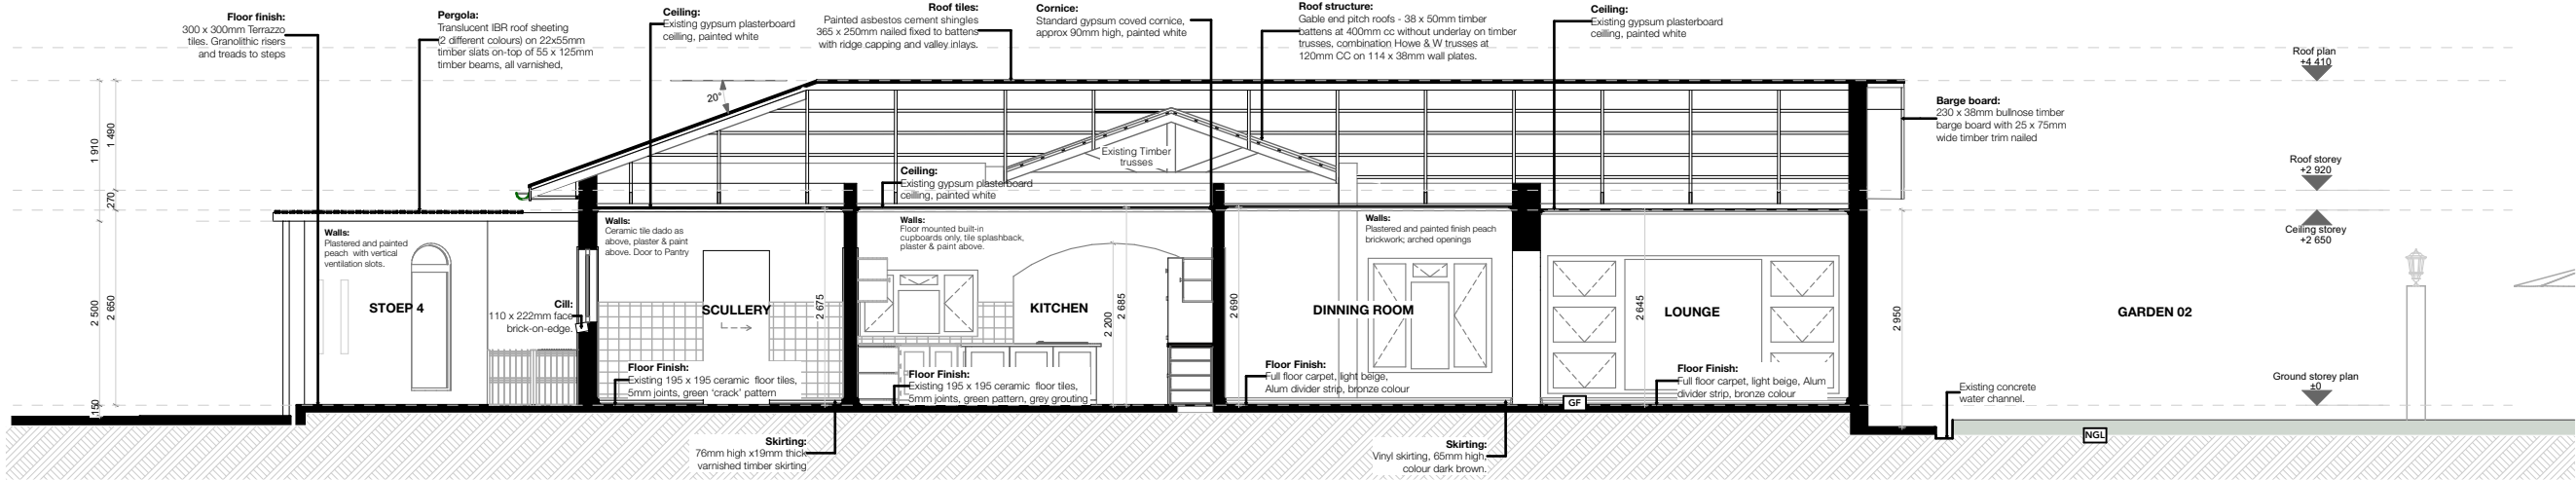

B 01

Building Section B 01

1:100

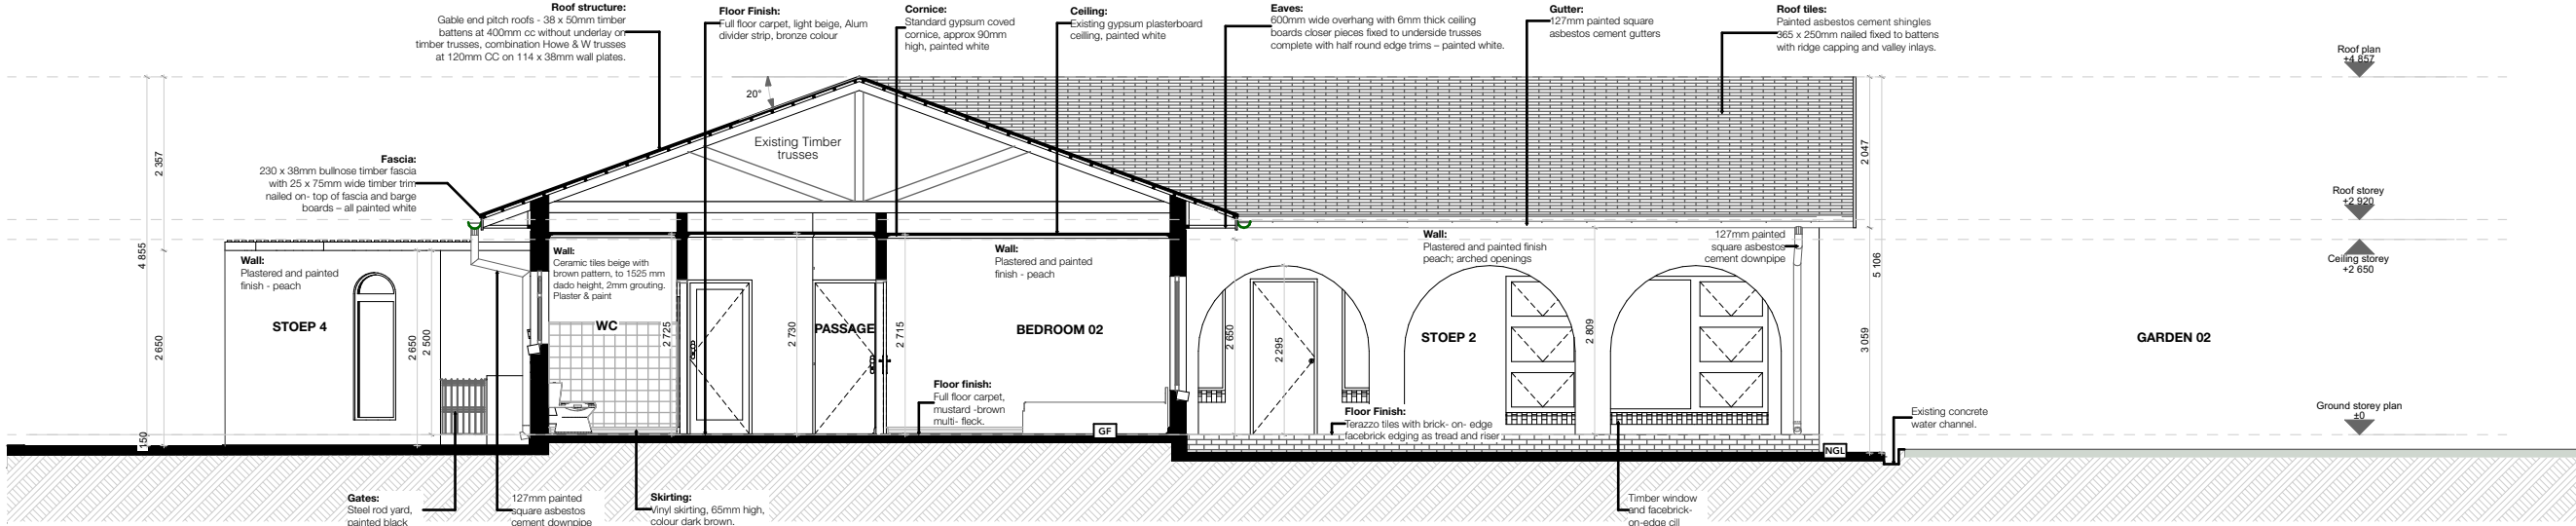

B 02

Building Section B 02

1:100



ARCHITECT:
**Osmond Lange
Architects and Planners
(Pty) Ltd
Cape Town**
Postal: PO Box 499, Bellville, 7535
Address: Tyger Terraces II, DJ Wood Way, Bellville, Cape Town
E-mail: cpl@o-l.co.za
Tel: +27 (0) 21 948 1877
Fax: +27 (0) 21 948 3455

BUILDING CLASSIFICATION
####

RESPONSIBLE PERSON

DESIGN BL / JDV

DRAWN BL / MK

CLIMATIC ZONE
####

DATE APPROVED

2025/08/19

RevID	ChID	Change Description	Date	IssID


PROJECT:
Nelson Mandela Prison House As Built
FOR Iziko Capitol Works
ON ERF: Portion 2 of Farm Watervliet No 942

PROJECT No.

220233

DRAWING NUMBER


REVISION

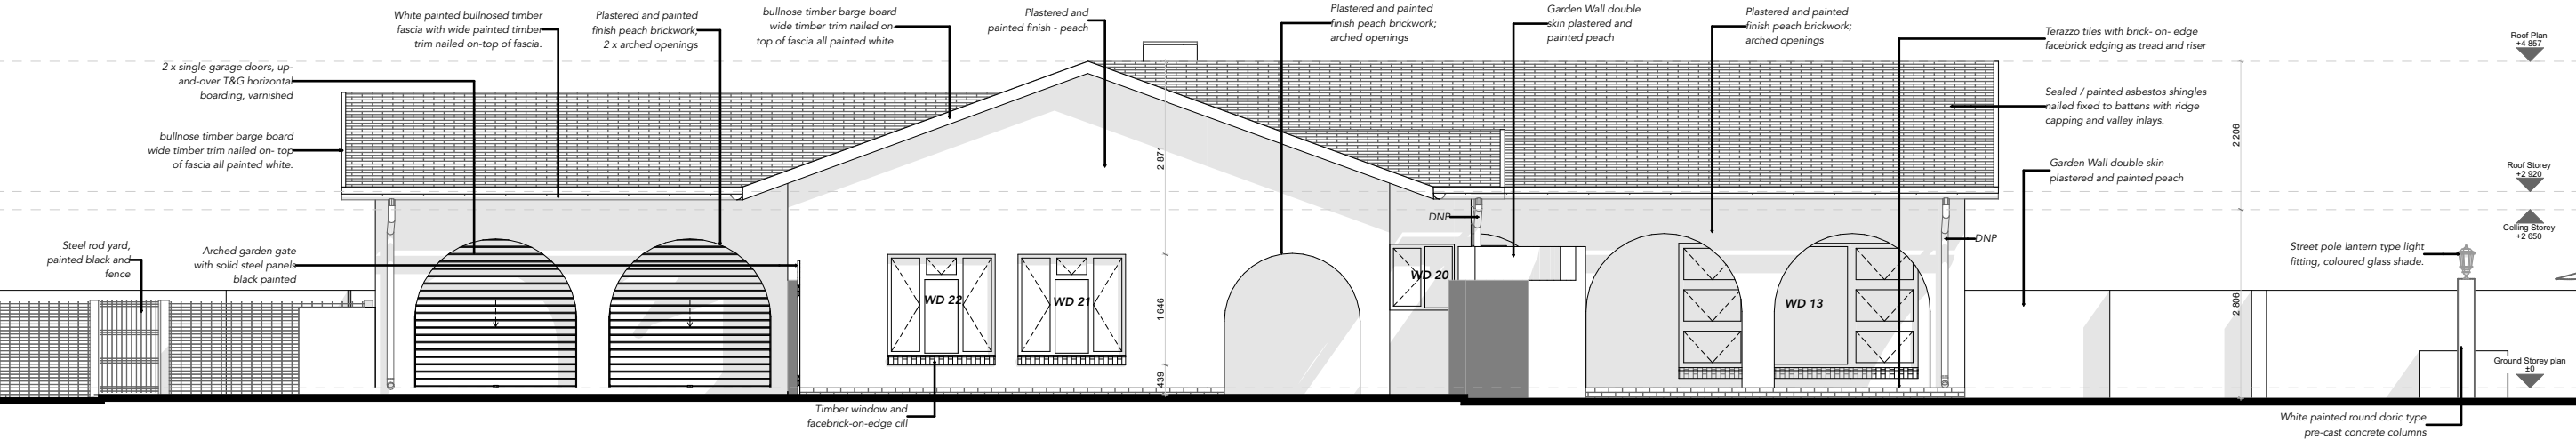

N

North Elevation

1:100

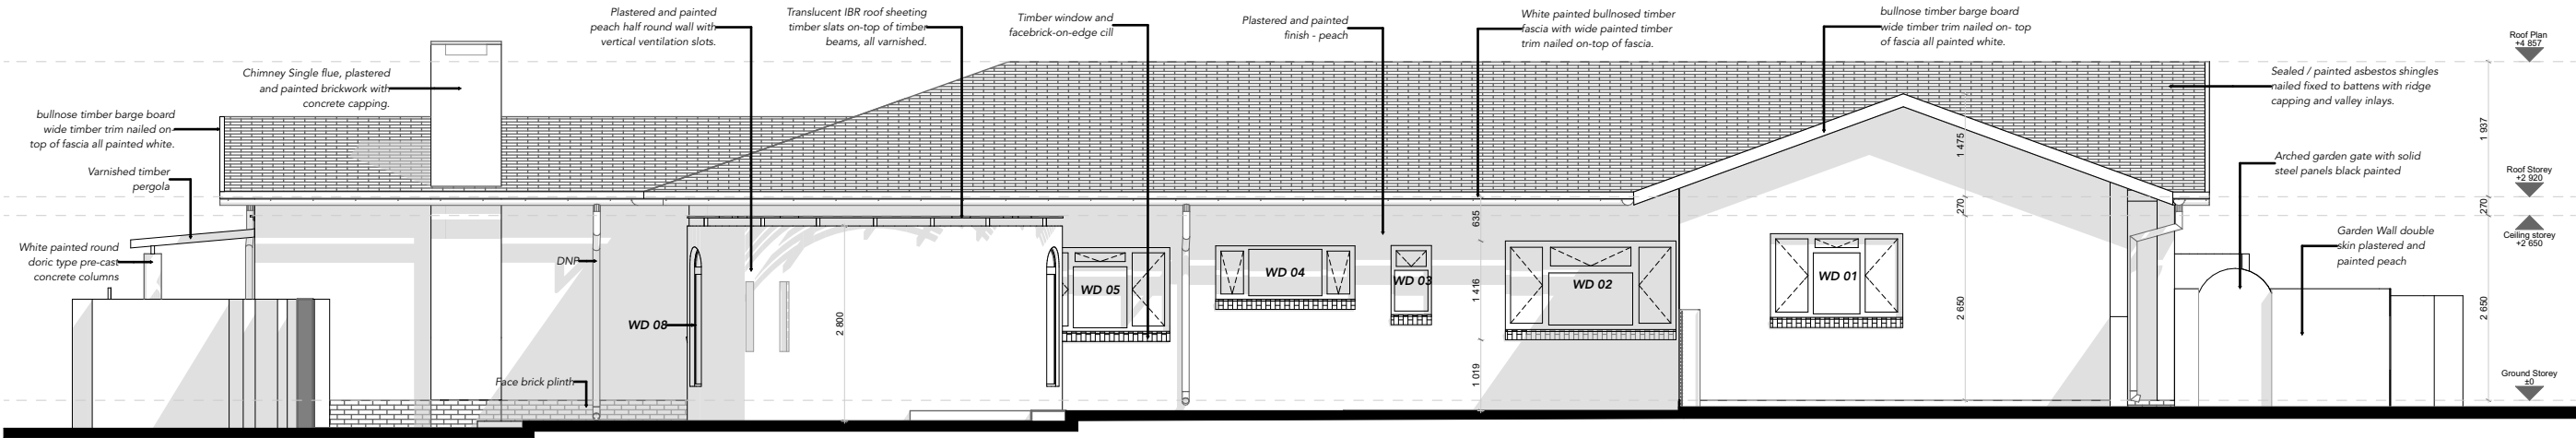

E

East Elevation

1:100



ARCHITECT:
**Osmond Lange
Architects and Planners
(Pty) Ltd
Cape Town**

Postal: PO Box 499, Bellville, 7535
Address: Tyger Terraces II, DJ Wood Way, Bellville, Cape Town
E-mail: cpt@o-l.co.za
Tel: +27 (0) 21 948 1877
Fax: +27 (0) 21 948 3455

BUILDING CLASSIFICATION
####

CLIMATIC ZONE
####

RESPONSIBLE PERSON

DATE APPROVED


DESIGN BL / JDV

2025/08/19

DRAWN BL / MK

RevID	ChID	Change Description	Date	IssID


PROJECT: Nelson Mandela Prison House As Built FOR Iziko Capitol Works ON ERF: Portion 2 of Farm Watervliet No 942		
PROJECT No. 220233	DRAWING NUMBER	REVISION

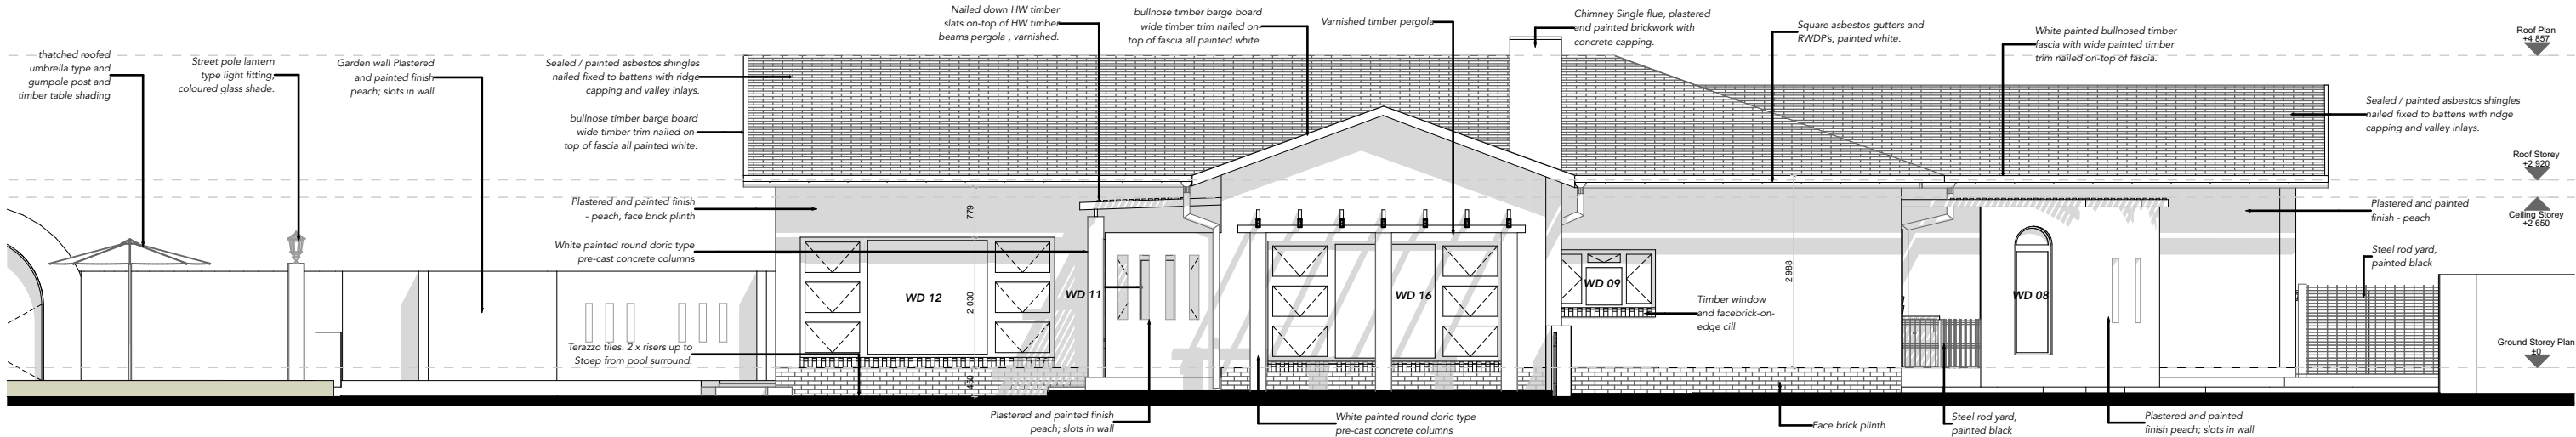

S

South Elevation


1:100

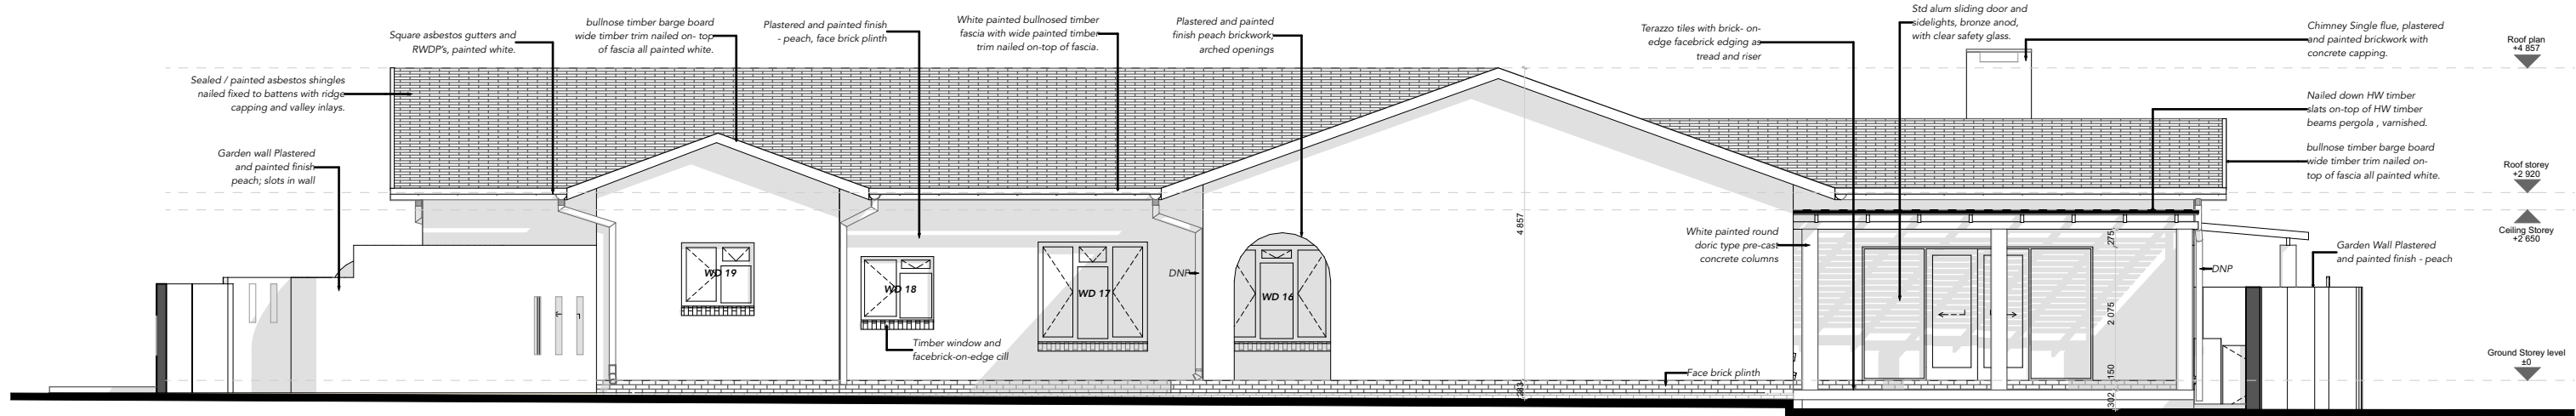

W

West Elevation

1:100

<div><div>OSMOND LANGE ARCHITECTS + PLANNERS</div></div> <div>ARCHITECT: Osmond Lange Architects and Planners (Pty) Ltd Cape Town</div> <div>Postal: PO Box 499, Bellville, 7535 Address: Tyger Terraces II, DJ Wood Way, Bellville, Cape Town E-mail: cpt@o-l.co.za Tel: +27 (0) 21 948 1877 Fax: +27 (0) 21 948 3455</div>	BUILDING CLASSIFICATION ####		CLIMATIC ZONE ####		<table><tr><td>RevID</td><td>ChID</td><td>Change Description</td><td>Date</td><td>IssID</td></tr><tr><td> </td><td> </td><td> </td><td> </td><td> </td></tr><tr><td> </td><td> </td><td> </td><td> </td><td> </td></tr><tr><td> </td><td> </td><td> </td><td> </td><td> </td></tr><tr><td> </td><td> </td><td> </td><td> </td><td> </td></tr><tr><td> </td><td> </td><td> </td><td> </td><td> </td></tr><tr><td> </td><td> </td><td> </td><td> </td><td> </td></tr><tr><td> </td><td> </td><td> </td><td> </td><td> </td></tr></table>		RevID	ChID	Change Description	Date	IssID																																				PROJECT: Nelson Mandela Prison House As Built FOR Iziko Capitol Works ON ERF: Portion 2 of Farm Watervliet No 942			
	RevID	ChID	Change Description	Date	IssID																																													
<table><tr><td> </td><td>RESPONSIBLE PERSON</td><td>DATE</td><td>APPROVED</td></tr><tr><td>DESIGN</td><td>BL / JDV</td><td>2025/08/19</td><td> </td></tr><tr><td>DRAWN</td><td>BL / MK</td><td> </td><td> </td></tr></table>			RESPONSIBLE PERSON	DATE	APPROVED	DESIGN	BL / JDV	2025/08/19		DRAWN	BL / MK					PROJECT No. 220233		DRAWING NUMBER		REVISION																														
	RESPONSIBLE PERSON	DATE	APPROVED																																															
DESIGN	BL / JDV	2025/08/19																																																
DRAWN	BL / MK																																																	