


Appendix B14– Terminal Blocks 2 LHP 109 UB and 1 LHP 002 AR / BN2

CONTROLLED DISCLOSURE




When downloaded from the document management system, this document is uncontrolled and the responsibility rests with the user to ensure it is in line with the authorized version on the system.

No part of this document may be reproduced without the expressed consent of the copyright holder, Eskom Holdings SOC Ltd, Reg No 2002/015527/30.

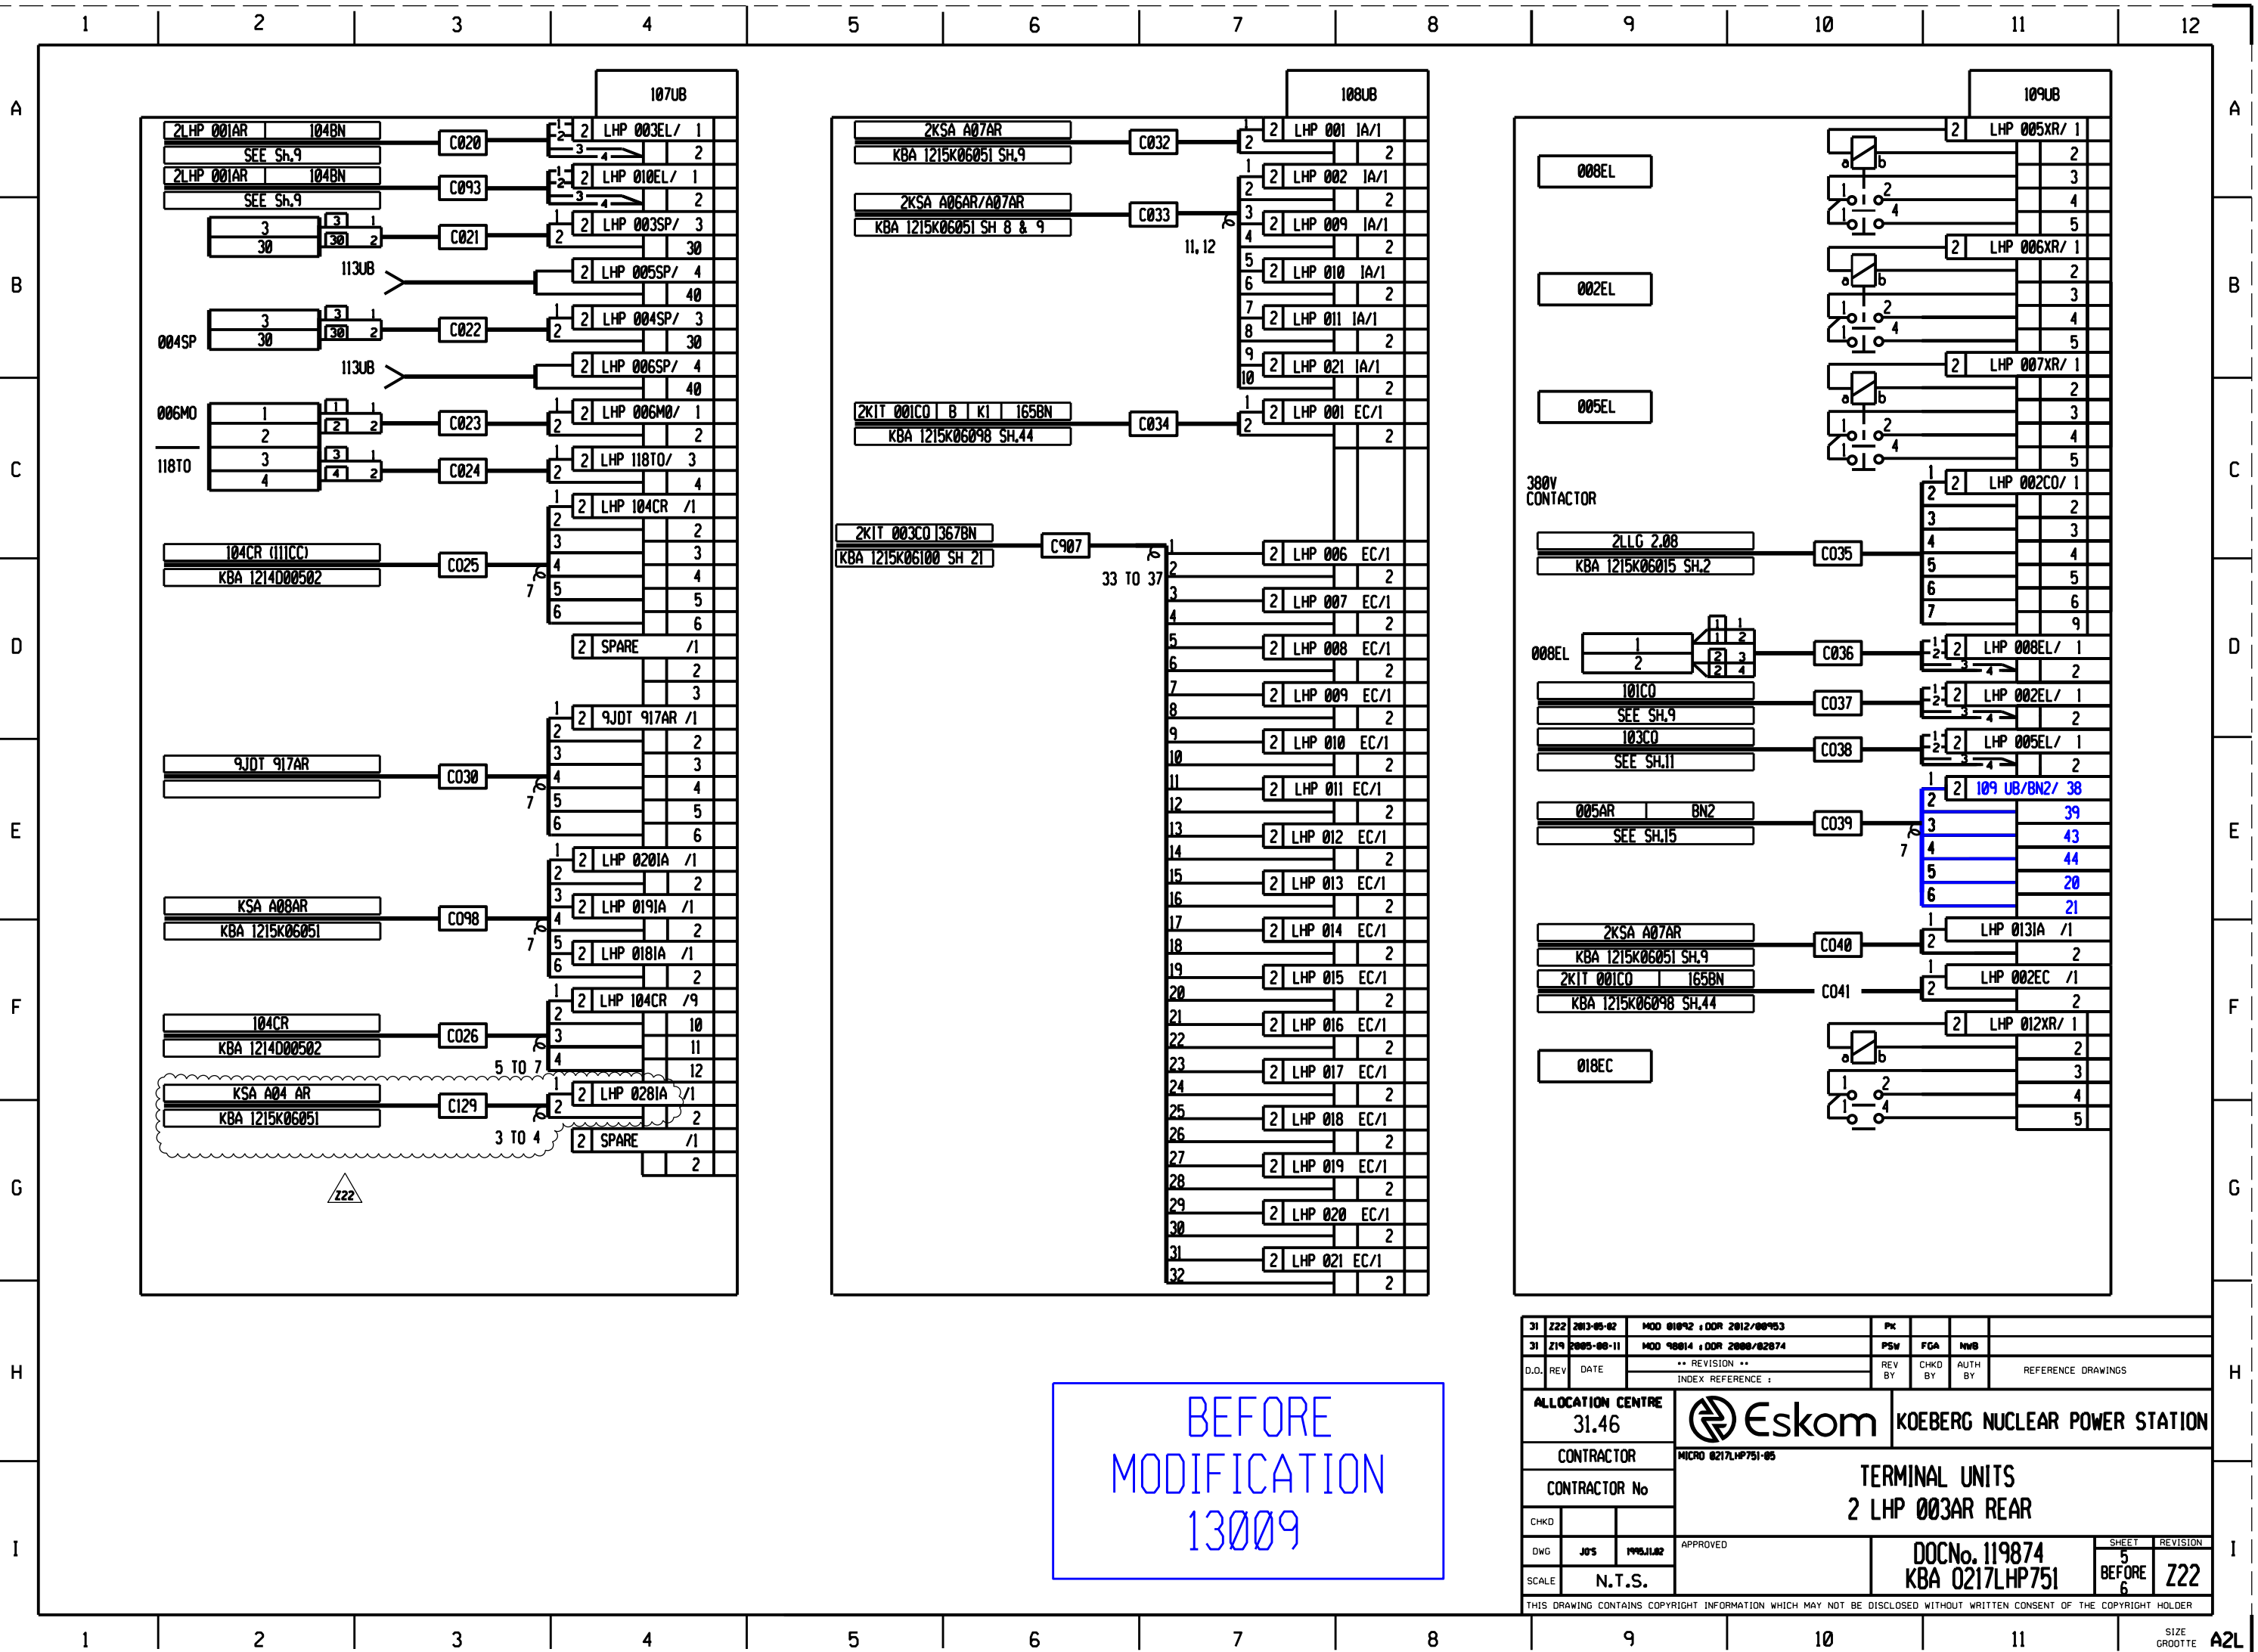

BEFORE
MODIFICATION
13009


31	222	2013-05-02	MOD 01092 : DOR 2012/00953	PK			
31	219	2005-08-11	MOD 98014 : DOR 2000/02074	PSW	FGA	NWB	
D.O.	REV	DATE	INDEX REFERENCE :	REV BY	CHKD BY	AUTH BY	REFERENCE DRAWINGS
ALLOCATION CENTRE			31.46	Eskom KOEBERG NUCLEAR POWER STATION			
CONTRACTOR			MICRO 0217LHP751-05	TERMINAL UNITS			
CONTRACTOR No				2 LHP 003AR REAR			
CHKD				APPROVED			
DWG	JOS	1995/11/02		DOCNo. 119874			
SCALE	N.T.S.			KBA 0217LHP751			
THIS DRAWING CONTAINS COPYRIGHT INFORMATION WHICH MAY NOT BE DISCLOSED WITHOUT WRITTEN CONSENT OF THE COPYRIGHT HOLDER							SHEET 5 BEFORE 6
							REVISION Z22

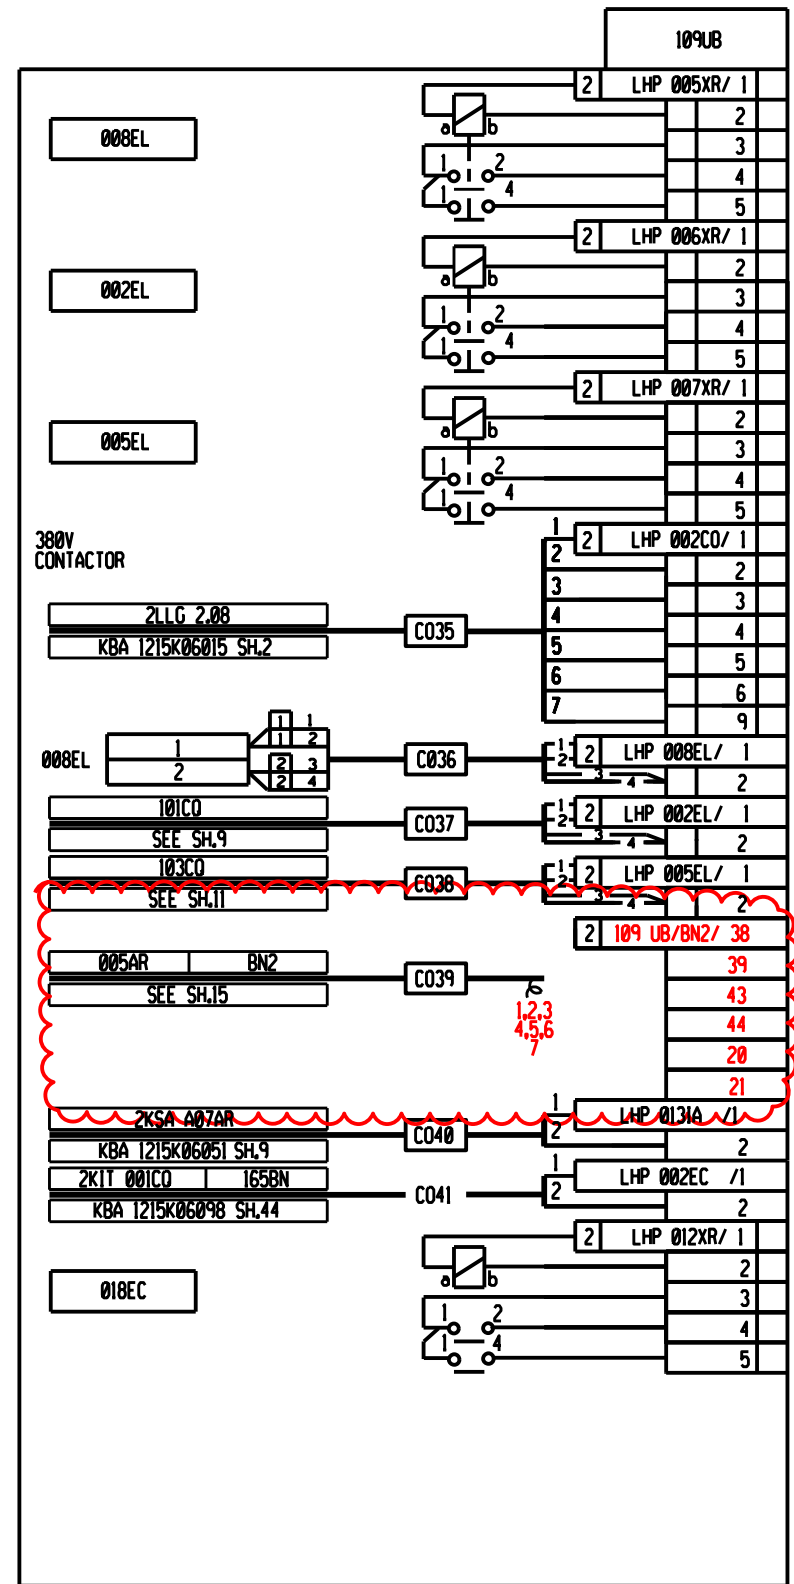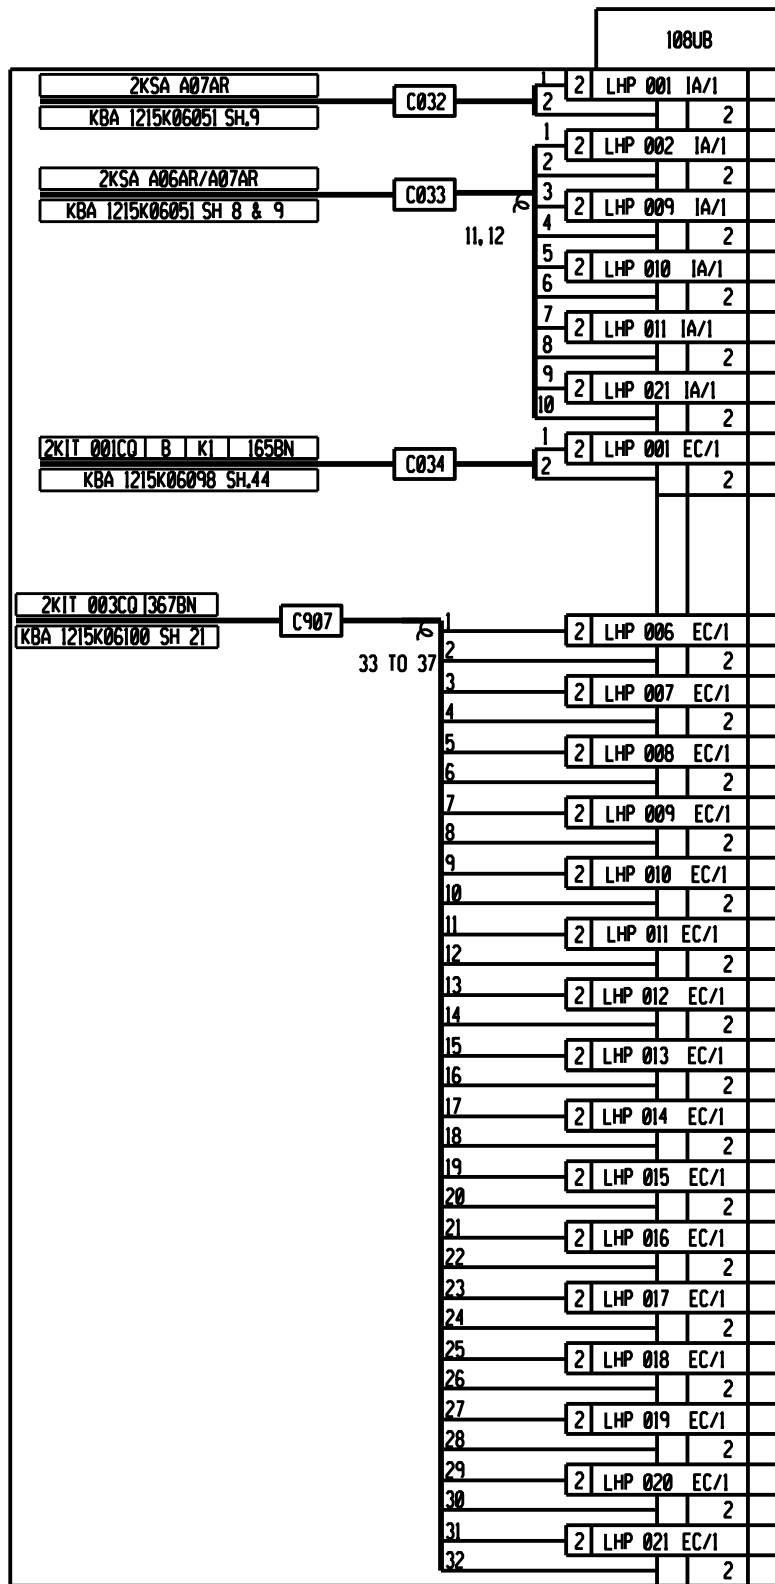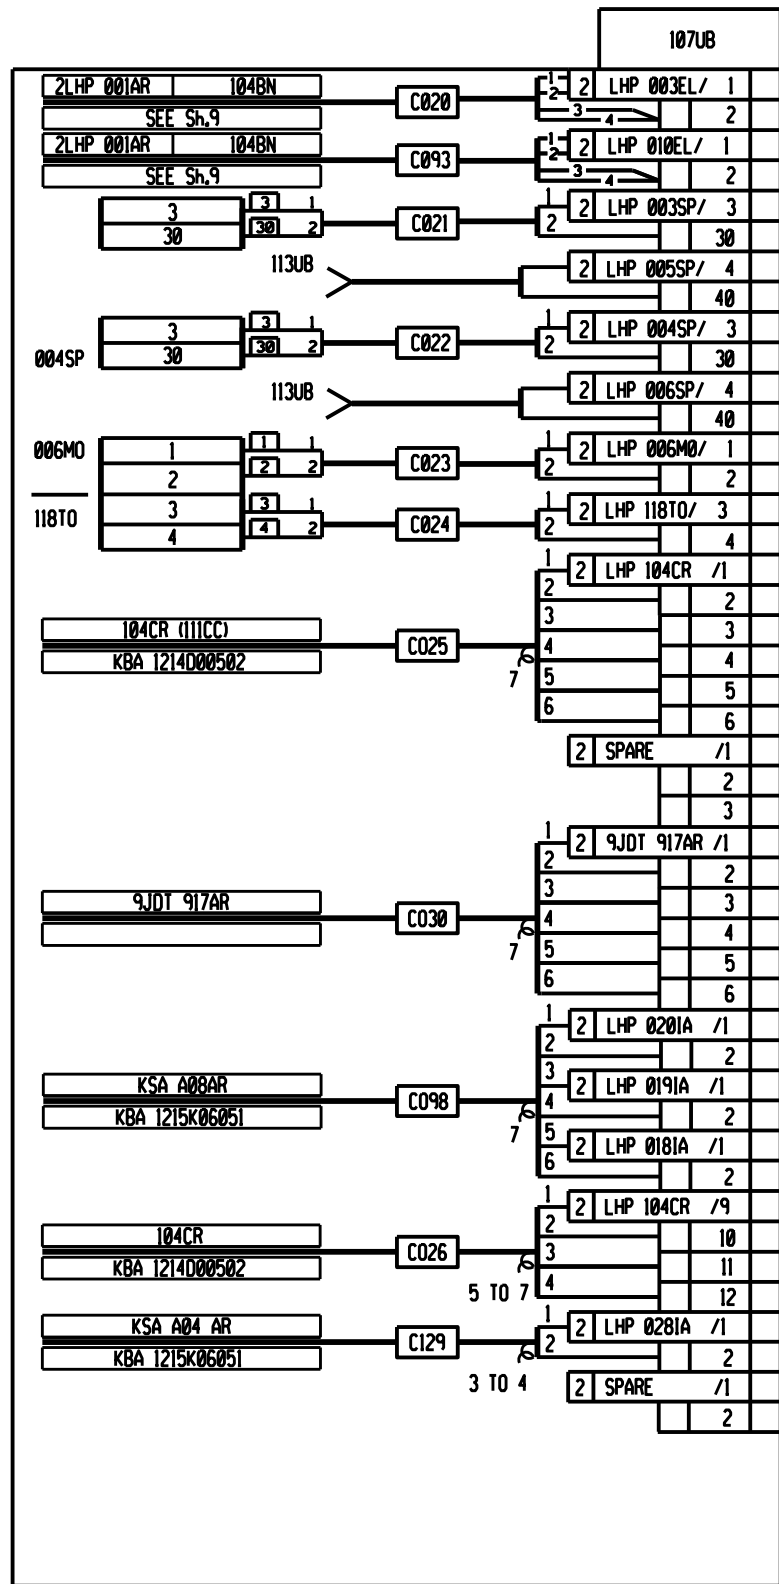

AFTER
MODIFICATION
13009

31	222	2013-05-02	MOD 01092 : DOR 2012/00953	PK					
31	219	2005-08-11	MOD 98014 : DOR 2000/02074	PSW	FCA	NWB			
D.O.	REV	DATE	** REVISION **	REV BY	CHKD BY	AUTH BY	REFERENCE DRAWINGS		
			INDEX REFERENCE :						
ALLOCATION CENTRE 31.46			 Eskom		KOEBERG NUCLEAR POWER STATION				
CONTRACTOR									
CONTRACTOR No			MICRO 0217LHP751-05						
			TERMINAL UNITS 2 LHP 003AR REAR						
CHKD			APPROVED			DOCNo. 119874		SHEET 5	REVISION
DWG	JOS	1998.11.02				KBA 0217LHP751		BEFORE 6	
SCALE	N.T.S.								222
THIS DRAWING CONTAINS COPYRIGHT INFORMATION WHICH MAY NOT BE DISCLOSED WITHOUT WRITTEN CONSENT OF THE COPYRIGHT HOLDER									

THIS DRAWING CONTAINS COPYRIGHT INFORMATION WHICH MAY NOT BE DISCLOSED WITHOUT WRITTEN CONSENT OF THE COPYRIGHT HOLDER

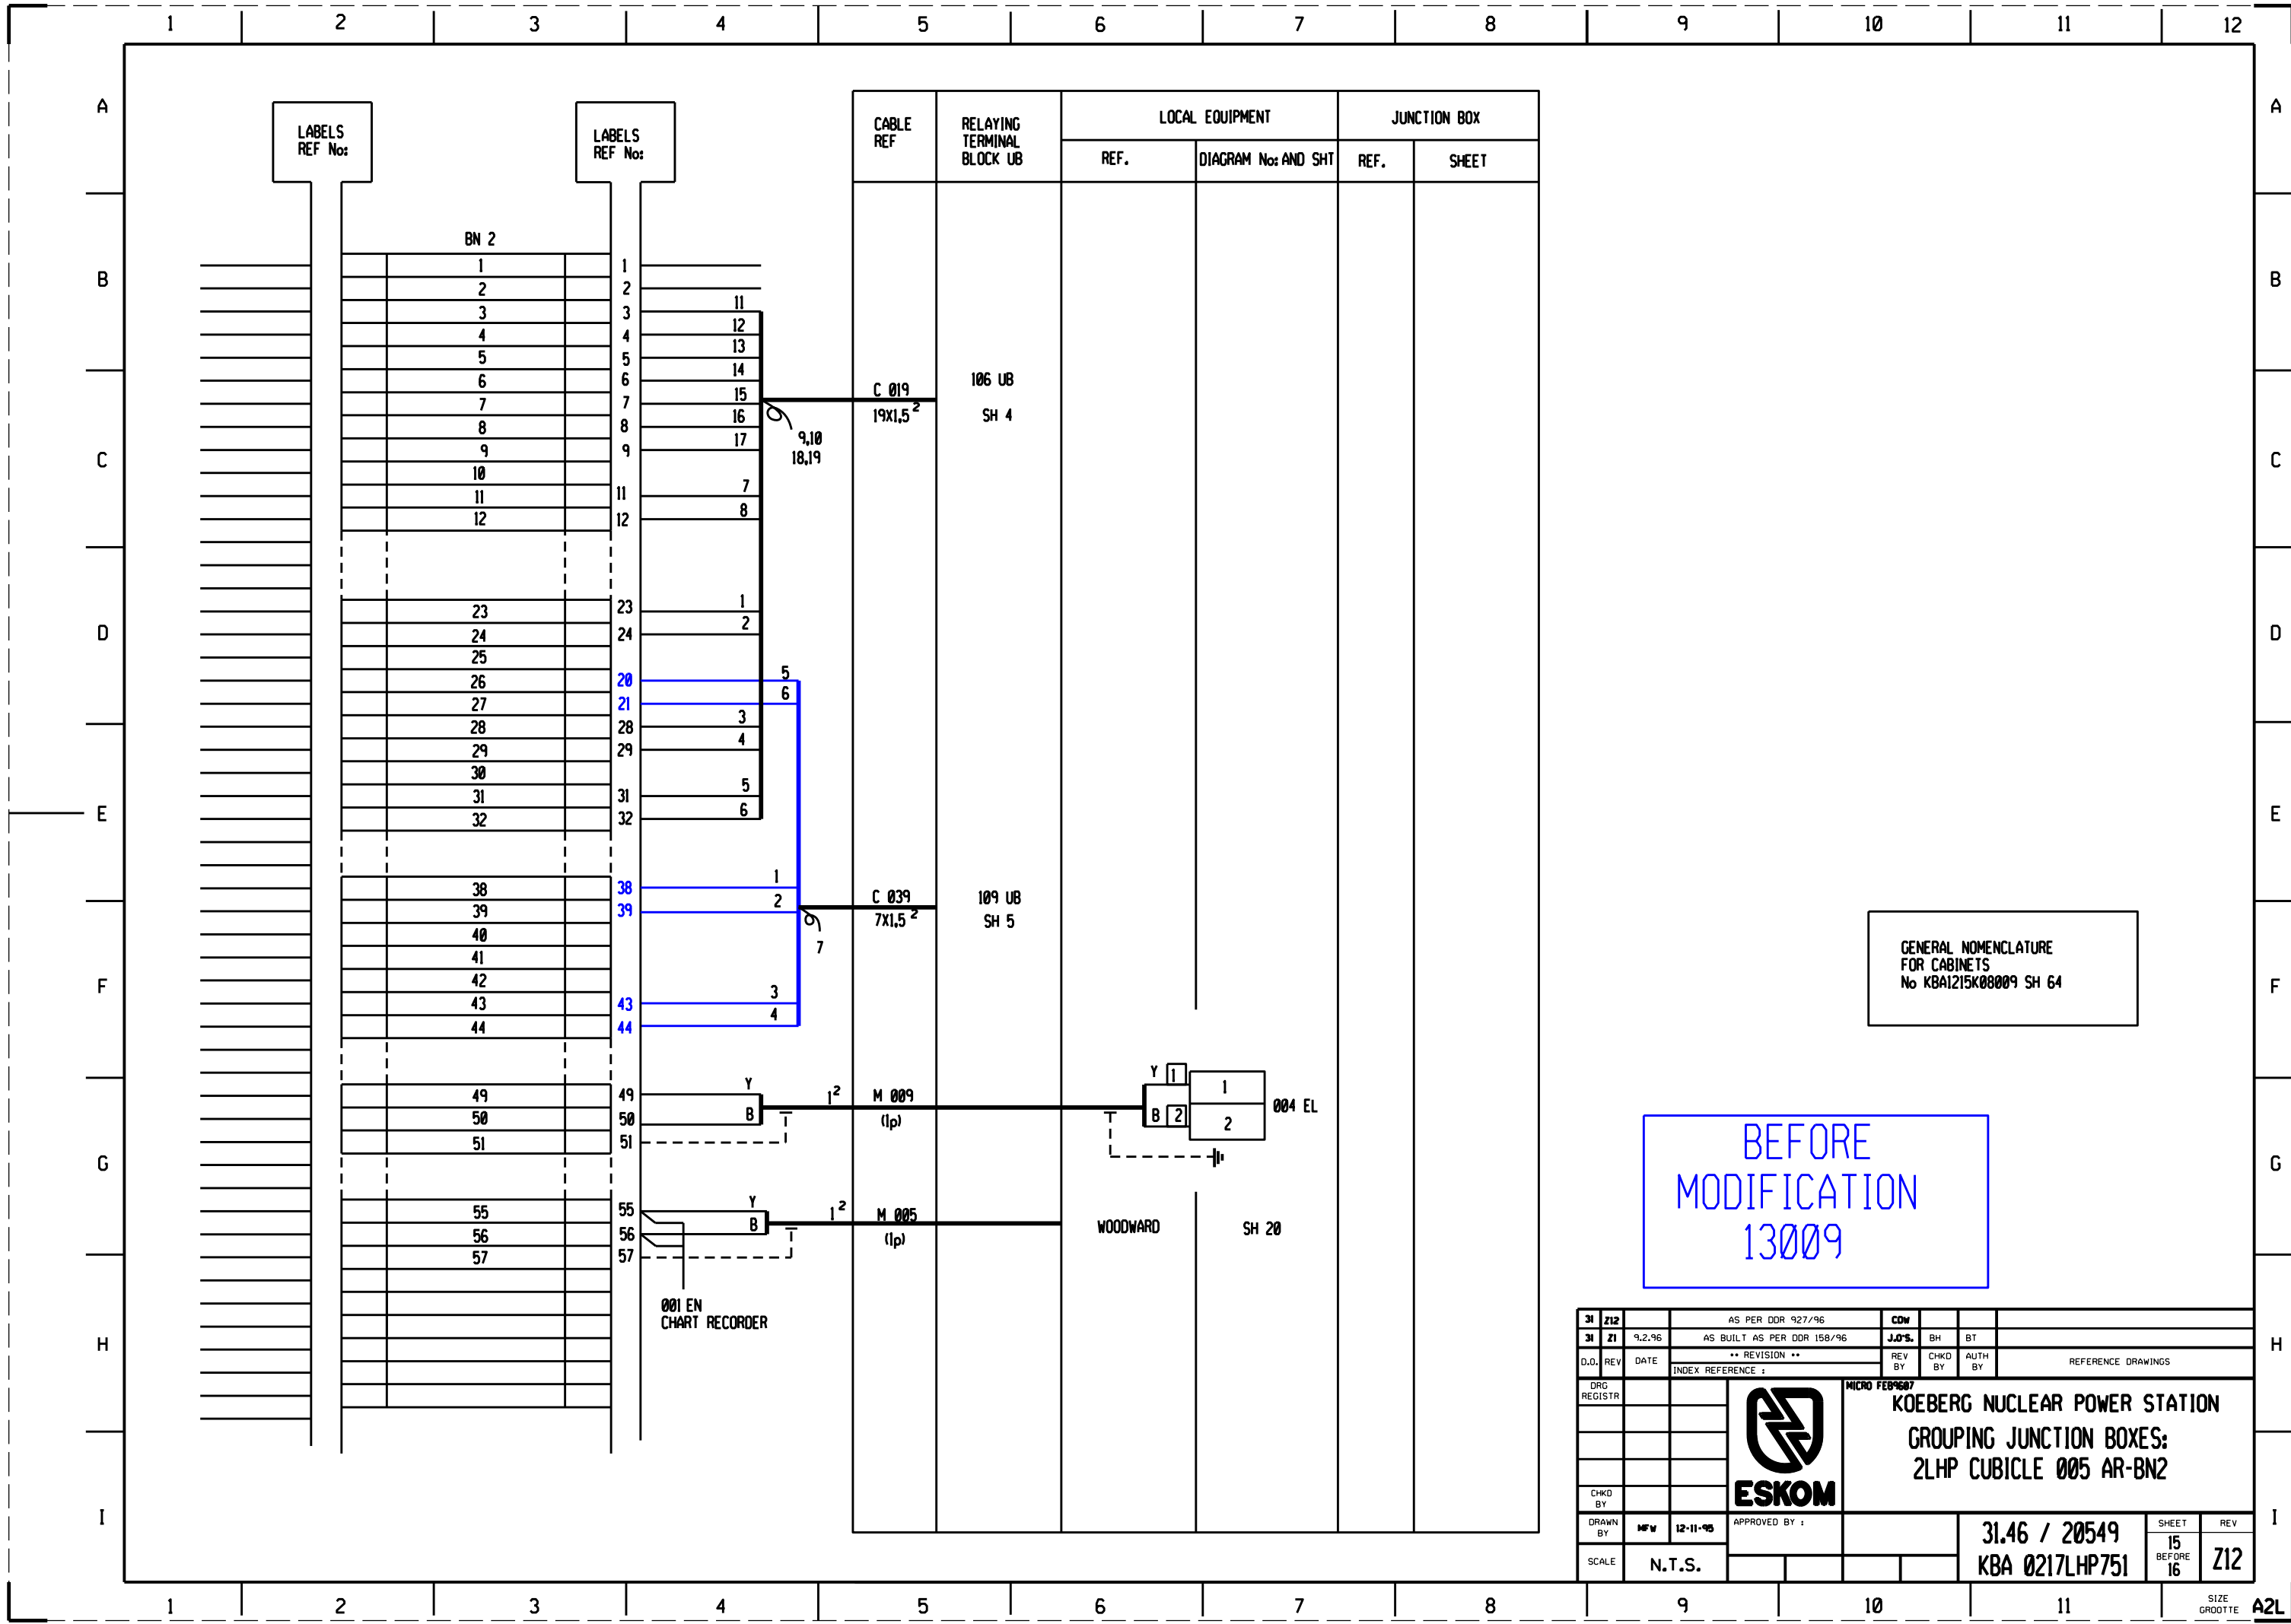

GENERAL NOMENCLATURE
FOR CABINETS
No KBA1215K00009 SH 64

BEFORE
MODIFICATION
13009

31	212		AS PER DDR 927/96		CDW					
31	21	9.2.96	AS BUILT AS PER DDR 158/96		J.O'S.	BH	BT			
D.O.	REV	DATE	** REVISION **		REV BY	CHKD BY	AUTH BY	REFERENCE DRAWINGS		
			INDEX REFERENCE :							
DRG	REGISTR				MICRO FEB 96 KOEBERG NUCLEAR POWER STATION GROUPING JUNCTION BOXES: 2LHP CUBICLE 005 AR-BN2					
CHKD BY										
DRAWN BY	MFV	12-11-96	APPROVED BY :		31.46 / 20549				SHEET	REV
SCALE	N.T.S.				KBA 0217LHP751				15 BEFORE 16	212

[illegible]