


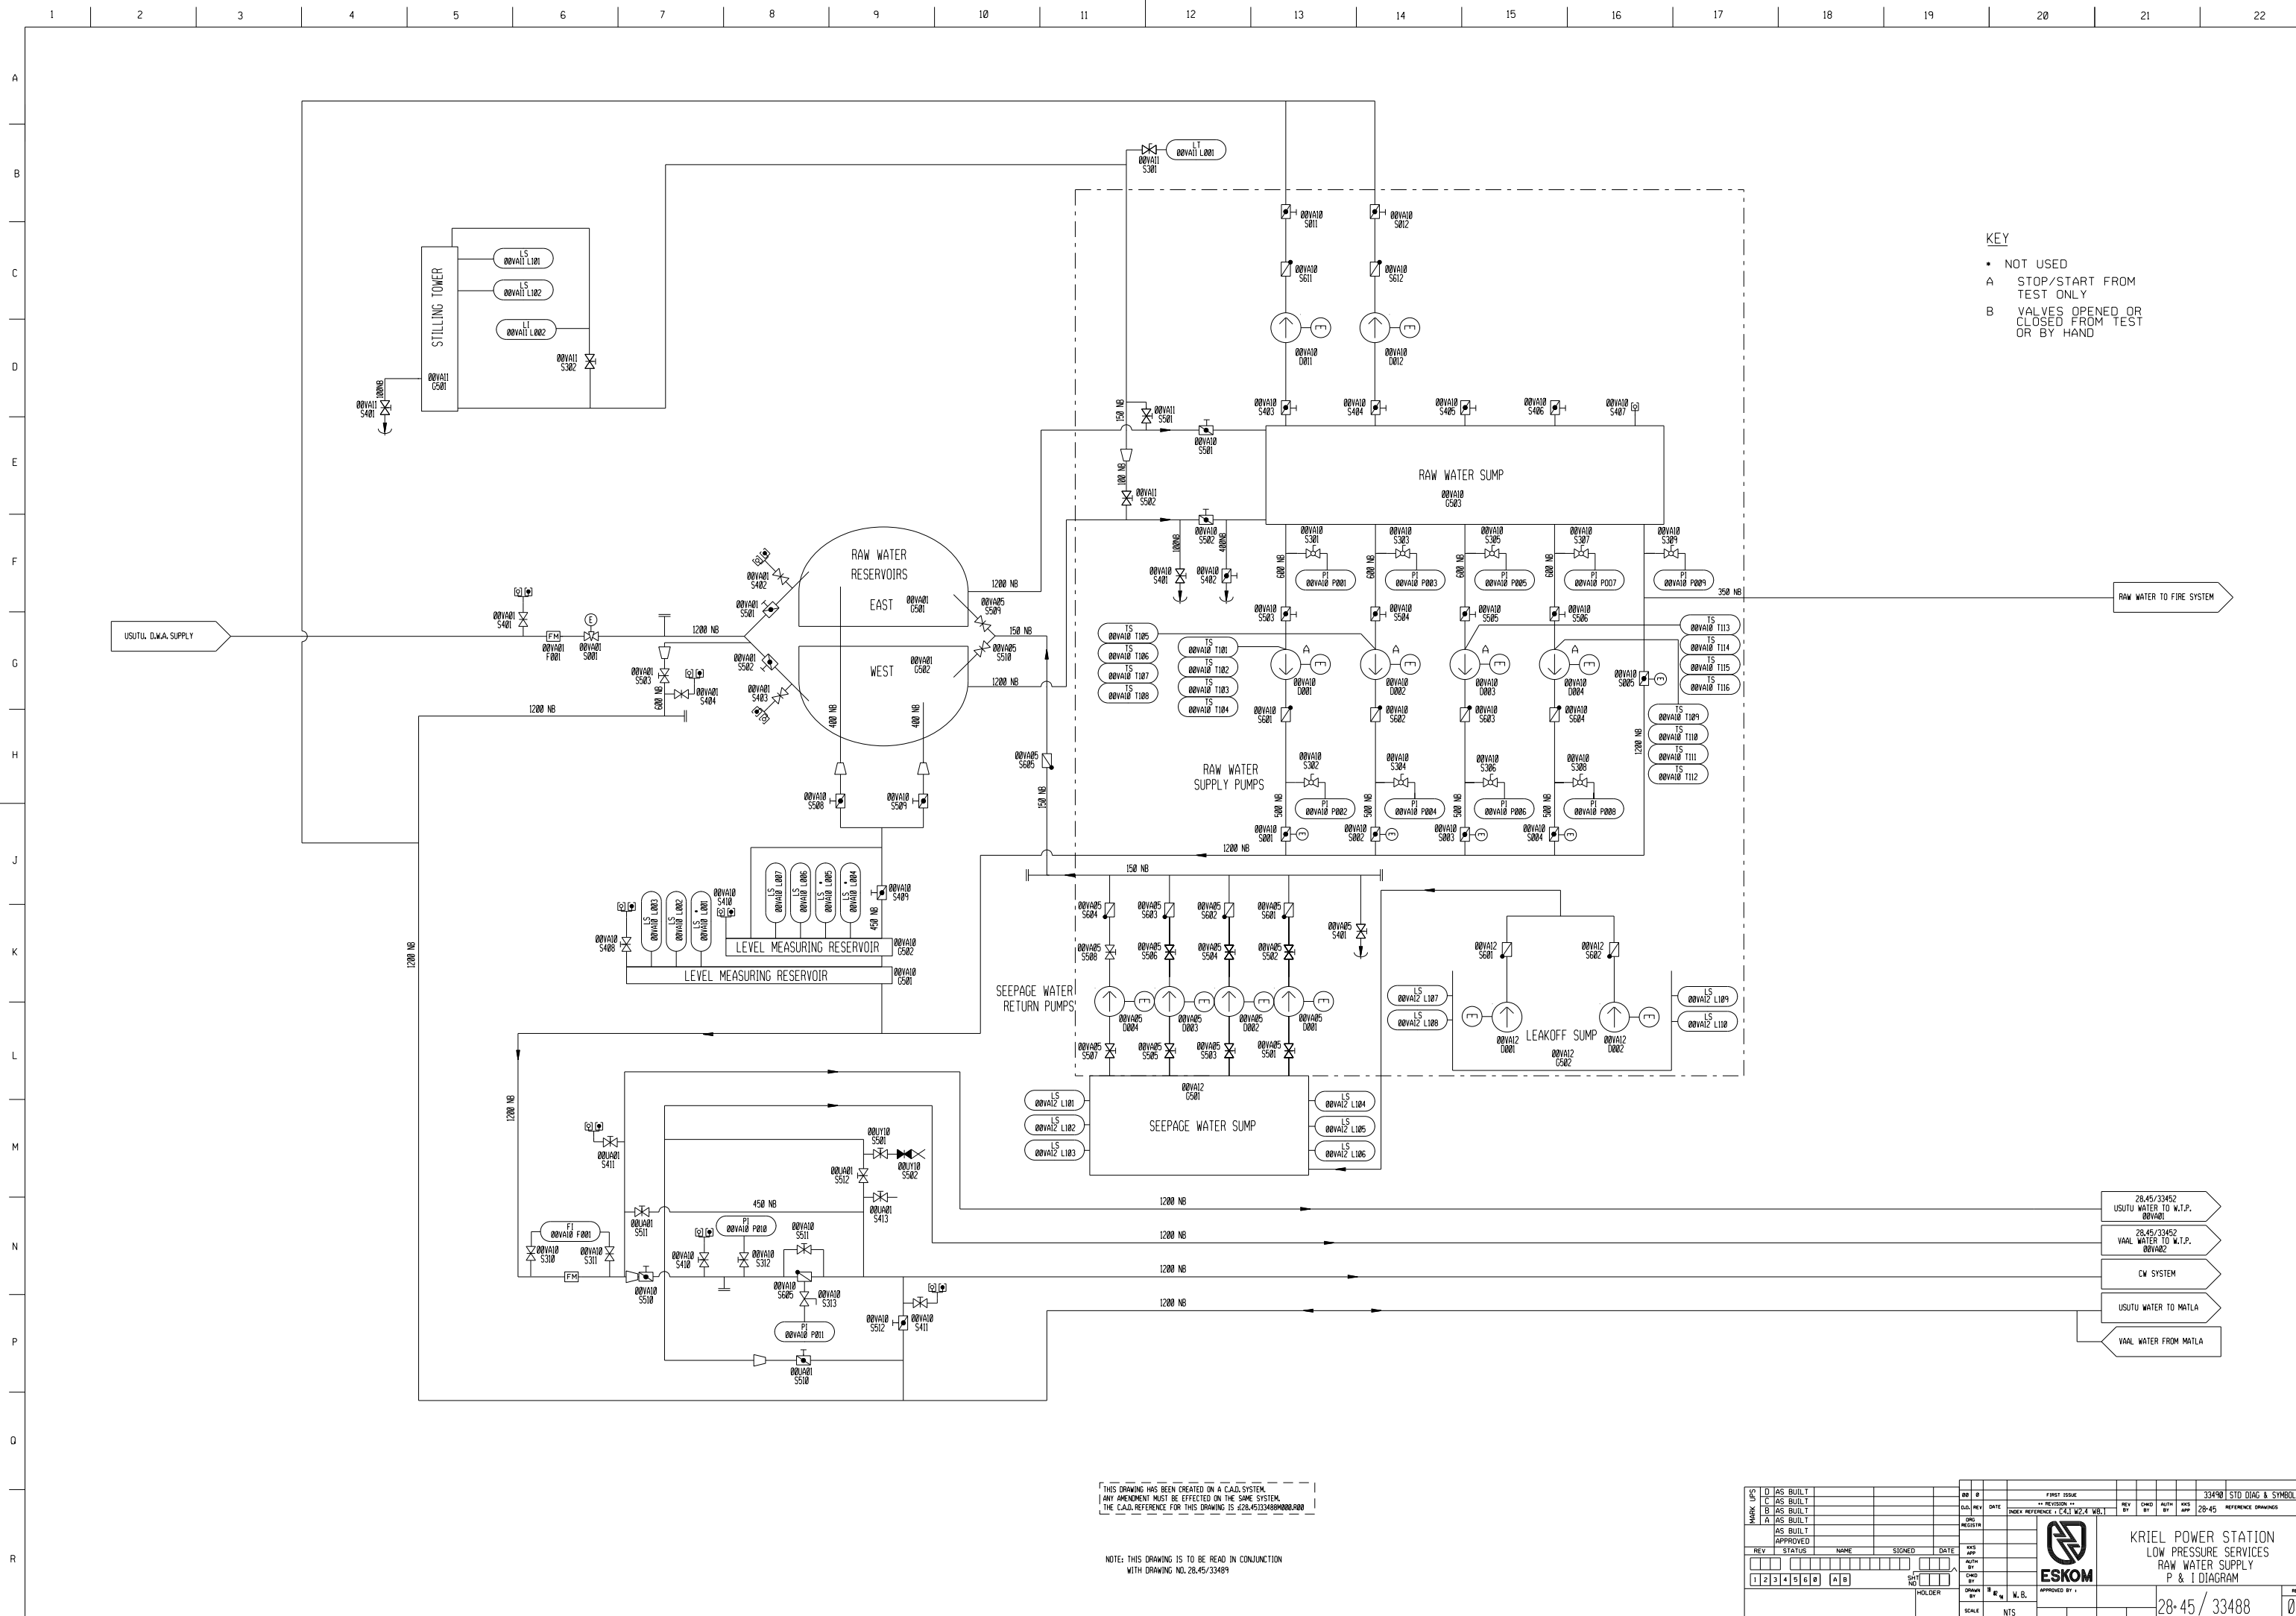

- KEY
- NOT USED
 - A STOP/START FROM TEST ONLY
 - B VALVES OPENED OR CLOSED FROM TEST OR BY HAND

THIS DRAWING HAS BEEN CREATED ON A CAD SYSTEM.
ANY AMENDMENT MUST BE EFFECTED ON THE SAME SYSTEM.
THE CAD REFERENCE FOR THIS DRAWING IS 428.4513348000000000

NOTE: THIS DRAWING IS TO BE READ IN CONJUNCTION
WITH DRAWING NO. 28.45/33489

UP		D AS BUILT				REV		DATE		FIRST ISSUE		REV		DATE		INDEX REFERENCE		28.45/33488		STD DIAG & SYMBOLS	
D		AS BUILT				REV		DATE		INDEX REFERENCE		REV		DATE		INDEX REFERENCE		28.45/33488		STD DIAG & SYMBOLS	
C		AS BUILT				REV		DATE		INDEX REFERENCE		REV		DATE		INDEX REFERENCE		28.45/33488		STD DIAG & SYMBOLS	
B		AS BUILT				REV		DATE		INDEX REFERENCE		REV		DATE		INDEX REFERENCE		28.45/33488		STD DIAG & SYMBOLS	
A		AS BUILT				REV		DATE		INDEX REFERENCE		REV		DATE		INDEX REFERENCE		28.45/33488		STD DIAG & SYMBOLS	
AS BUILT						REV		DATE		INDEX REFERENCE		REV		DATE		INDEX REFERENCE		28.45/33488		STD DIAG & SYMBOLS	
APPROVED						REV		DATE		INDEX REFERENCE		REV		DATE		INDEX REFERENCE		28.45/33488		STD DIAG & SYMBOLS	
STATUS						REV		DATE		INDEX REFERENCE		REV		DATE		INDEX REFERENCE		28.45/33488		STD DIAG & SYMBOLS	
1		2		3		4		5		6		7		8		9		10		11	
1		2		3		4		5		6		7		8		9		10		11	
