




1:100 SECTION A-A

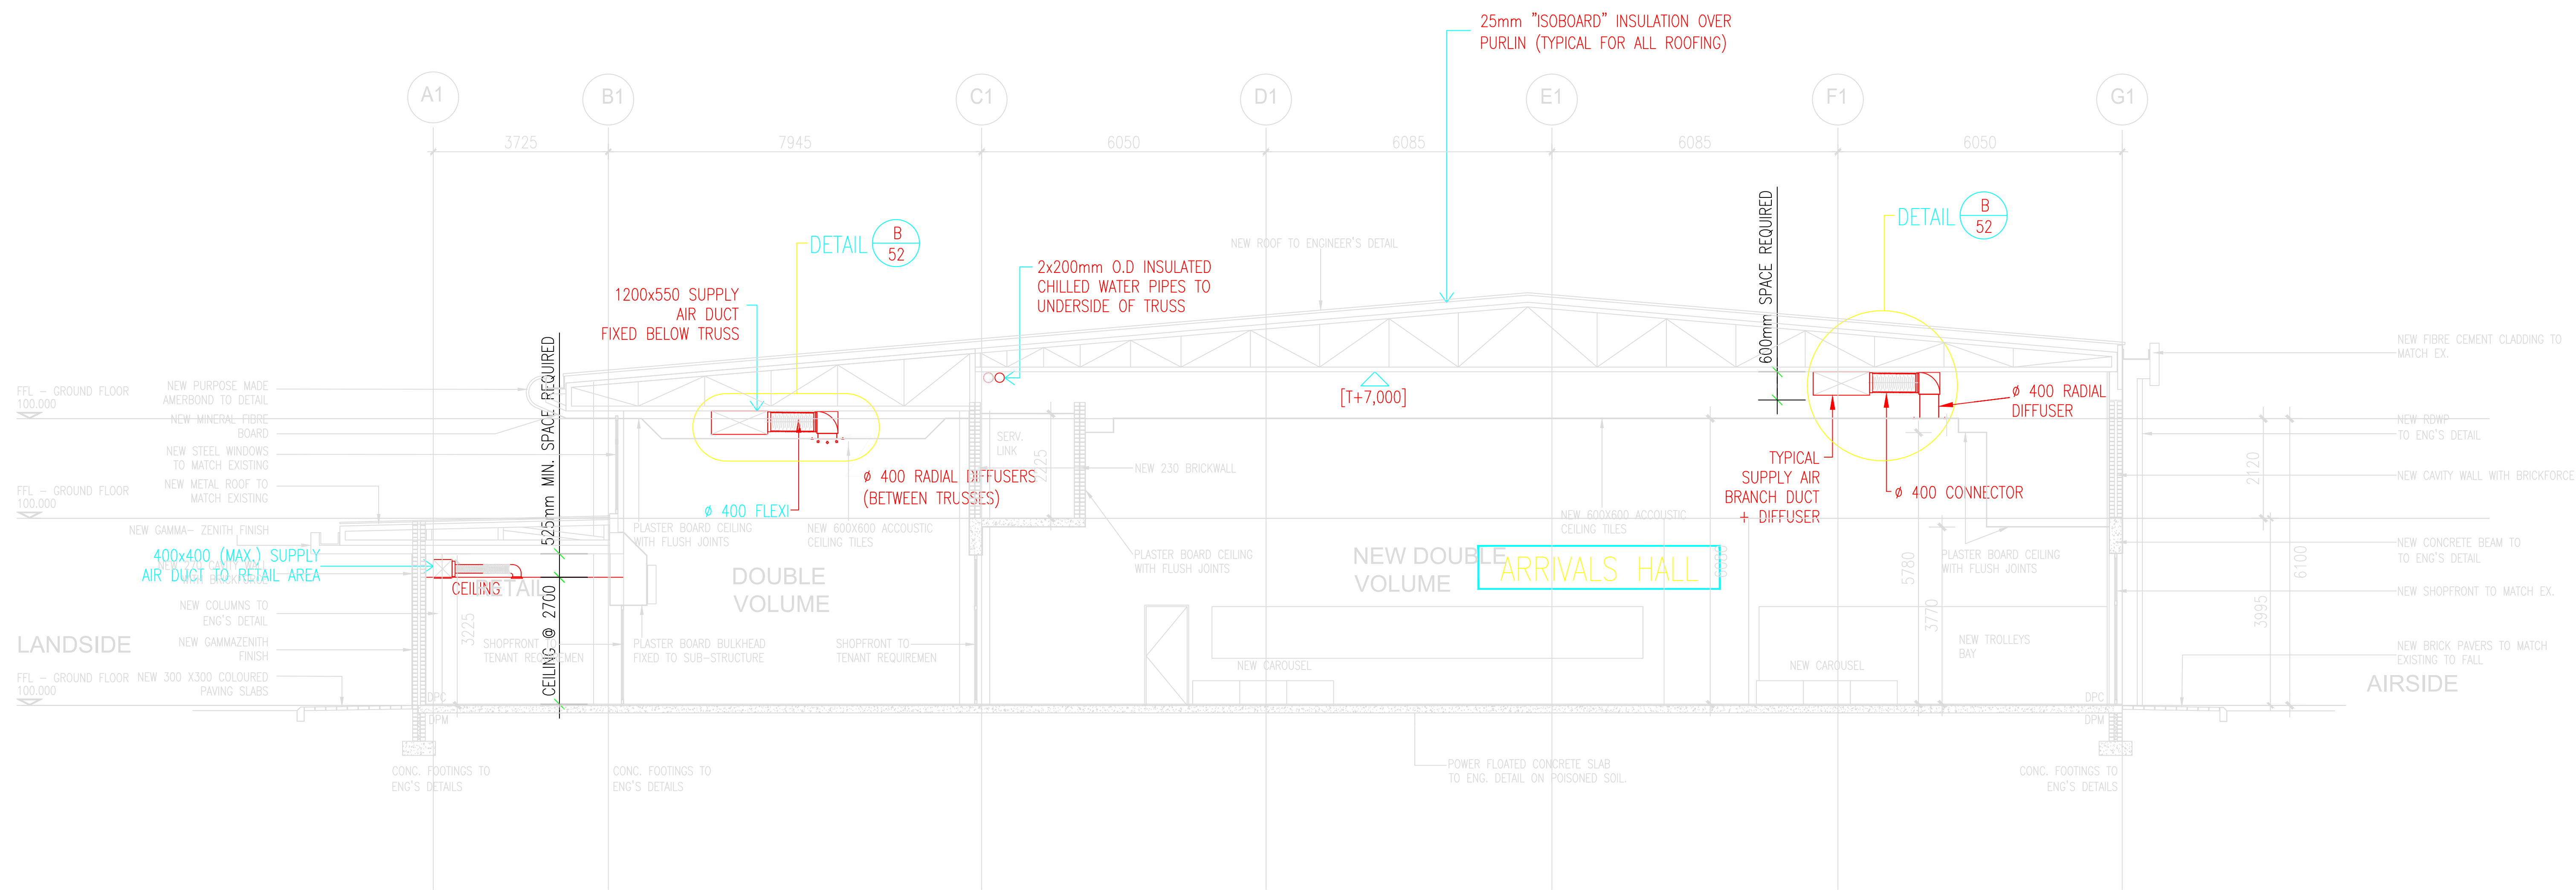

1:100 SECTION B-B

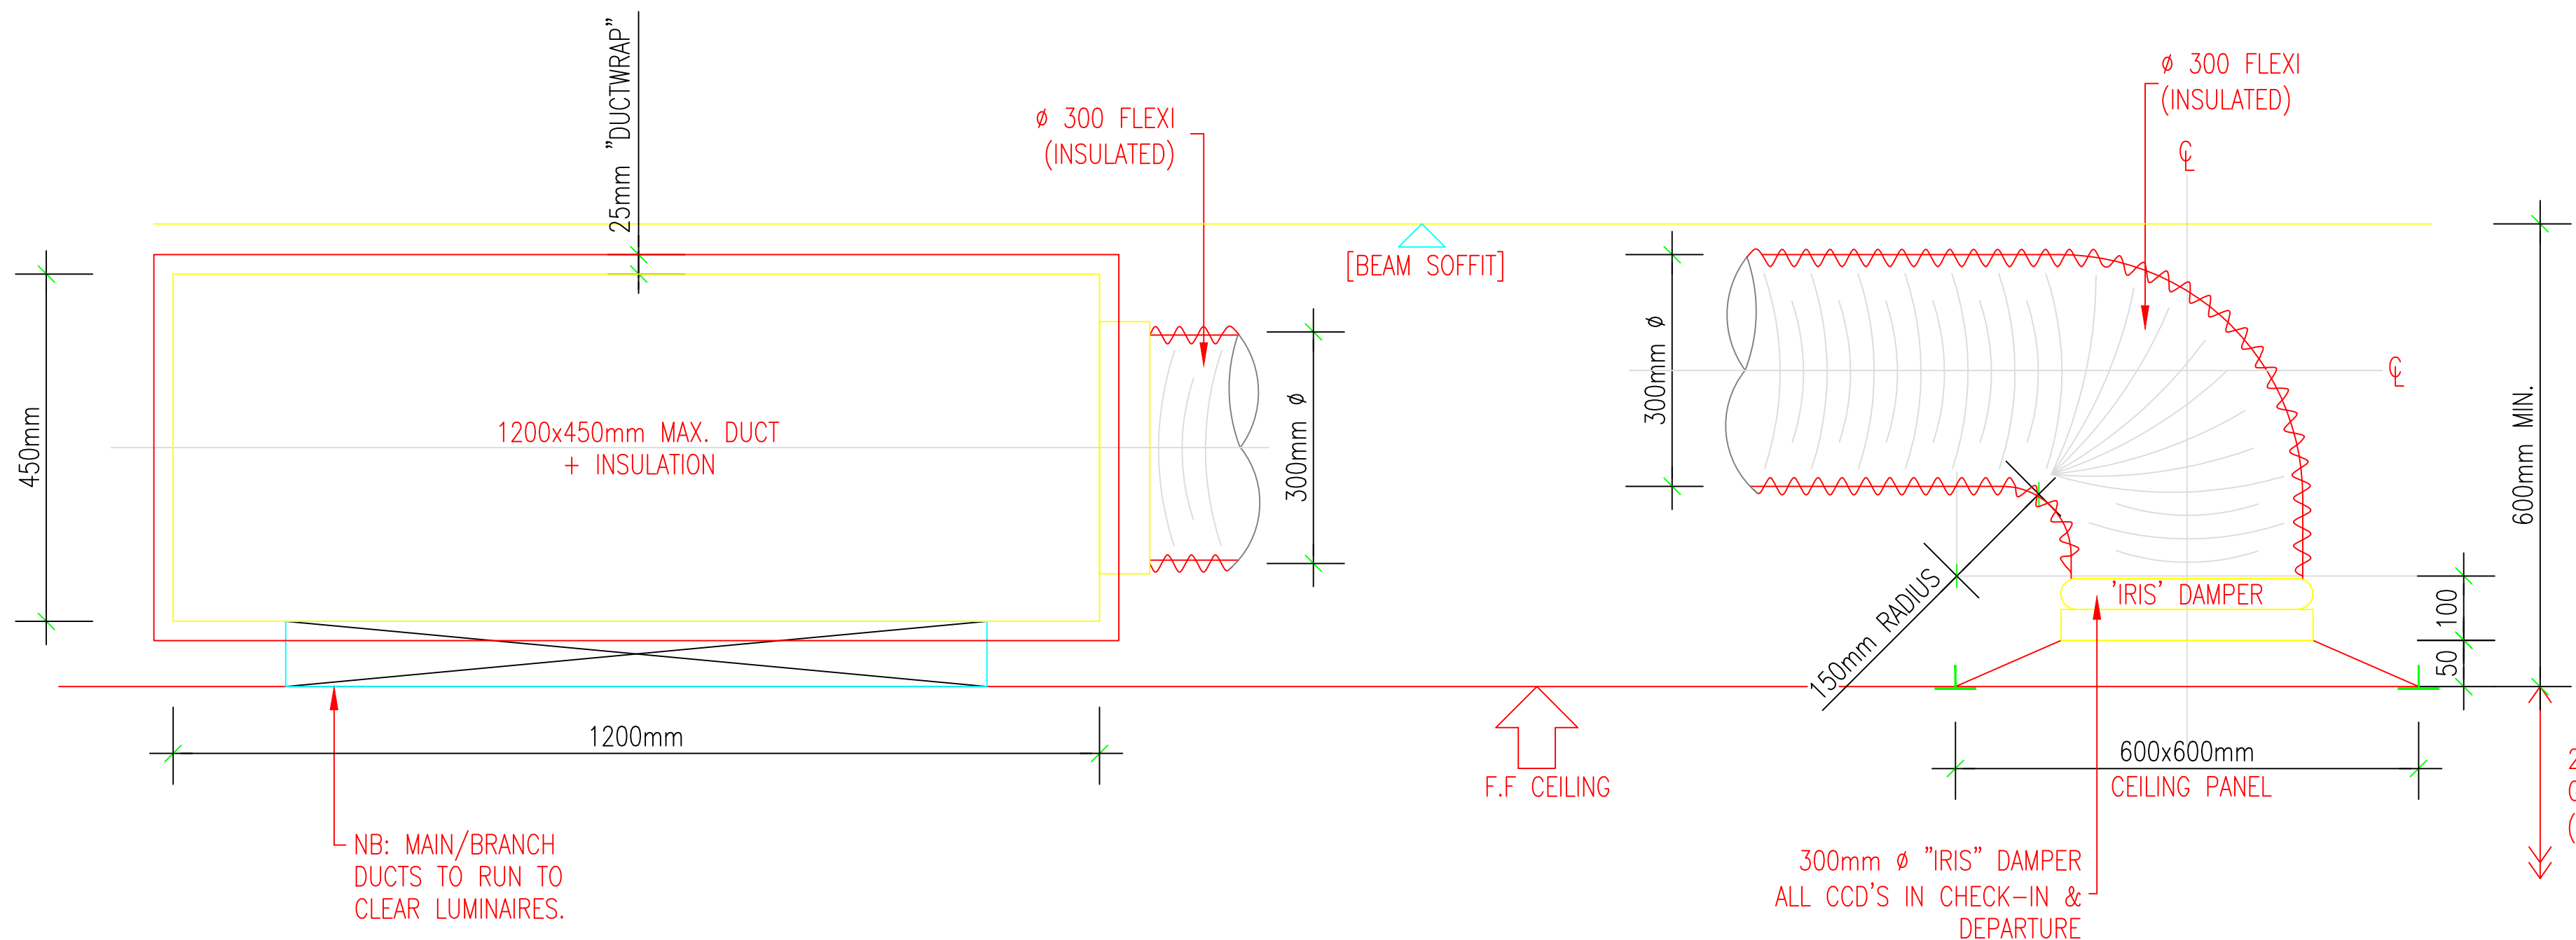

1:10 DETAIL A

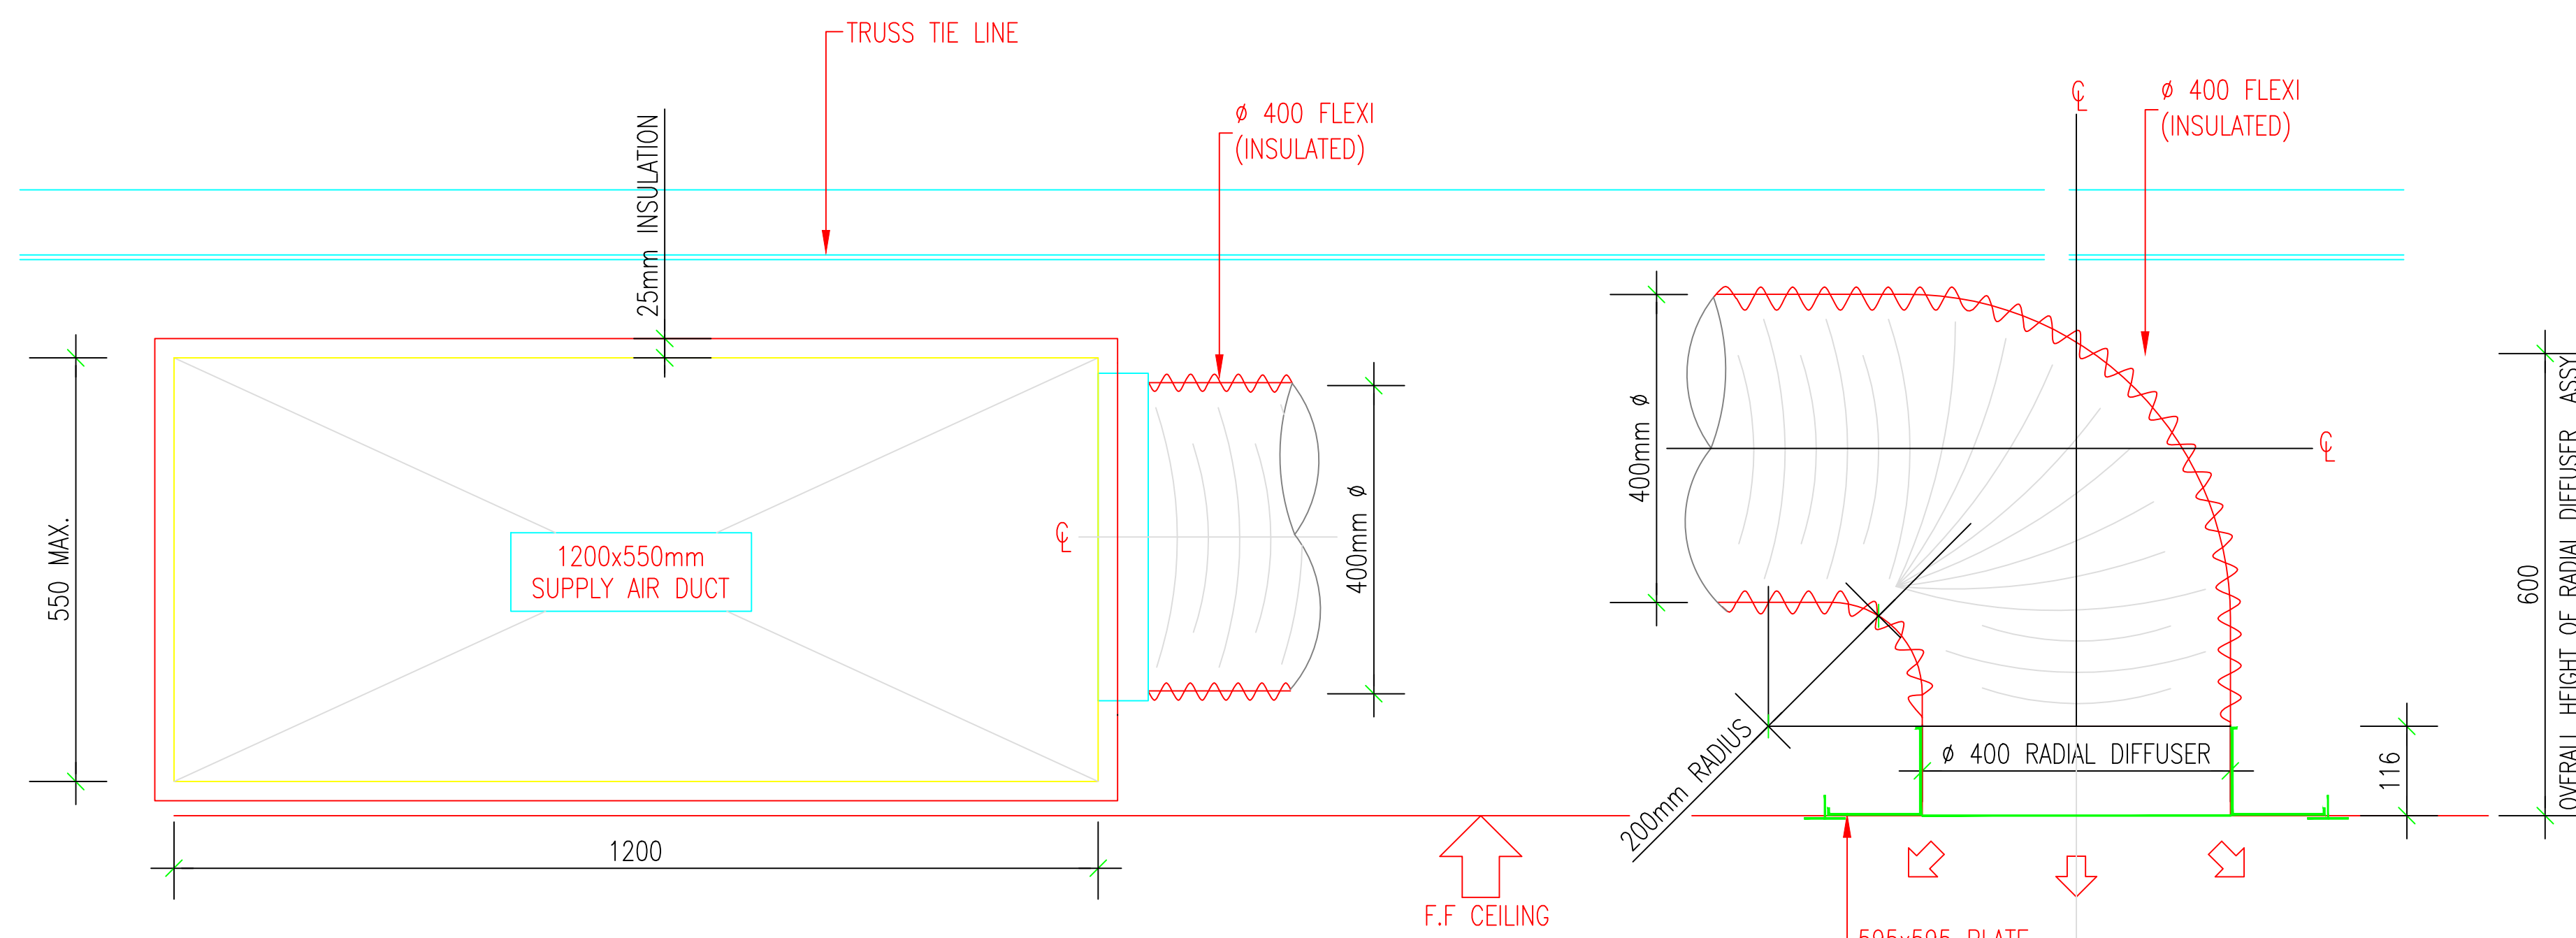


1:10 DETAIL B

	INITIALS	SIGN	DATE
DESIGNED			
DRAWN	TM		10.10.05
PROJECT ENG.	CvG		
APPROVED	AC		



PO BOX 94 CAPE TOWN TEL : (021) 421 8940

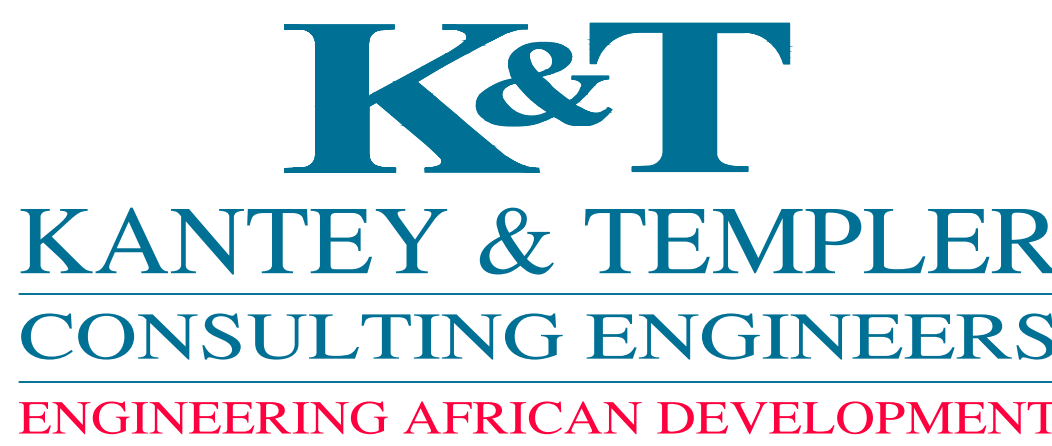


PO BOX 3132 CAPE TOWN 8000 TEL : (021) 405 9600

CLIENT



REVISION	DESCRIPTION	BY	DATE
2	AS BUILT	ES	02/05/07
1		PJS	09/05/06

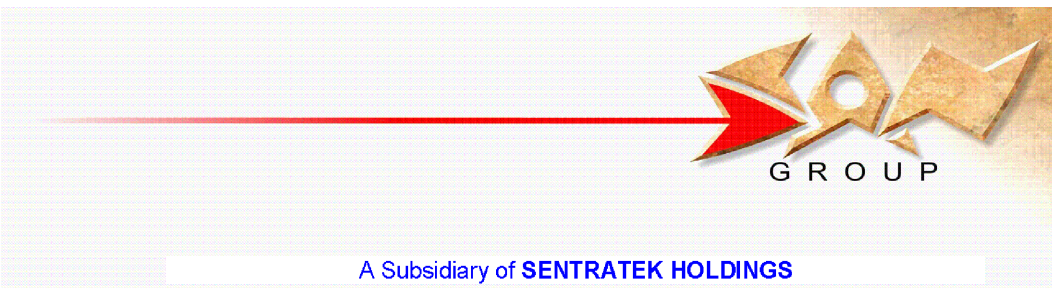

APPROVED BY	MECHANICAL:	MvZ	DATE:	03/05/07
	ELECTRICAL:	MvZ	DATE:	03/05/07
	PROJECT LEADER:	MvZ	DATE:	03/05/07
	CONSULTANT:	AC	DATE:	03/05/07

PROJECT DESCRIPTION
AS BUILT NEW ADDITIONS
TO THE TERMINAL BUILDINGS
GEORGE AIRPORT - PHASE 3

SERVICE
AIR CONDITIONING DETAILS
(SECTION A-A & SECTION B-B)

DESIGN PJS	DATE	DRAWN PJS	DATE: 08/06/06
PROJ. NO 564	DRAWING NO 564/AC/01	Revision 2	SCALE: AS SHOWN