



Sectional View

Scale 1:50

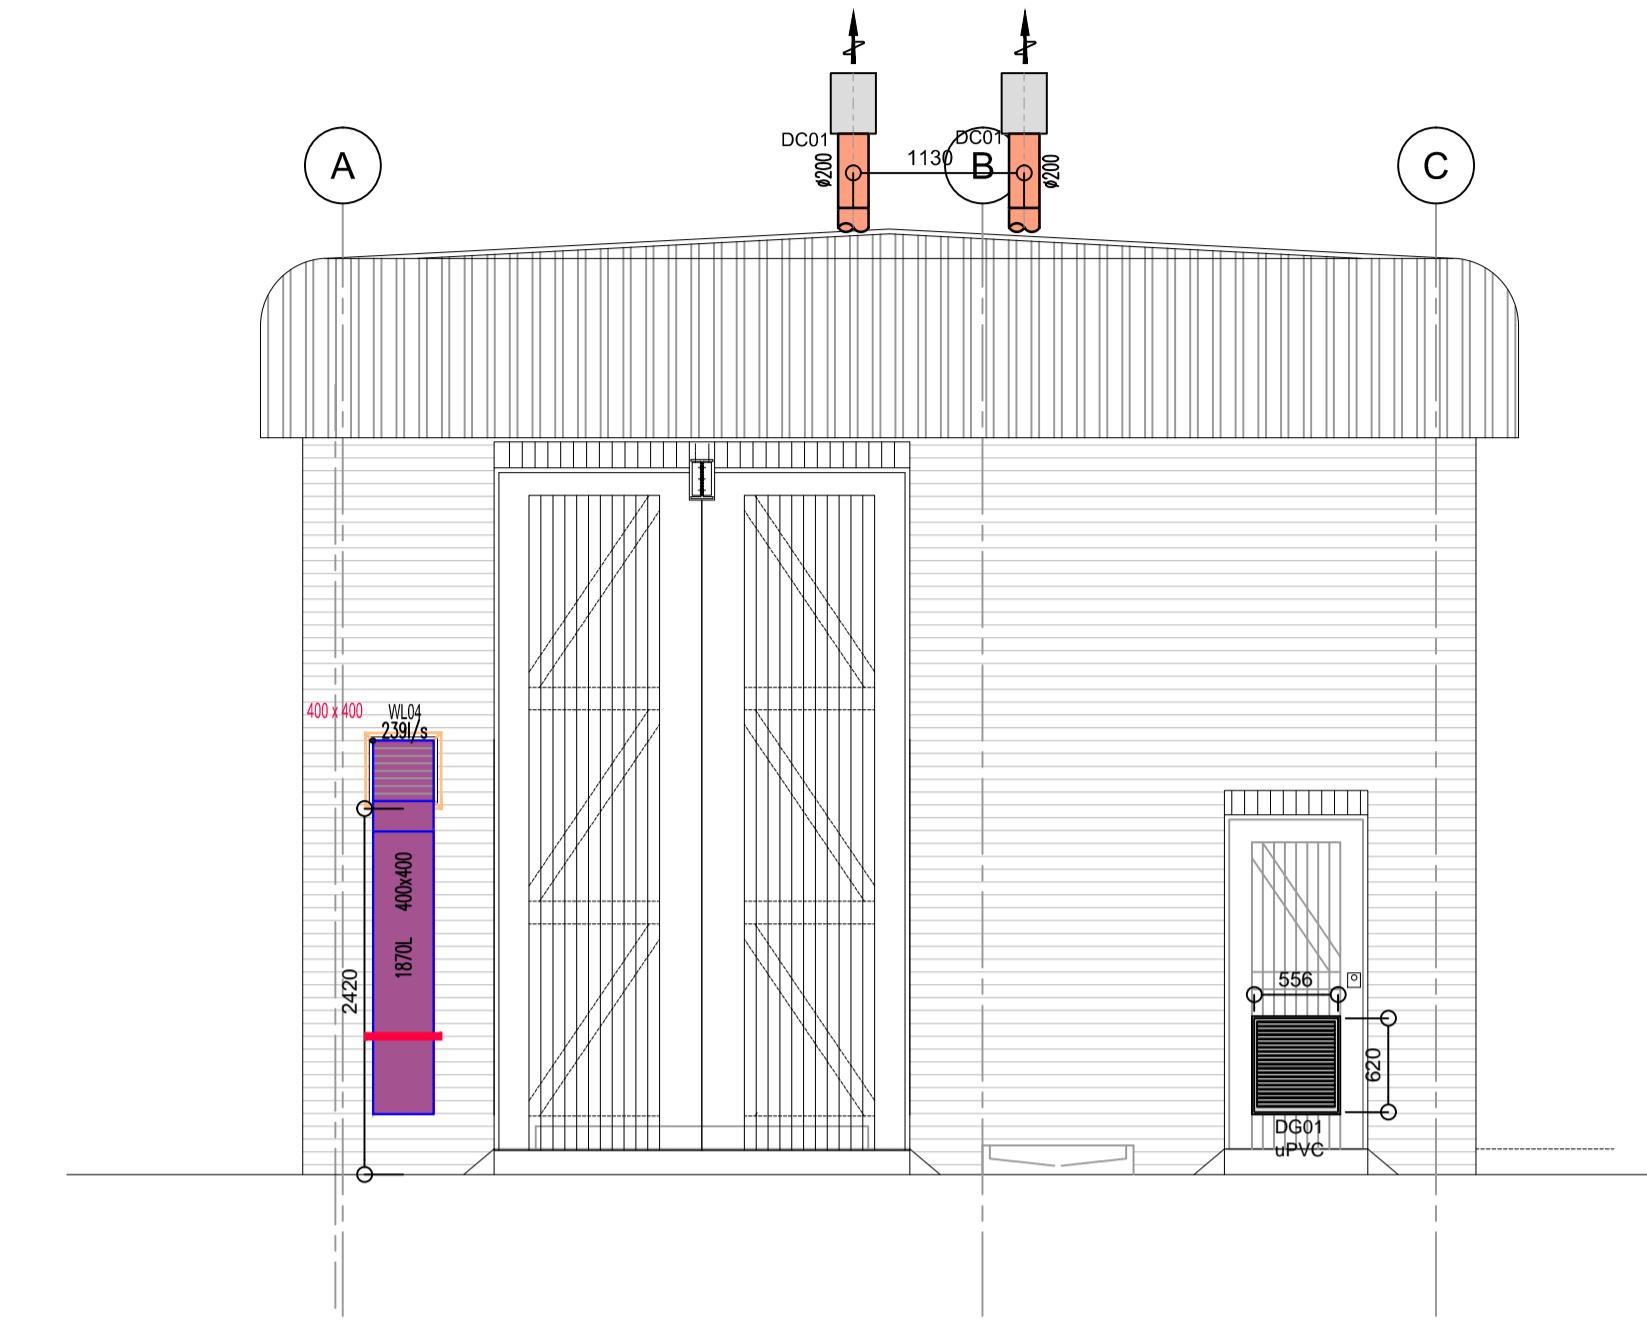


Elevational View with broken Section

Scale 1:50

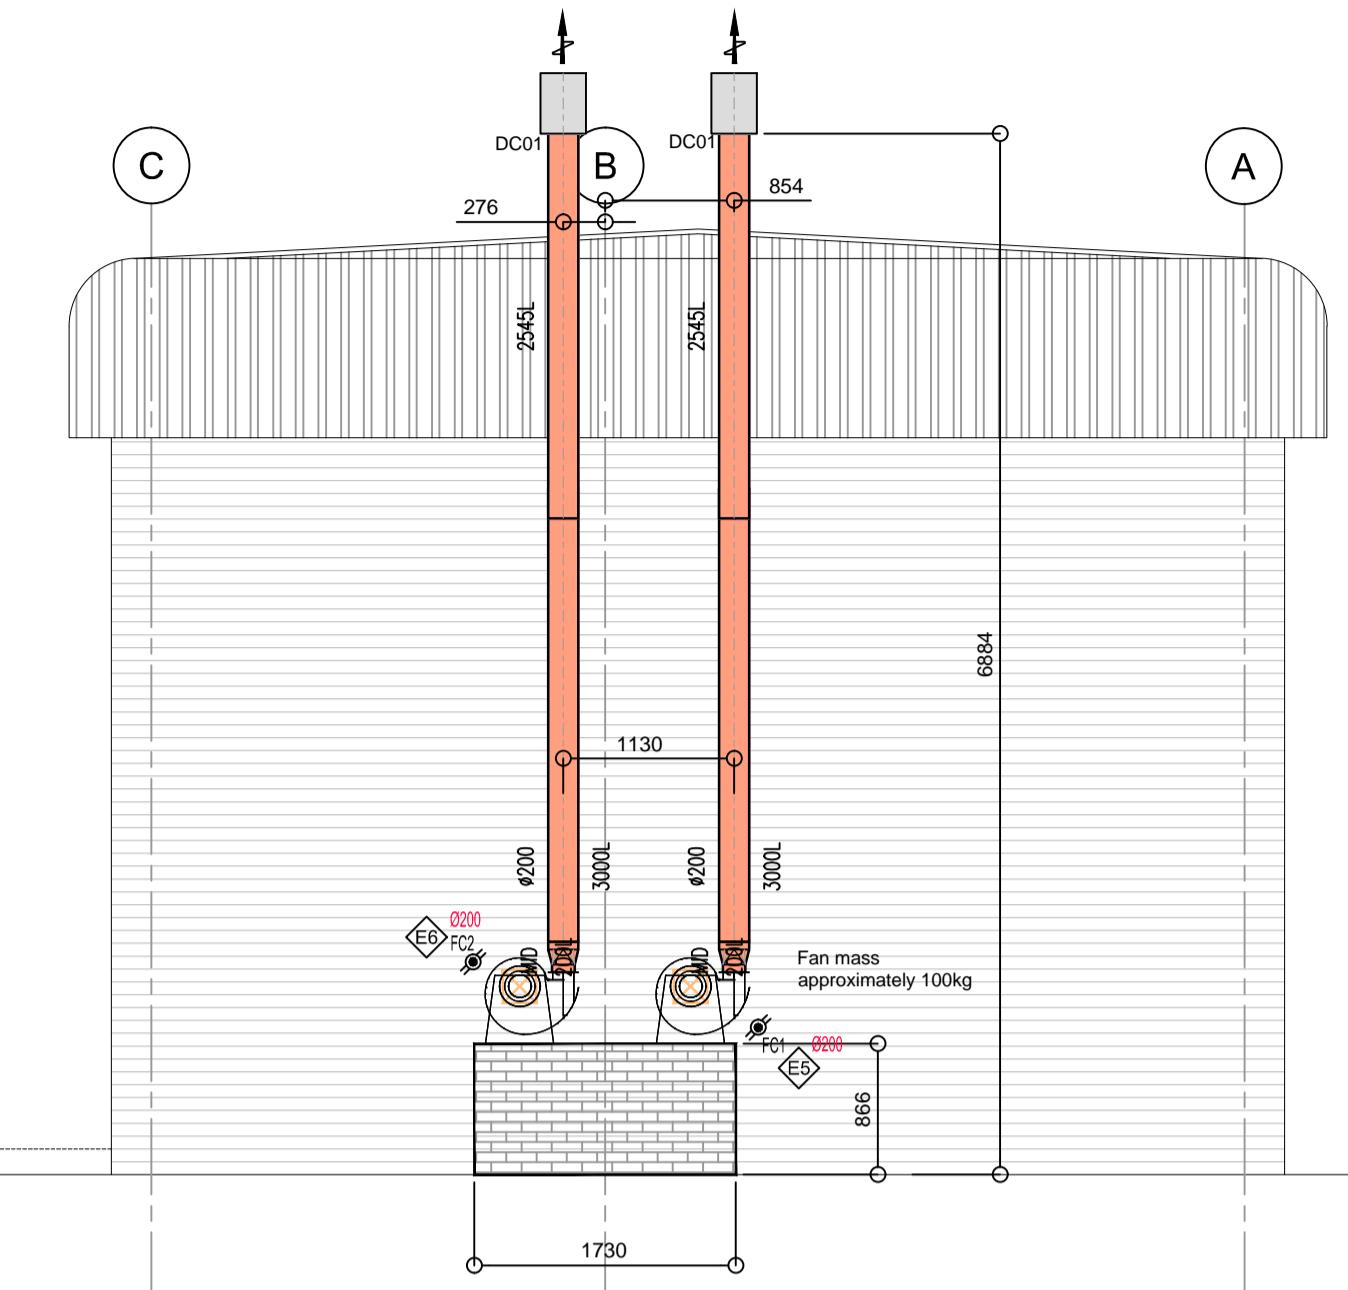


Elevational View

Scale 1:50

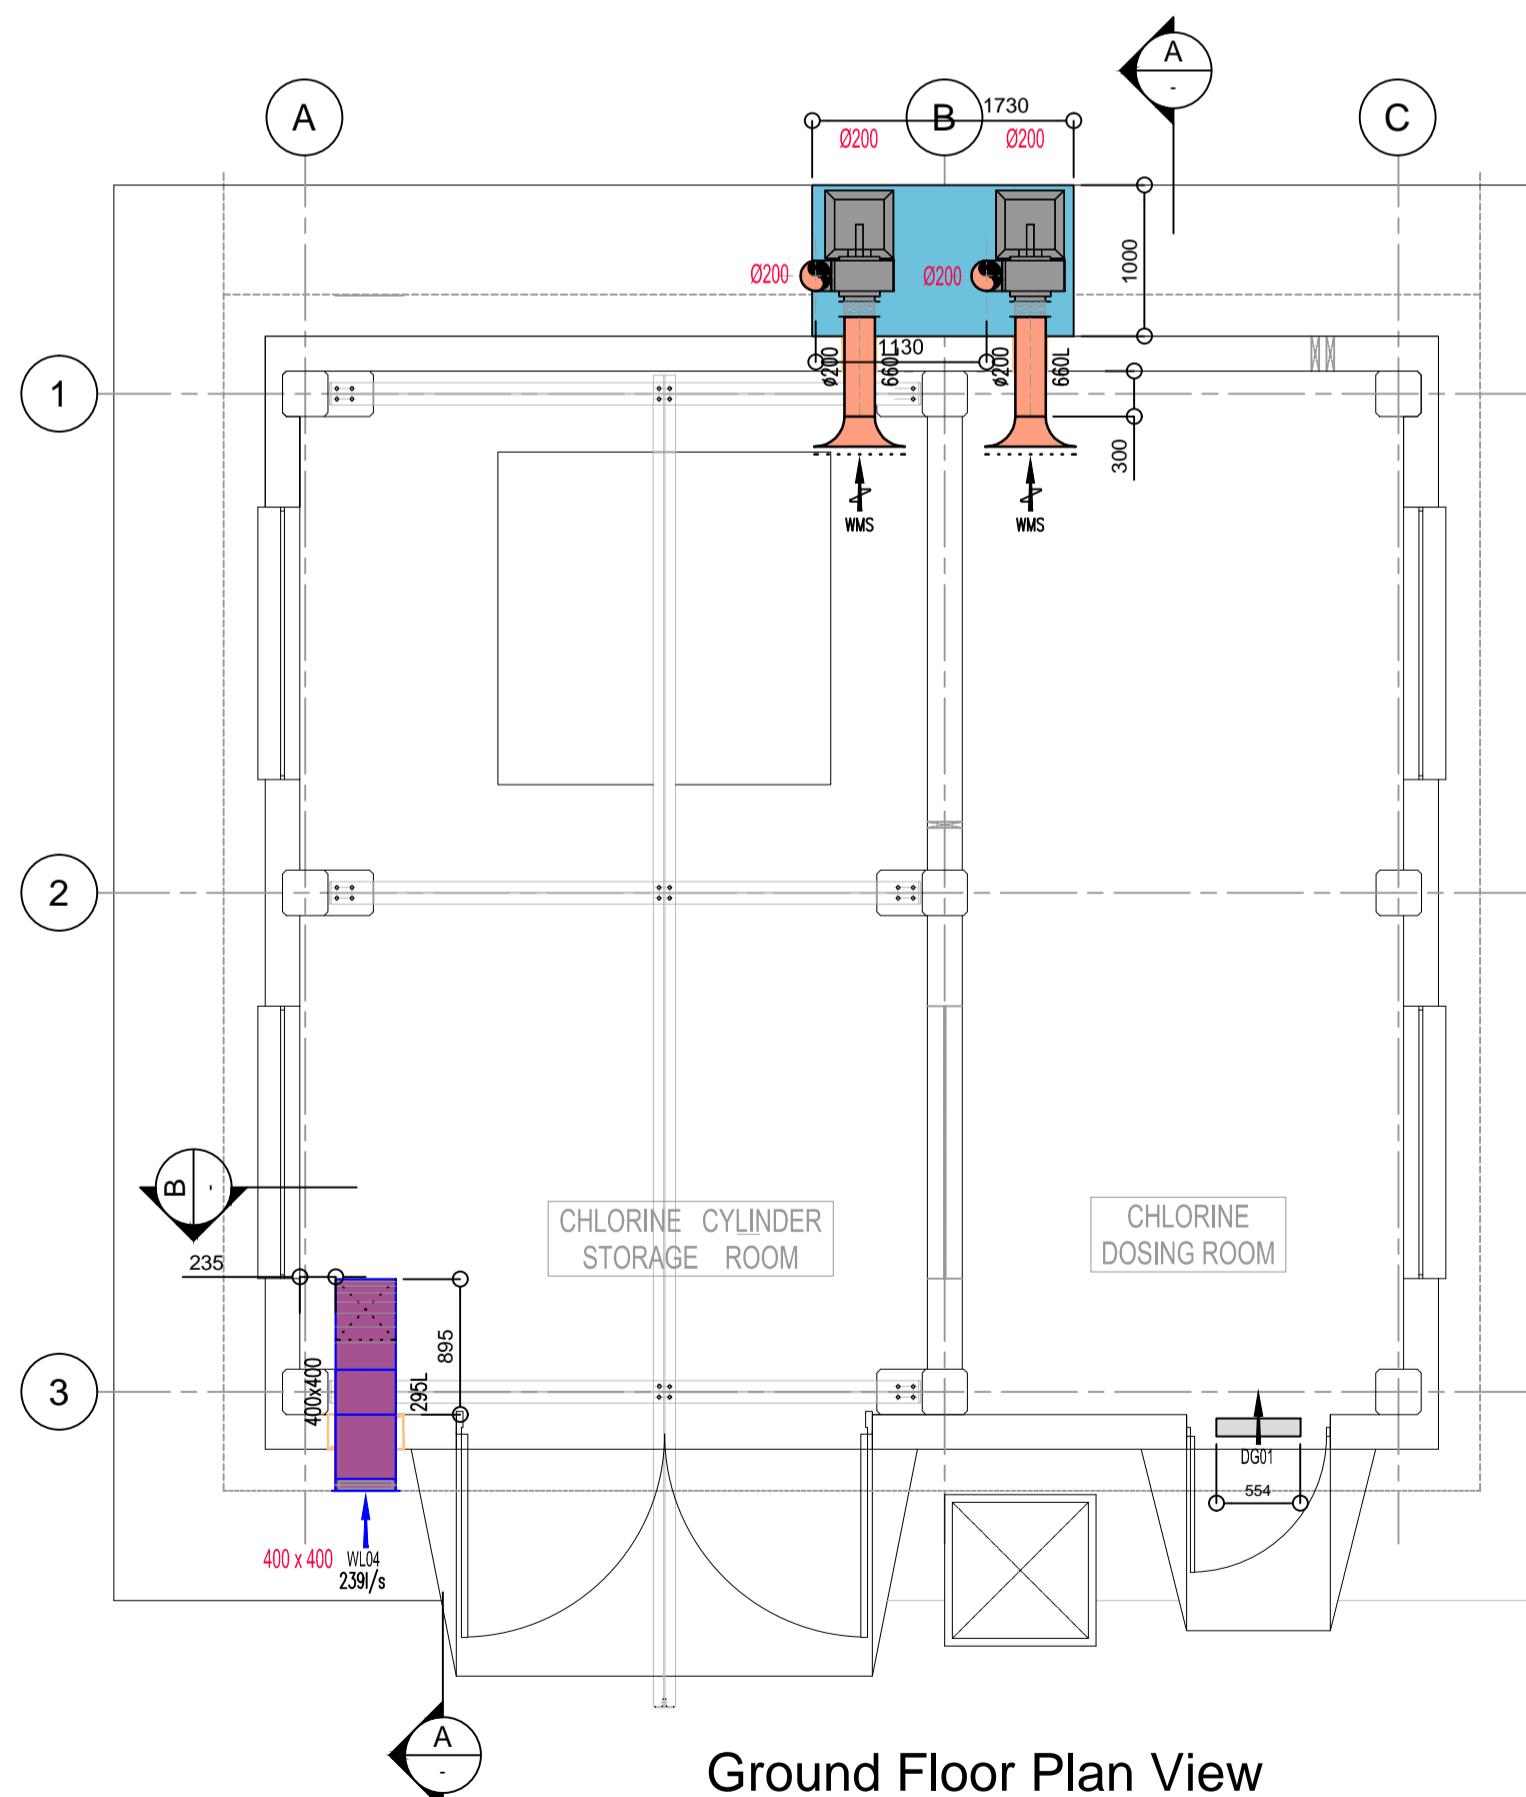



Ground Floor Plan View

Scale 1:50

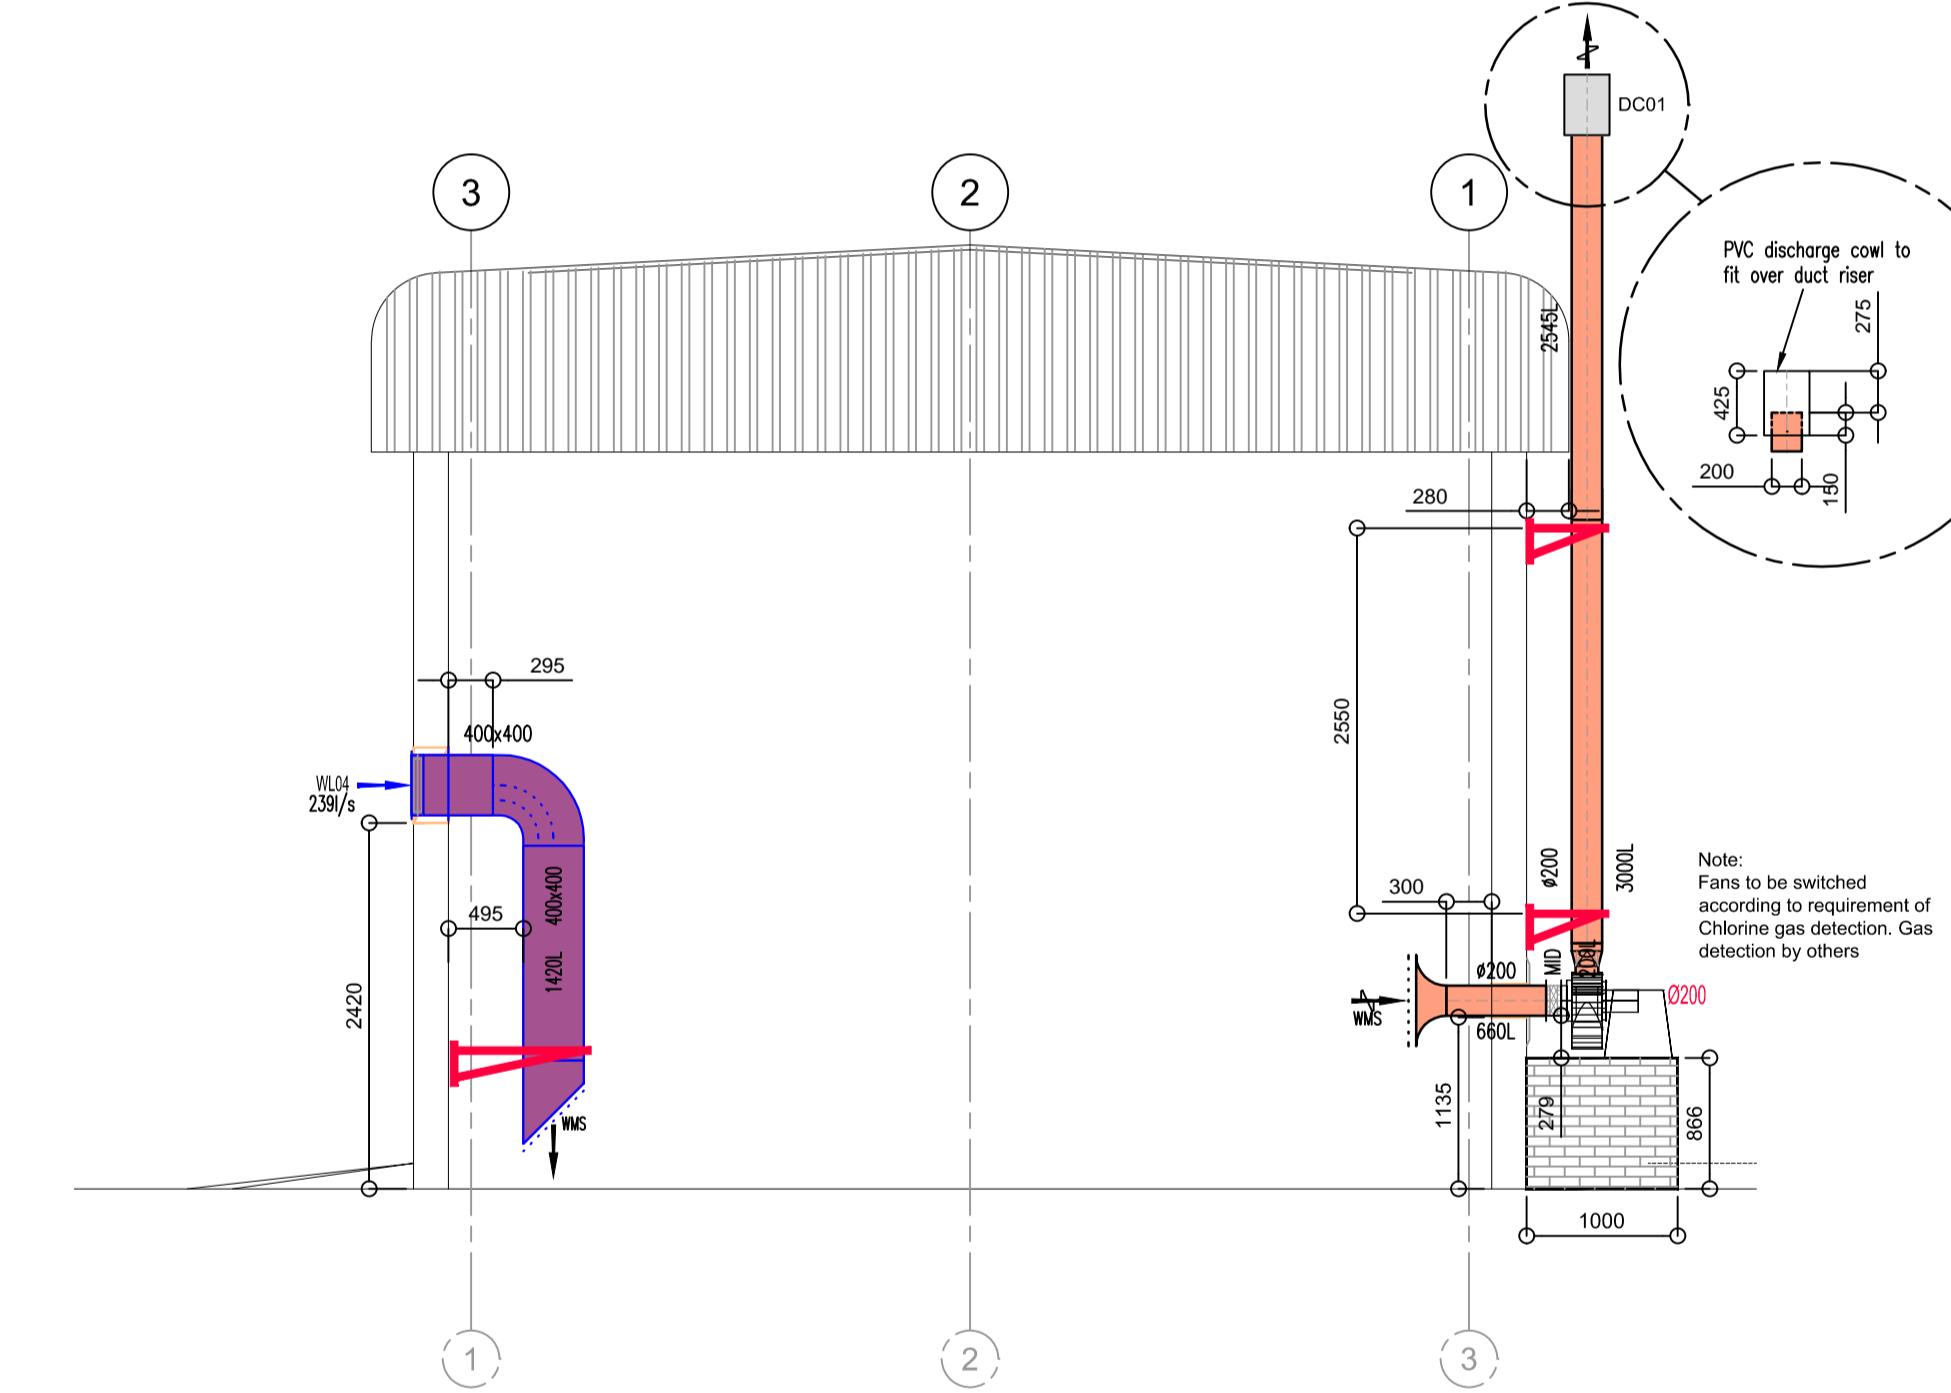

Section A-A

Scale 1:50

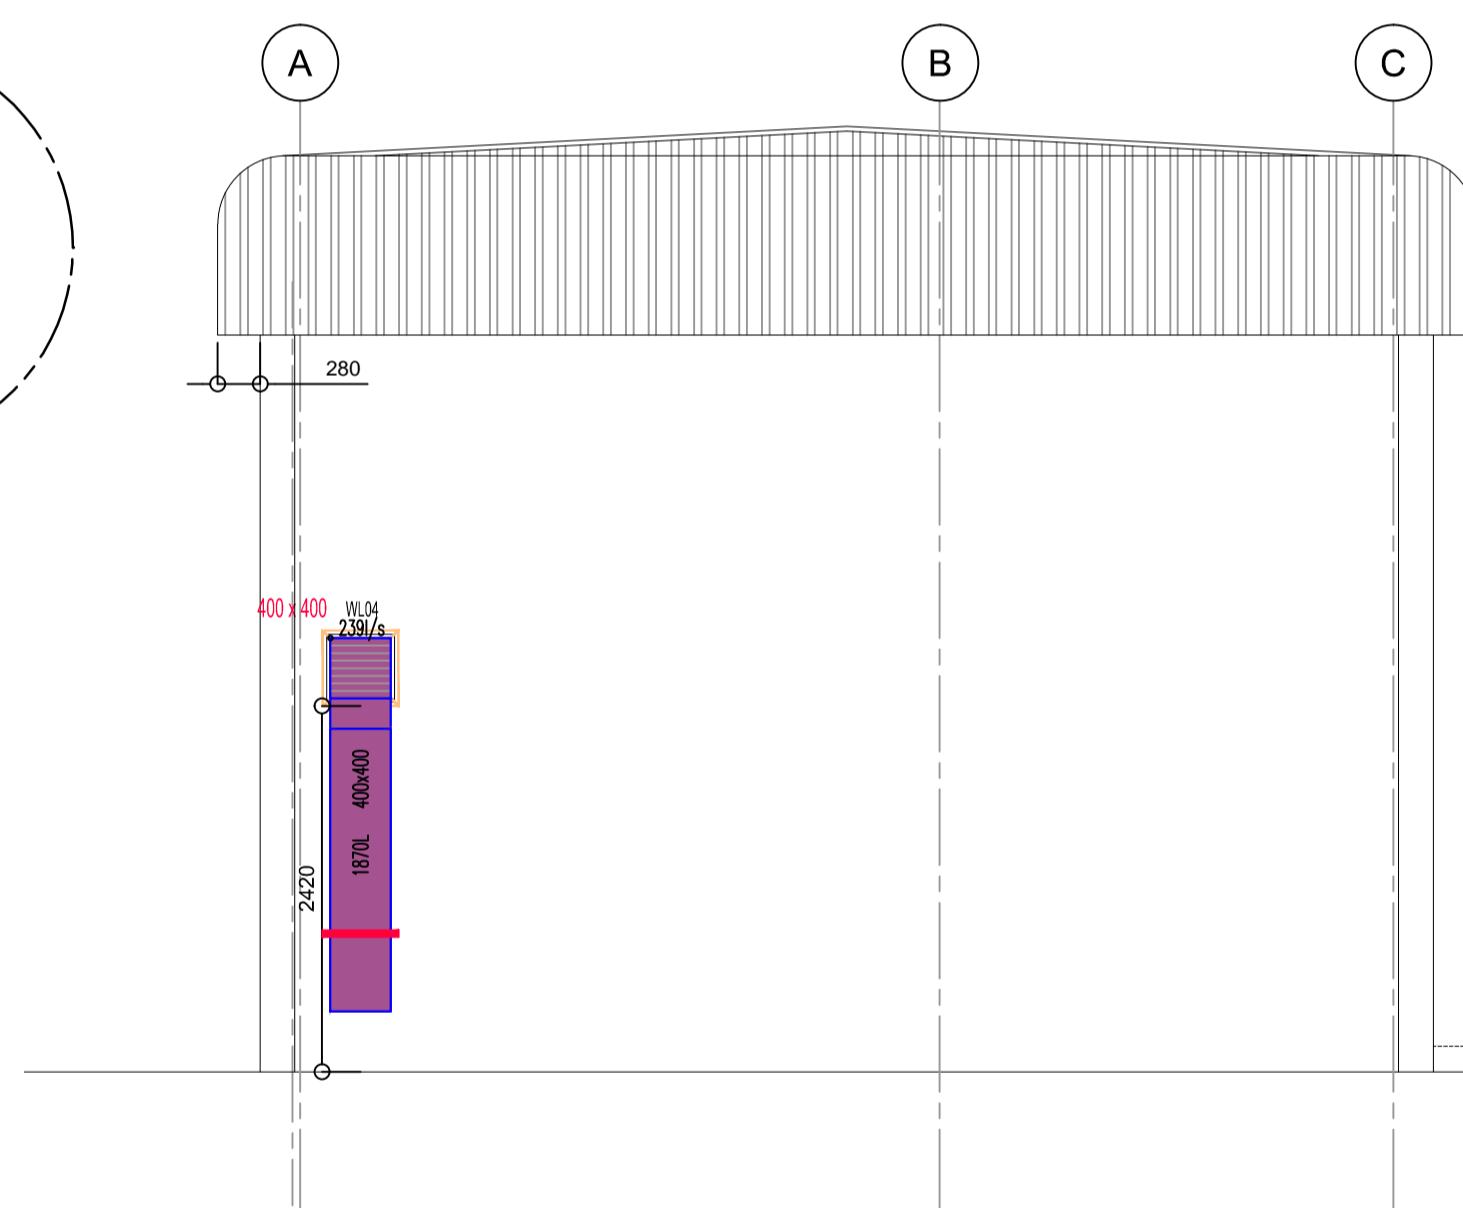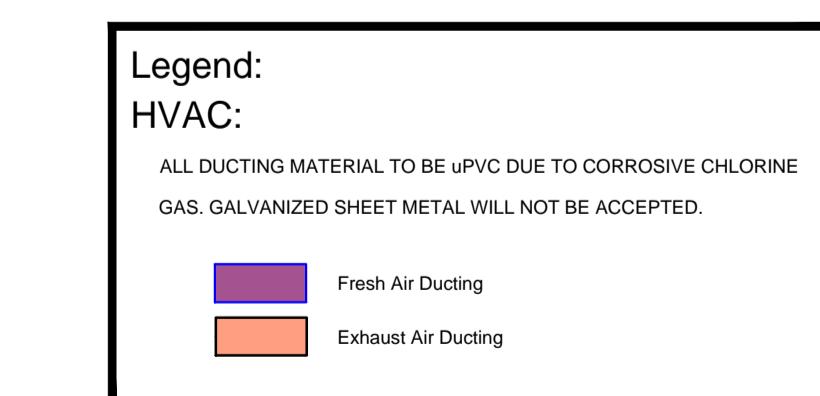

Section B-B


Scale 1:50

NOTE:
AWAITING KEY PLAN
FROM ARCHITECT

RECEIVED
2011/10/12
Transmittal 041-CHL

Key Plan
Scale 1:500

MPSJV-ENV-0107

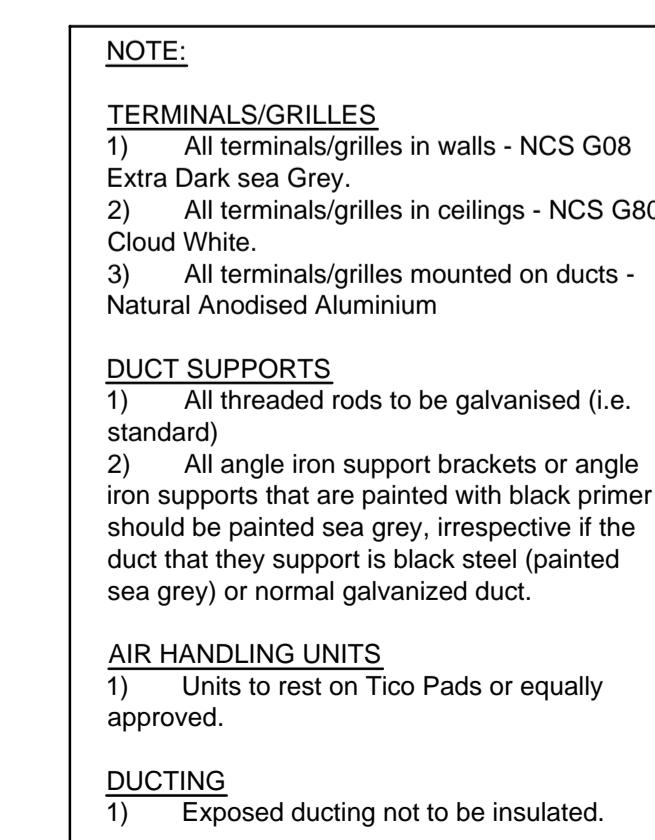

NOTE:

1. STARTER ISOLATOR TO BE PROVIDED BY ESKOM.
2. ALL DUCTING MATERIAL TO BE uPVC DUE TO CORROSIVE CHLORINE GAS. GALVANIZED SHEET METAL WILL NOT BE ACCEPTED.

NOTES:

DO NOT SCALE THIS DRAWING. WORK ONLY TO FIGURED DIMENSIONS.
FOR ALL RELEVANT NOTES, REFER TO MECHANICAL AND ELECTRICAL
ENGINEERING PERFORMANCE SPECIFICATION
ANY DISCREPANCIES ARE TO BE REPORTED TO ENVIROWARE CONSTRUCTION
IMMEDIATELY
THIS DRAWING IS TO BE READ IN CONJUNCTION WITH ALL OTHER RELEVANT
ENGINEERS, ARCHITECTS AND SUB-CONTRACTORS DRAWINGS AND DETAILS.

NOTE:
FOR LEGEND INFORMATION SEE
DRAWING DWG-ENV-ME-WTP-015 OR
FOR FULL SCHEDULE AND LEGEND SEE
DRAWING DWG-ENV-ME-WTP-015

APPROVAL

01	10/10/2011	UPDATED TO CONSULTANT REDLINE	GB
00	22/07/2011	ISSUED FIRST FIX FOR APPROVAL	GB
No.	DATE	DESCRIPTION	By

REVISIONS

COPYRIGHT © ENVIROWARE CONSTRUCTION 2001



CLIENT

MEDUPI POWER STATION

BUILDING

CHLORINATION BUILDING

DRAWING TITLE

HVAC LAYOUT

DRAWN	PROJECT MANAGER
GB	JB
CHECKED	APPROVED
AC	JB
DATE	SCALE
19/07/2011	1:50 @A1
DRAWING NUMBER	REF CONSU. 08073-T-14DF-CHL
	REV No. 0
	REF ARCHT. 0.84/3327
	ENV REF No: 1650