


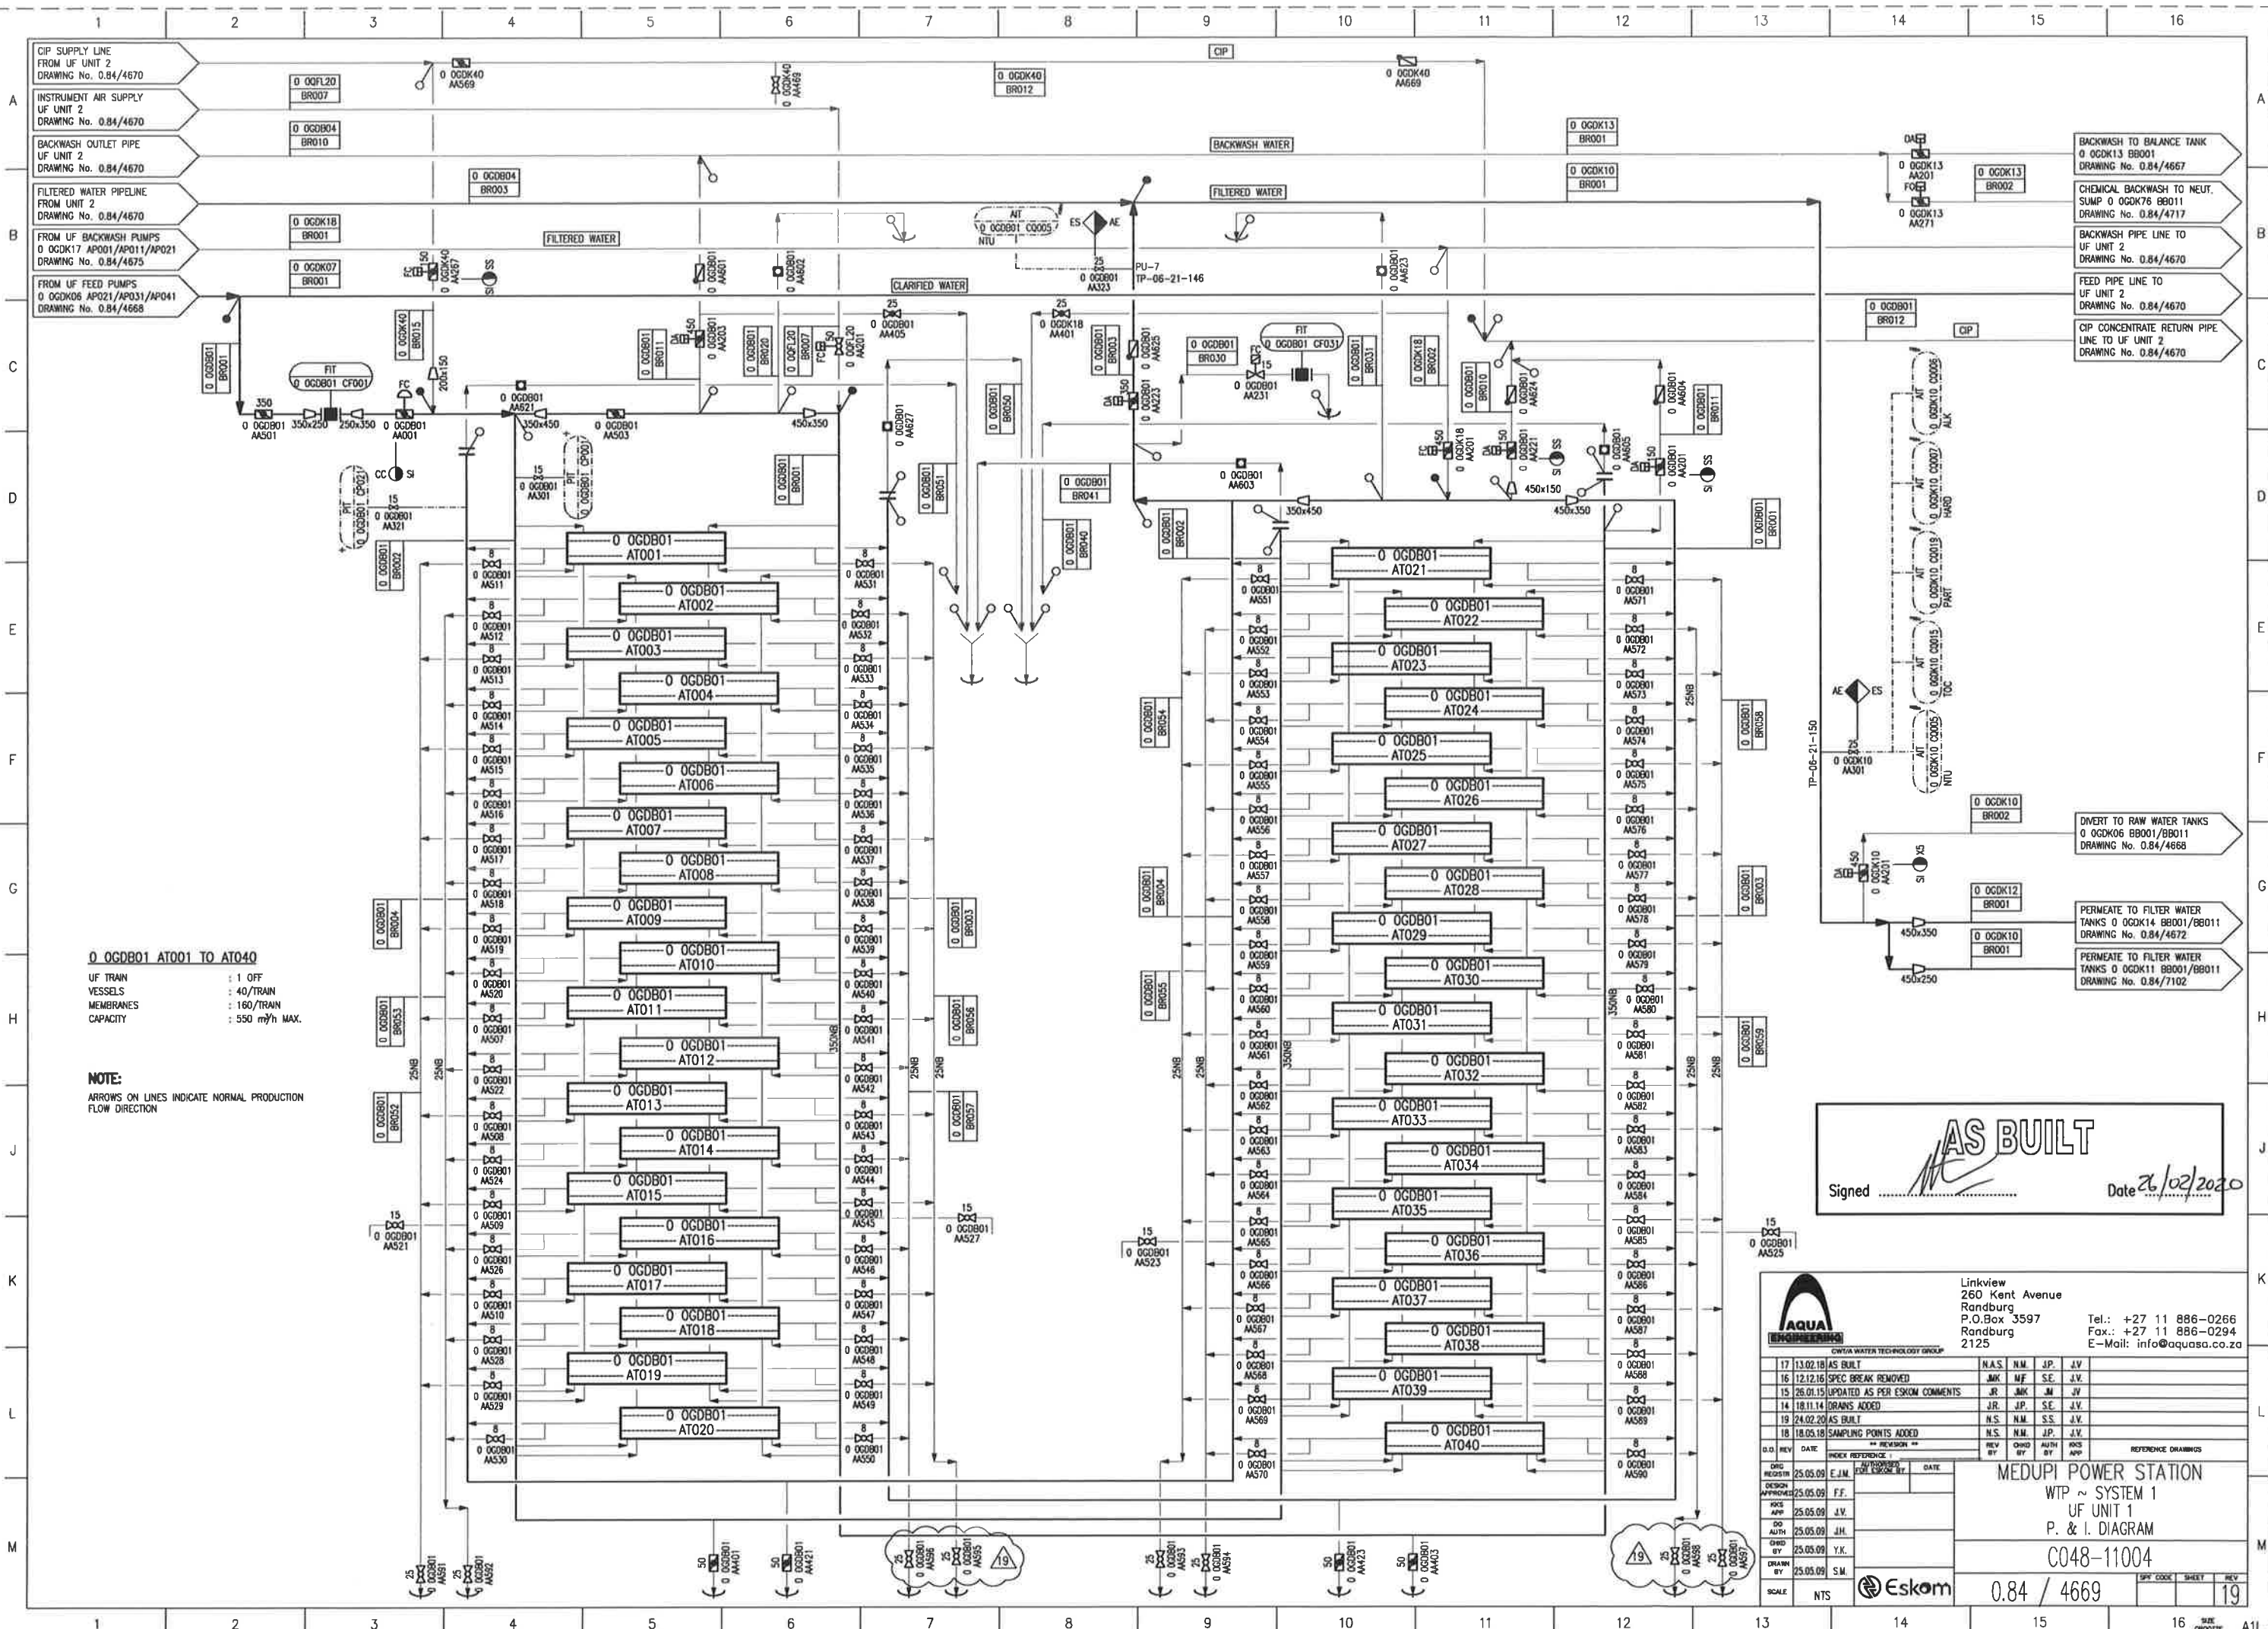

0 OGDB01 AT001 TO AT040

UF TRAIN : 1 OFF
VESSELS : 40/TRAIN
MEMBRANES : 160/TRAIN
CAPACITY : 550 m³/h MAX.

NOTE:
ARROWS ON LINES INDICATE NORMAL PRODUCTION FLOW DIRECTION

AS BUILT
Signed Date 26/02/2020

AQUA ENGINEERING
Linkview
260 Kent Avenue
Randburg
P.O. Box 3597
Randburg
2125
Tel.: +27 11 886-0266
Fax.: +27 11 886-0294
E-Mail: info@aquas.co.za

REVISIONS				REFERENCE DRAWINGS			
NO.	REV.	DATE	BY	CHKD.	DATE	NO.	REV.
17	13.02.18	AS BUILT	N.S.	N.M.	J.P.	J.V.	
16	12.12.16	SPEC BREAK REMOVED	J.M.	M.F.	S.E.	J.V.	
15	26.01.15	UPDATED AS PER ESKOM COMMENTS	J.R.	J.M.	J.M.	J.V.	
14	18.11.14	DRAWINGS ADDED	J.R.	J.P.	S.E.	J.V.	
13	24.02.20	AS BUILT	N.S.	N.M.	S.S.	J.V.	
12	18.05.18	SAMPLING POINTS ADDED	N.S.	N.M.	J.P.	J.V.	
O.D. REV. DATE				INDEX REFERENCE			
DESIGN	25.05.09	E.J.M.		DESIGN	25.05.09		
APPROVED	25.05.09	F.F.		APPROVED	25.05.09		
CHKD.	25.05.09	J.V.		CHKD.	25.05.09		
DO	25.05.09	J.H.		DO	25.05.09		
BY	25.05.09	Y.K.		BY	25.05.09		
SCALE	25.05.09	S.M.		SCALE	25.05.09		

ESKOM
0.84 / 4669

MEDUPI POWER STATION
WTP ~ SYSTEM 1
UF UNIT 1
P. & I. DIAGRAM
C048-11004