


NOZZLE SCHEDULE				
MARK	NPS	CLASS	FACING	SERVICE
D1	1 1/2	150	LWN RF	DRAIN
D2	3	300	LWN RF	DRAIN
D3	3	150	LWN RF	DRAIN
D4	3	150	LWN RF	DRAIN
D5	3	300	LWN RF	DRAIN
V1	1 1/2	150	LWN RF	VENT
V2	1 1/2	150	LWN RF	VENT
V3	1 1/2	150	LWN RF	VENT

- NOTES**
- ALL DIMENSIONS GIVEN FROM FLANGE RF.
  - VALVE & ACTUATORS IS NOT DRAWN IN DETAIL.
  - MANHOLE 457 I/D.
  - EXISTING EQUIPMENT IS DRAWN IN DASHED LINES.
  - BELLOW WILL BE STRETCH INITIALLY APPROXIMATELY 10mm FOR FITMENT.
  - PARTS LIST BELOW ONLY SHOW MODIFIED ITEMS, ALL THE BOLTS, NUTS & GASKETS IN CHAMBER ALSO NEED TO BE REPLACED.
  - MATERIAL CERTIFICATION TO EN 10204, 3.1 IS REQUIRED FOR PRESSURE BEARING ITEMS.
  - DESIGN DATA IS ONLY APPLICABLE TO MODIFICATIONS (INSTALLATION OF BELLOW & PIPE MODIFICATIONS) INSIDE CHAMBER.
  - ENSURE PROPER WASHER FITMENT AT BACK OF VALVE FLANGES DURING BOLT-UP.
  - PIPE SUPPORTS (ITEMS 9) TO BE FIXED TO CONCRETE FLOOR (PERMANENTLY).
  - BELLOW & VALVE MUST BE INSTALLED & SUPPORT FROM GROUND BEFORE FITMENT OF PIPING.
  - LOCALIZED HYDRO TEST TO BE CONDUCTED ON MODIFICATION WELD (PIPE MODIFICATION) AT A PRESSURE OF 2925 kPa FOR FOUR (4) HOURS.
  - PIPE FITMENT TO BE DONE ON SITE
  - TIGHTNESS PRESSURE TEST TO BE DONE FOR ONE (1) HOUR ON PIPE LINE.
  - THE TRUE ANGLE OF SPOOL PIECE (ITEM 10) WITH THE HORIZONTAL PLANE IS 23.08°
  - PAINTING TO BE ACCORDING ACSA SPECIFICATIONS.

DESIGN DATA		
DESIGN CODE (RELEVANT TO MODIFICATION)		ASME B 31.4 2006
DESIGN PRESSURE	kPa (g)	1950
OPERATING PRESSURE	kPa (g)	1200 (MAX)
DESIGN TEMPERATURE	°C	40
OPERATING TEMPERATURE	°C	AMBIENT
TIGHTNESS TEST	kPa (g)	2000
HYDROSTATIC PRESSURE TEST	kPa (g)	(SEE NOTE 12)
SERVICE		AVIATION KEROSEEN

NO.	QTY	DESCRIPTION	MATERIALS
19	1	GASKET TO SUIT NPS 16 CL 150	GRAFTECH
18	1	BLIND FLANGE NPS 3 CL 300 RF	SA 105
17	16	WASHER NS 3/4"	MILD STEEL
16	8	STUDBOLT 3/4" x 10 UNC x 115 LG	SA 193 GR B7
15	16	HEX NUT 3/4" x 10 UNC	SA 194 GR 2H
14	1	GASKET TO SUIT NPS 3 CL 300	GORE UNIVERSAL PIPE GASKET
13	2	FLANGE NPS 16 CL 150 WN RF (HUB THK: SCH STD)	SA 105
12	1	ELBOW NPS 16 SCH STD 90° LR (TRIM TO 74.8°)	SA 234 GR WPB
11	1	ELBOW NPS 16 SCH STD 45° LR (TRIM TO 28.1°)	SA 234 GR WPB
10	1	PIPE NPS 16 SCH STD x 382 LG (API 5L SEAMLESS)	SA 106 GR B
9	1	ADJUSTABLE PIPE SUPPORT	
8	1	BLIND FLANGE NPS 16 CL 150 RF	SA 105
7	2	SPECTACLE BLIND NPS 16 CL 150 x 25 THK	SA 516 GR 70
6	144	WASHER NS 1"	MILD STEEL
5	32	STUDBOLT 1" x 8 UN x 175 LG	SA 193 GR B7
4	48	STUDBOLT 1" x 8 UN x 145 LG	SA 193 GR B7
3	144	HEX NUT 1" x 8 UN	SA 194 GR 2H
2	7	GASKET TO SUIT NPS 16 CL 150	GORE UNIVERSAL PIPE GASKET
1	1	SPOOL PIECE SEE KOG DRG. 1483-DBFPT-09F485-0010-00	

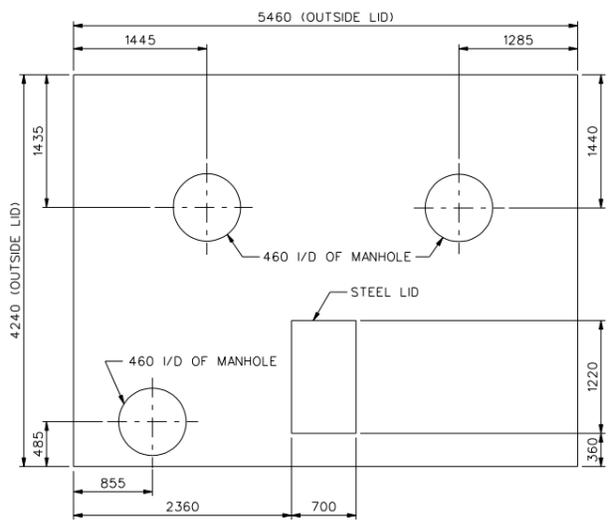

POSITION OF ACCESS MANHOLE  
SCALE 1:35

PLAN VIEW

THE VALVE CHAMBER NUMBER INDICATED ON THE VALVE CHAMBER ON SITE AT TIME OF PRODUCING THIS DRAWING WAS VCF4D

REFERENCE DRAWINGS	
DRAWING NUMBER	DESCRIPTION
MC2610879-VCD4-DWG-002-SHT02	DETAILS OF VALVE CHAMBER VCD4
1483-DBFPT-09F485-0010-00	BELLOW SPOOL PIECE

This drawing is the property of Megchem Engineering and Drafting Services (Pty) Ltd  
Copyright Patents and all Industrial Property Rights Reserved

No.	REVISION DESCRIPTION	DRAWN	CHECKED	APPROVED	ENGINEER	DATE
07	AS-BUILT (MC2610879) MEGCHEM	J. KEMP	P.F. ARIA	P.L. VAN DEN BERG	G. BLIGNAUT	2010-10-27

DATE	UNIT/SECTION
2009-07-13	
2009-07-13	
**MEG CHEM**

MEGCHEM ENGINEERING AND DRAFTING SERVICES (PTY) LTD  
TEL: (016) 981 4806  
FAX: (016) 981 3816  
P O BOX 394 SASOLBURG 1947

DETAIL OF MODIFICATIONS ON VALVE CHAMBER VCD4

MEGCHEM OLD DRG No.	MEGCHEM NEW DRG No.	SHEET No.	REV No.
MC2610879-VCF4D-DWG-002	MC2610879-VCD4-DWG-002	001	07