
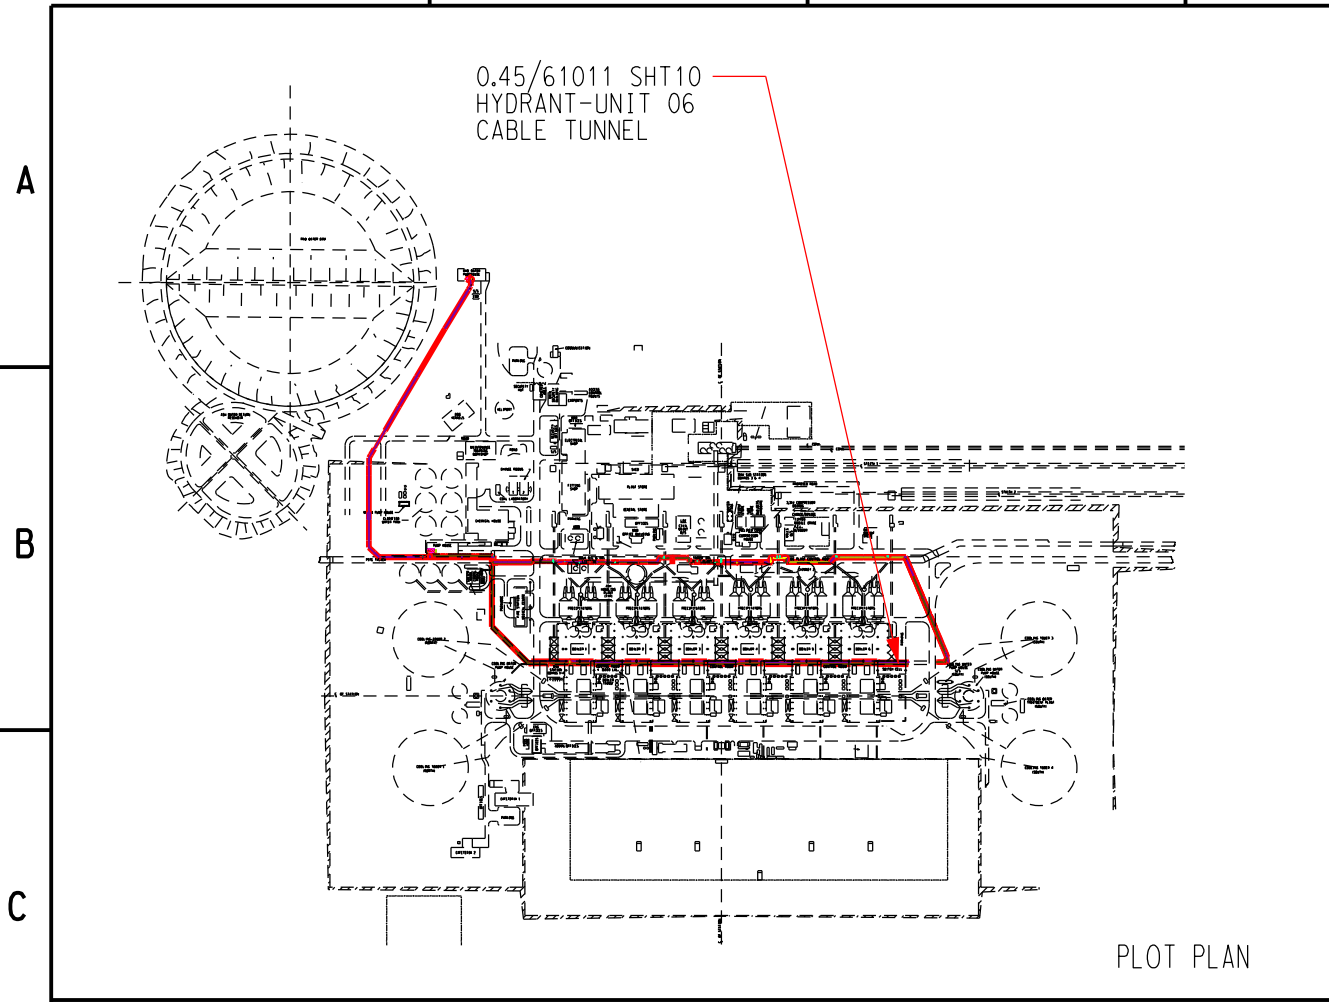


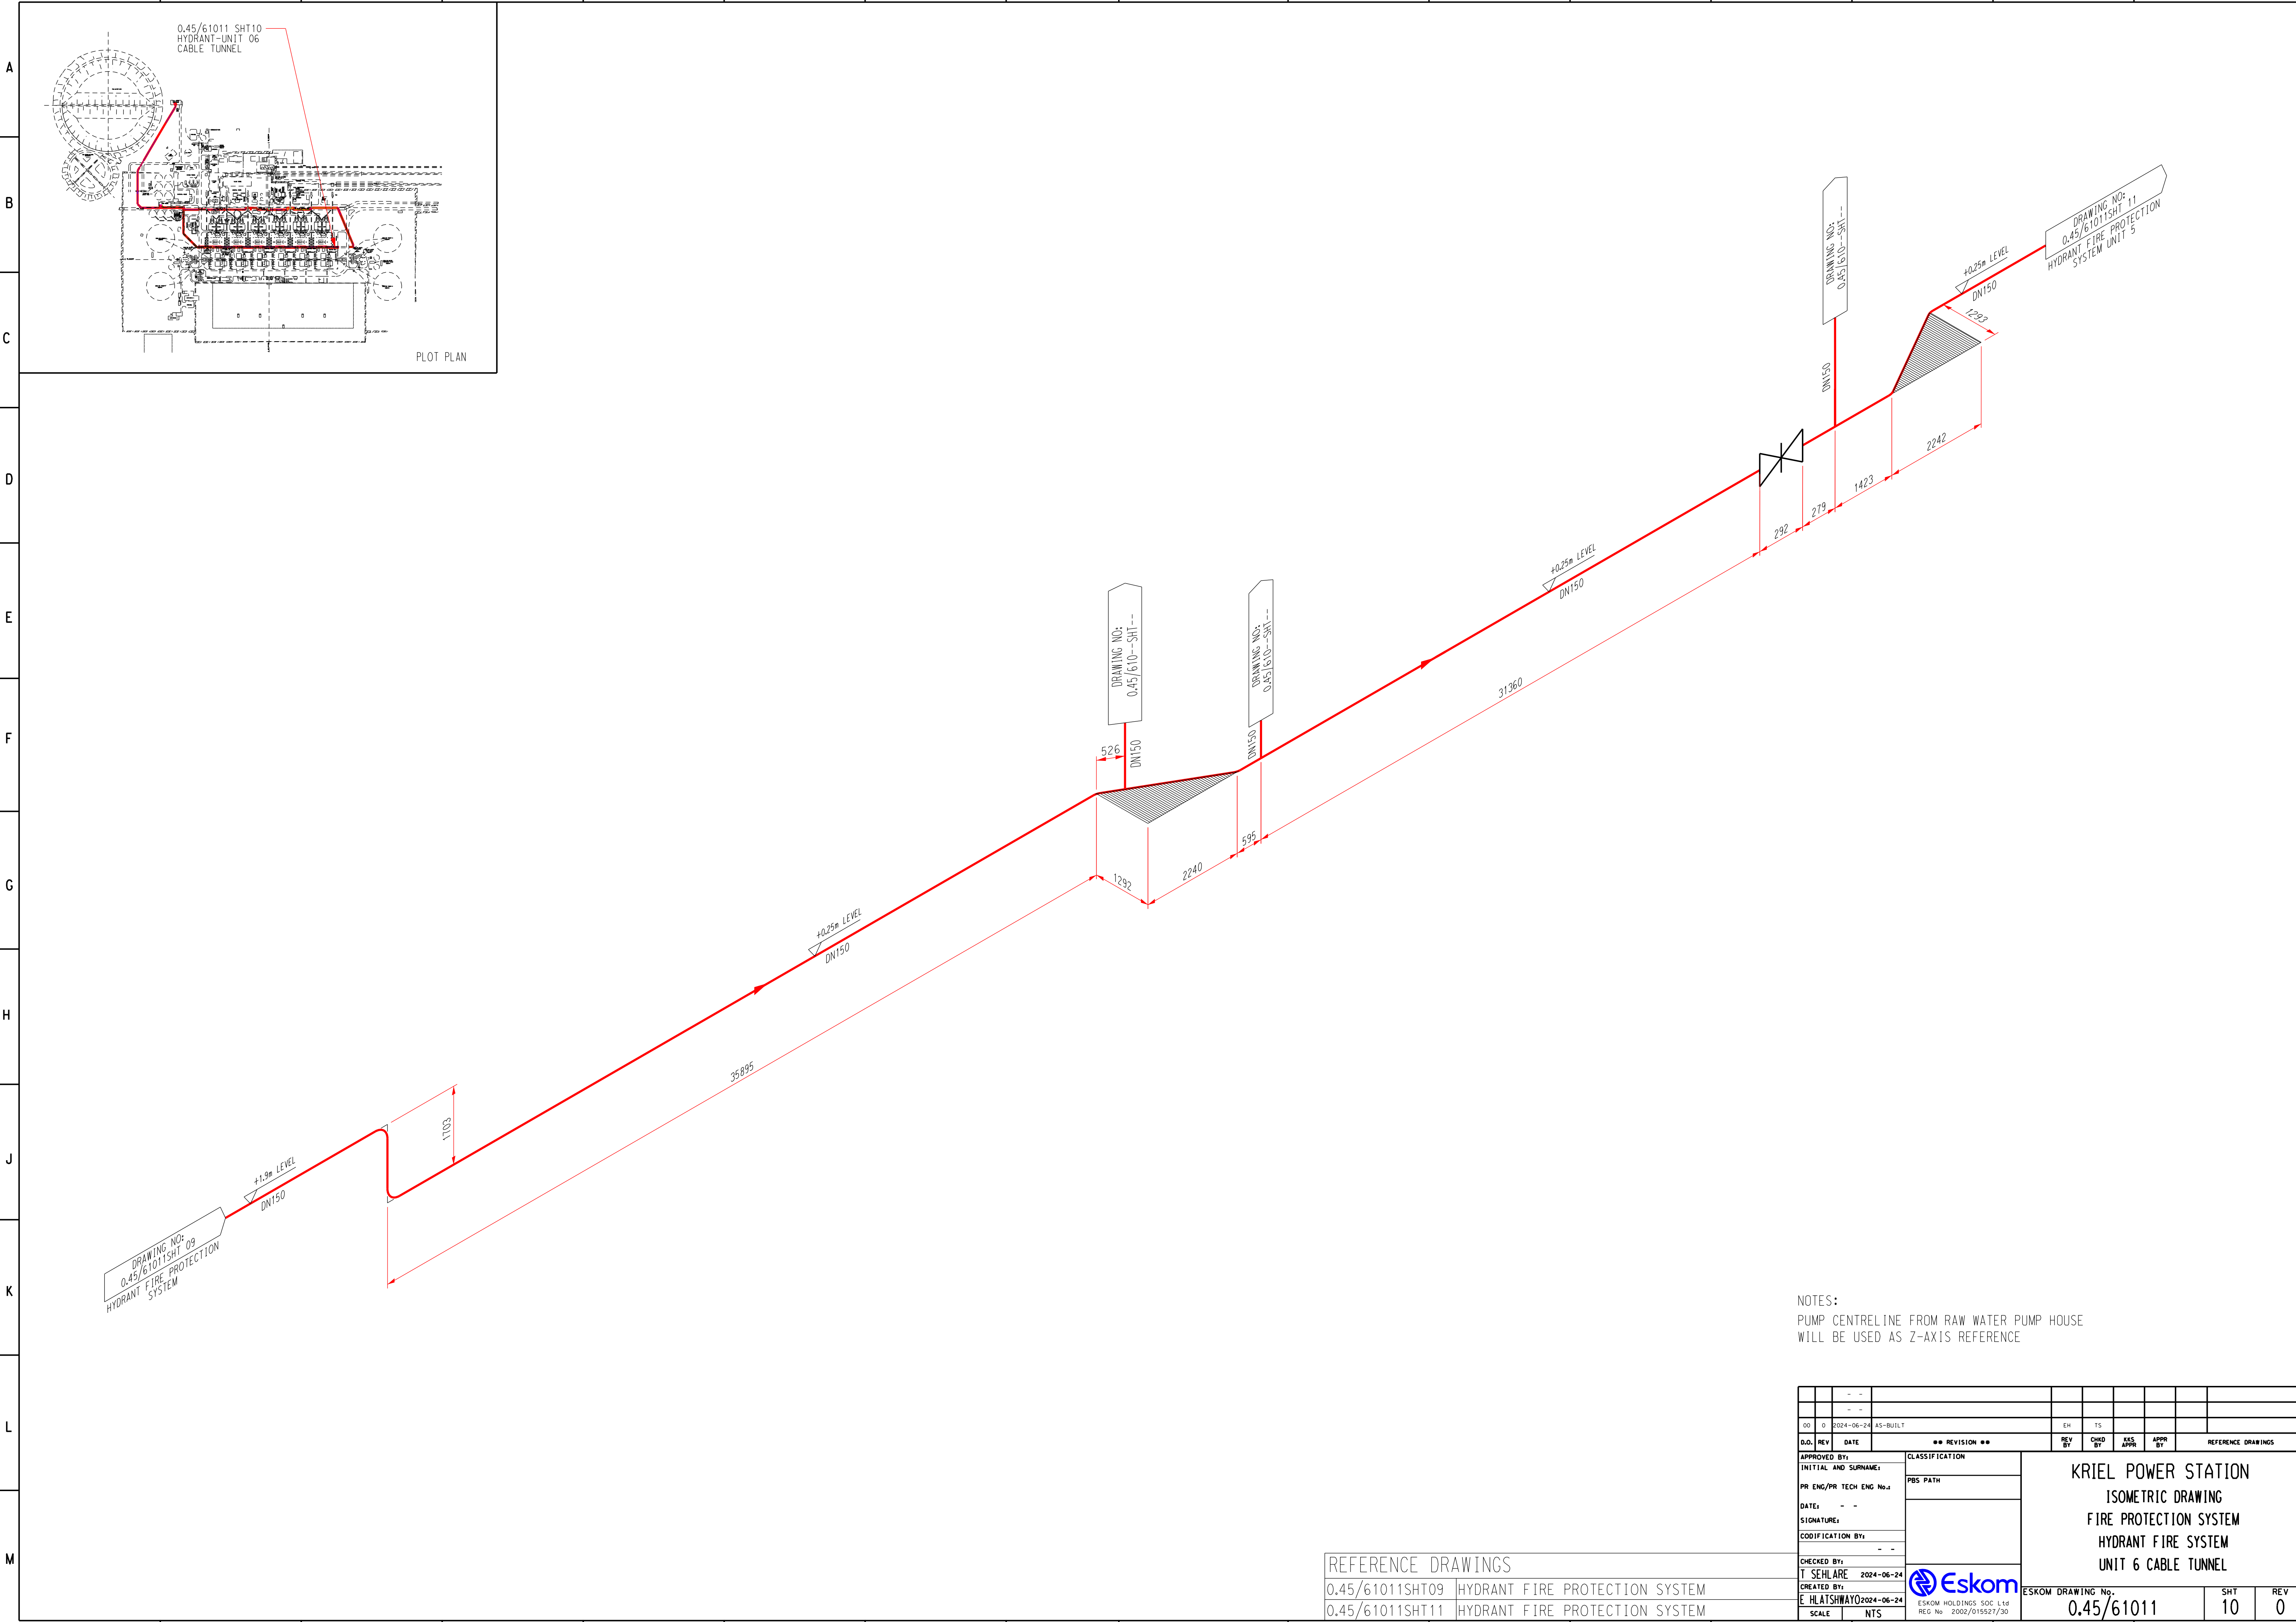

DRAWING NO:
0.45/61011SHT 09
HYDRANT FIRE PROTECTION
SYSTEM

DRAWING NO:
0.45/61011SHT --
DN150

DRAWING NO:
0.45/61011SHT --
DN150

DRAWING NO:
0.45/61011SHT --
DN150

DRAWING NO:
0.45/61011SHT 11
HYDRANT FIRE PROTECTION
SYSTEM UNIT 5

NOTES:
PUMP CENTRELINE FROM RAW WATER PUMP HOUSE
WILL BE USED AS Z-AXIS REFERENCE

REFERENCE DRAWINGS	
0.45/61011SHT09	HYDRANT FIRE PROTECTION SYSTEM
0.45/61011SHT11	HYDRANT FIRE PROTECTION SYSTEM

00		0	2024-06-24	AS-BUILT		EH		TS									
D.O.		REV		DATE		** REVISION **				REV BY	CHKD BY	ISS APPR	APPR BY	REFERENCE DRAWINGS			
APPROVED BY:				CLASSIFICATION				KRIEL POWER STATION ISOMETRIC DRAWING FIRE PROTECTION SYSTEM HYDRANT FIRE SYSTEM UNIT 6 CABLE TUNNEL									
INITIAL AND SURNAME:				PBS PATH													
PR ENG/PR TECH ENG No.:																	
DATE:																	
SIGNATURE:																	
CODIFICATION BY:																	
CHECKED BY:																	
T. SEHLARE				2024-06-24				 ESKOM DRAWING No. 0.45/61011									
CREATED BY:																	
E. HLATSHWAYO				2024-06-24													
SCALE		NTS		ESKOM HOLDINGS SOC LTD				REG No				2002/015521/30		SHT		REV	
														10		0	

KRIEL POWER STATION
ISOMETRIC DRAWING
FIRE PROTECTION SYSTEM
HYDRANT FIRE SYSTEM
UNIT 6 CABLE TUNNEL