


Unfactored Dead Load Allowance For PV Panels = 0.15kPa (15kg/sqm)

LOWER ROOF LAYOUT - OVERALL
SCALE 1:200

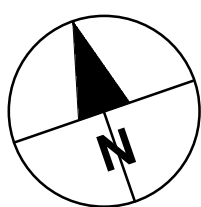

FOR CONSTRUCTION

ISSUE / REVISION

ISS	DATE	DESCRIPTION	ISS BY
1	2021-10-14	C.I. NO. 1 VALUERS OMITTED	S.O
2	2022-01-27	C.I. NO. 6 MIDDLE WAREHOUSE INCLUDED	S.O
3	2021-10-14	C.I. NO. 1 VALUERS OMITTED	S.O
4	2021-08-27	ISSUED FOR CONSTRUCTION	S.O

DRAWING BY


DESIGNED BY: N. KHAN
DRAWN BY: S. OLIVER

APPROVAL CONSULTANT

NAME: E. SCHEEPERS
PROF. REG. No.: 20010325

THE MASTER HELD AT THE AECOM CENTURION OFFICE
BEARS THE ORIGINAL SIGNATURE OF APPROVAL

KEY PLAN

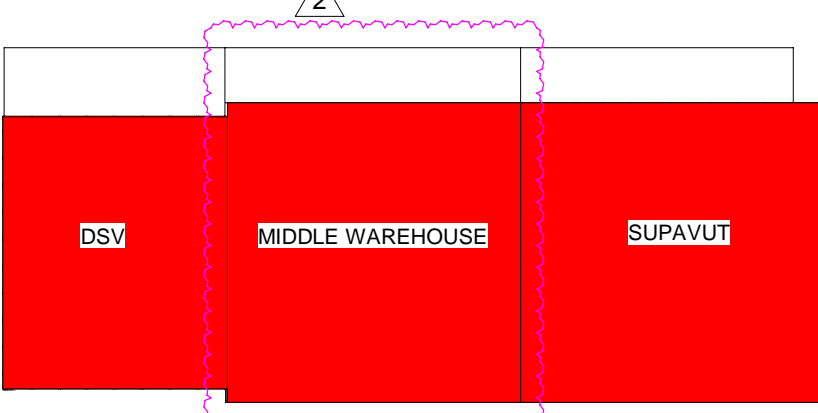

NOTES

- FOR GENERAL NOTES, REFER TO DRAWING: TZC7-ACM-XX-XX-DR-SE-010060
- DRAWINGS ARE NOT TO BE SCALED. ALL LEVELS AND DIMENSIONS SHALL BE VERIFIED ON SITE PRIOR TO COMMENCEMENT OF WORKS. ANY DISCREPANCIES SHALL BE BROUGHT TO THE ENGINEER / ARCHITECT'S ATTENTION IMMEDIATELY.
- THIS DRAWING IS TO BE READ IN CONJUNCTION WITH ALL OTHER DRAWINGS, SCHEDULES AND SPECIFICATIONS RELATED TO THIS PROJECT.
- ALL BUILDING WORK AND MATERIALS SHALL COMPLY WITH LOCAL AUTHORITY'S REQUIREMENTS AND SHALL BE IN ACCORDANCE WITH SANS 10400, SANS 2100 NATIONAL BUILDING REGULATIONS AND SANS 10155 ACCURACY IN BUILDINGS

CLIENT



IMPLEMENTING AGENT



ARCHITECT



JOHANNESBURG
Unit 25, Witwatersrand Office Park
Van Hoof Street, Ruimsig
Johannesburg, 1724
Phone: +27 (0) 11 432 6940
Fax: 085 5188 528

DURBAN
5 Old Main Road, Unit 6, Hilltop
House, KwaZulu-Natal
Phone: 031 258 7651
P.O. Box 1232, Berea, 2001
Email: info@lbcconsulting.co.za

STRUCTURAL CONSULTANT



CENTURION

263A West Avenue
PO BOX 3173, Pretoria, 0001
Gauteng, South Africa

+27 (0) 12 421 3501 fax
Reg No. 1986/00628/07

PROJECT

TASEZ SECTOR 7

REM PTN 796 (A PORTION OF 601)
ON THE FARM THE WILLOWS
NO.340-JR)

BUILDING/FACILITY/ZONE
TASEZ SECTOR 7

PROJECT NUMBER

60645999

SHEET TITLE

LOWER ROOF LAYOUT - OVERALL

DISCIPLINE

STRUCTURES

DRAWING NUMBER

TZC7-ACM-XX-XX-DR-SE-010060-C-2
PROJECT: TASEZ SECTOR 7
LEVEL: TYPE: ROLE: SERIAL: NO: STATUS: REV:
TZC7 - ACM - XX - XX - DR - SE - 010060 - C - 2
BID/PTP/PRELIMINARY/REVISION/ISSUED FOR CONSTRUCTION/AS BUILT/RECORD/CONSULTED
SCALE 1:200 PAPER SIZE A0