
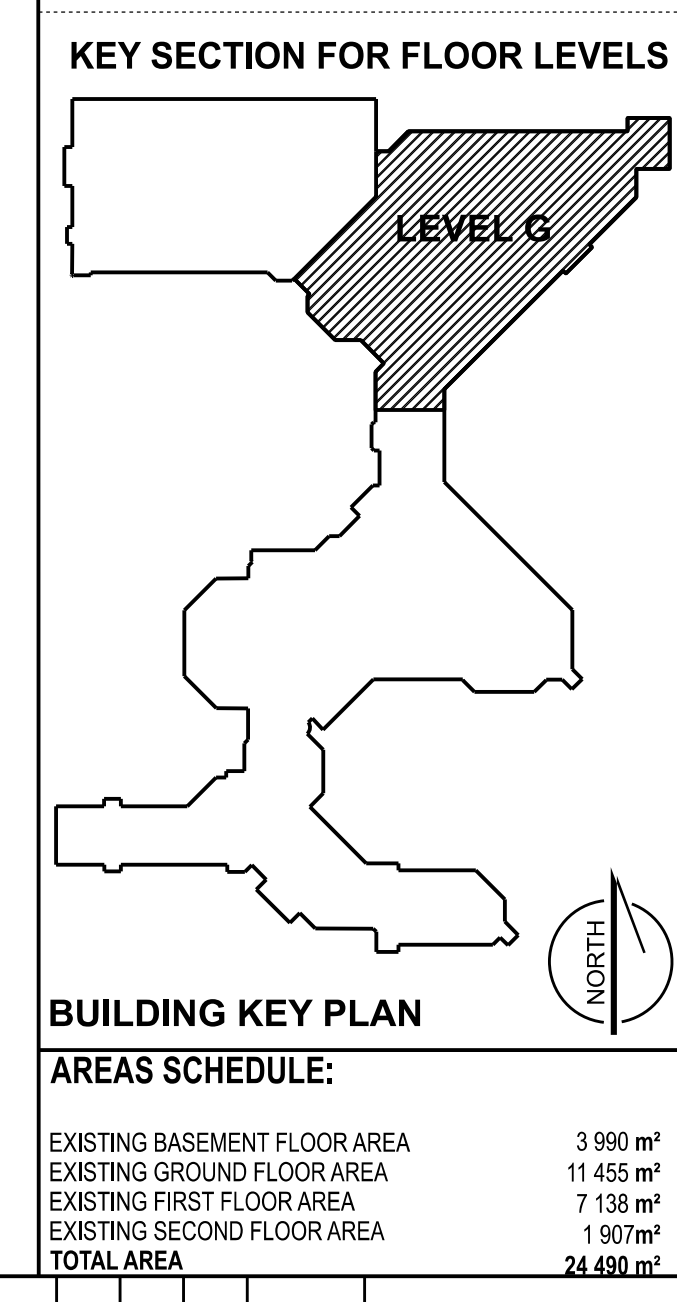


G
FLOOR LEVEL
NORTH WEST WING: KITCHEN
SCALE 1:100

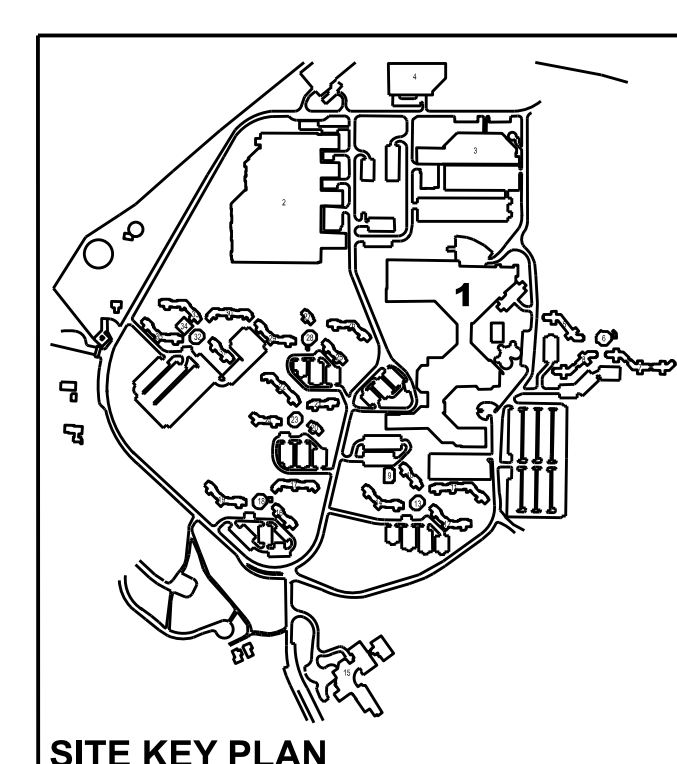

D.O. REV. 1		AS-BUILT	1/M	2016/10/10	EA-4850/100-111
AUTHORISED PERSON		REVISION	REV. 1	2016/10/10	REFERENCE DRAWINGS
5 OF 16		CLASSIFICATION	AS-BUILT	2016/10/10	REFERENCE DRAWINGS
COPIED BY:		CLASSIFICATION	AS-BUILT	2016/10/10	REFERENCE DRAWINGS
APPROVED BY:		CLASSIFICATION	AS-BUILT	2016/10/10	REFERENCE DRAWINGS
CHECKED BY:		CLASSIFICATION	AS-BUILT	2016/10/10	REFERENCE DRAWINGS
CREATED BY:		CLASSIFICATION	AS-BUILT	2016/10/10	REFERENCE DRAWINGS
SCALE		AS-SHOWN	1/M	2016/10/10	REFERENCE DRAWINGS
Eskom		ESKOM HOLDINGS LTD 114	100/104	2016/10/10	REFERENCE DRAWINGS
DRAWING CLASSIFICATION: CONTROLLED DISCLOSURE		100/104	1	0	2016/10/10