


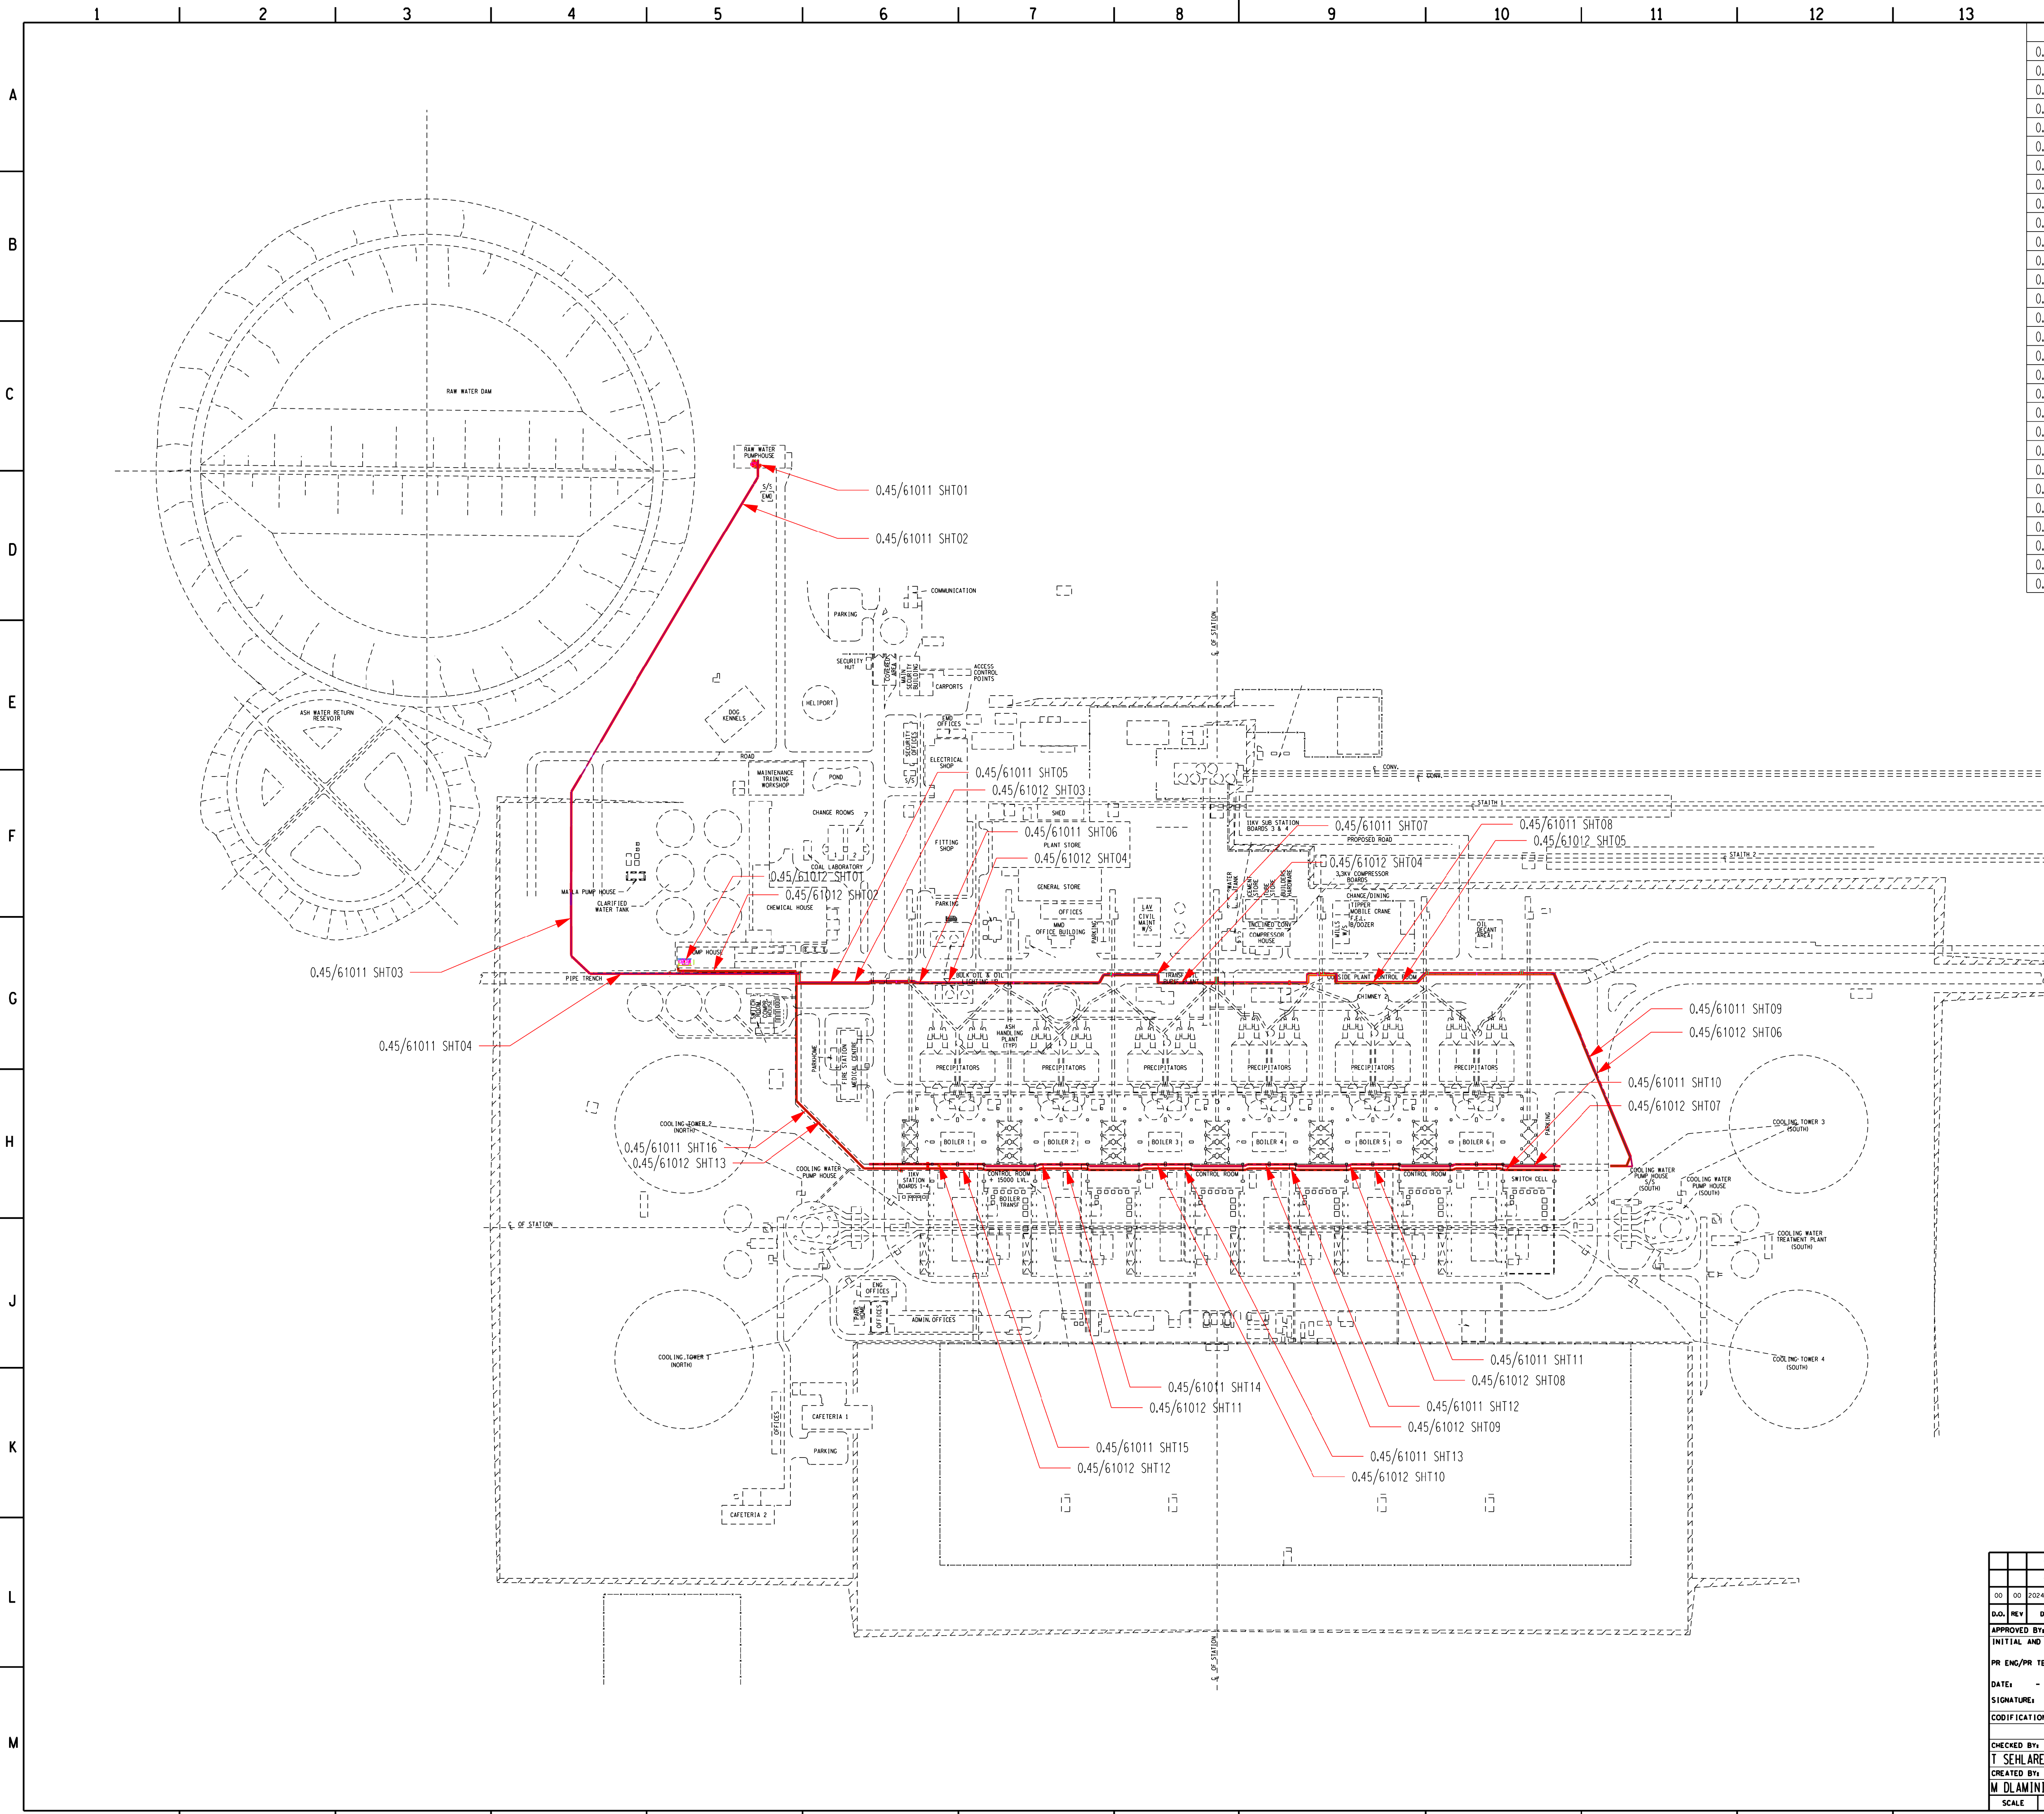

DRAWING NUMBER	DESCRIPTION
0.45/61011 - SHT01	HYDRANT - RAW WATER PUMP HOUSE
0.45/61011 - SHT02	HYDRANT - RAW WATER - SERVICES PUMP HOUSE 1
0.45/61011 - SHT03	HYDRANT - RAW WATER - SERVICES PUMP HOUSE 2
0.45/61011 - SHT04	HYDRANT - RAW WATER - SERVICES PUMP HOUSE 3
0.45/61011 - SHT05	HYDRANT - CHEMICAL HOUSE - BRIDGE
0.45/61011 - SHT06	HYDRANT - BRIDGE BY CHEMICAL HOUSE - UNIT 1
0.45/61011 - SHT07	HYDRANT - UNIT 1 - UNIT 3
0.45/61011 - SHT08	HYDRANT - UNIT 4 - UNIT 6
0.45/61011 - SHT09	HYDRANT - UNIT 6 - CABLE TUNNEL
0.45/61011 - SHT10	HYDRANT - UNIT 6 CABLE TUNNEL
0.45/61011 - SHT11	HYDRANT - UNIT 5 CABLE TUNNEL
0.45/61011 - SHT12	HYDRANT - UNIT 4 CABLE TUNNEL
0.45/61011 - SHT13	HYDRANT - UNIT 3 CABLE TUNNEL
0.45/61011 - SHT14	HYDRANT - UNIT 2 CABLE TUNNEL
0.45/61011 - SHT15	HYDRANT - UNIT 1 CABLE TUNNEL
0.45/61011 - SHT16	HYDRANT - CABLE TUNNEL - BRIDGE BY CHEMICAL HOUSE
0.45/61012 - SHT01	EMULSIFIER - SERVICES PUMP HOUSE
0.45/61012 - SHT02	EMULSIFIER - SERVICES PUMP HOUSE - BRIDGE BY CHEMICAL HOUSE
0.45/61012 - SHT03	EMULSIFIER - BRIDGE BY CHEMICAL HOUSE - UNIT 1
0.45/61012 - SHT04	EMULSIFIER - UNIT 1 - UNIT 3
0.45/61012 - SHT05	EMULSIFIER - UNIT 4 - UNIT 6
0.45/61012 - SHT06	EMULSIFIER - UNIT 6 - CABLE TUNNEL
0.45/61012 - SHT07	EMULSIFIER - UNIT 6 CABLE TUNNEL
0.45/61012 - SHT08	EMULSIFIER - UNIT 5 CABLE TUNNEL
0.45/61012 - SHT09	EMULSIFIER - UNIT 4 CABLE TUNNEL
0.45/61012 - SHT10	EMULSIFIER - UNIT 3 CABLE TUNNEL
0.45/61012 - SHT11	EMULSIFIER - UNIT 2 CABLE TUNNEL
0.45/61012 - SHT12	EMULSIFIER - UNIT 1 CABLE TUNNEL
0.45/61012 - SHT13	EMULSIFIER - CABLE TUNNEL - BRIDGE BY CHEMICAL HOUSE

D.O. REV		DATE	REVISION		REV BY	CHEK BY	E.S. APPR	APPR BY	REFERENCE DRAWINGS
00		00	2024/08/02		AS BUILT PLANT				
APPROVED BY:			CLASSIFICATION			KRIEL POWER STATION ISOMETRIC DRAWING FIRE PROTECTION SYSTEM HYDRANT AND EMULSIFIER FIRE SYSTEM PLOT PLAN			
INITIAL AND SURNAME:			PBS PATH						
PR ENG/PR TECH ENG No.:									
DATE:									
SIGNATURE:									
CODIFICATION BY:									
CHECKED BY:			2024/08/02			Eskom ESKOM HOLDINGS SOC. LTD REG No 2002/015521/30			
CREATED BY:			2024/08/01						
SCALE:			NTC						
			0.45/61010			SHT 01		REV 00	

DRAWING CLASSIFICATION: CONTROLLED DISCLOSURE