

1

2

3

4


5

6

NOTE:
1. THIS DESIGN IS COPYRIGHT AND REMAINS THE PROPERTY OF THE ARCHITECT.
2. ALL WORK TO BE CARRIED OUT IN STRICT ACCORDANCE WITH THE NATIONAL BUILDING REGULATIONS, TO BE CHECKED ON SITE BEFORE COMMENCING WITH ANY WORK.
3. ANY DISCREPANCIES TO BE REPORTED TO THE ARCHITECT IMMEDIATELY. WORK TO PROCEED ONCE THE PROBLEM HAS BEEN RESOLVED.
DRAWING NOT TO BE SCALED.

REVISIONS	
REV	DATE

REVISIONS	
REV	DATE
A	07.12.12
B	08.01.21
C	08.01.24
D	08.01.29
E	08.02.01
F	08.02.06
G	08.02.13
H	08.03.03
I	08.03.17
J	08.03.28
K	08.04.01
L	08.04.16
M	08.04.25
N	08.05.12
O	08.05.28
P	08.06.03
Q	08.10.11
R	09.01.16
S	09.02.03



389 ALBERT ROAD
SALT RIVER CIRCLE
PO BOX 71 WOODSTOCK 7525
T: +27 21 448 8851
F: +27 21 448 8851
E: MAIL: acg@acgplan.co.za

CLIENT
PETRO SA

PROJECT:
**PETRO SA
OFFICE EXTENSION**

DRAWING TITLE
**LEVEL 2 PLAN
EXTENSION & EXISTING**

DRAWN	CHECKED	DATE FIRST ISSUED
LR	GG	07/11/29

FOR INFORMATION


DISCIPLINE	DRAWING NUMBER	REVISION
A	104	S

REFER DRAWING TO:


LEVEL 2a
SCALE @ 1:100

REFER DRAWING TO:

LEVEL 2b
SCALE @ 1:100

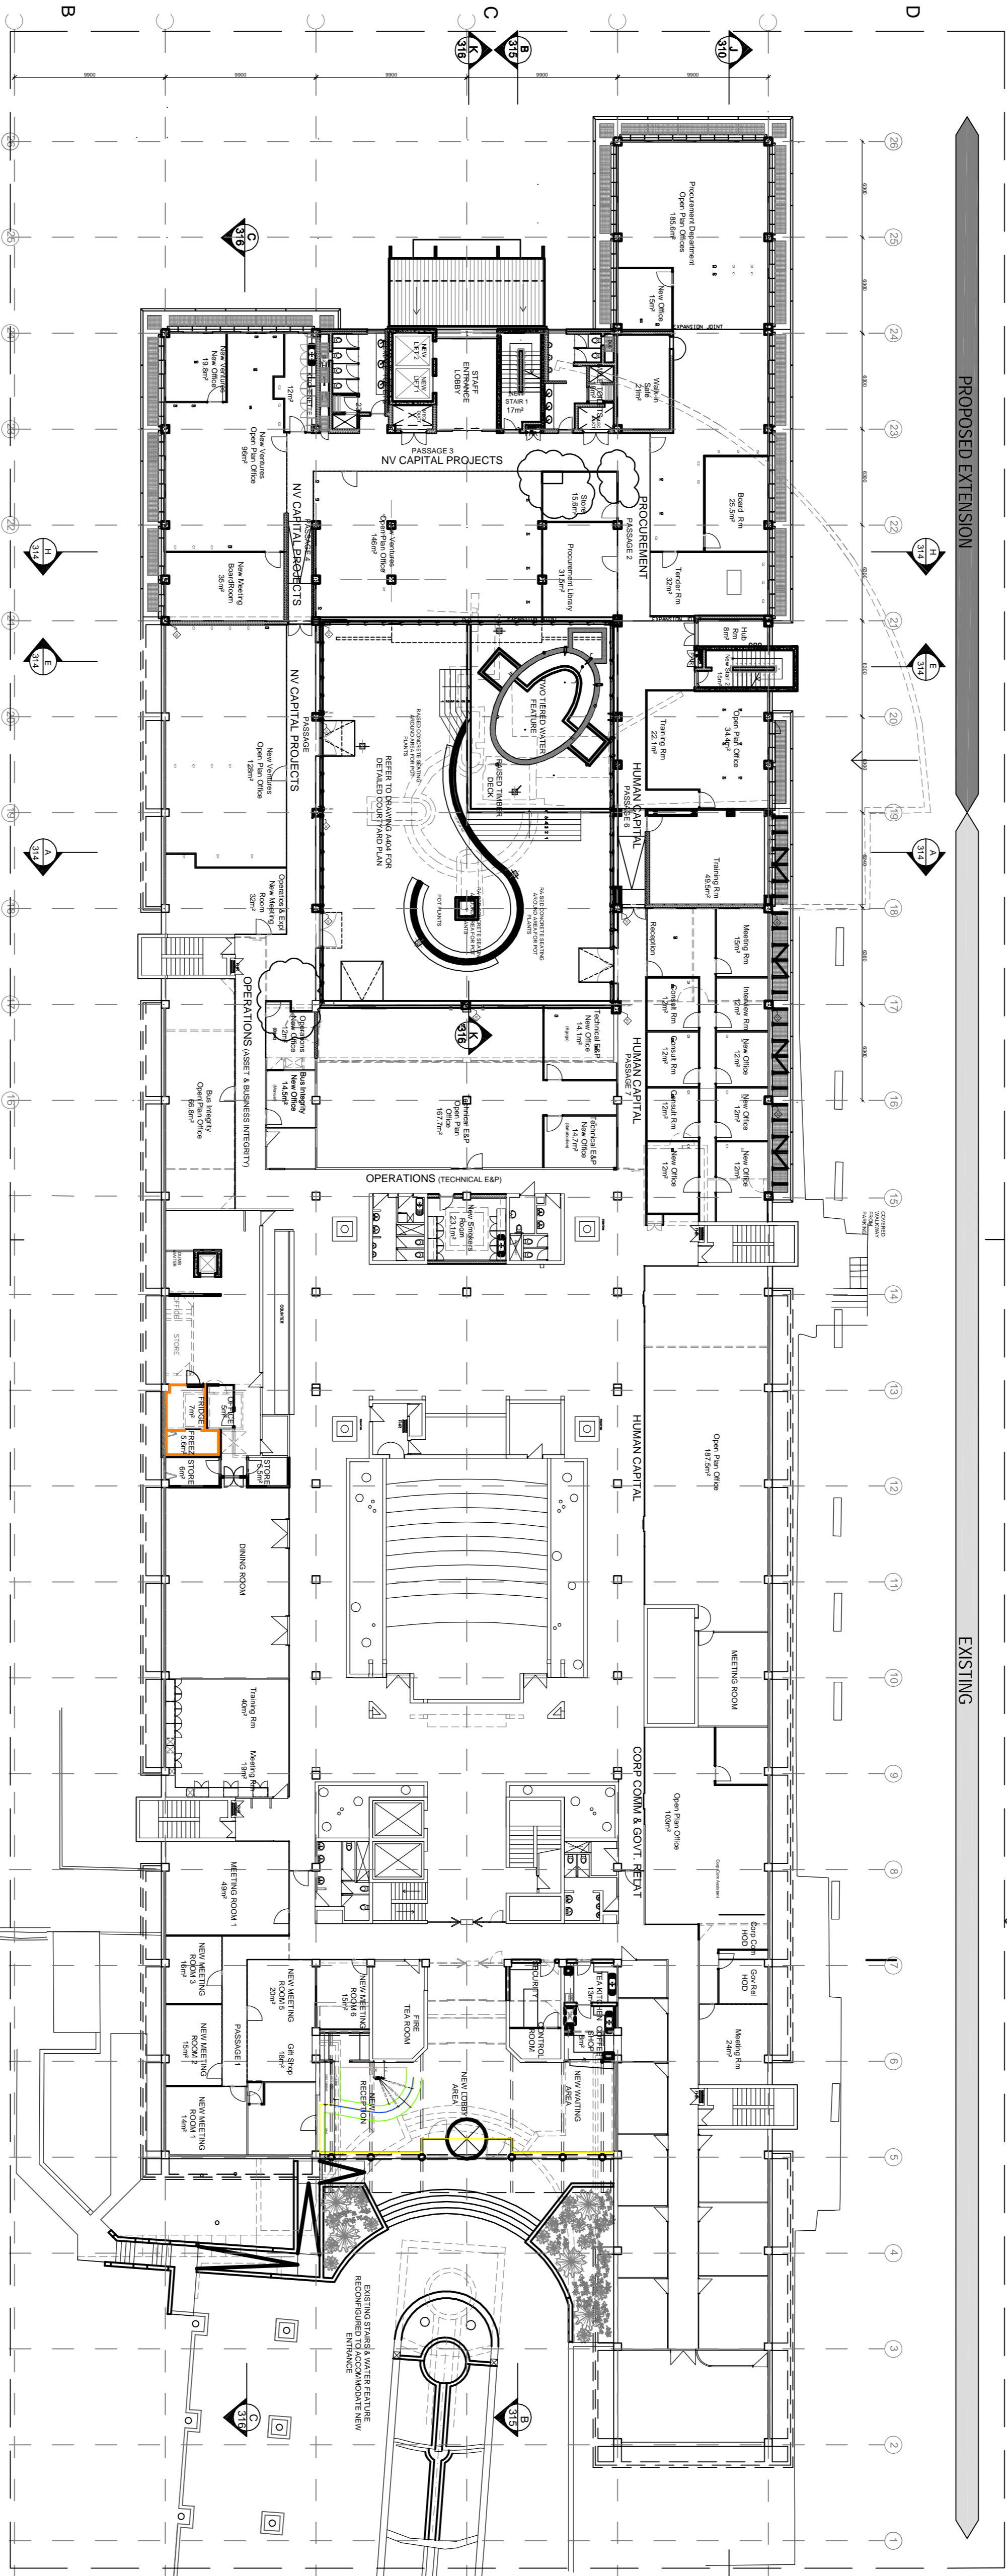

LEVEL 2 PLAN
SCALE 1:250 @ A1

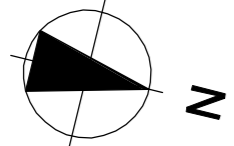

AS BUILT DRAWINGS
BP NO. 0666/2008
ERF NO. 19801(3471)

AS - BUILT DRAWINGS DISCLAIMER:

AS - BUILT DRAWINGS ARE COPIES OF THE LAST DRAWINGS ISSUED FOR CONSTRUCTION TO THE CONTRACTOR AND INCLUDE WHERE RELEVANT, CONTRACT INSTRUCTIONS REGARDING THE WORKS. ALTHOUGH EVERY CARE IS EXPENDED BY ACG ARCHITECTS & DEVELOPMENT PLANNERS TO PROVIDE TO OUR CLIENT IN GOOD FAITH, AS - BUILT DRAWINGS ARE NOT SURVEY DRAWINGS AND SHOULD NOT BE SCALED IN PREFERENCE TO THE DRAWINGS. THE LEVELS DERIVED ON THE DRAWINGS HAVE BEEN VERIFIED BY ON - SITE SURVEY OR MEASUREMENT. AS - BUILT DRAWINGS ARE NOT TO BE USED FOR ANY PURPOSE OTHER THAN OUR CLIENT SHOULD FUTURE WORK BE UNDERTAKEN TO THE BUILDING DERIVED ON THE DRAWINGS. THE SERVICES OF A PROFESSIONAL LAND SURVEYOR SHOULD BE UTILISED TO OBTAIN ACCURATE DIMENSIONS AND LEVELS DERIVED THEREON.