

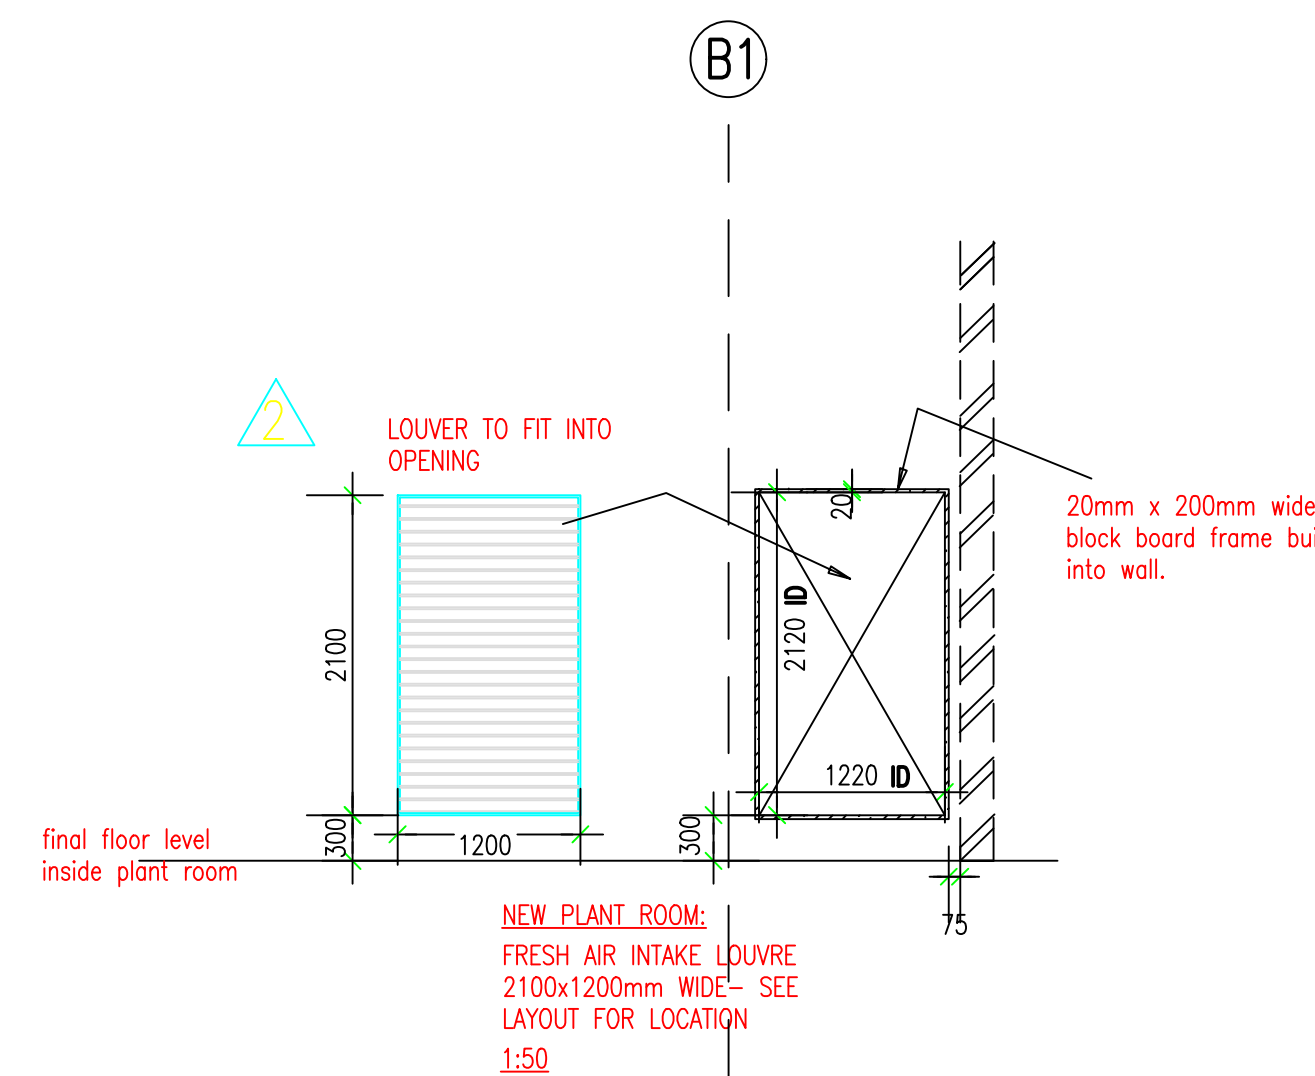
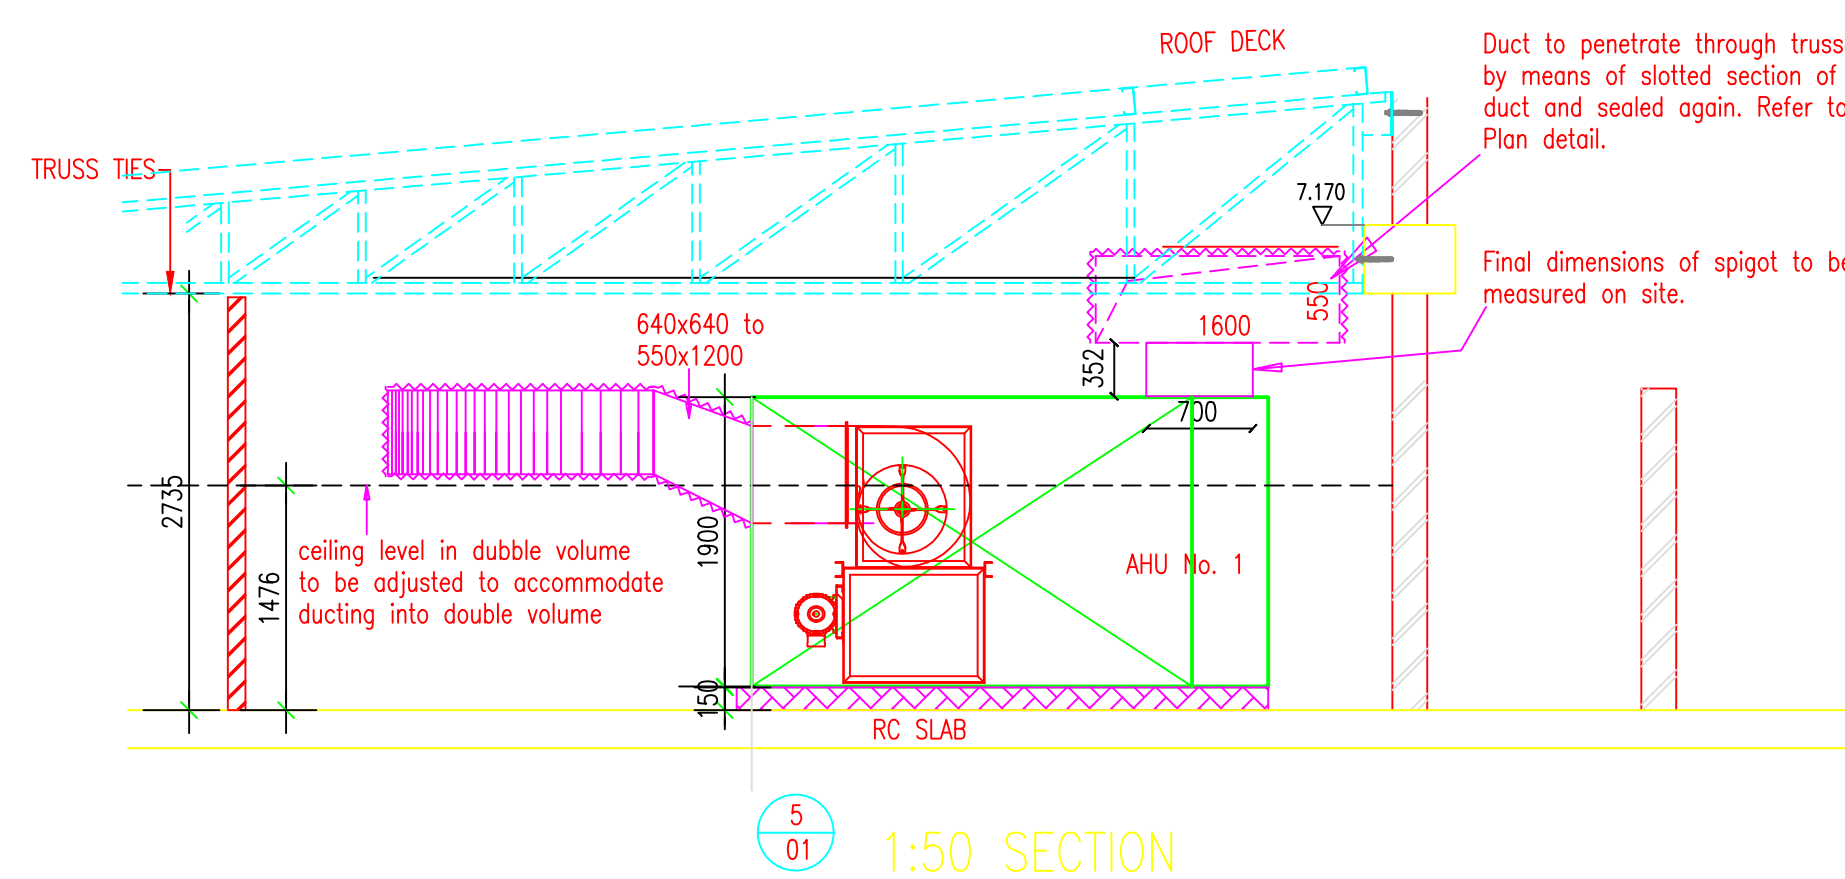
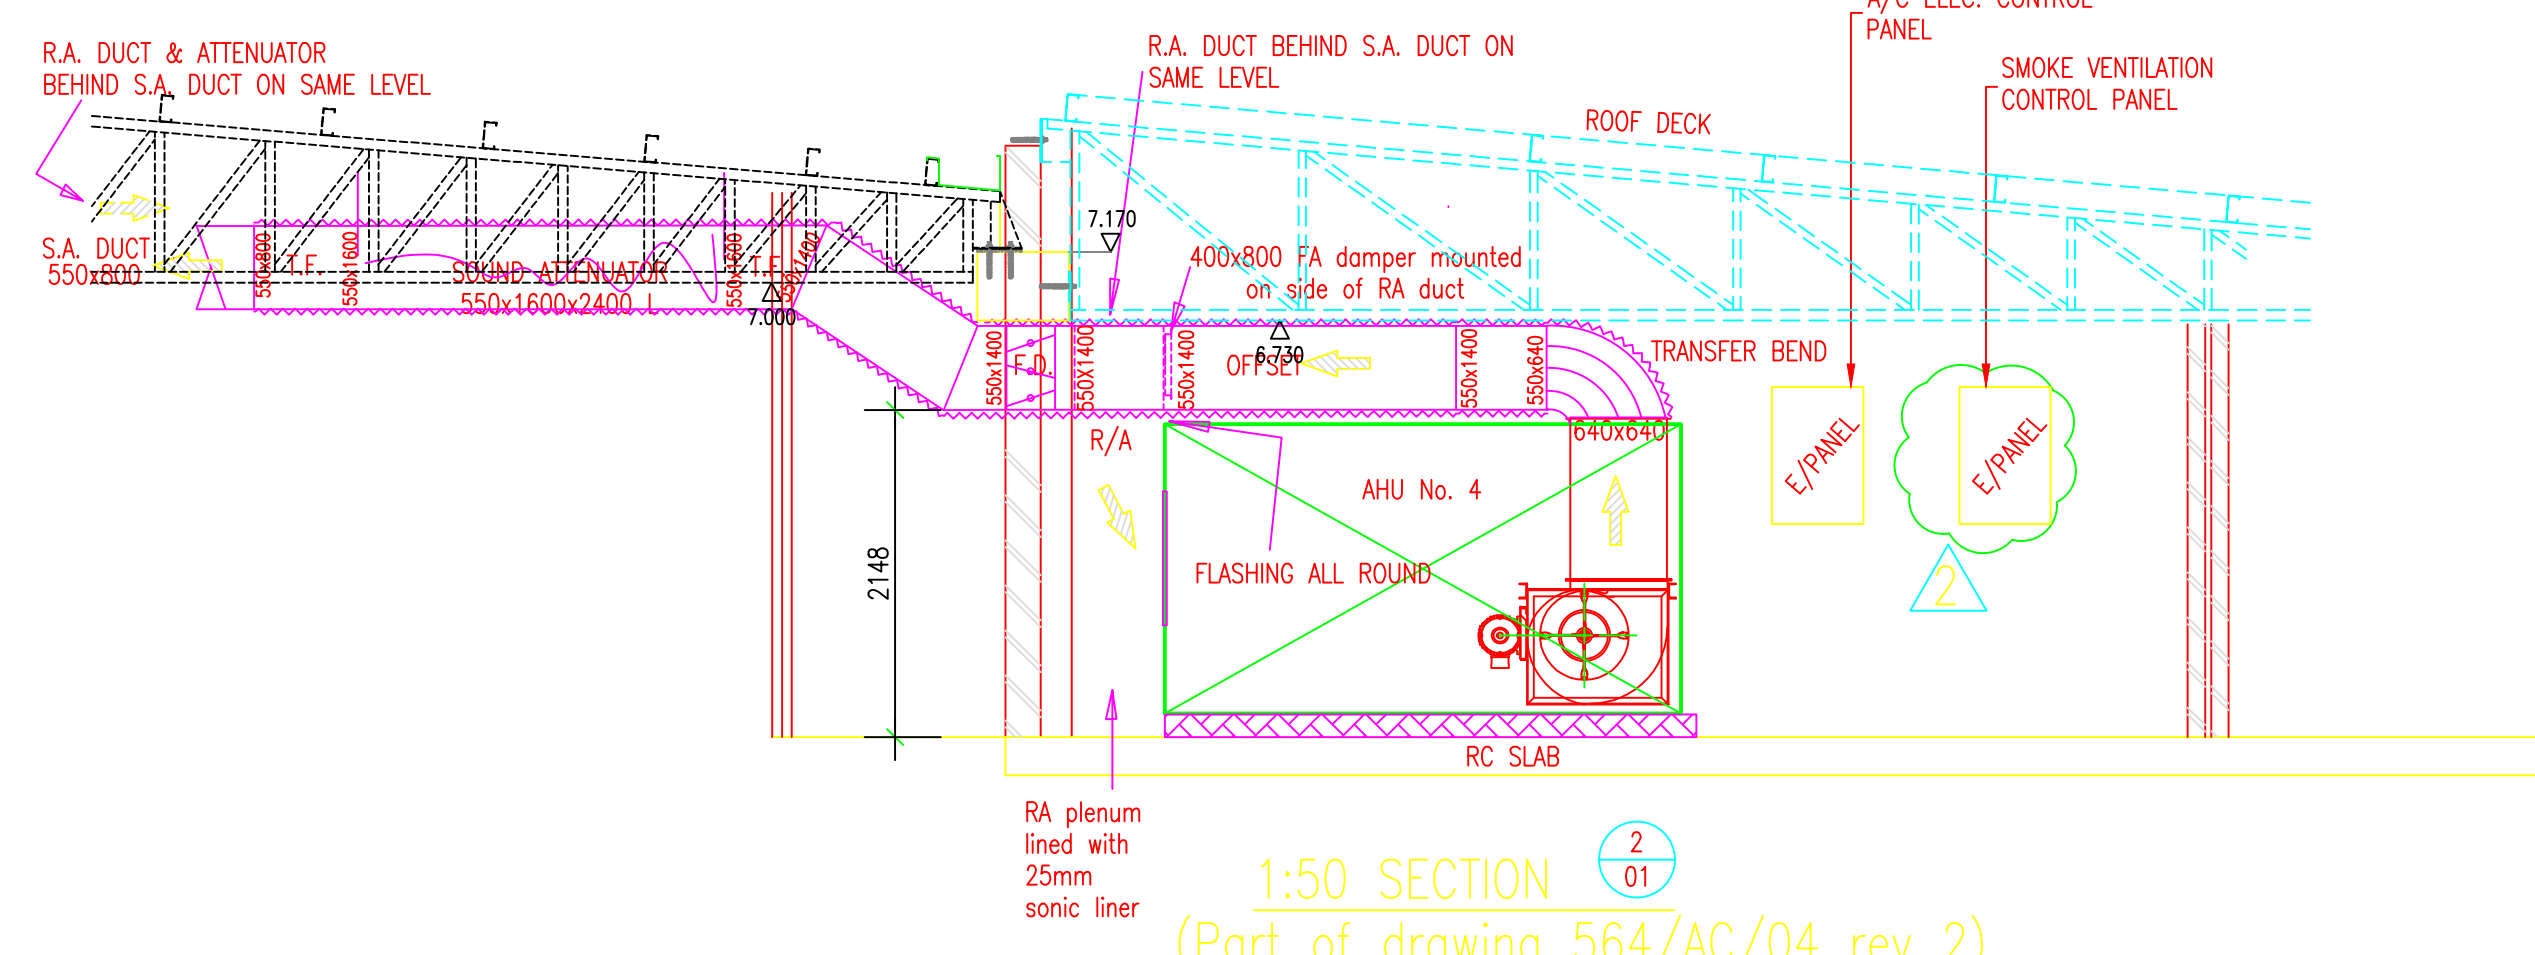
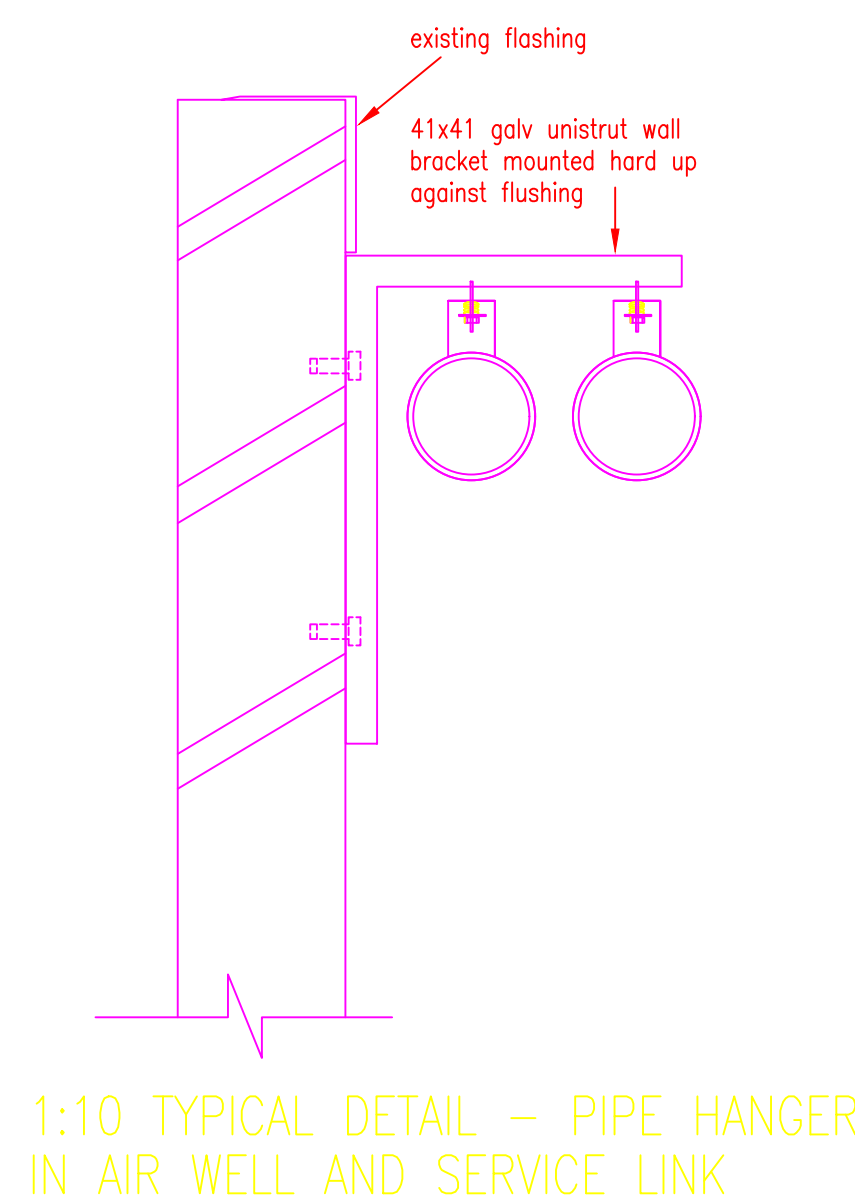
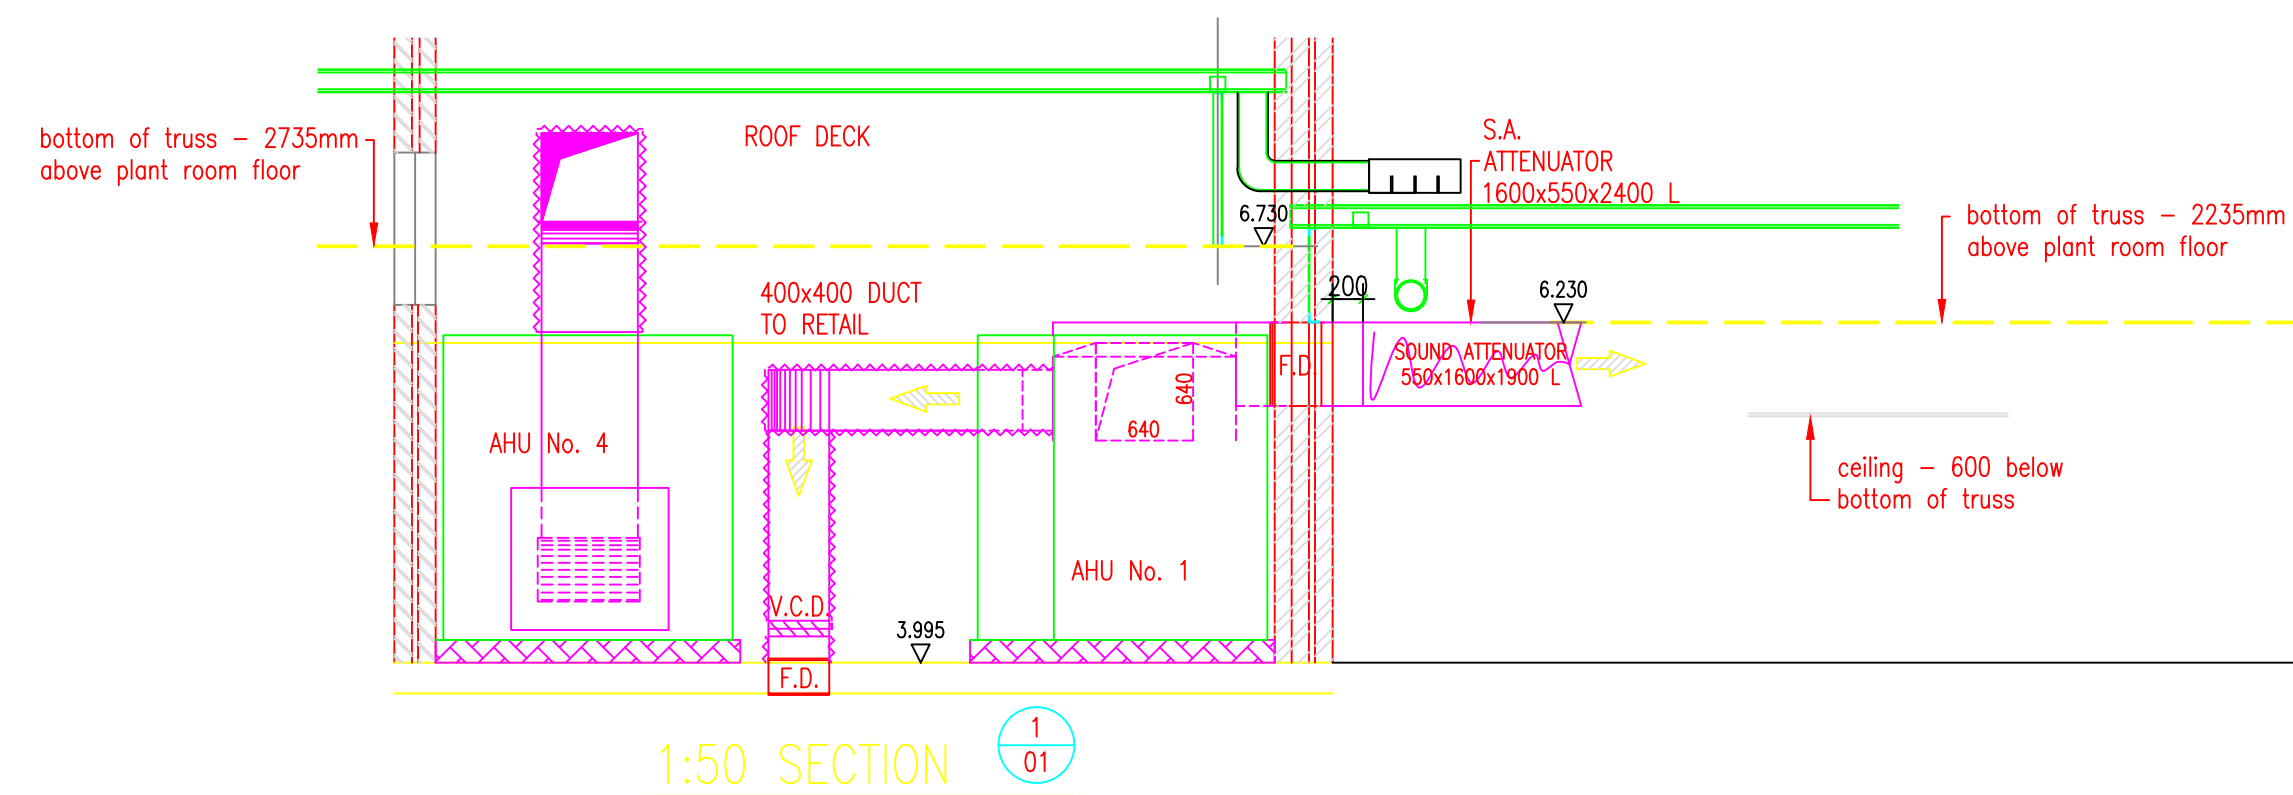
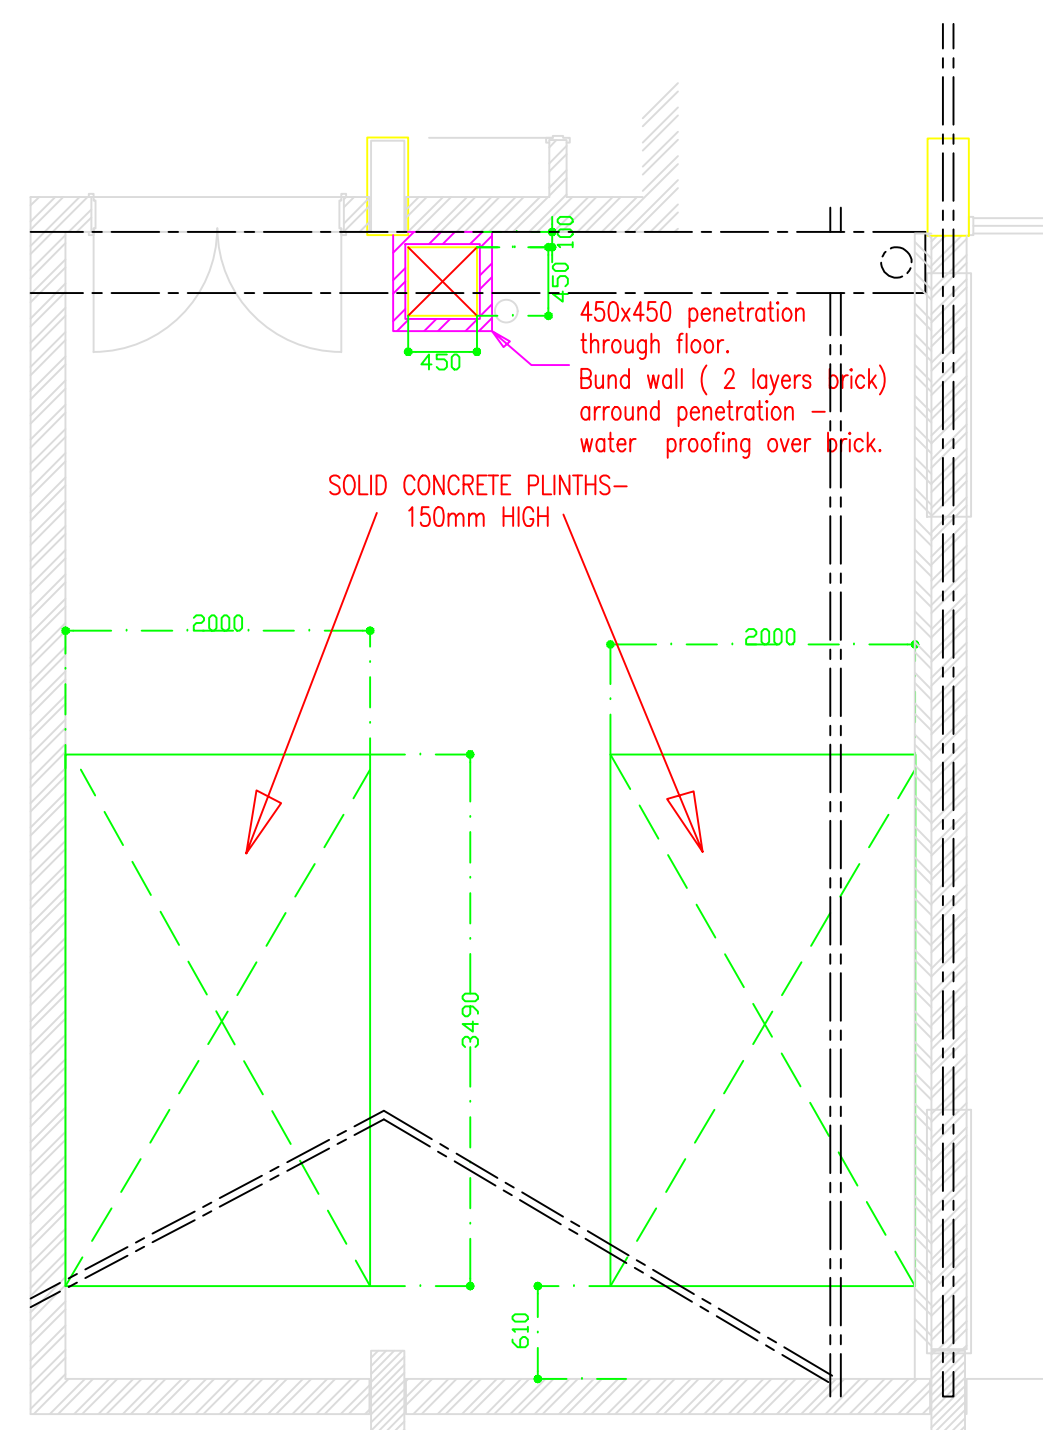
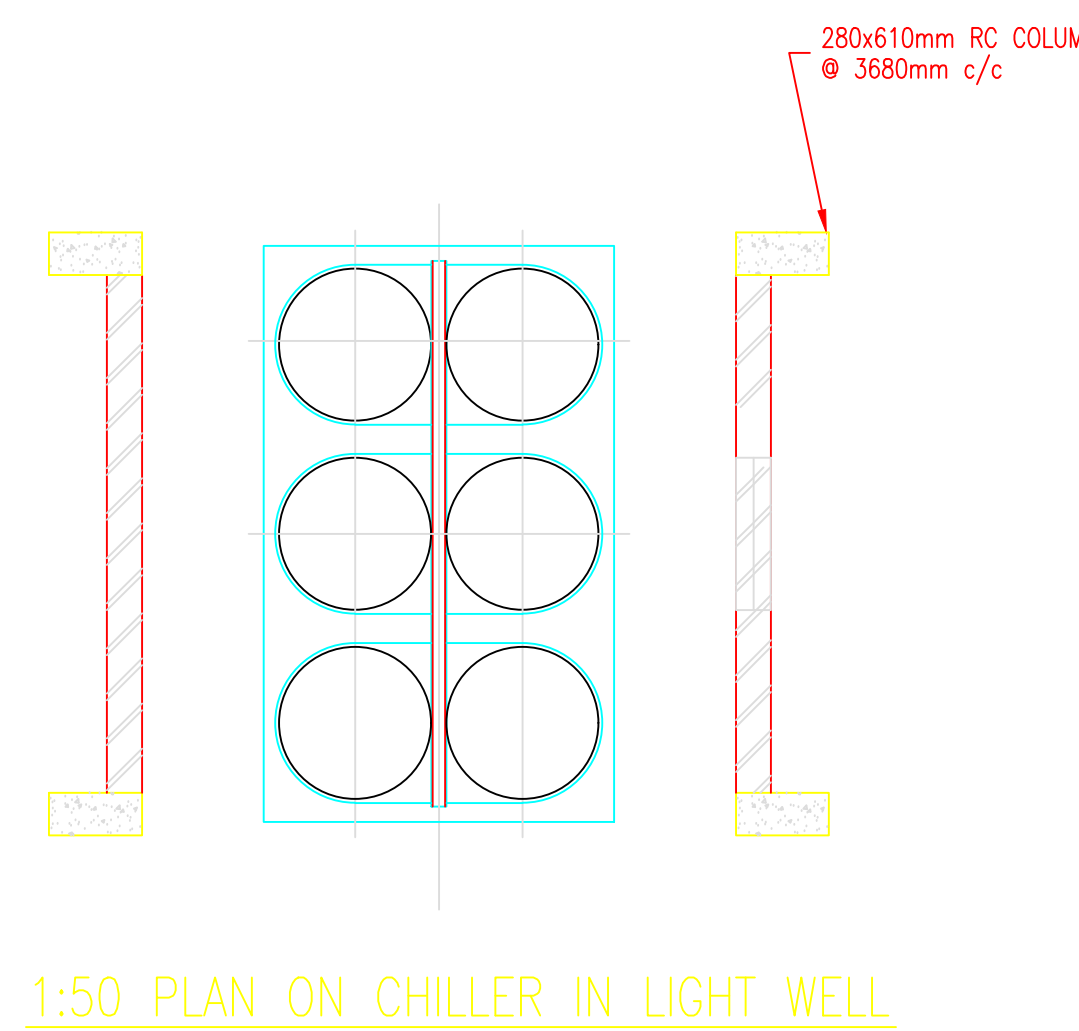
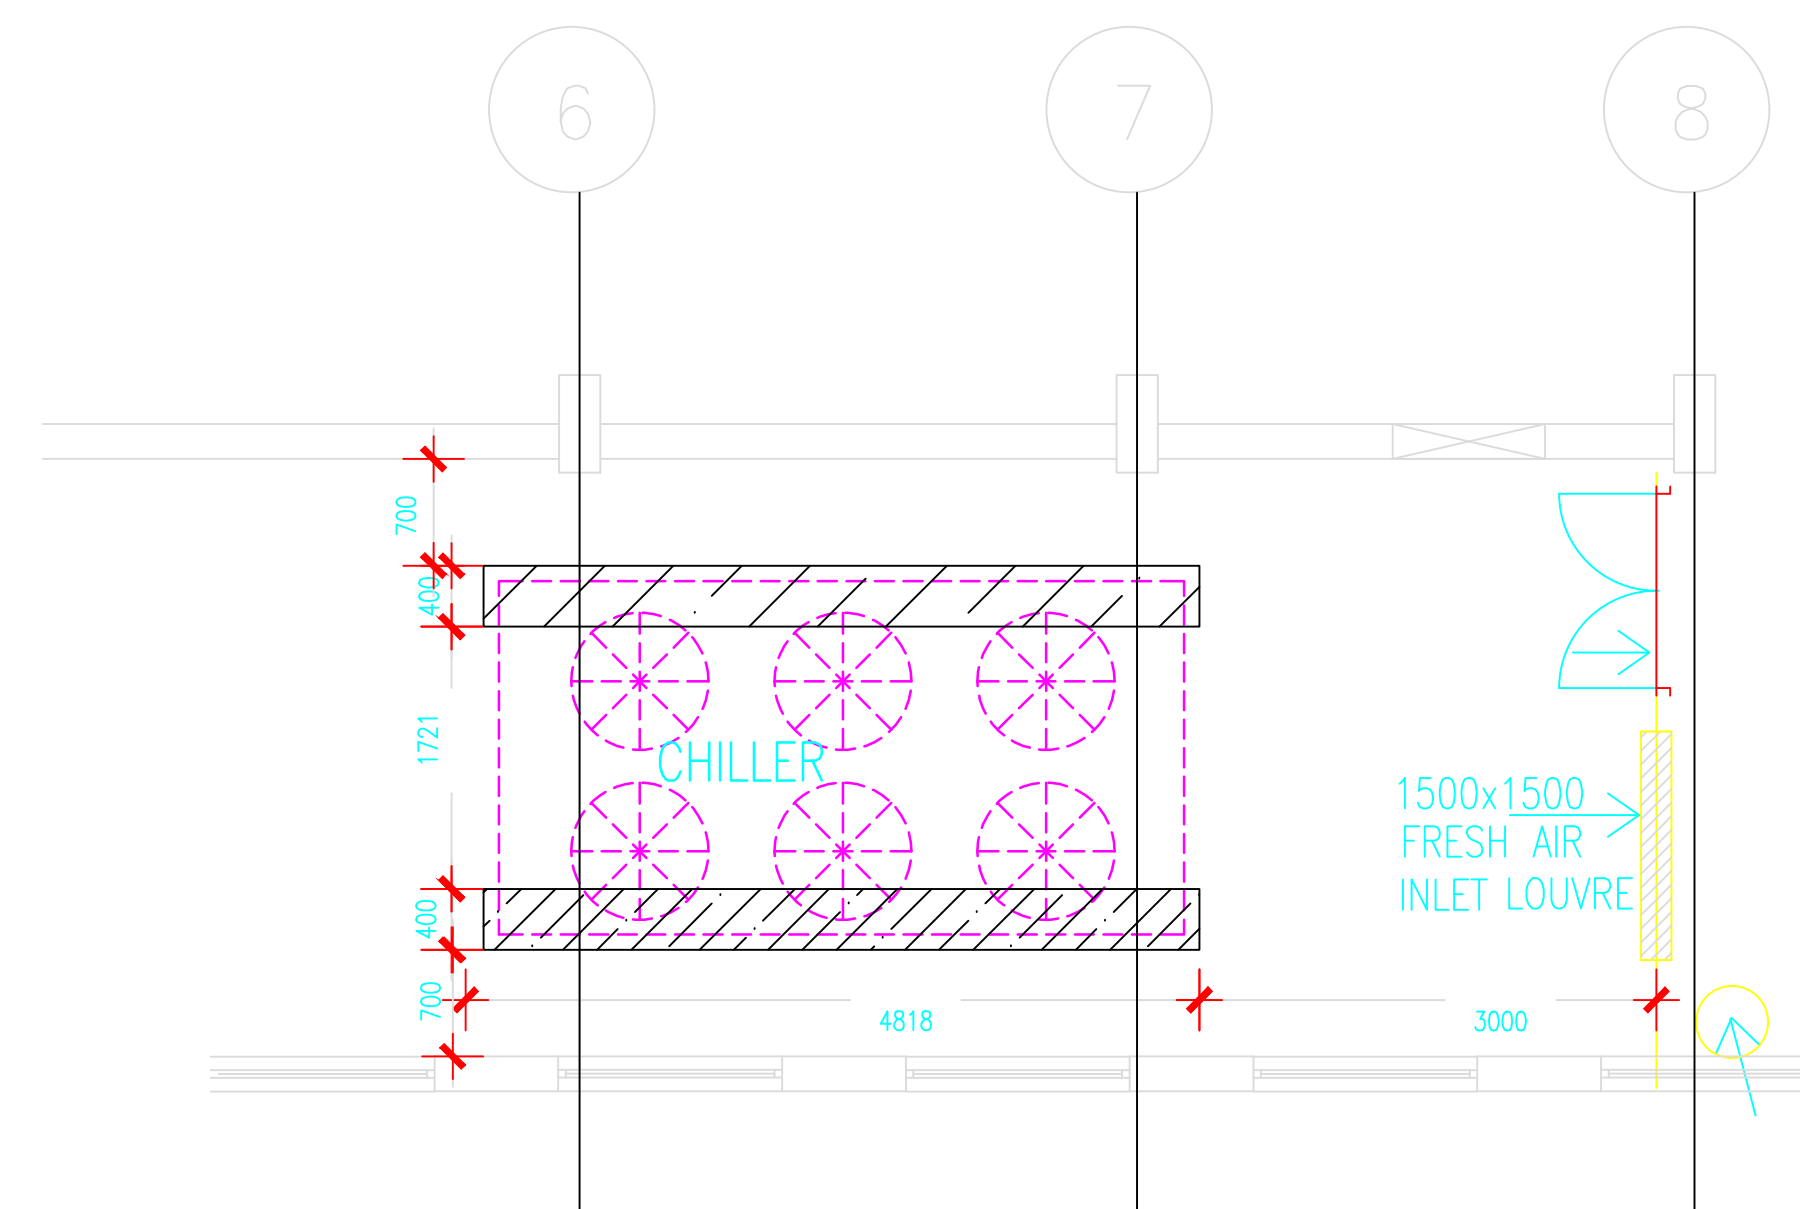
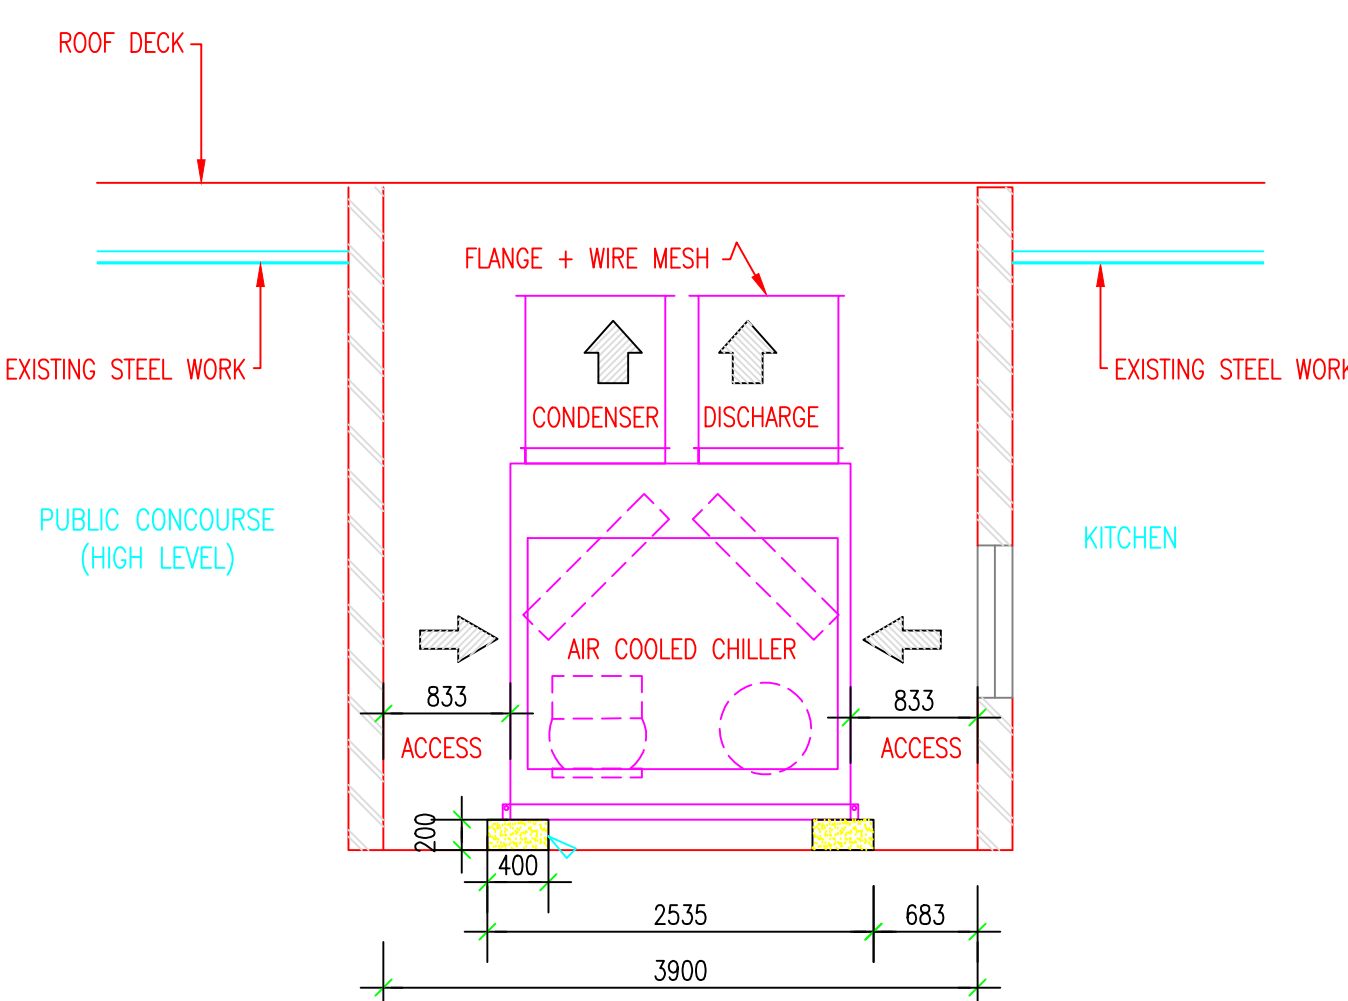
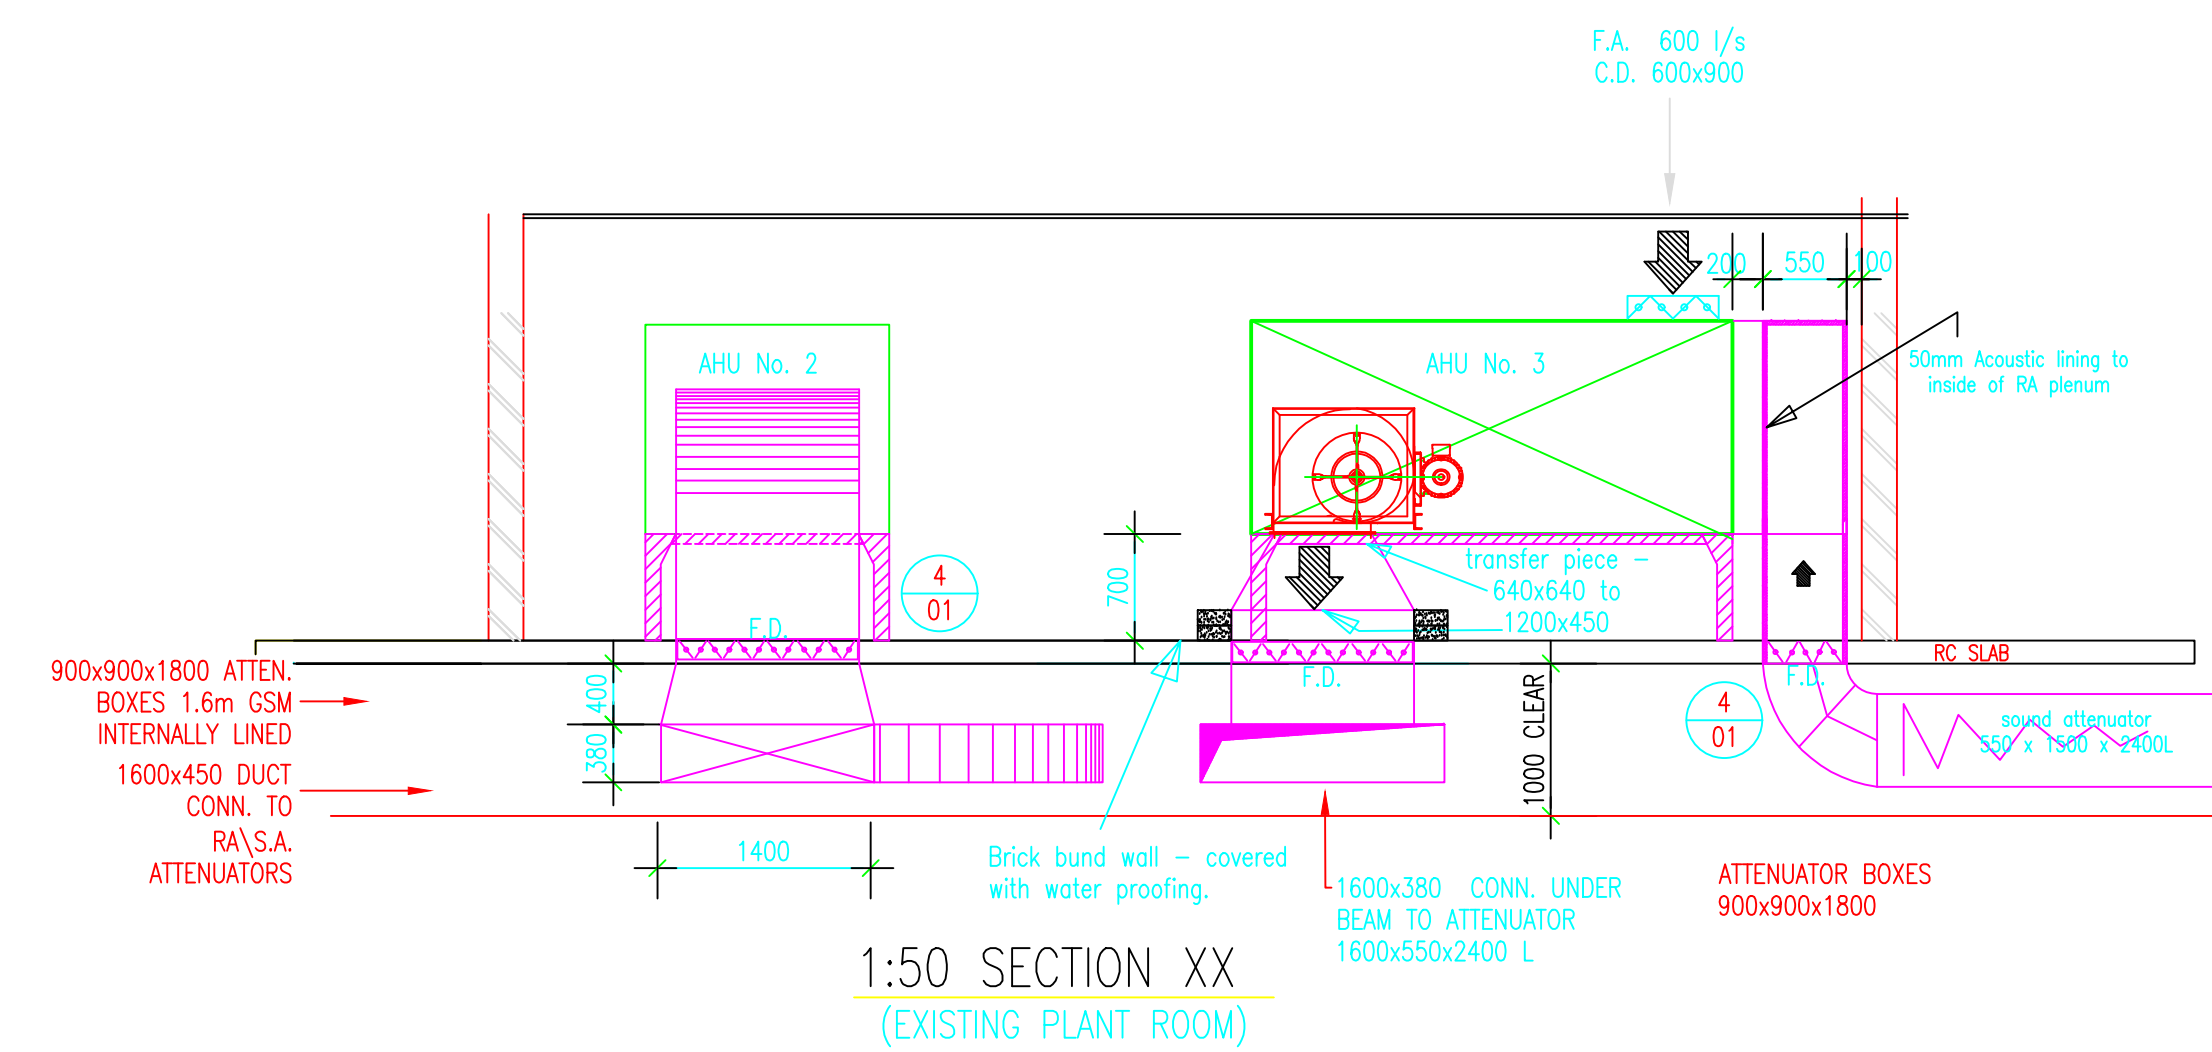
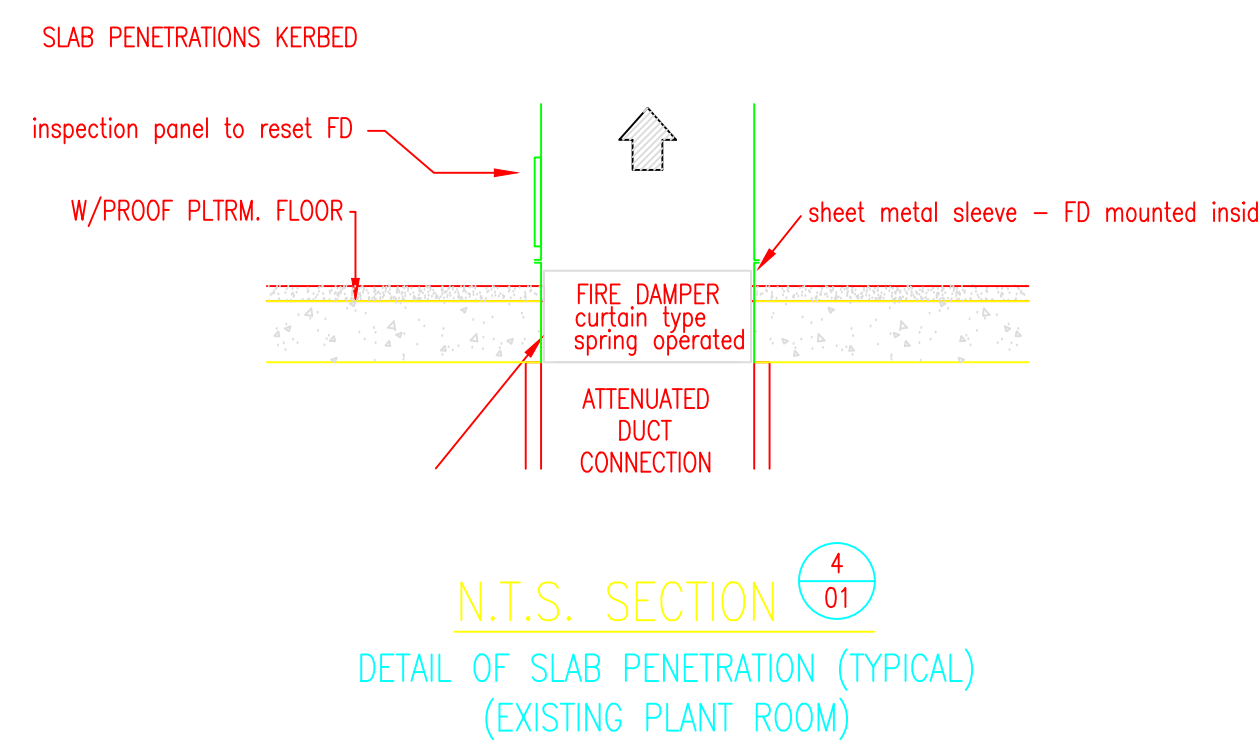


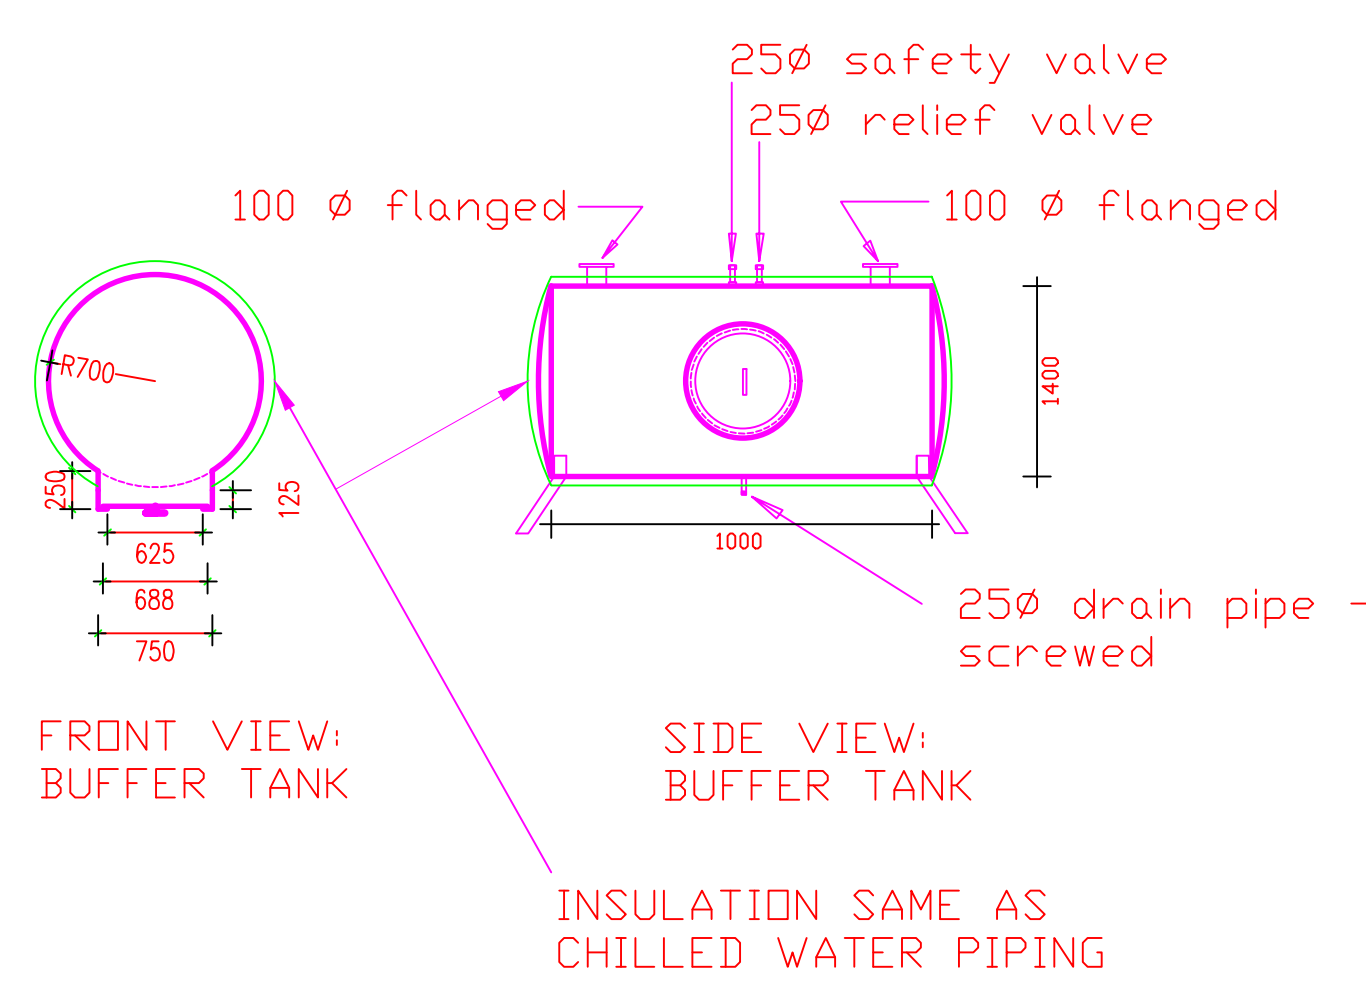


LEGEND
F.D. FIRE DAMPER
C.D. CONTROL DAMPER
F.A. FRESH AIR
R.A. RETURN AIR
S.A. SUPPLY AIR
V.C.D. VOLUME CONTROL DAMPER

2	REVISED TO SUIT ARCH'S LATEST REVISION	TM	CVG	04/05/06
1	DROPPER MOVED	SR	CVG	04/04/06
0	FOR CONSTRUCTION	SR	AC	30/03/06
REV	DESCRIPTION	DR.	APPL.	DATE

DESIGNED	INITIALS	SIGN	DATE
DRAWN	TM		10.10.05
PROJECT ENG.	CVG		
APPROVED	AC		

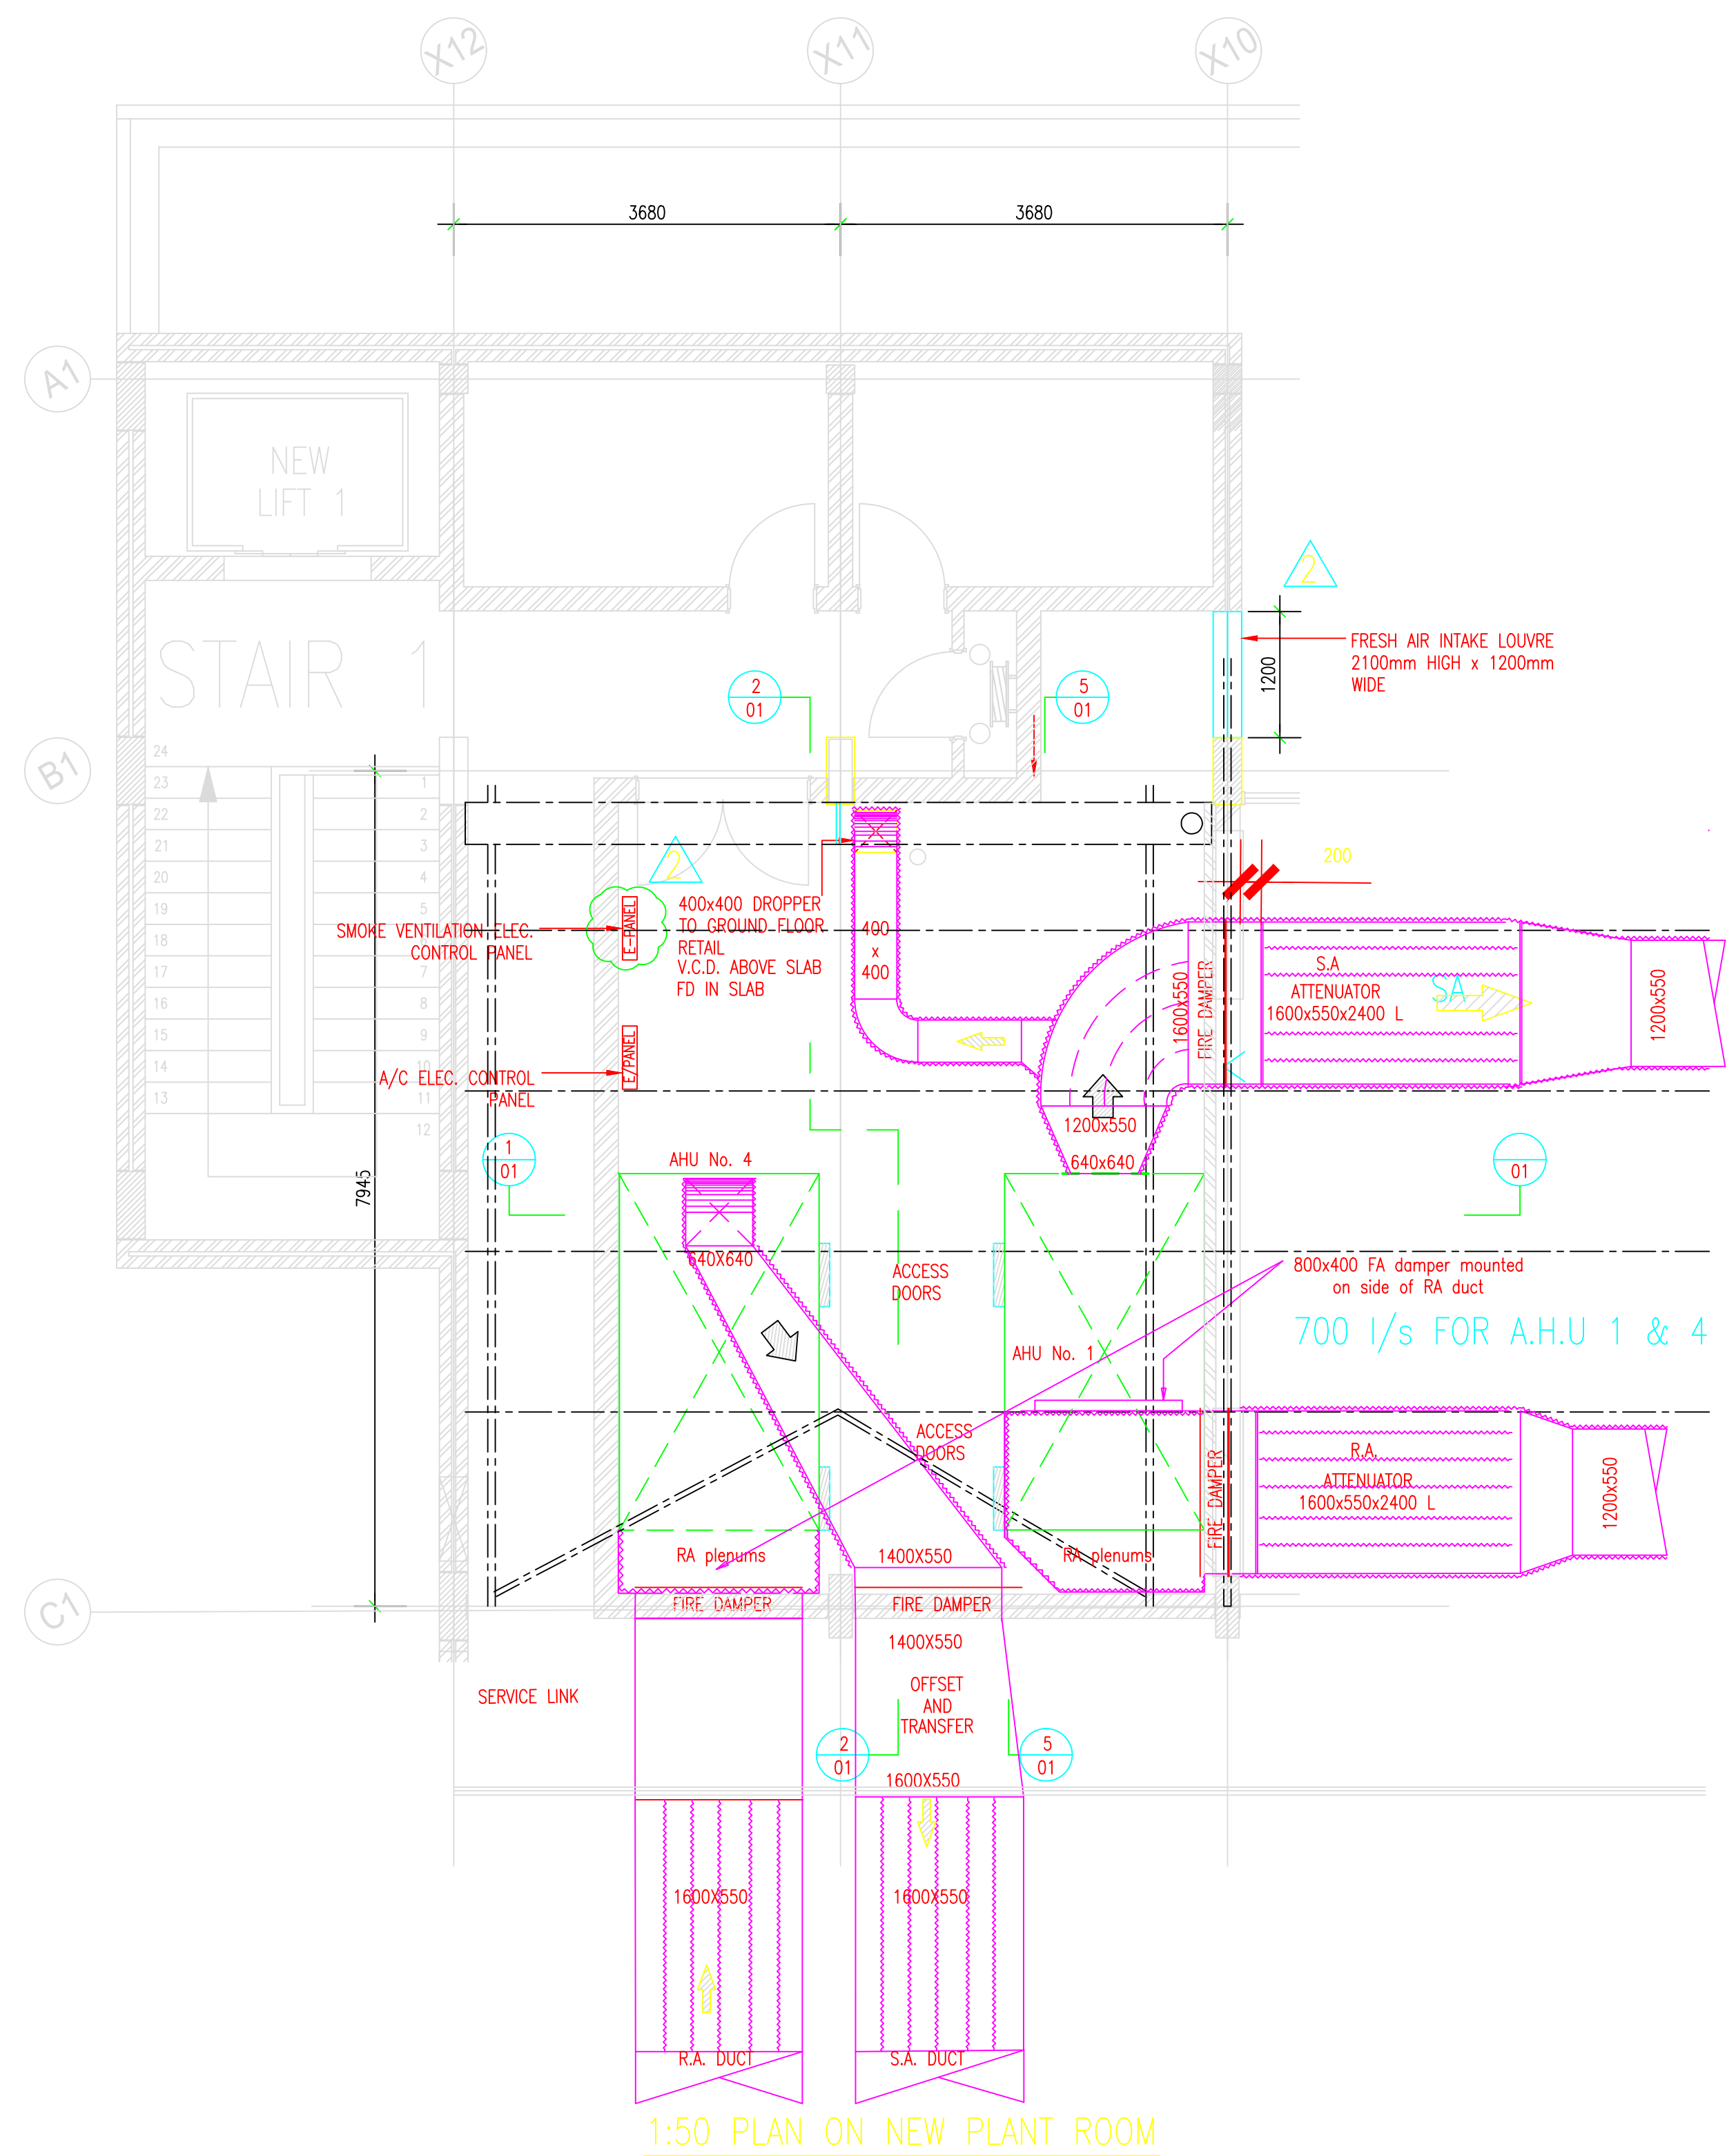

REVISION	DESCRIPTION	BY	DATE
4	AS BUILT	ES	06/05/07
3	AHU 1 MOVED & BUILT INTO NEW	TL	17/07/06
2	PIPE HANGERS DETAIL ADDED	PJS	30/06/05
1	APPROVAL	PJS	06/06/05

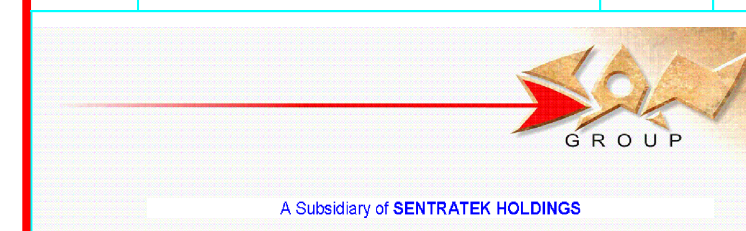

APPROVED BY	MECHANICAL	PHZ	DATE	03/05/07
	ELECTRICAL	PHZ	DATE	03/05/07
	PROJECT LEADER	PHZ	DATE	03/05/07
	CONTROL TIME	AC	DATE	03/05/07

AS BUILT NEW ADDITIONS
TO THE TERMINAL BUILDINGS
GEORGE AIRPORT - PHASE 3

SERVICE
DETAILS
AC PLANT ROOM

DESIGN	DATE	DRAWN	DATE
JIS		ES	05/06/06
PROJ. NO	DRAWING NO	Revision	
564	564/AC04	4	
SCALE			AS SHOWN