



LEGEND

- FH = FIRE HYDRANT
- CP = CHANGE POINT
- EP = ELECTRICITY POLE & NO.
- MARKER PRIVATE
- ROCKET
- WAST & No.
- SP = SIGN POST
- MH = MAN HOLE
- LP = LIGHT POLE
- BEGINNING AND END OF CIRCULAR CURVE
- STOP BLOCK
- WARNING BOARD
- STOP / NOTING BOARD

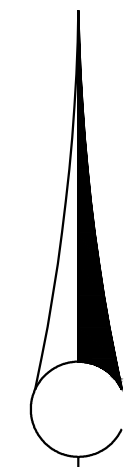

T N

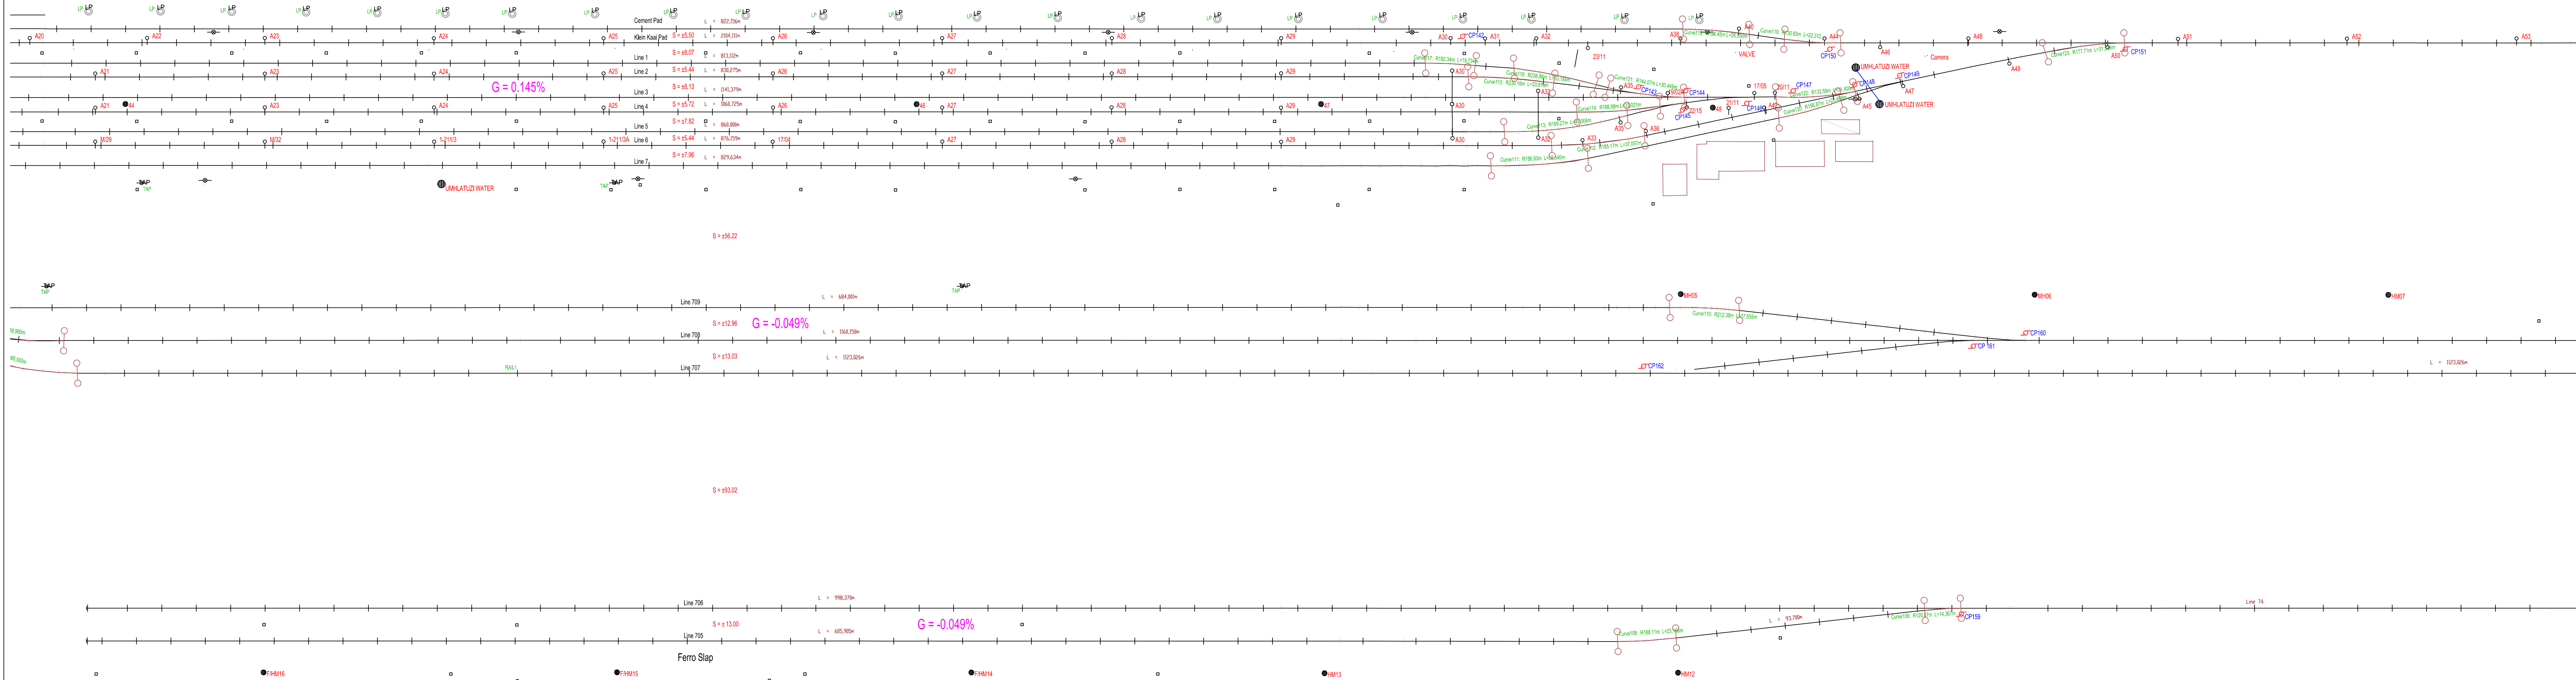

This Survey was conducted by Survey Technicians:
L. W. Danga
Reg. No. 15700 & 15711
Cell: 081 230 1000
E-mail: l.w.danga@transnet.co.za

As Built Drawing for Rail Yard
**PORT of
RICHARDS BAY**

Compiled:	LSD	DATE:	2013-10-11
Checked:	SWZ		
For Area Manager:			
AMENDED:			
SYSTEM:	WG 31°	SCALE:	1 / 1 000

Plan prepared by:
TRANSNET PROPERTY
GEO-SPATIAL, EASTERN REGION
Mr. Andrew Danga
Cell: 081 230 1000
E-mail: a.danga@transnet.co.za

PLAN No. RB_TNPA_RAIL YARD