


















Plan prepared for:
TRANSNET NATIONAL
PORTS AUTHORITY
Mr. Basil Ngcobo
Tel: (011) 595-2955

LEGEND

-  FH = FIRE HYDRANT
 CP = CHANGE POINT
 EP = ELECTRICITY POLE & No.
 MARKER PRIVATE
 ROBOT
 MAST & No.
 SP = SIGN POST
 MH = MAN HOLE
 LP = LIGHT POLE
 BEGINNING AND END OF CIRCULAR CURVE
 BEGINNING AND END OF TRANSITION
 STOP BLOCK
 WARNING BOARD
 STOP / NOTING BOARD

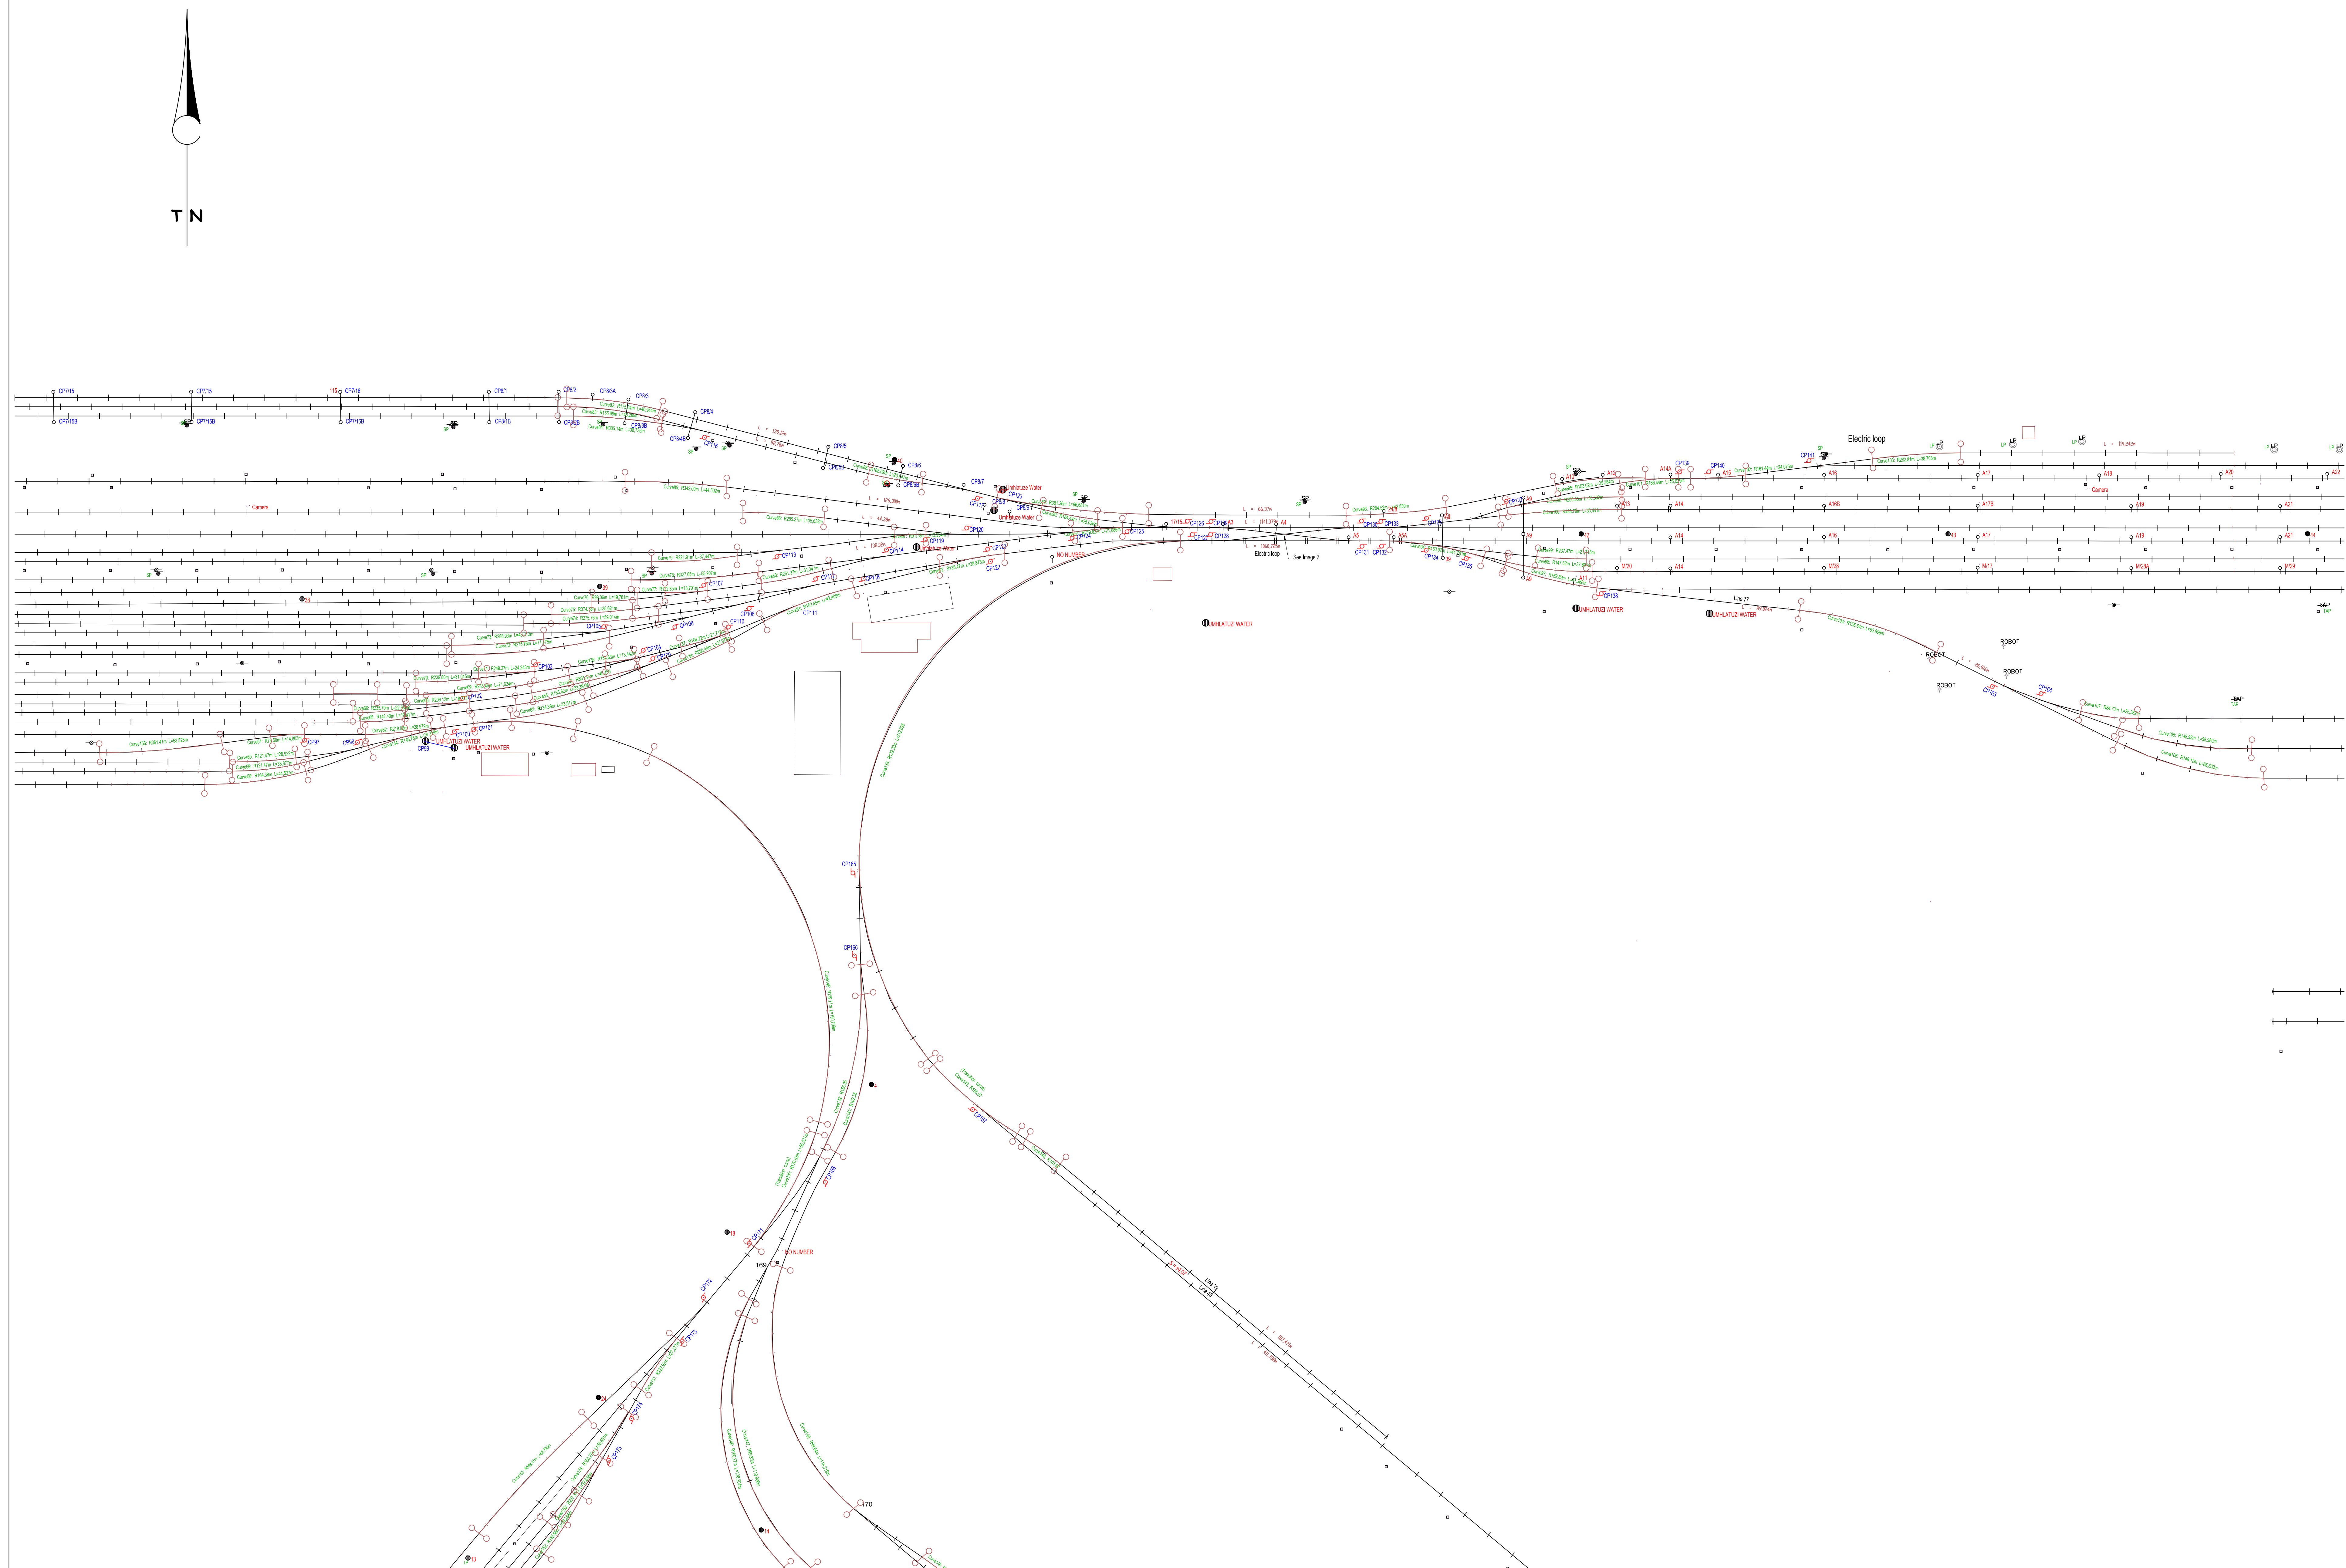

*This Survey was conducted by Survey Technician
S. W. Zangwa
Reg No. ST0699 & PST0111
Tel: (031) 361-3030
Cell: 683 259 9859
e-mail: swzangwa@transnet.net*

As Built Drawing for Rail Yard
PORT of
RICHARDS BAY

Compiled: LSD	DATE: 2013-10-11
Checked: SWZ	
For Area Manager:	
AMENDED:	
SYSTEM: WG 31°	SCALE : 1 / 1 000

Plan prepared by:
TRANSPET PROPERTY
GEO-SPATIAL: EASTERN REGION
302 ANTON LEMMIE ST P.O. Box 61777
DURHAM, NC 27705-0177
4081
FAX: (919) 286-2211
Tel: (919) 286-2211

PLAN No.	RB_TNPA_RAIL YARD
----------	-------------------