



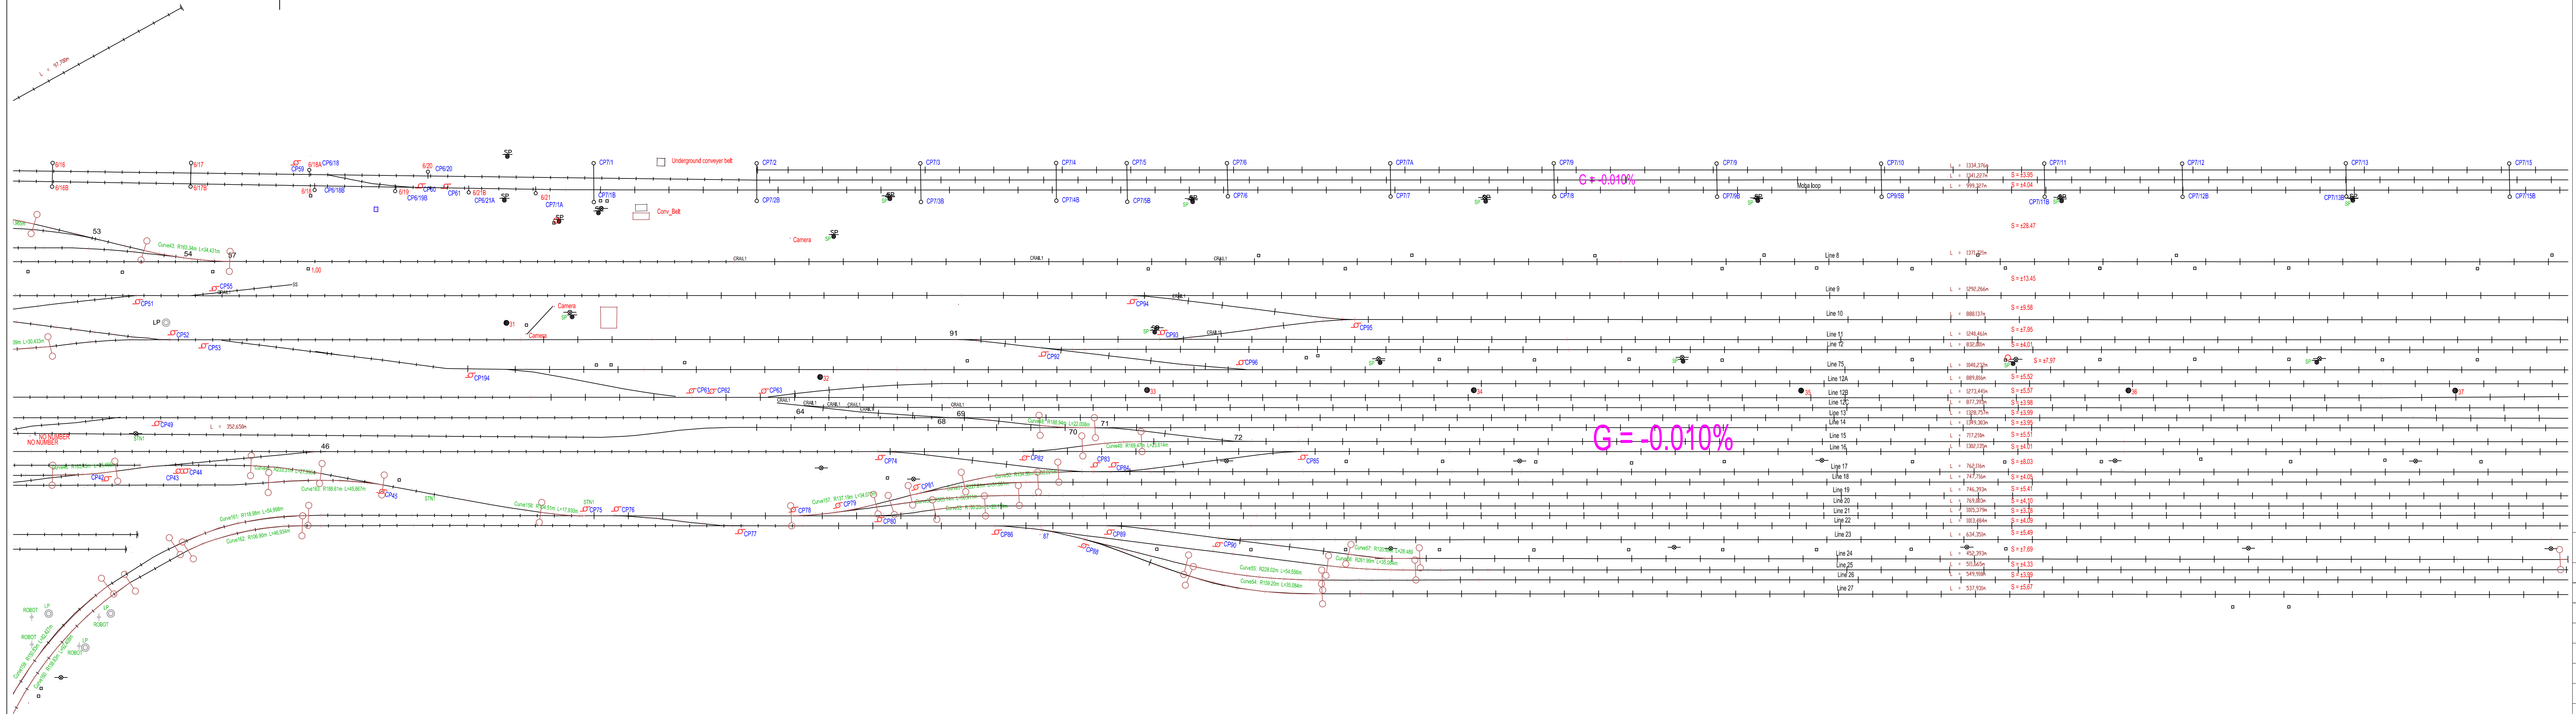

has prepared for:
RANSNET NATIONAL
SPORTS AUTHORITY
Mr. Basil Ngcobo
Tel: (015) 905-3985

	FH = FIRE HYDRANT
	CP = CHANGE POINT
	EP = ELECTRICITY POLE & No.
	MARKER PRIVATE
	ROBOT
	MAST & No.
	SP = SIGN POST
	MH = MAN HOLE
	LP = LIGHT POLE
	BEGINNING AND END OF CIRCULAR CURVE
	BEGINNING AND END OF TRANSITION
	STOP BLOCK
	WARNING BOARD
	STOP / NOTING BOARD

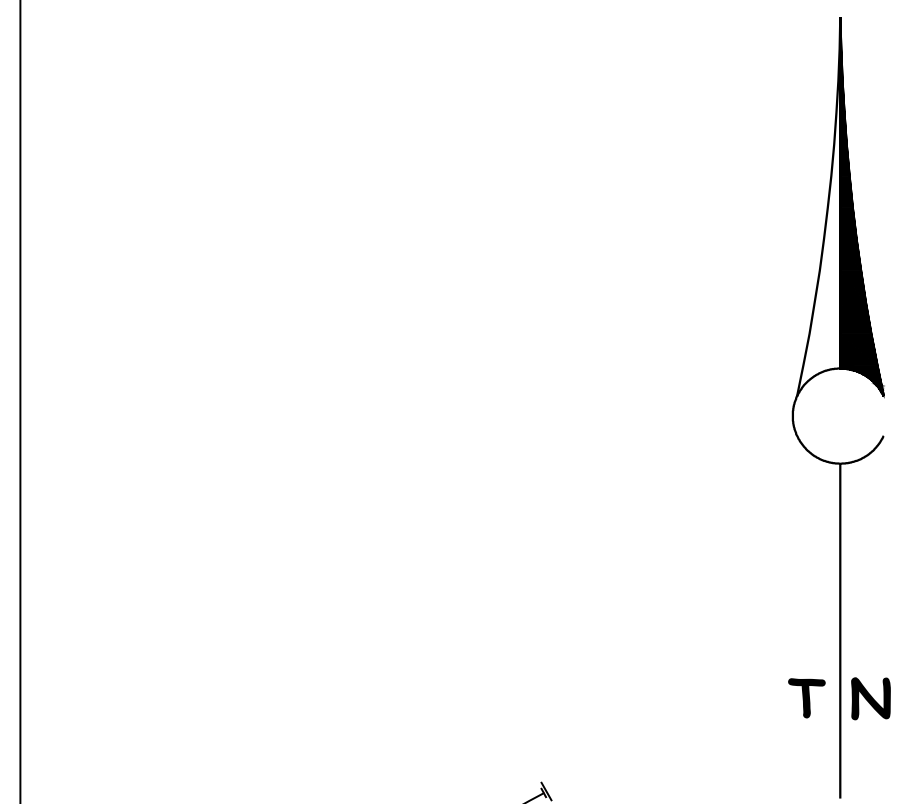

*This Survey was conducted by Survey Technician:
S. W. Zangue
Reg No. ST06690 & PST0111
Tel: (031) 361-3020
Cell: 083 259 9889
e-mail: slzw.zangue@transnet.net*

As Built Drawing for Rail Yard
**PORT of
RICHARDS BAY**

Compiled: LSD	DATE: 2013-10-11
Checked: SWZ	
For Area Manager:	
AMENDED:	
SYSTEM: WG 31°	SCALE : 1 / 1 000

Plans prepared by:
TRANSNET PROPERTY
GEO-SPATIAL: EASTERN REGION
202 ANTON LEMMING ST. P.O. Box 61577
DURHAM, NC 27706-0577
4081
FAX: (919) 261-2242
TEL: (919) 261-2541

PLAN No.	RB_TNPA_RAIL YARD
----------	-------------------