



INCORPORATING MASTER DRAWING REV 35

No.	DATE	REVISION	APPROVED	No.	DATE	REVISION	APPROVED
B01	15/07/10	MIRROR CHANGES TO WATER METERS ON THE ACCESS ROAD TO AGRZ ZONE					
B01	06/05/10	AS-BUILT DRAWING					
P01	22/03/10	FOR INFORMATION					

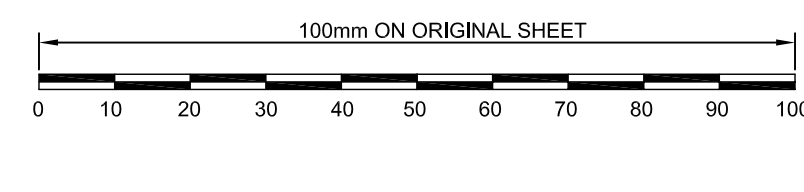

AS BUILT PLAN
(Full signature)
JV Partner Design Leader
For Client

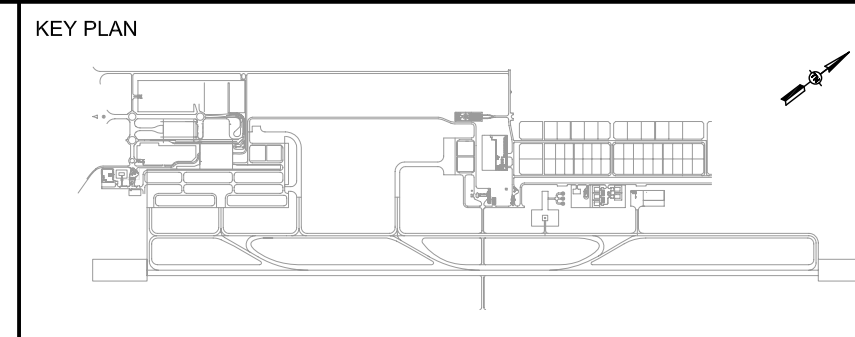

PROJECT
KING SHAKA INTERNATIONAL AIRPORT

DRAWING TITLE
BULK & INTERNAL SERVICES WATER RETICULATION
PLAN LAYOUT
SHEET 1

Designed by	Drawn by	Checked by	
L SEDUMEDI	L SEDUMEDI	G. ROSSouw	
Approved by Design Leader	Date	Scale	Original Size
Approved by Client	Date	NTS	A0
ACSA Number		Drawing Date	27/11/09
Drawing Name	Location	Designer	Discipline
SET-PDN-WS-XX-DB-2310-04			
Sheet No.	Sheet Title	Revision	Revision
B01			