



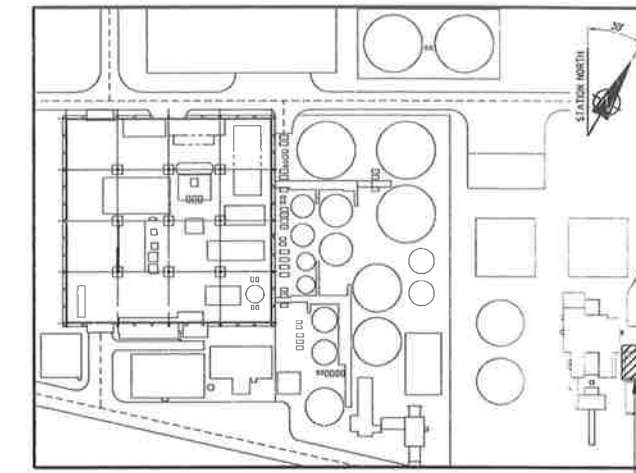

LOCALITY PLAN

THIS DRG.

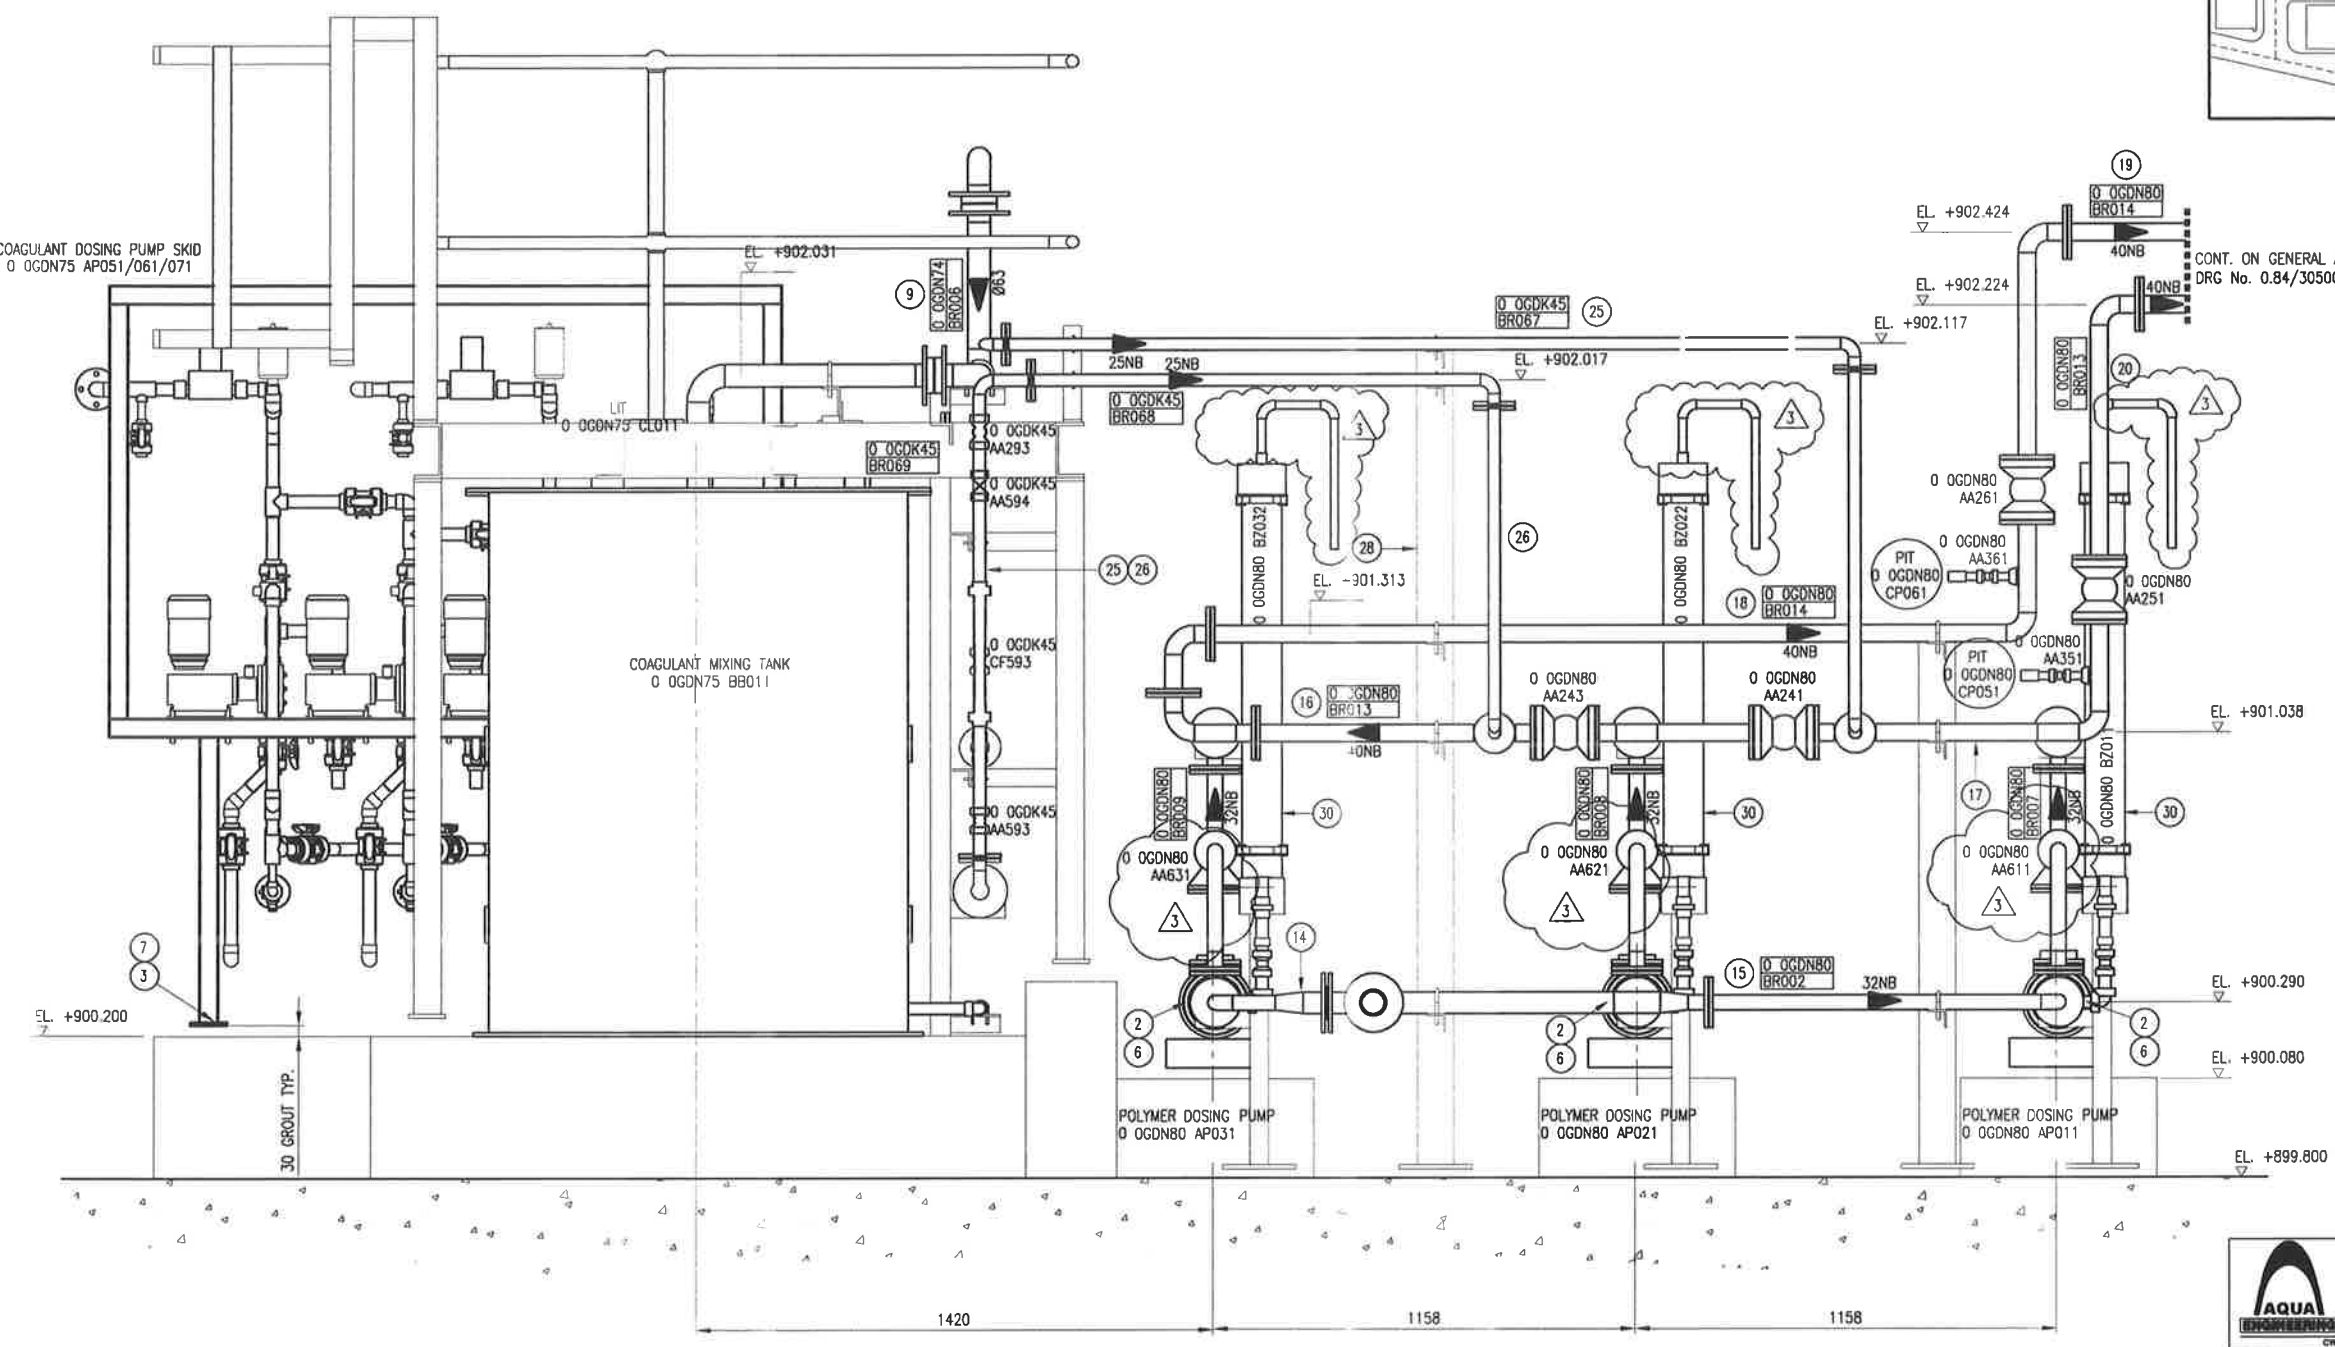

CONT. ON GENERAL ARRANGEMENT
DRG No. 0.84/30500 (C048-10085)

SECTION C
0.84/25224

AS BUILT
Signed *N. MAZIBUKO* Date 11/12/19

READ DRG IN CONJUNCTION WITH THE FOLLOWING DRG'S
0.84/25224, 25225 (C048-10066, 10067)

Linkview
260 Kent Avenue
Randburg
P.O.Box 3597
Randburg
2125

Tel.: +27 11 886-0266
Fax: +27 11 886-0294
E-Mail: info@aquas.co.za

0.84/4747 & 11978 (C048-51019/20) P&ID

NO.	REV.	DATE	DESCRIPTION	BY	CHKD BY	APP BY
3	15.10.19	AS BUILT		NS	NM	SS
2	05.01.16	UPDATED AS PER ESKOM COMMENTS		JR	JMK	JV
1	08.08.12	APPROVED FOR CONSTRUCTION		ANK	L.C.	H.H.
0	09.07.12	ISSUED FOR REVIEW		ANK	L.C.	H.H.

DRG REC'D BY: 21.06.12 S.S.

DESIGN APPROVED: 22.06.12 B.D.

CHKD APP: 22.06.12 J.V.

APP AUTH: 22.06.12 H.H.

CHKD BY: 22.06.12 J.C.

SCALE: 1:10

APPROVED FOR ESKOM BY: _____ DATE: _____

REFERENCE DRAWINGS

MEDUPI POWER STATION
WTP ~ CLARIFIER POLYMER DOSING
POLYMER DOSING - SECTIONS
PIPING GENERAL ARRANGEMENT

C048-10068

0.84/25226

SCALE: 1:10

1 2 3 4 5 6 7 8 9 10 11 12 13 14 15 16