


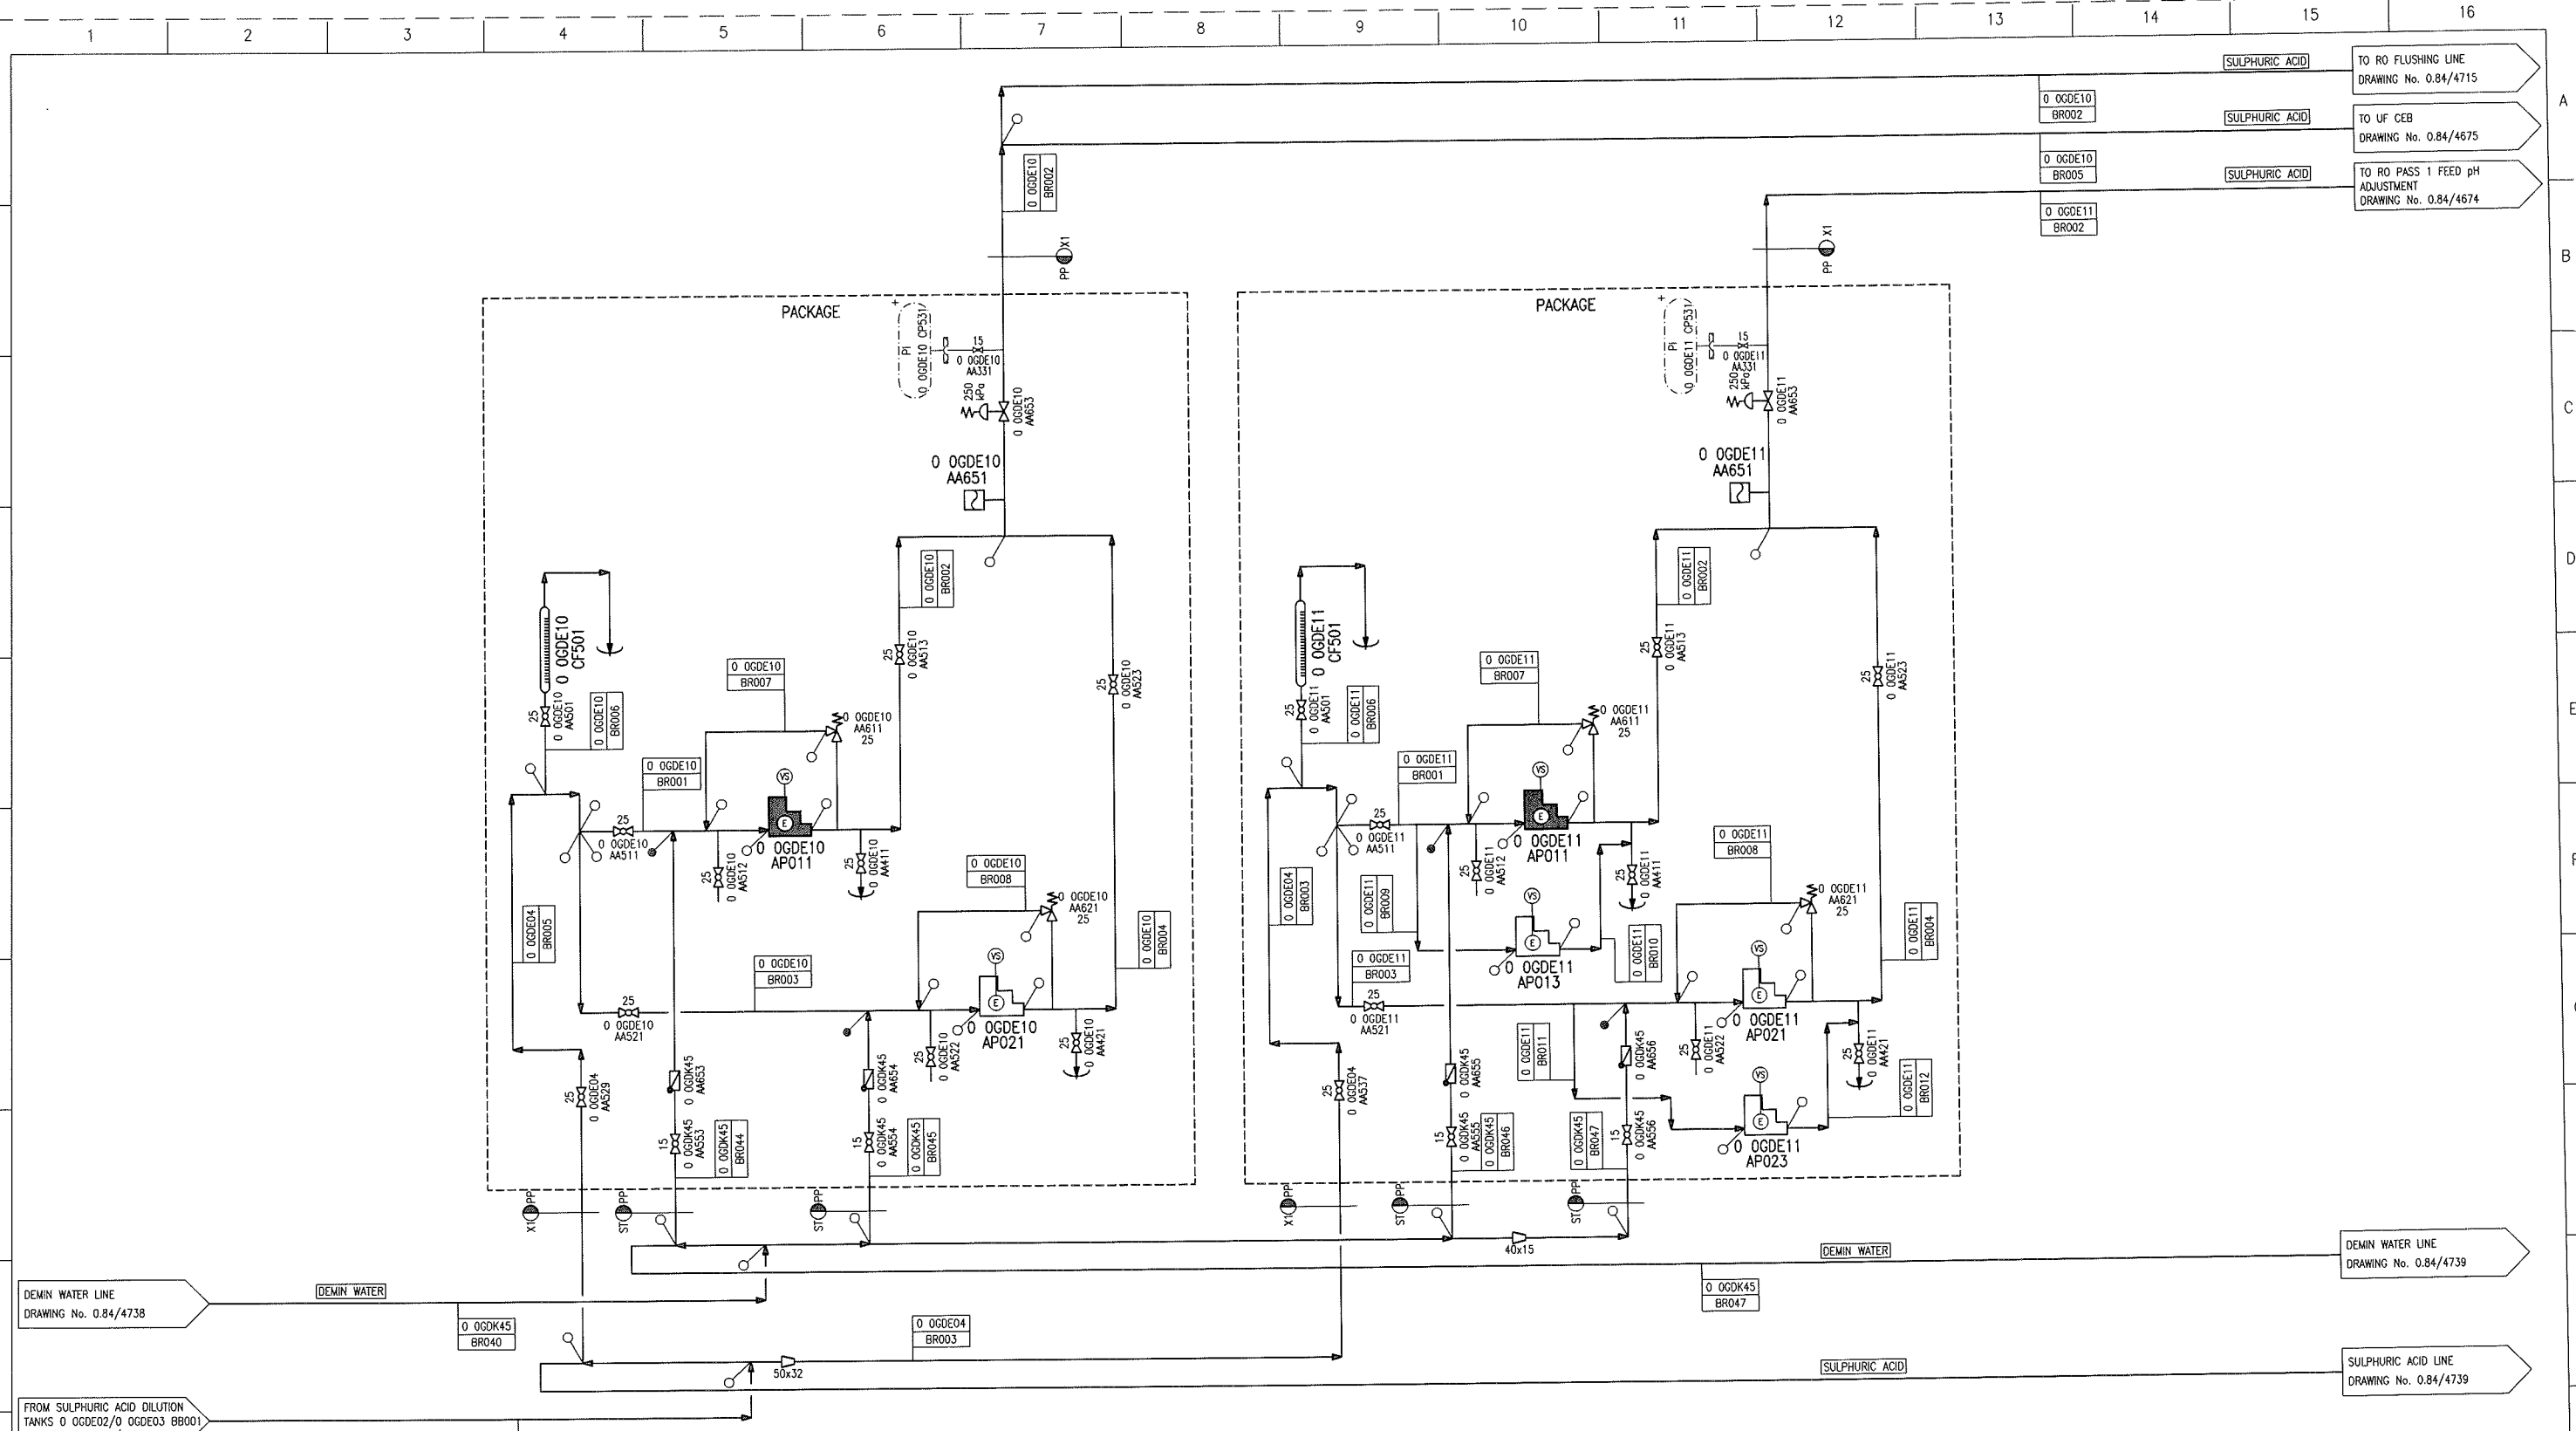

0 OGDE10 CF501
CALIBRATION COLUMN : 1 OFF
CAPACITY : 17 l
DIMENSIONS : Ø100 x 1000
M.O.C. : GLASS

0 OGDE11 CF501
CALIBRATION COLUMN : 1 OFF
CAPACITY : 2 l
DIMENSIONS : Ø80 x 400
M.O.C. : GLASS

0 OGDE10 AP011/AP021
SULPHURIC ACID DOSING PUMP : 2 OFF
CAPACITY : 0-2000 l/h
PRESSURE : 400 kPa
MOTOR : 1,5 kW
WET PARTS M.O.C. : PTFE DIAPHRAGM

0 OGDE11 AP011/AP021
SULPHURIC ACID DOSING PUMP : 2 OFF
CAPACITY : 0-50 l/h
PRESSURE : 200 kPa
MOTOR : 0,18 kW
WET PARTS M.O.C. : PTFE DIAPHRAGM

0 OGDE11 AP013/AP023
SULPHURIC ACID DOSING PUMP : 2 OFF
CAPACITY : 0-7,5 l/h
PRESSURE : 200 kPa
MOTOR : 0,024 kW
WET PARTS M.O.C. : PTFE DIAPHRAGM

0 OGDE10/0 OGDE11 AA651
PULSATION DAMPNER : 2 OFF

AS BUILT
Signed: *[Signature]* Date: 15/2/08



Linkview
260 Kent Avenue
Randburg
P.O.Box 3597
Randburg
2125

Tel.: +27 11 886-0266
Fax.: +27 11 886-0294
E-Mail: info@aquas.co.za

NO.	REV.	DATE	DESCRIPTION	BY	CHKD BY	APP BY	DATE
11	20.02.12		PIPE SPEC BREAK ADDED	J.P.	J.P.	J.V.	
10	28.11.11		UPDATED AS PER LAYOUT	S.M.	J.P.	J.V.	
15	13.02.18		AS BUILT	N.A.S.	N.W.	J.P.	
14	05.10.15		DOSING PUMPS ADDED	J.M.	S.E.	J.M.	
13	22.08.12		KKS NUMBERS CHANGED	T.P.S.	J.C.	P.M.	
12	08.05.12		SULPHURIC ACID DOSING PUMP KW CHANGED	R.D.T.	P.M.	F.F.	

DESIGN APPROVED: 25.05.09 E.M.

KKS APP: 25.05.09 F.F.

DO AUTH: 25.05.09 J.H.

CHKD BY: 25.05.09 Y.K.

DRAWN BY: 25.05.09 S.M.

REFERENCE DRAWINGS

WTP ~ SYSTEM 5
SULPHURIC ACID DOSING SYSTEM 2
P. & I. DIAGRAM

C048-51012

0.84 / 4740

SCALE: NTS

ESKOM

SIZE: A1/L

DEMIN WATER LINE
DRAWING No. 0.84/4738

DEMIN WATER LINE
DRAWING No. 0.84/4739

SULPHURIC ACID LINE
DRAWING No. 0.84/4739