


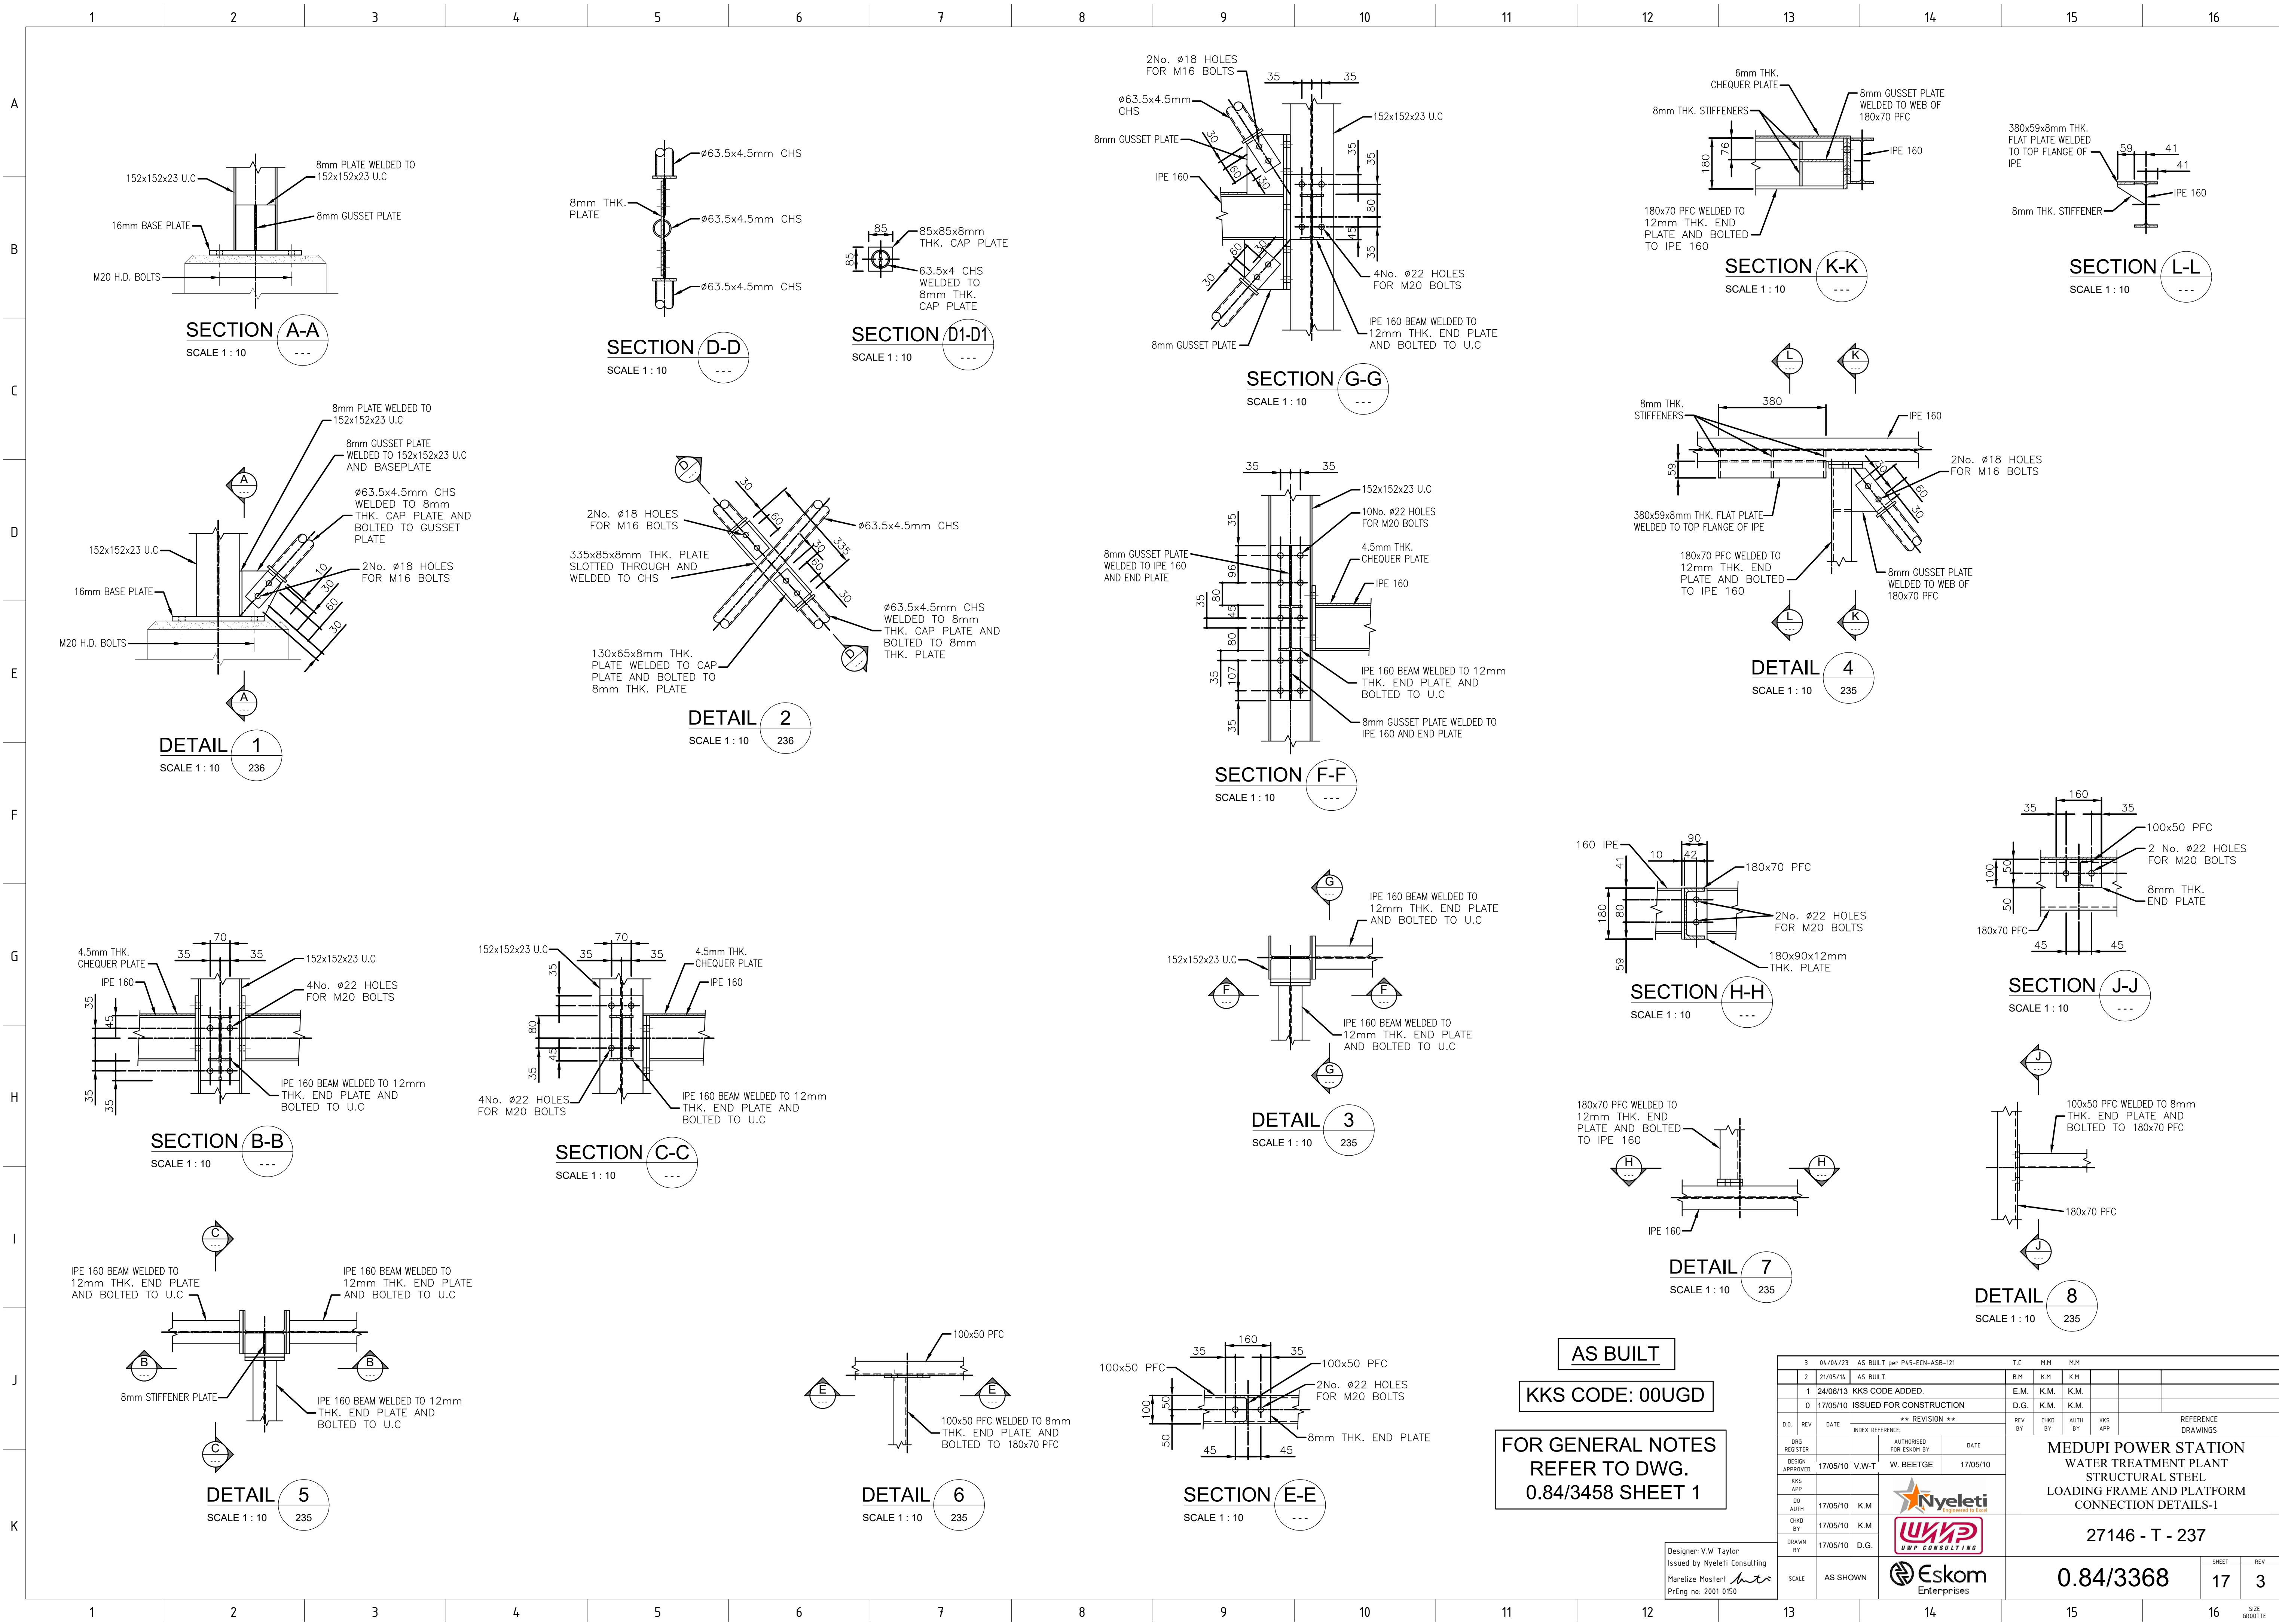

AS BUILT

KKS CODE: 00UGD

**FOR GENERAL NOTES
REFER TO DWG.
0.84/3458 SHEET 1**

3	04/04/23	AS BUILT per P45-ECN-ASB-121			T.C		M.M		K.M							
2	21/05/14	AS BUILT			B.M		K.M		K.M							
1	24/08/13	KKS CODE ADDED			E.M.		K.M.		K.M.							
0	17/05/10	ISSUED FOR CONSTRUCTION			D.G.		K.M.		K.M.							
D.O.		REV	DATE	** REVISION **			REV	BY	CHKD	BY	AUTH	BY	KKS	APP	REFERENCE DRAWINGS	
		INDEX REFERENCE:														
DRG REGISTER				AUTHORISED FOR ESKOH BY		DATE										
DESIGN APPROVED		17/05/10	V.W-T	W. BEETGE		17/05/10										
KKS APP																
DR AUTH		17/05/10	K.M													
CHKD BY		17/05/10	K.M													
DRAWN BY		17/05/10	D.G.													
SCALE		AS SHOWN														