


KEY	
	GRASS
	STONE PAVER
	WATER
	MOSAIC TILE
	PLANTED / FLOWER BED
	BRICK PAVER
	CONCRETE BENCH
	STONE CLADDED COLUMN
	STEEL BENCH
	CONCRETE COLUMN
	QUARRY TILES
	FLOWER POT URN 01
	CONTOURS
	FLOWER POT URN 02
	CONCRETE PAVING



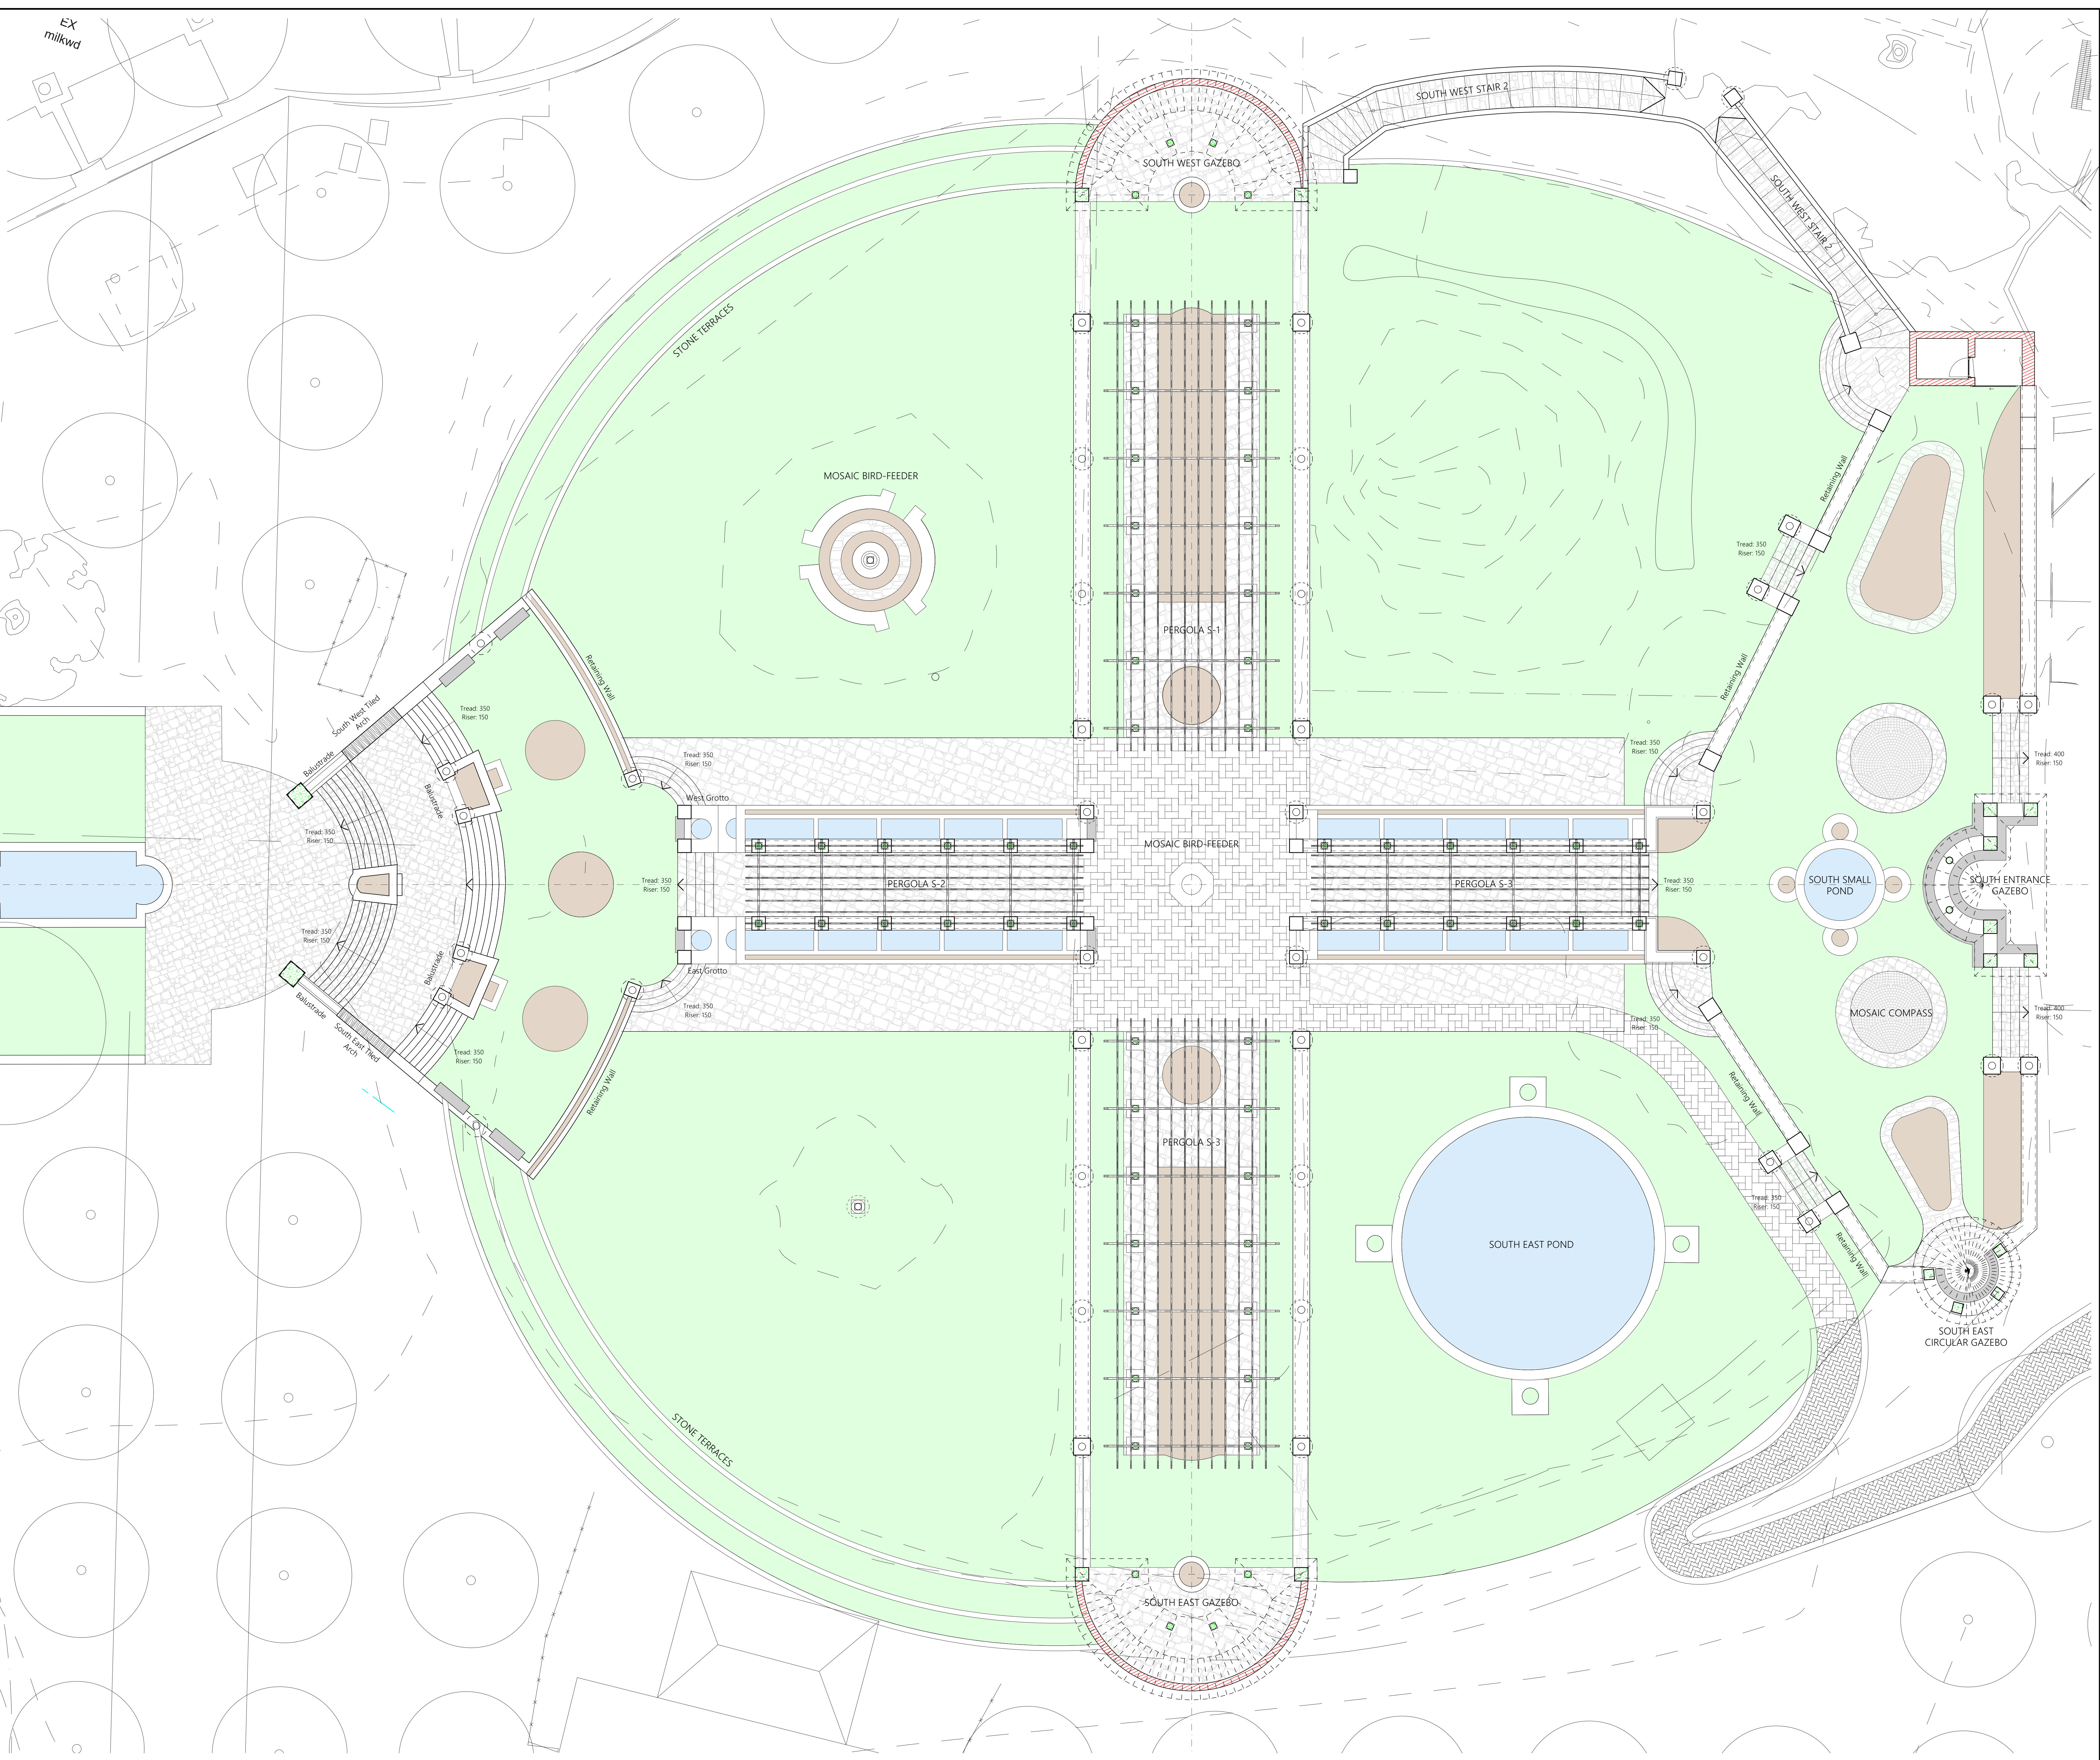

 CASE ID: 20788
 27 November 2023
APPROVED

- GENERAL NOTES**
1. ALL WORK TO COMPLY WITH LOCAL BY-LAWS AND ALL RELEVANT NATIONAL STANDARDS - (N.B.R SABS 0400-1990, SANS).
 2. ALL DIMENSIONS AND LEVELS TO BE CHECKED ON SITE PRIOR TO COMMENCEMENT OF ANY WORK.
 3. FIGURED DIMENSIONS ARE TO BE USED IN PREFERENCE TO SCALED DIMENSIONS. IF FURTHER DIMENSIONS ARE REQUIRED, THESE ARE TO BE REQUESTED.
 4. ANY DISCREPANCIES OR QUERY TO BE REPORTED TO THE ARCHITECT IMMEDIATELY PRIOR TO COMMENCEMENT OF ANY WORK.
 5. LARGER SCALE DETAILS SUPERCEDE THOSE OF SMALLER SCALE.
 6. ALL WORK OF A STRUCTURAL OR CIVIL NATURE TO BE STRICTLY TO ENGINEER'S DETAIL AND SPECIFICATION.
 8. NO PORTION OF PROPOSED WORK TO ENCRUCH ON ADJACENT PROPERTIES.
 9. THIS DRAWING IS COPYRIGHT AND REMAINS WITH THE ARCHITECT.

SIGNED: _____ (OWNER)
 SIGNED: _____ (ARCHITECT)/SACAP 5008

OCCUPANCY CLASSIFICATION:



PROJECT
AS BUILT DRAWINGS OF EXISTING SUNKEN GARDENS

DRAWING TITLE
 SOUTHERN SUNKEN GARDEN PLAN

SCALE: AS SHOWN DRAWN: S.K.
 DATE: Thursday, February 16, 2023 CHECKED: M.G.

DRAWING NO. SD 22-74-03 REVISION