

NOTES / LEGEND

LEGEND:

- SEWER
- WATER
- STORMWATER
- ELECTRICAL

DO NOT SCALE DRAWING  
IF IN DOUBT, REFER TO DRAWING OFFICE

CLIENT PLAN NUMBER

---

REFERENCE DRAWINGS

NUMBER	DRAWING DESCRIPTION
---	---

APPROVED BY COUNCIL / CLIENT

CITY ENGINEER / CLIENT REG. NO. DATE

AMENDMENTS CODE

A / : REPORT/DESIGN/TENDER  
0/99 : CONSTRUCTION  
Z / : AS BUILT

A : BY CLIENT  
B : BY ARCHITECT  
C : BY MECHANICAL OR ELECTRICAL  
D :  
E : BY OTHER ( )

DATE	INITIAL	CODE	REVISION DESCRIPTION
04/09/2018	F.S.	A	ISSUED FOR INFORMATION

OFFICES





CLIENT

PROJECT

AIRPORT

DRAWING TITLE

GENERAL EXISTING LAYOUT  
BLOCK B

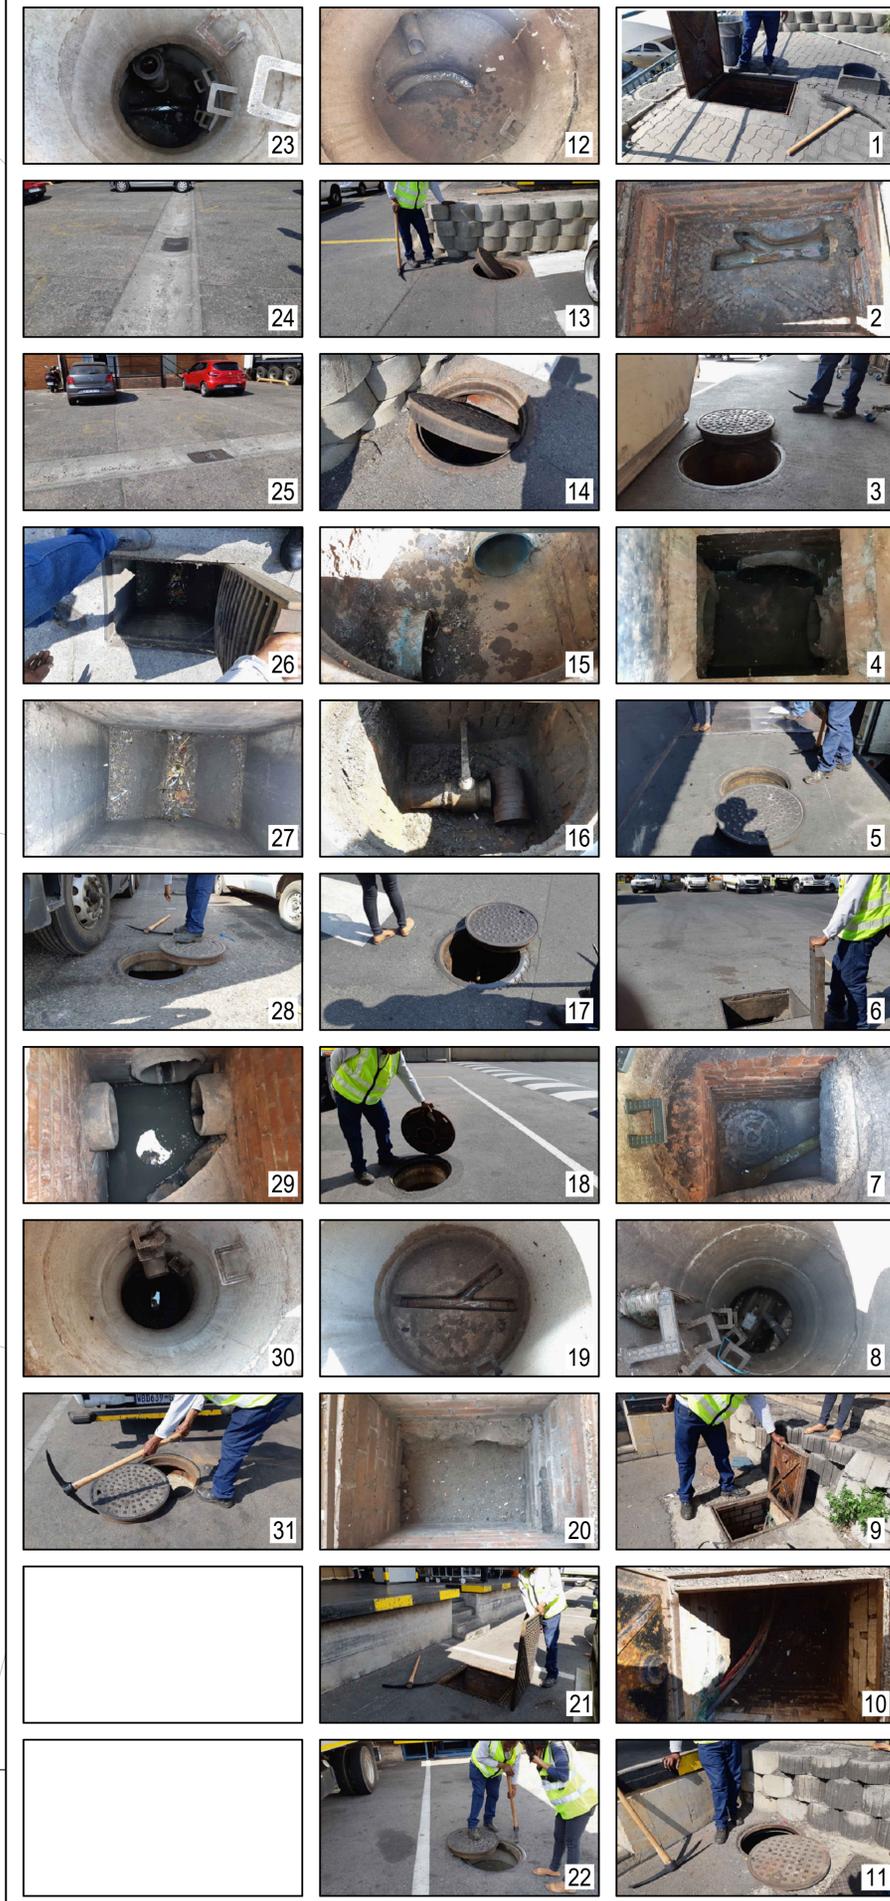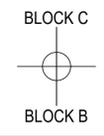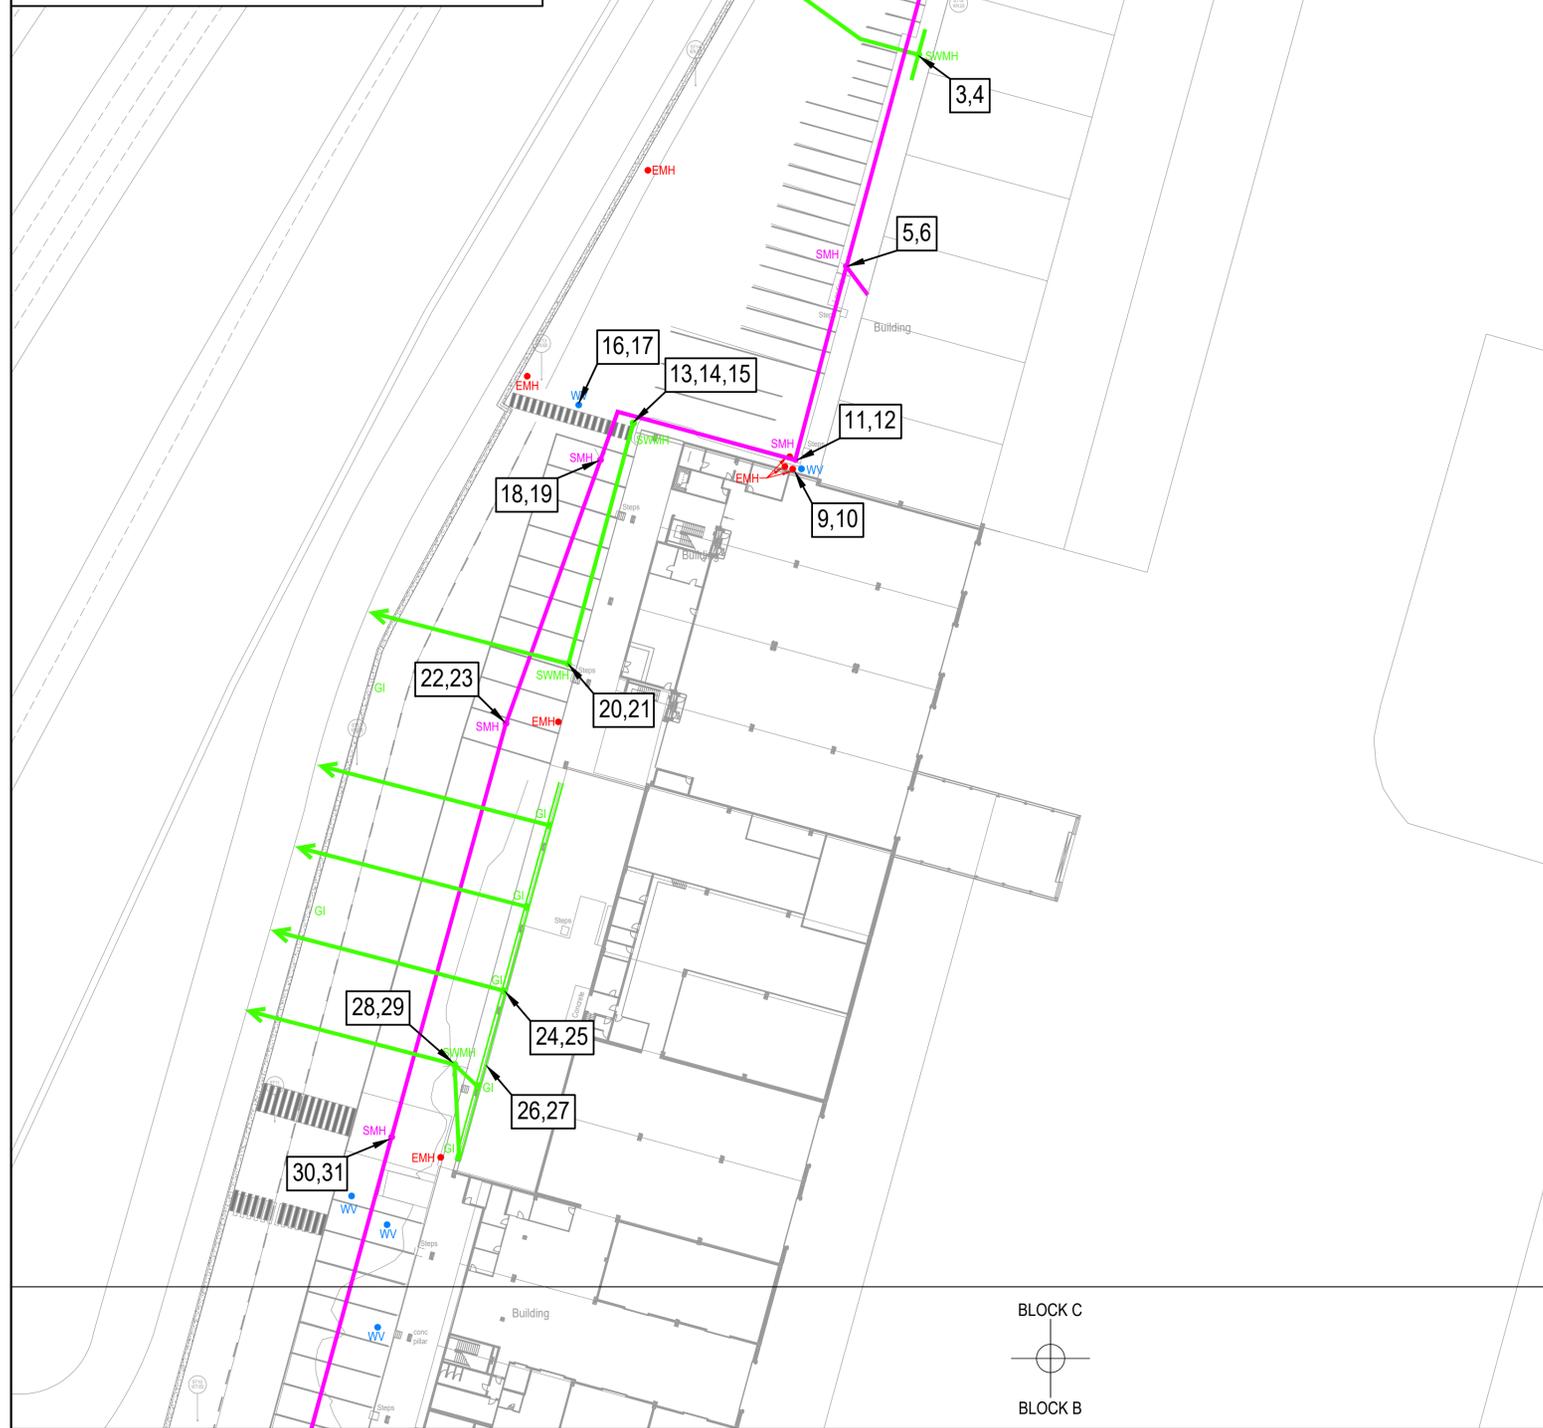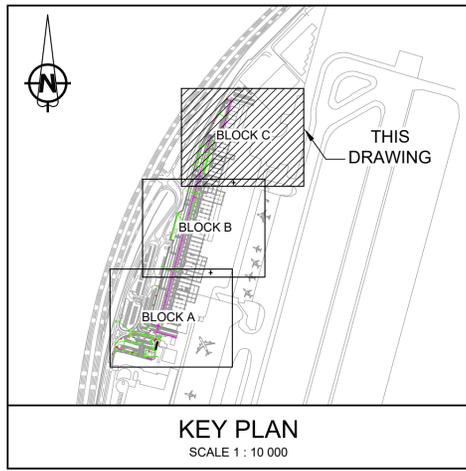

NOTES / LEGEND

LEGEND:

- SEWER
- WATER
- STORMWATER
- ELECTRICAL

DO NOT SCALE DRAWING  
IF IN DOUBT, REFER TO DRAWING OFFICE

CLIENT PLAN NUMBER  
---

REFERENCE DRAWINGS

NUMBER	DRAWING DESCRIPTION
---	---

APPROVED BY COUNCIL / CLIENT

CITY ENGINEER / CLIENT	REG. NO.	DATE

AMENDMENTS CODE

A.Y. / REPORT/DESIGN/TENDER	A: BY CLIENT
0/99 / CONSTRUCTION	B: BY ARCHITECT
Z / AS BUILT	C: BY MECHANICAL OR ELECTRICAL
	D: BY OTHER ( )
	E: BY OTHER ( )

DATE	INITIAL	CODE	REVISION DESCRIPTION
04/09/2018	F.S.	A	ISSUED FOR INFORMATION

OFFICES

CLIENT

PROJECT

AIRPORT

DRAWING TITLE

GENERAL EXISTING LAYOUT  
BLOCK C



BLOCK B

BLOCK A

NOTES / LEGEND

- LEGEND:
- SEWER
  - WATER
  - STORMWATER
  - ELECTRICAL

DO NOT SCALE DRAWING  
IF IN DOUBT, REFER TO DRAWING OFFICE

CLIENT PLAN NUMBER

---

REFERENCE DRAWINGS

NUMBER	DRAWING DESCRIPTION
---	---

APPROVED BY COUNCIL / CLIENT

CITY ENGINEER / CLIENT

REG. NO.

DATE

AMENDMENTS CODE

- A: BY CLIENT
- B: BY ARCHITECT
- C: BY MECHANICAL OR ELECTRICAL
- D: BY OTHER ( )
- E: BY OTHER ( )

DATE


INITIAL

CODE


REVISION DESCRIPTION

04/09/2018 F.S. A ISSUED FOR INFORMATION

OFFICES

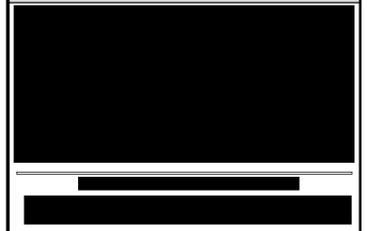

CLIENT

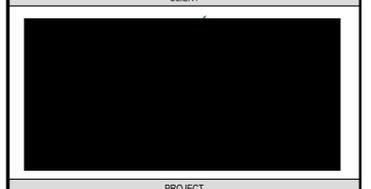

PROJECT

AIRPORT

DRAWING TITLE

GENERAL EXISTING LAYOUT BLOCK A

