




AS BUILT
Signed Date 29/04/2020

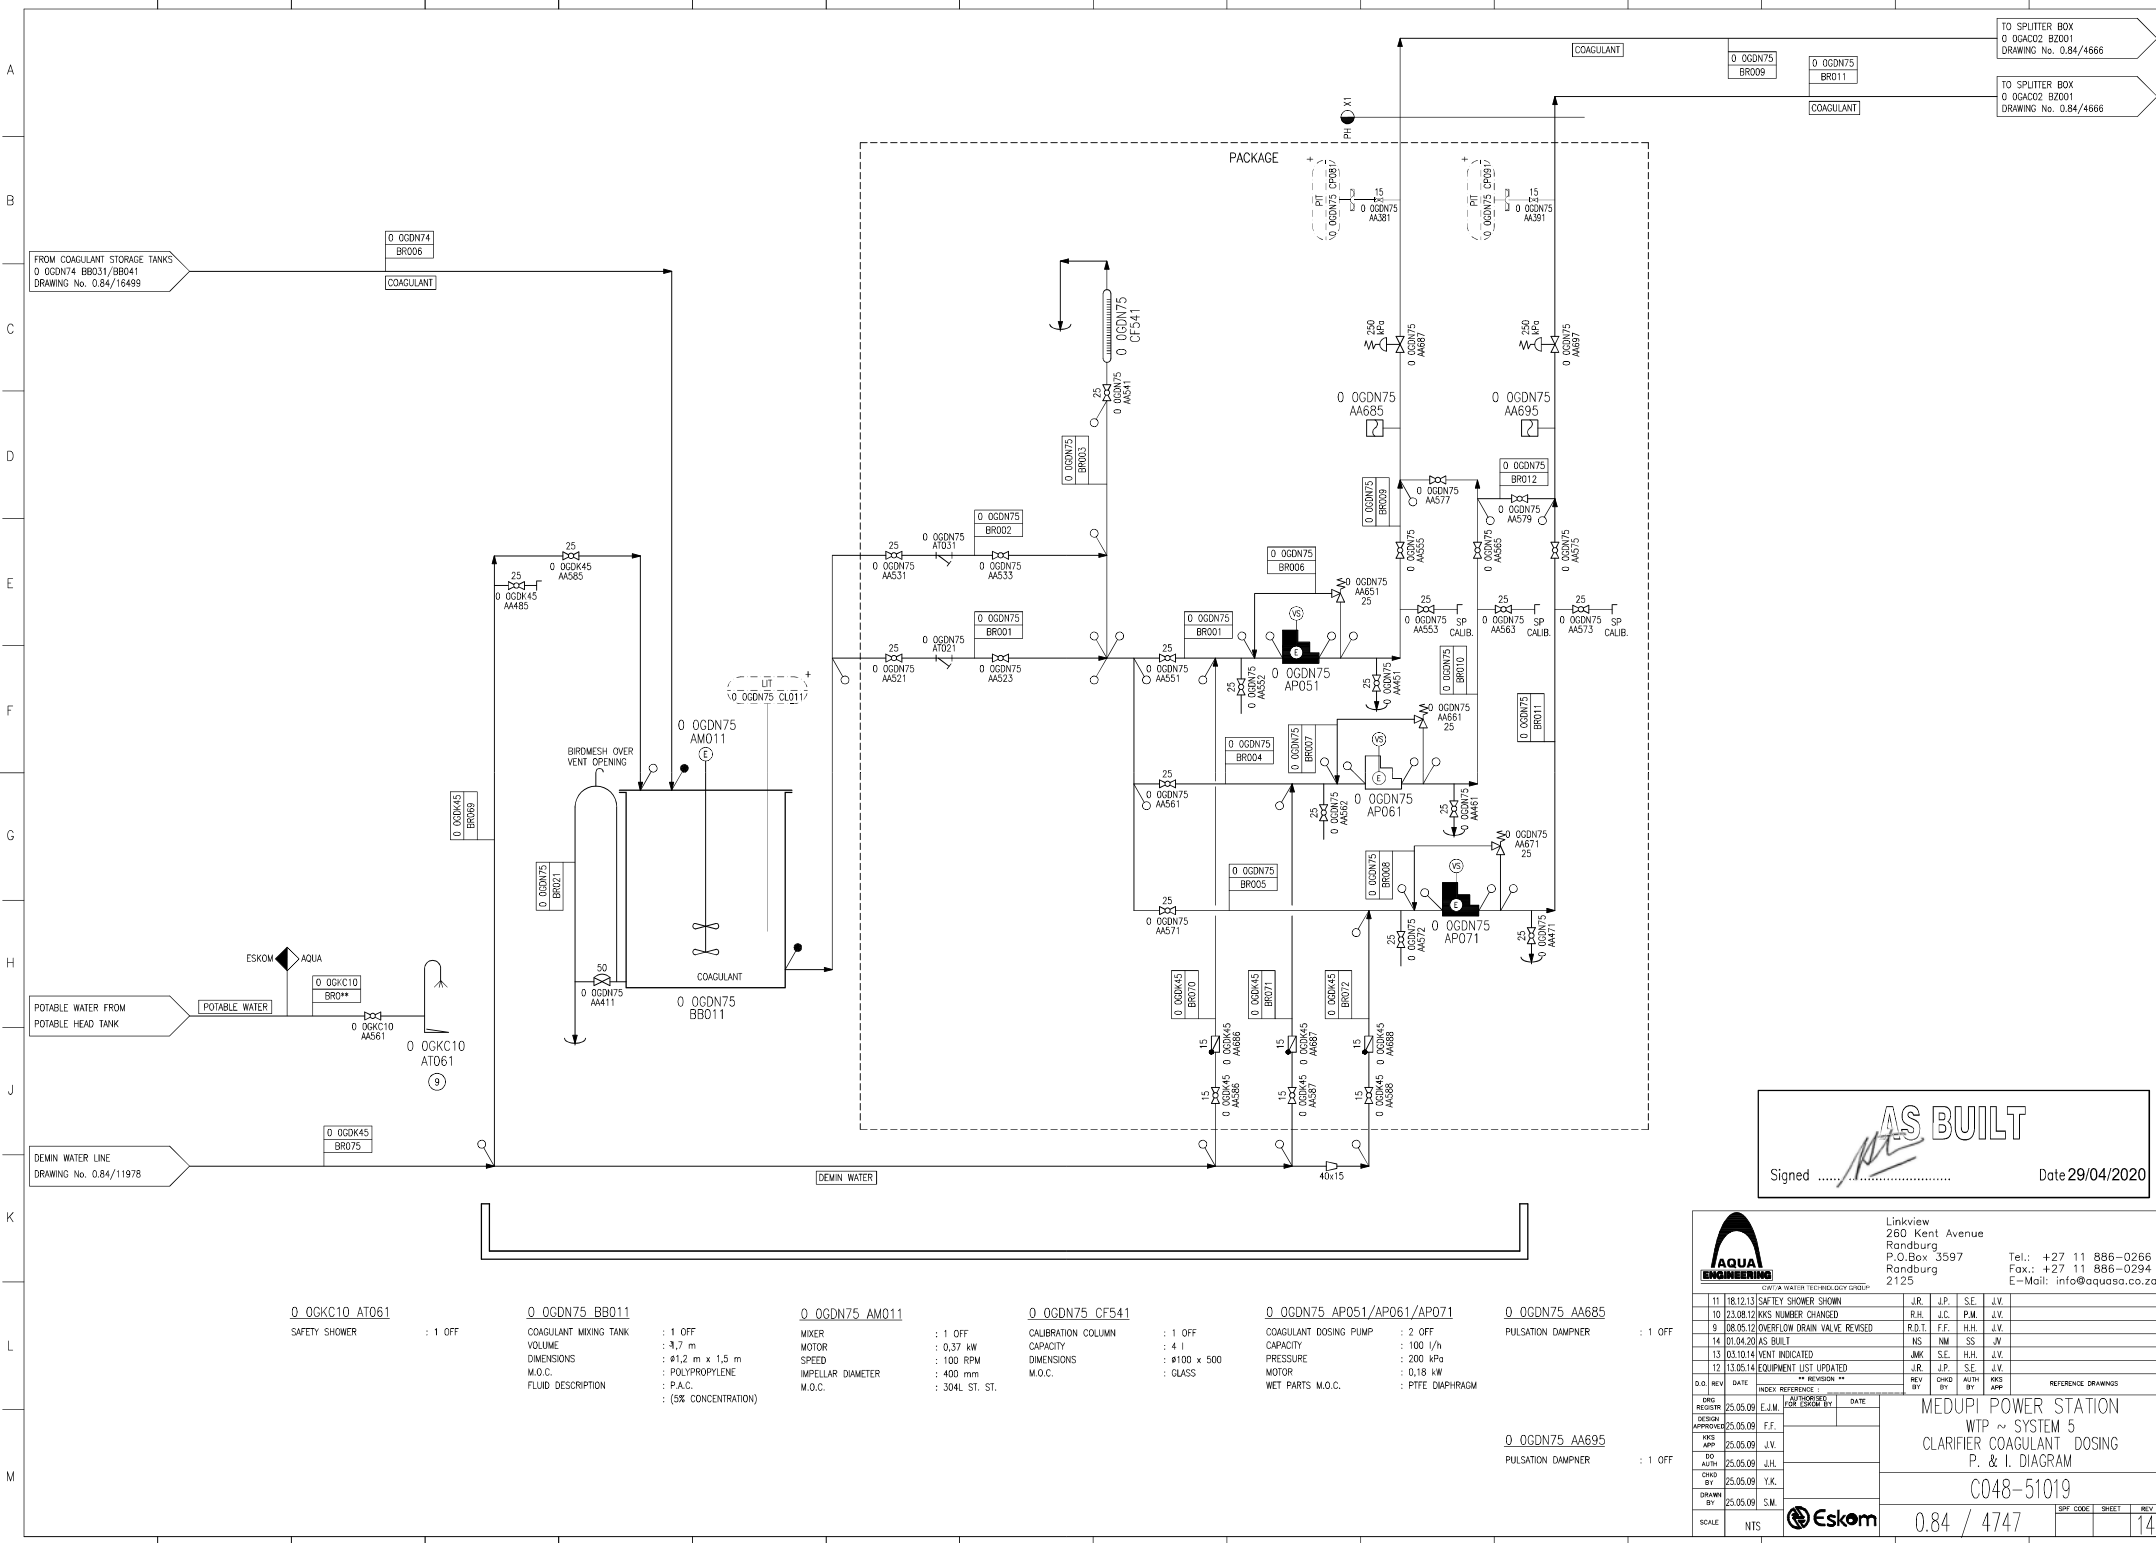

Linkview
260 Kent Avenue
Randburg
P.O.Box 3597
Randburg
2125
Tel: +27 11 886-0266
Fax: +27 11 886-0294
E-Mail: info@aqua.co.za

CHG / A WATER TECHNOLOGY GROUP				DATE			
11	18.12.13	SAFETY SHOWER SHOWN	J.R.	J.P.	S.E.	J.V.	
10	23.08.12	RKS NUMBER CHANGED	R.H.	J.C.	P.M.	J.V.	
9	08.05.12	OVERFLOW DRAIN VALVE REVISED	R.B.T.	F.F.	H.H.	J.V.	
14	01.04.20	AS BUILT	NS	NM	SS	J.V.	
13	03.10.14	VENT INDICATED	JMK	S.E.	H.H.	J.V.	
12	13.06.14	EQUIPMENT LIST UPDATED	J.R.	J.P.	S.E.	J.V.	
* REVISION **				REV	CHD	APP	REFERENCE DRAWINGS
D.O.	REV	DATE	INDEX	REFERENCE	DATE	DATE	
DESIGN	25.05.09	E.J.M.	APPROVED	25.05.09	F.F.		
DESIGN	25.05.09	J.V.	APP	25.05.09	J.V.		
DES	25.05.09	J.V.	APP	25.05.09	J.V.		
CHD	25.05.09	Y.K.	APP	25.05.09	Y.K.		
DRAWN	25.05.09	S.M.	APP	25.05.09	S.M.		
SCALE	NTS						

MEDIPI POWER STATION
WTP ~ SYSTEM 5
CLARIFIER COAGULANT DOSING
P. & I. DIAGRAM

C048-51019

0.84 / 4747



SHEET 14