

KEY PLAN

AREA SCHEDULE

EXISTING GROUND FLOOR	577m²
EXISTING FIRST FLOOR	538m²
TOTAL AREA	1115m²

Lead Consultants



Pro-Serve Consulting (Pty) Ltd
"Providing Professional Construction Consulting Services"

Architects



P.O. Box 26817
Monument Park, 0105
Tel: 011 026 4039
email: mail@arch-live.co.za

Project :

ESKOM ACADEMY OF LEARNING

Project Description :

AS-BUILT-KOEBERG 60-107
KEY PLAN (14)

Drawing :

SECTIONS
ELEVATIONS

Project No: **PSC/08.12/EAL**

Date: 07/12/2012

Drawn By: S.L.M

Scale: AS SHOWN

Checked by: LL/ MI


Revision: A

Drawing No: EAL-AB-033


No Revisions

A ISSUED FOR INFORMATION


FOR INFORMATION ONLY

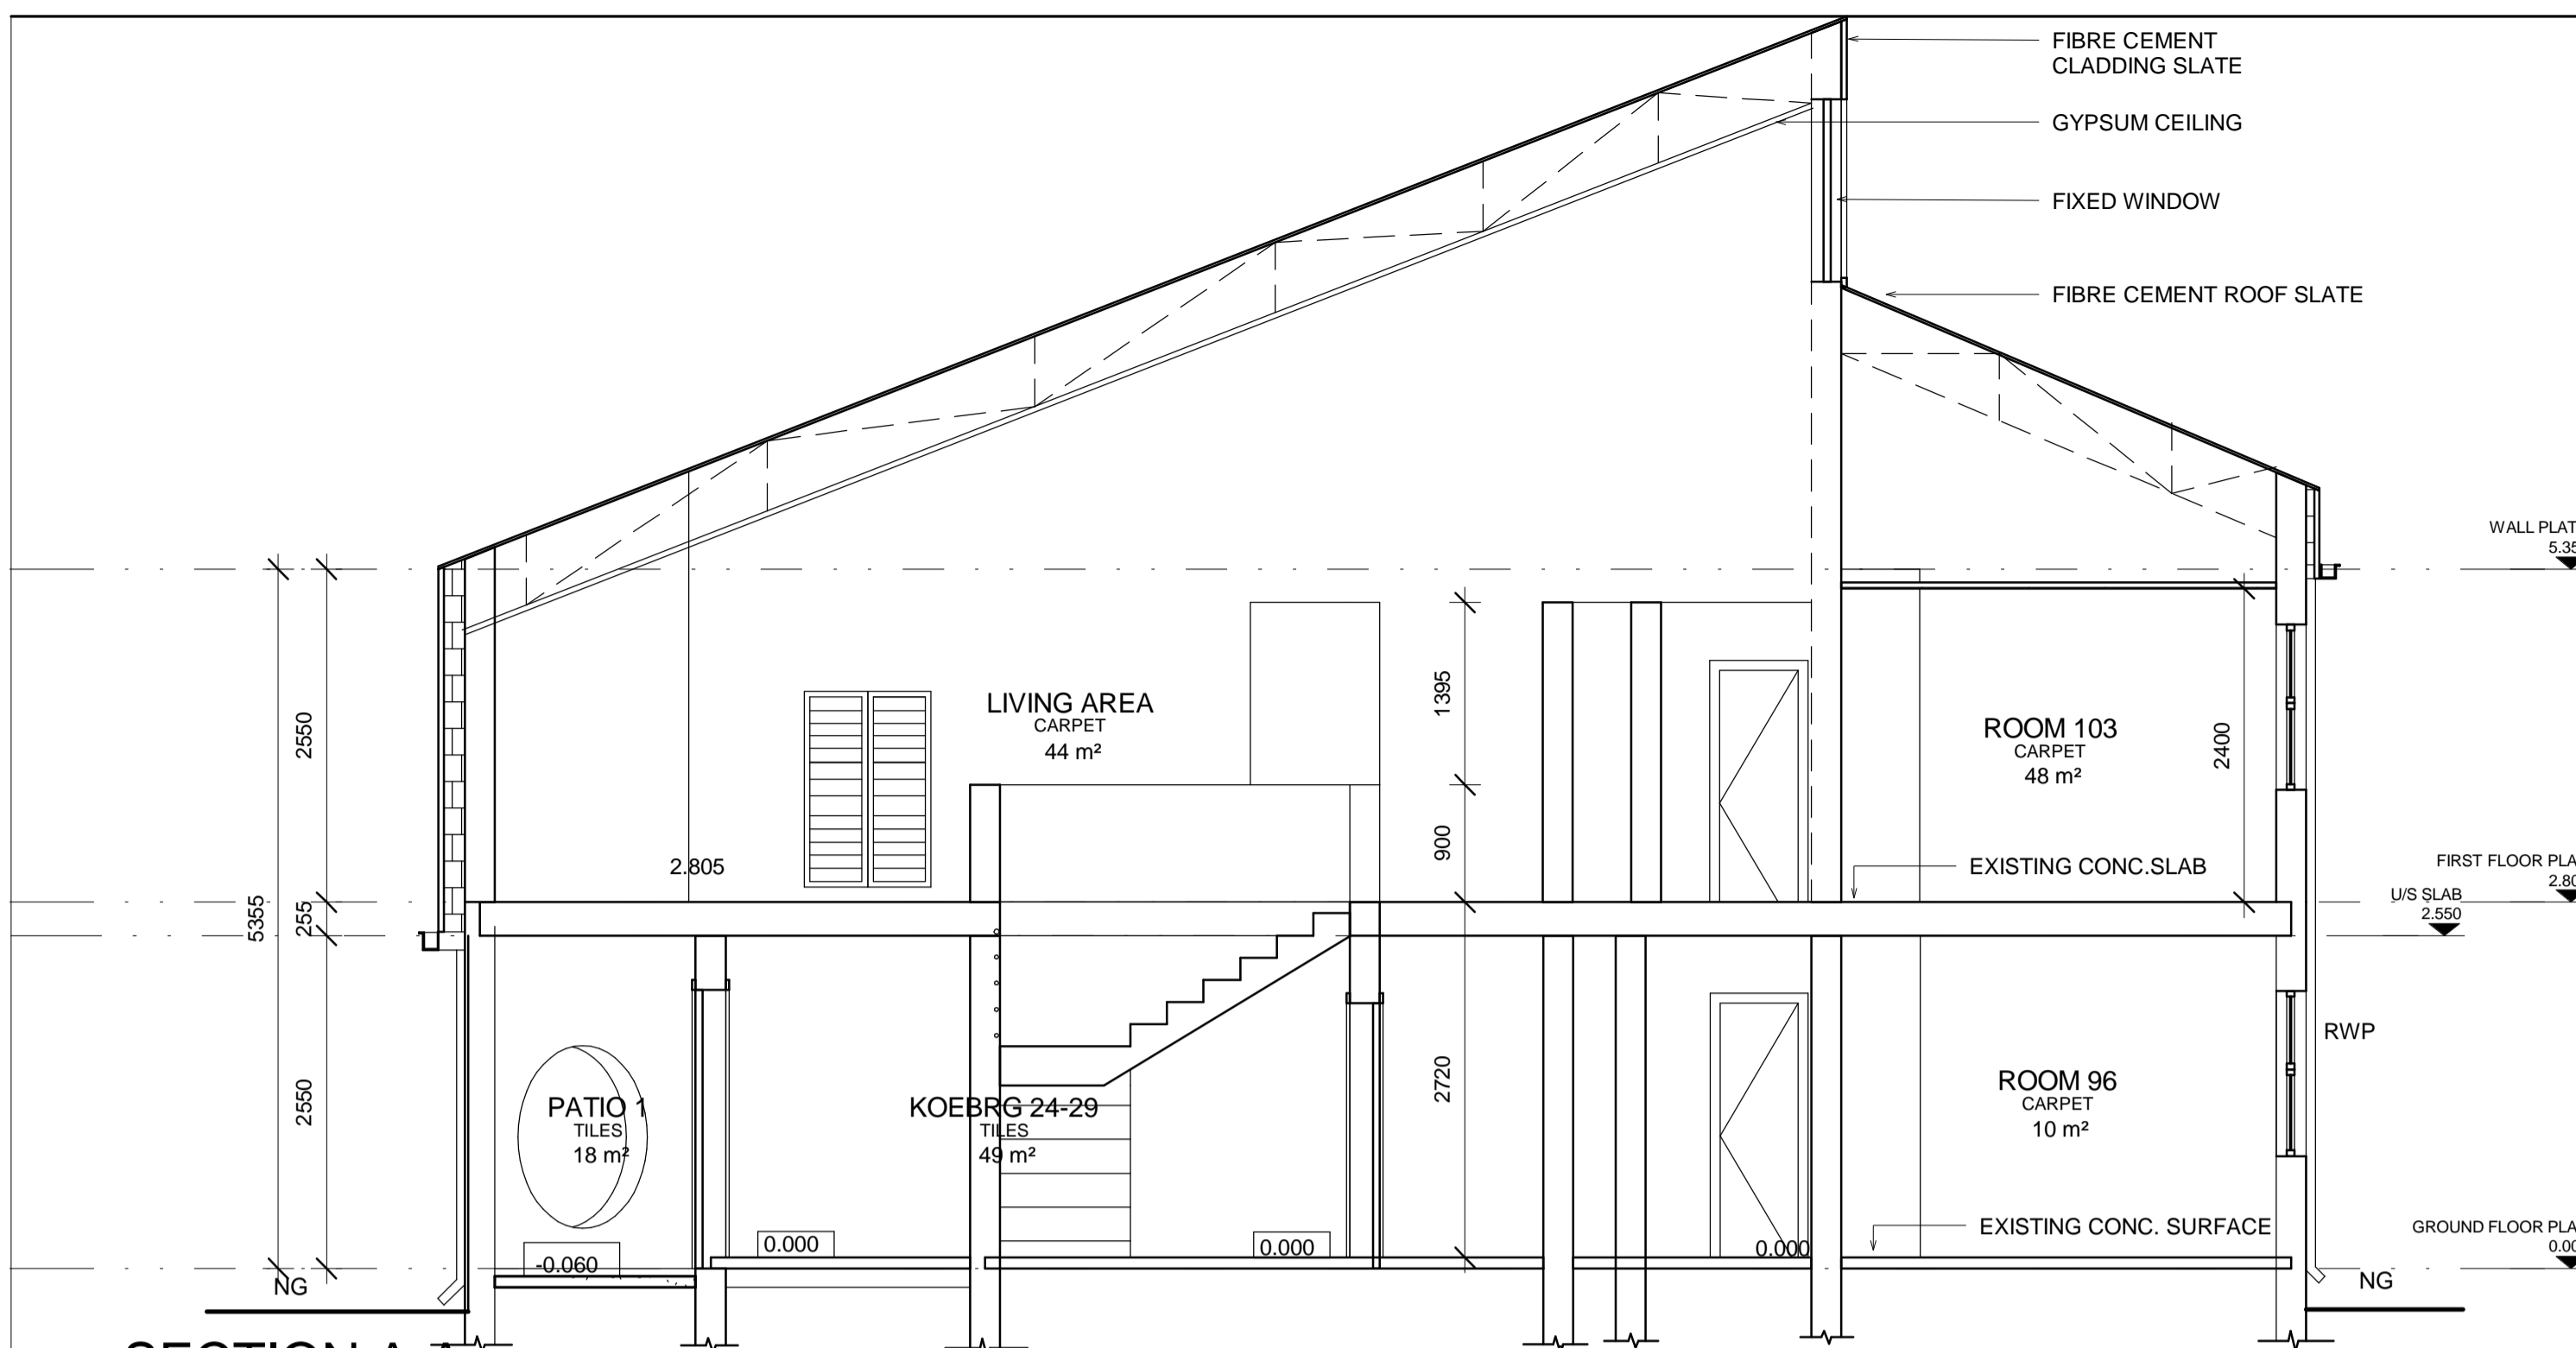


A SECTION A-A
1 : 50

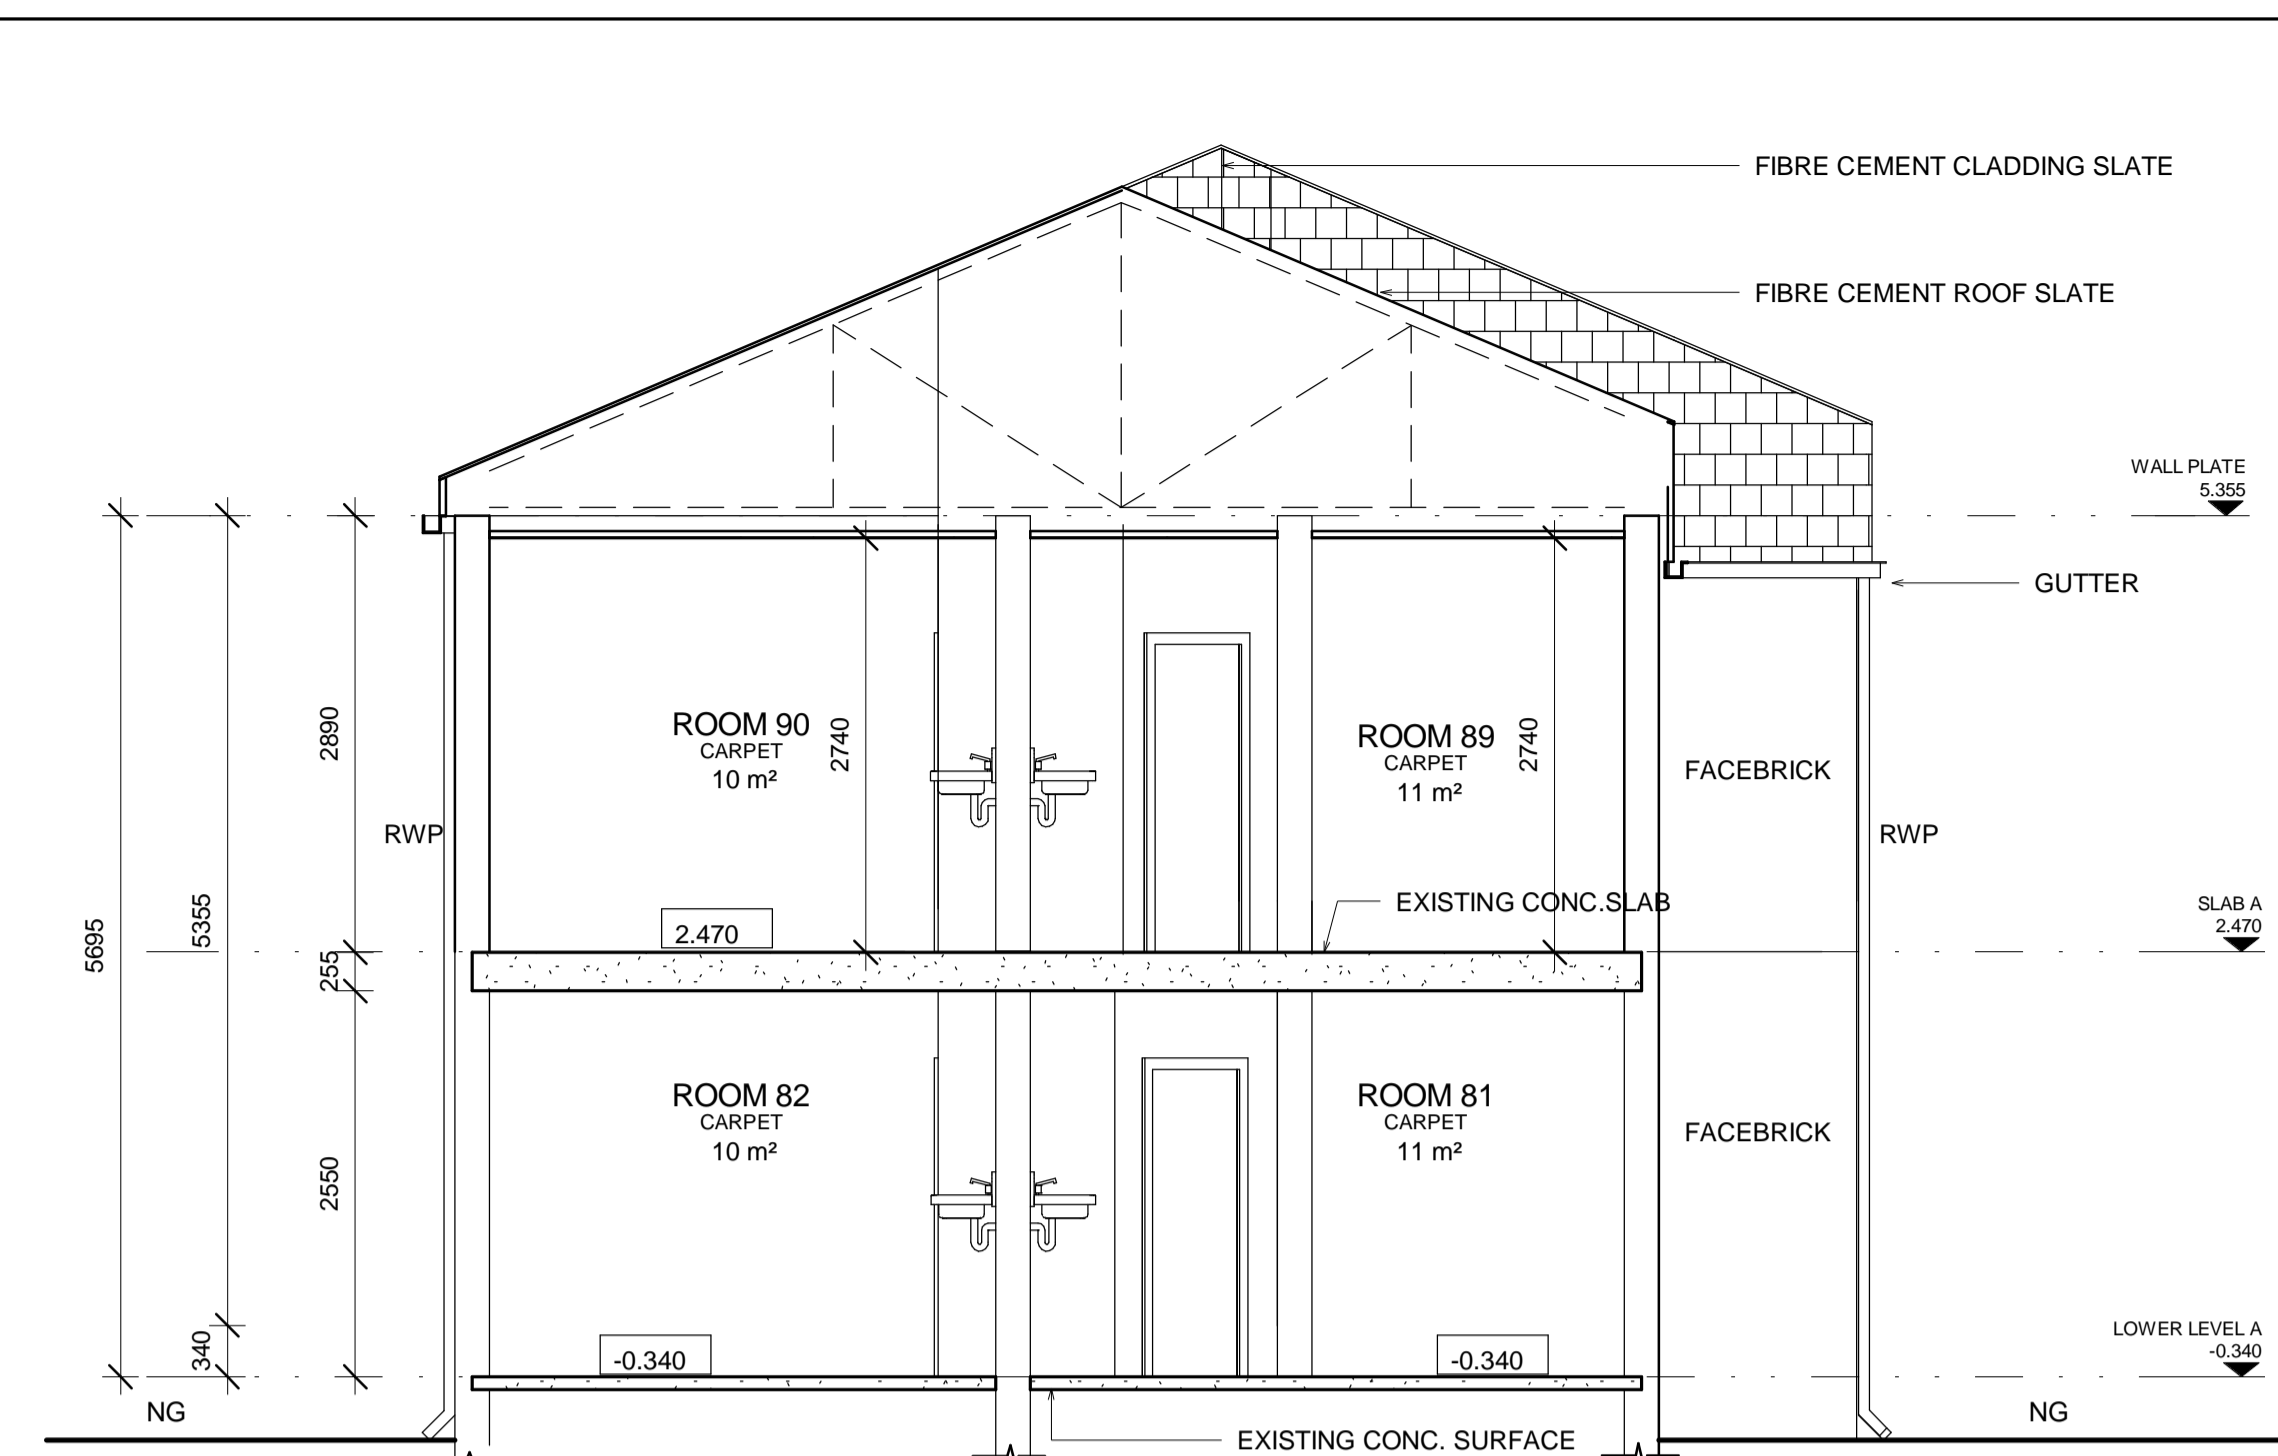


B SECTION B-B
1 : 50

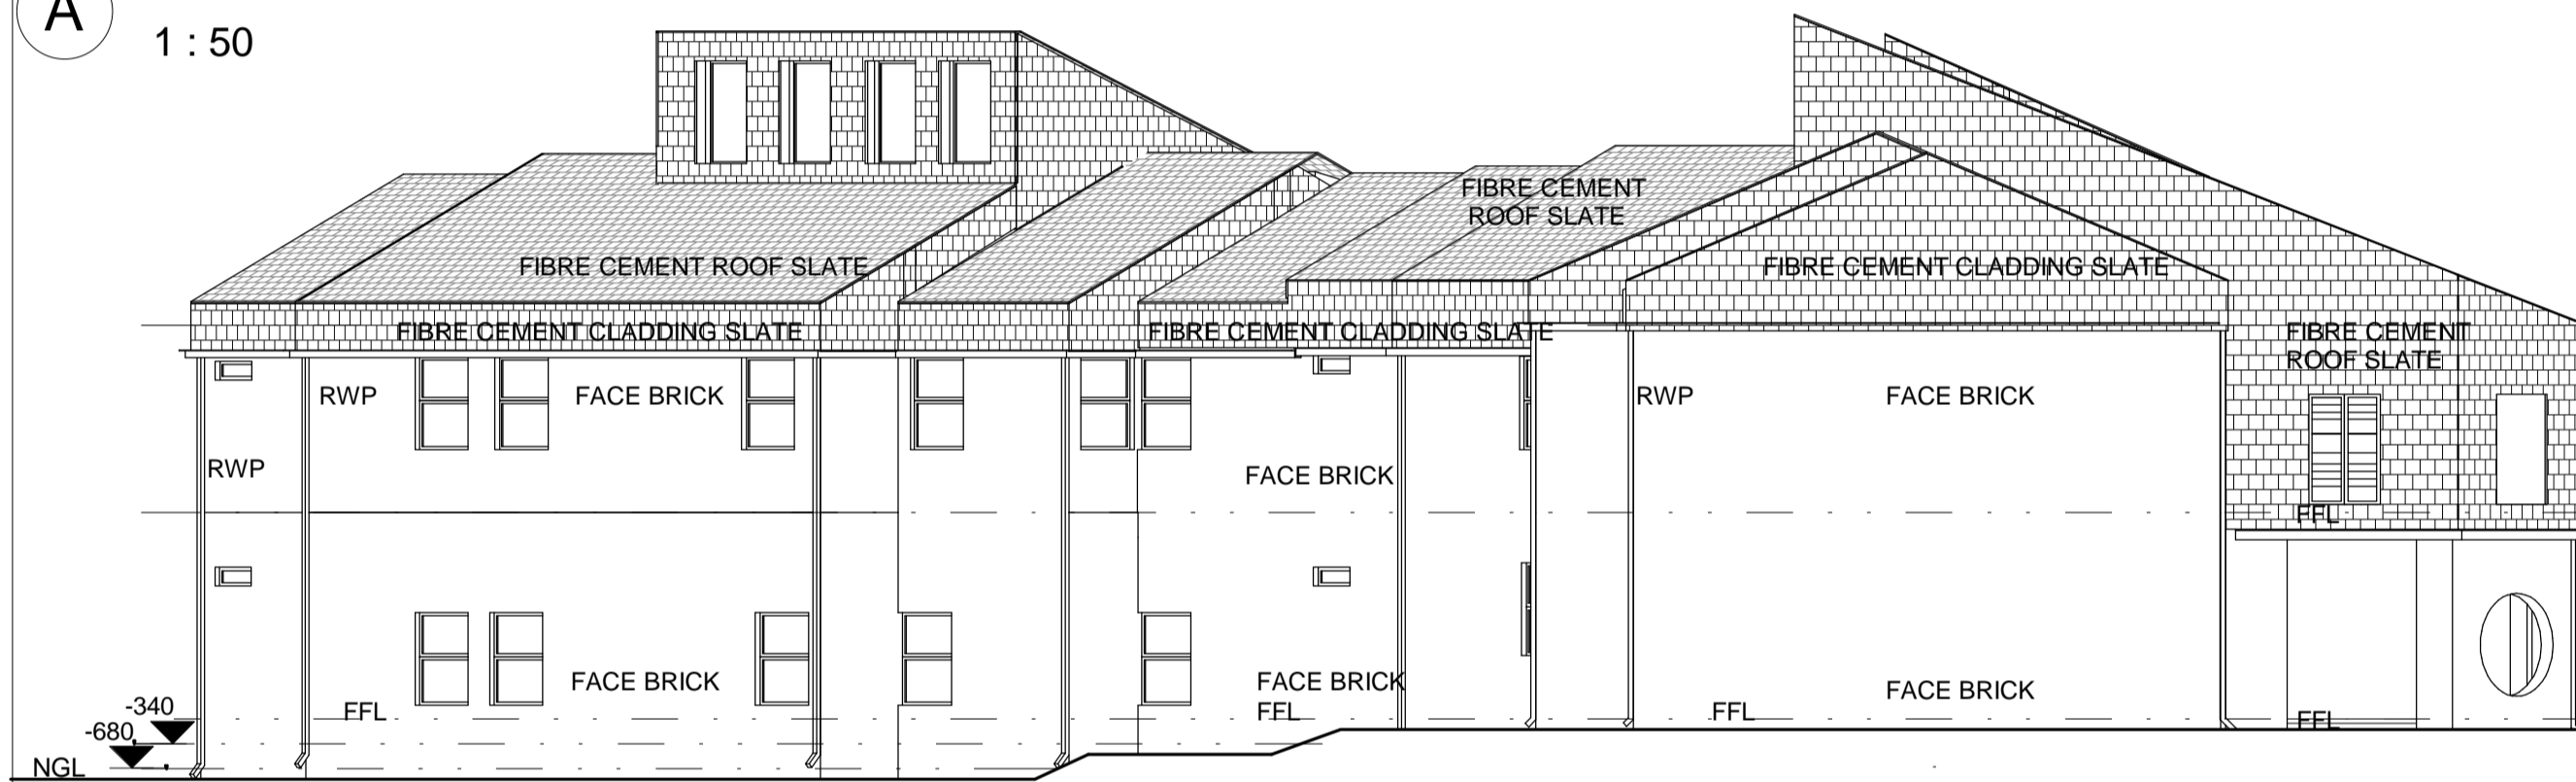


1 WEST ELEVATION
1 : 100

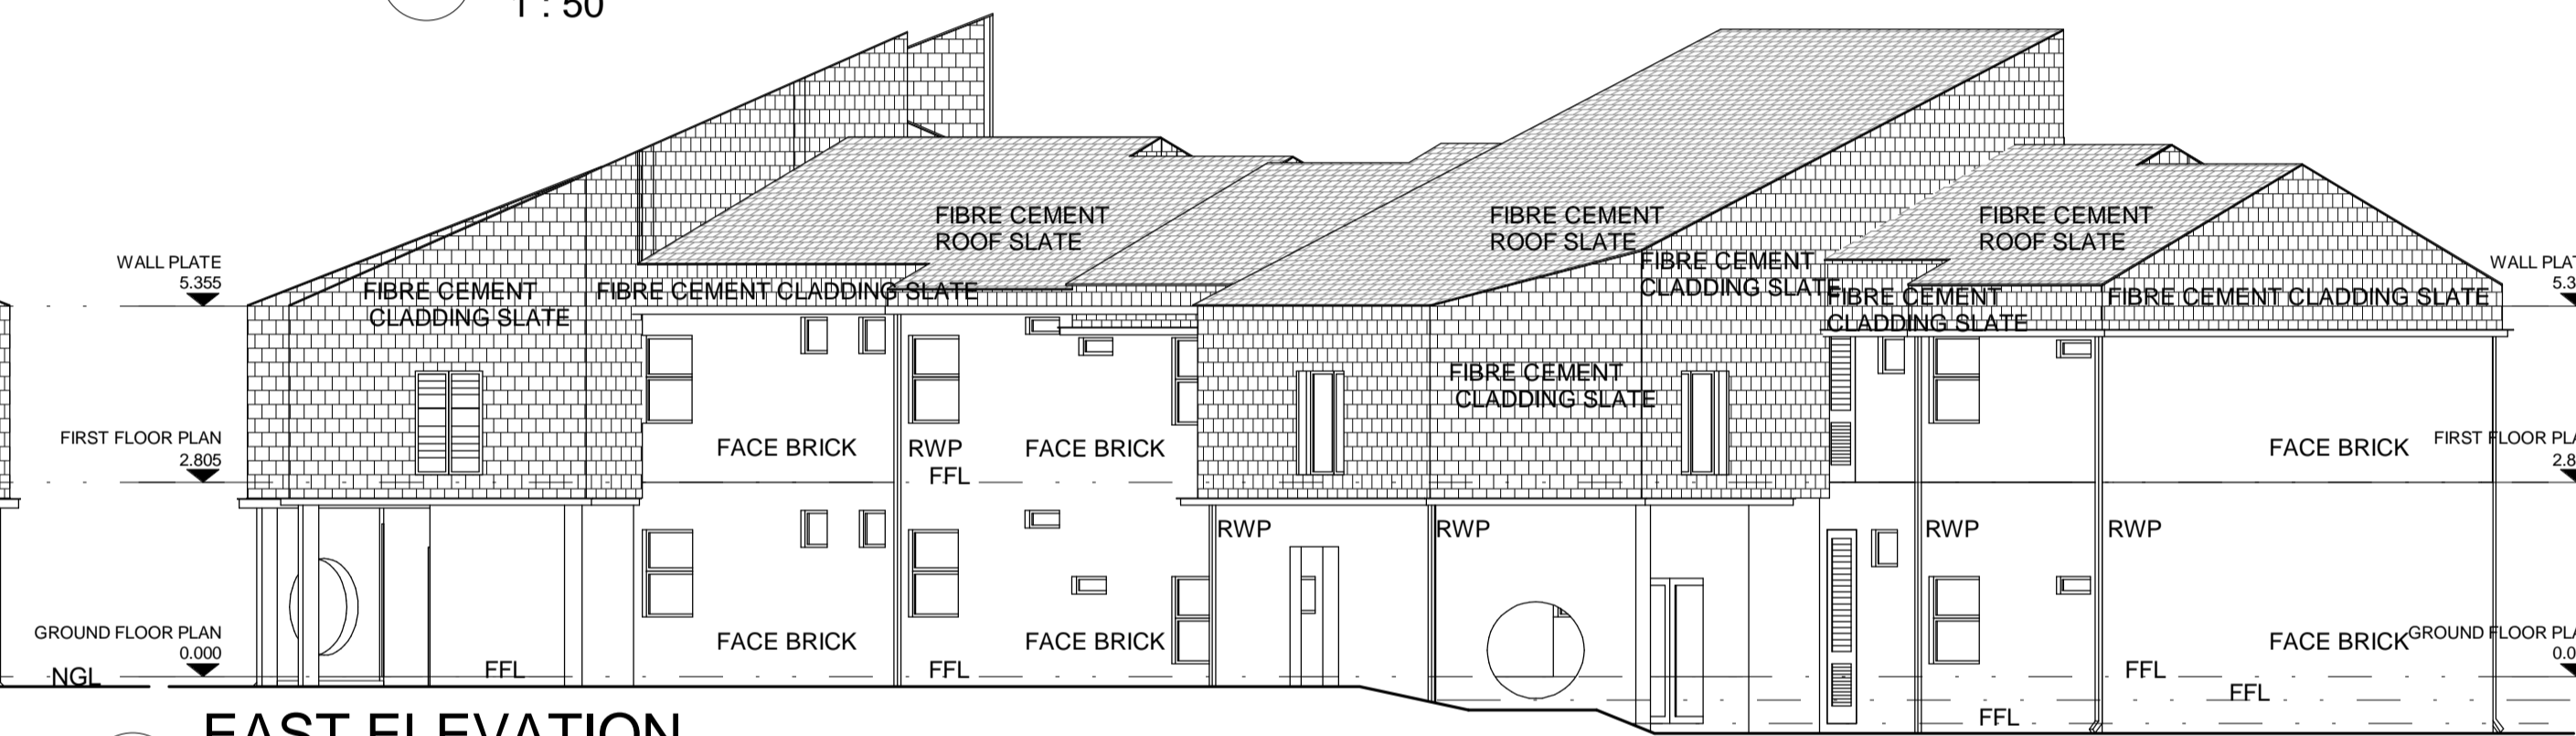

2 EAST ELEVATION
1 : 100

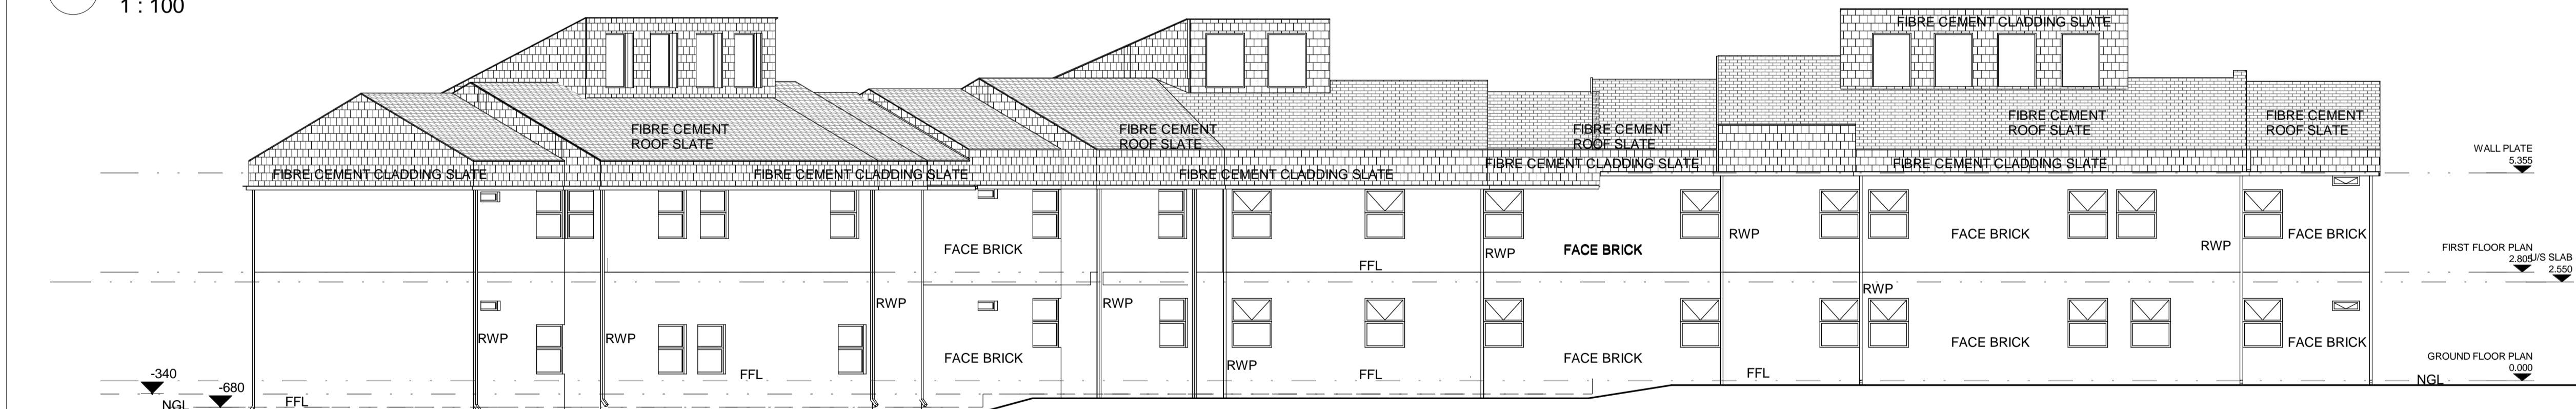

3 NORTH ELEVATION.
1 : 100

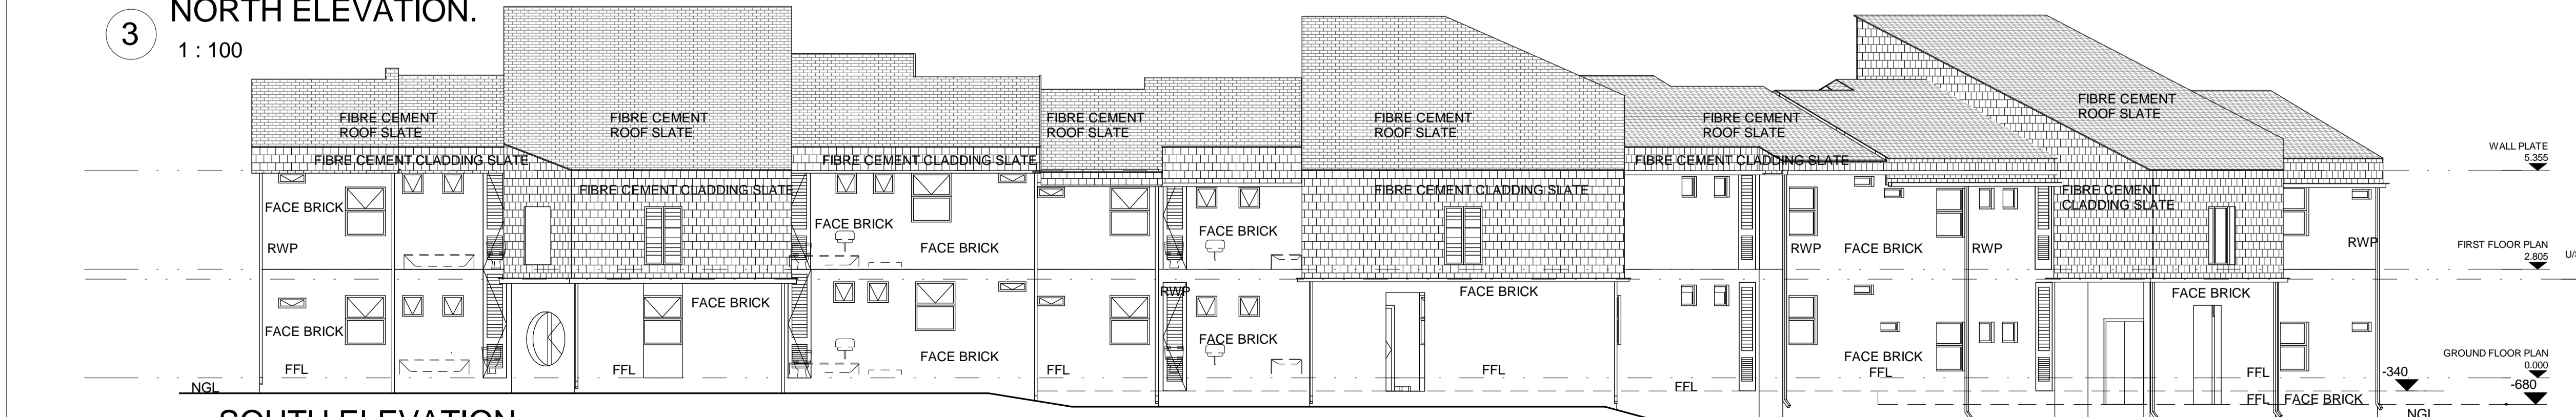

4 SOUTH ELEVATION.
1 : 100