


INSTALLED BY
VOLTELECT CC
 Andre Visser Park TEL: (021) 982 5495
 Otlovango Industria FAX: (021) 982 3792

X	26-03-2012	AS BUILT	LIJ	DVM
1	03-03-11	ISSUED FOR CONSTRUCTION	WA	SS
T	11-10-10	ISSUED FOR TENDER	WA	SS
A	23-09-10	ISSUED FOR CLIENT APPROVAL	WA	SS
REV	DATE	REVISION DESCRIPTION	BY	CHECKED

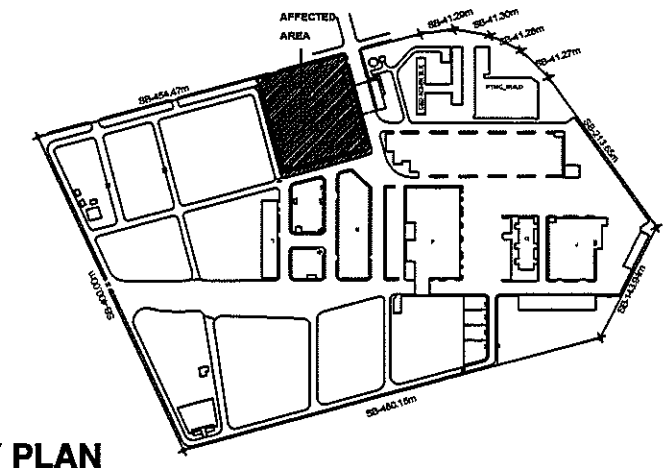

QUANTECH 11 SOUTH AVENUE
 Architectural Consultants ATHLONE 7764
 TEL: (021) 633 9314
 FAX: (021) 633 9994
 info@quantech.co.za

INTEGRATE
 CONSULTING ENGINEERS
 OFFICE 138, RICHMOND CENTRE
 114-25 MAIN ROAD, PLUMSTEAD
 7800
 SOUTH AFRICA
 Tel: +27 (0)21 797 0377
 Fax: +27 (0)21 797 0375
 website: www.integrate.co.za

Eskom Distribution	AUTHORISED BY:	PROJECT:	BRACKENFELL COMPLEX - ERF 3417		
	SS	PROPOSED NEW BUILDING			
DATE:	SS	DRAWING TITLE:	ELECTRICAL RETICULATION LAYOUT		
CHECKED BY:	SS	DRAWING STATUS:	AS BUILT		
DATE:	WA	DRAWN BY:	DRAWING NUMBER		
SCALE:	1:300	COMPLEX NO.:	SET	SHEET	REVISION
THIS DRAWING IS THE PROPERTY OF ESKOM		DATE: SEPT 2010	D - WC - 7307	204	1 X