

A

B

C

D

E

F

G

H

J

K



L

M


A
B
C
D
E
F
G

THIS DRAWING HAS BEEN CREATED
ON A C.A.D. SYSTEM AND ANY
AMENDMENT TO THE DRAWING
MUST BE EFFECTED ONLY
ON THE SAME C.A.D. SYSTEM


A
B
C
D
E
F
G
H
J
K
L
M

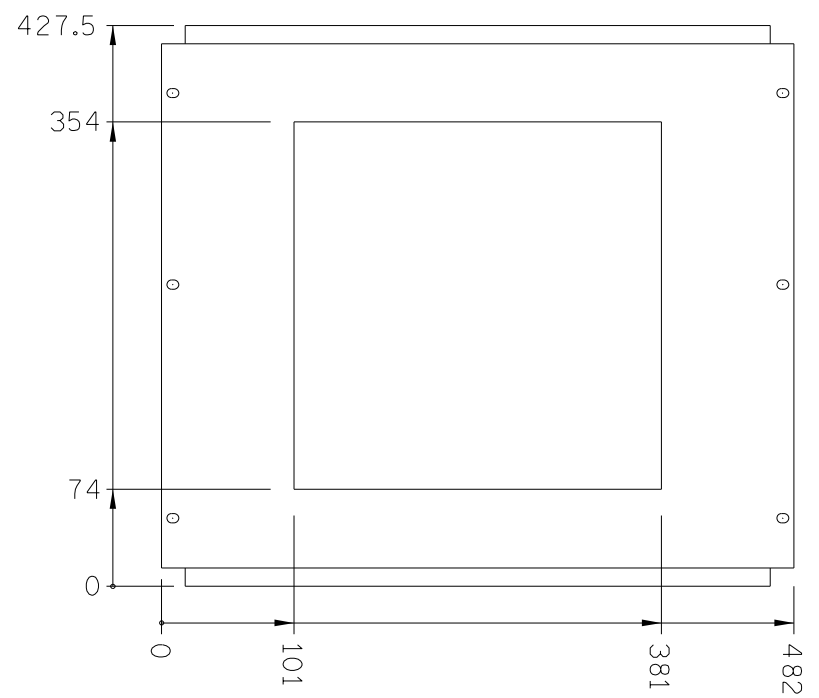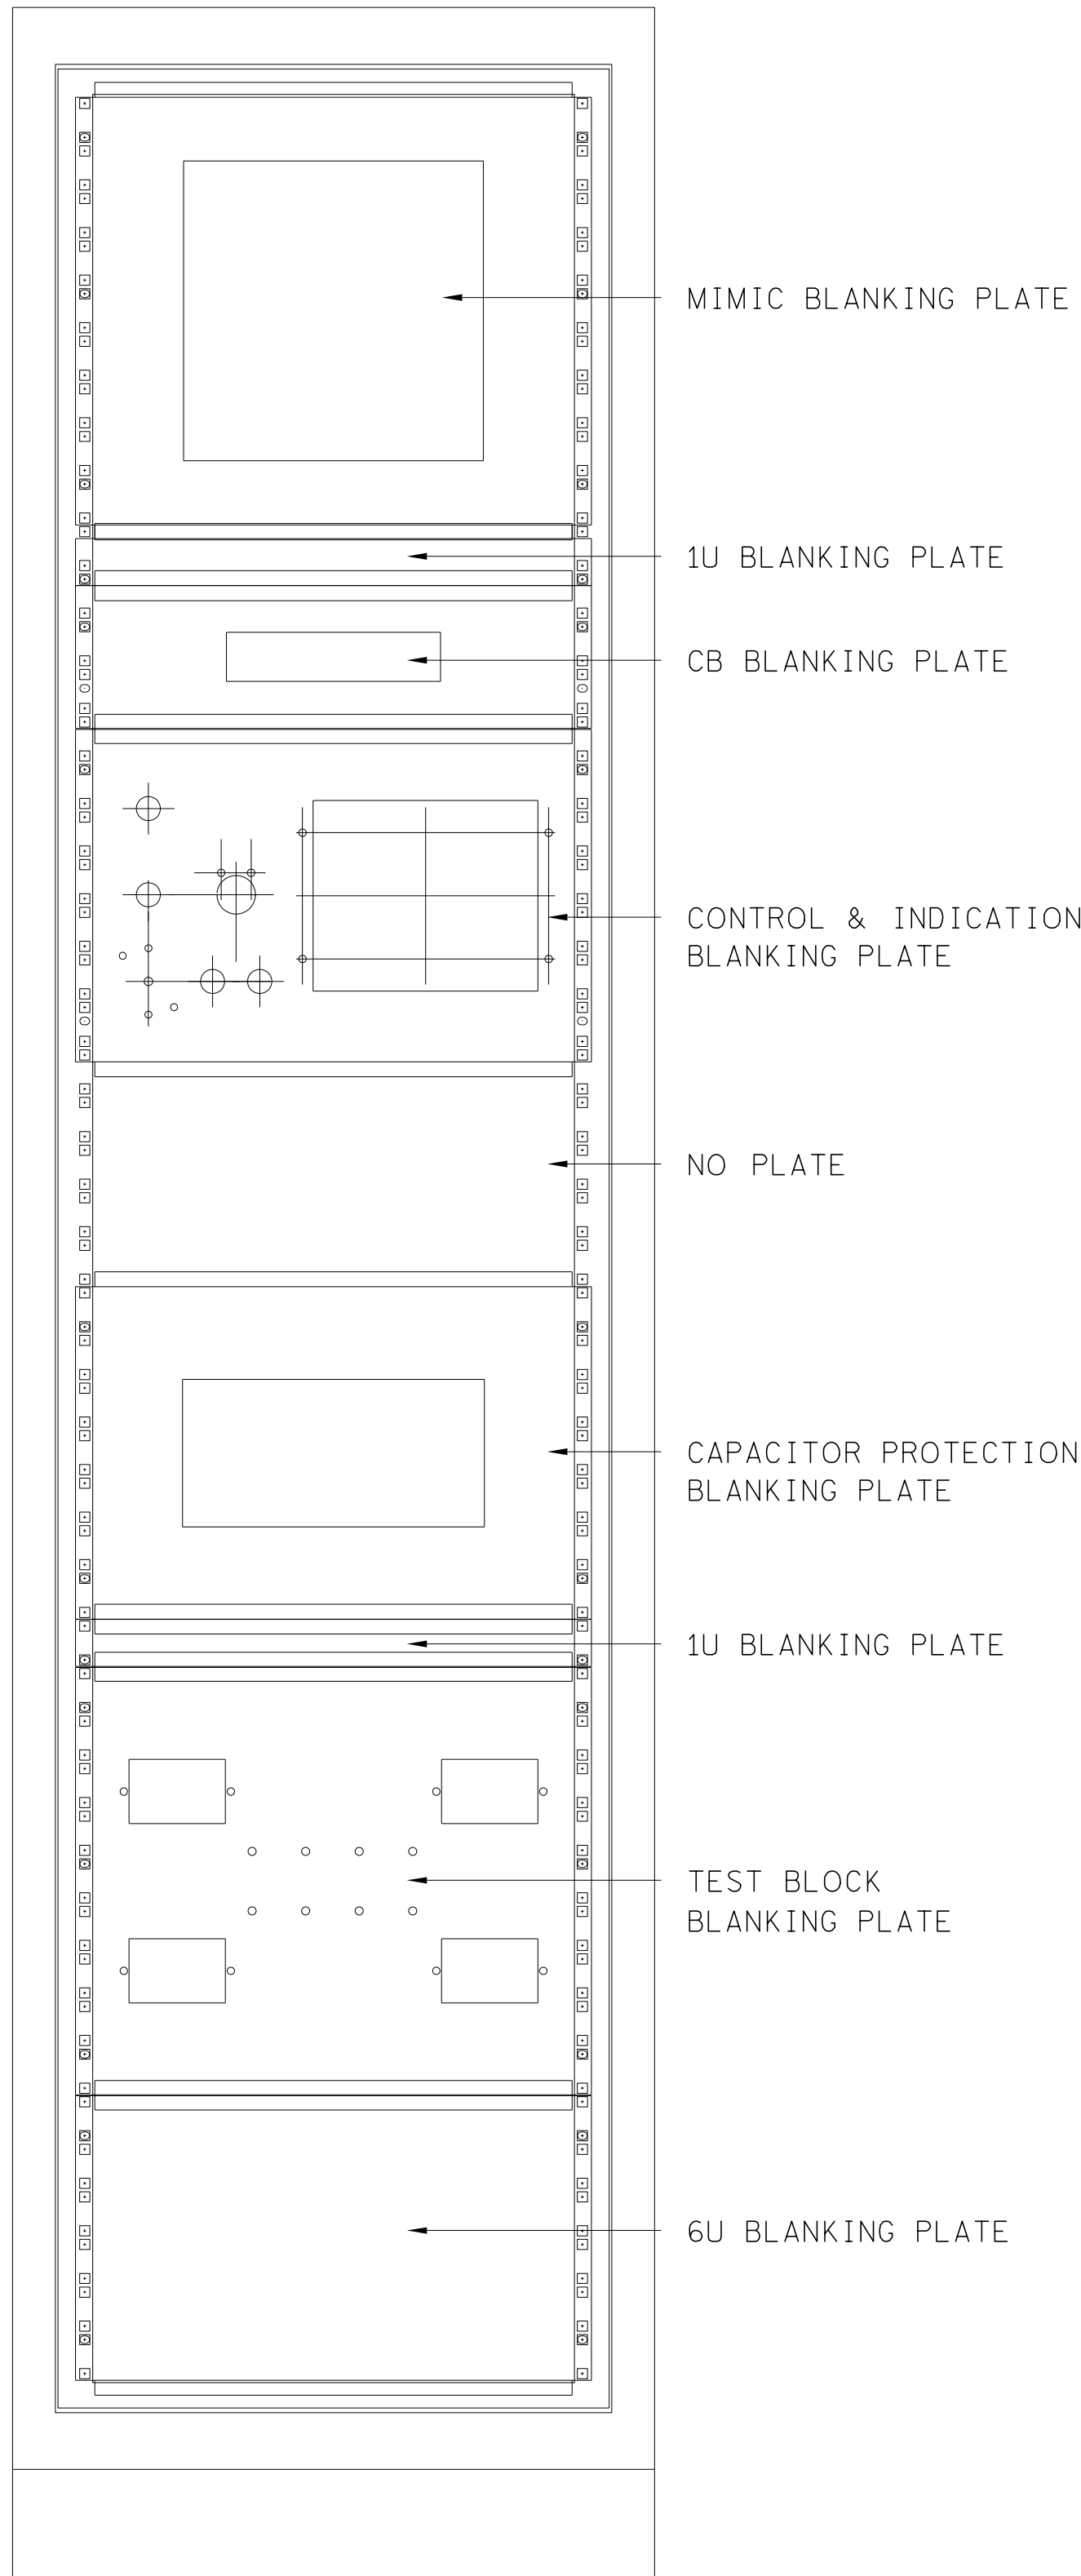


MIMIC CUT-OUT DETAILS
STANDARD 9U BLANKING PLATE

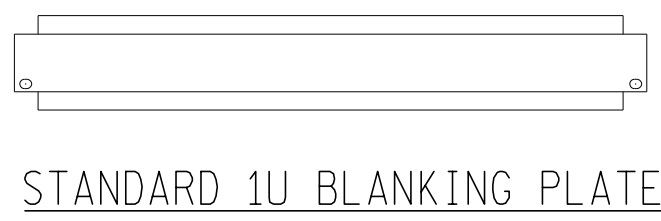


STANDARD 1U BLANKING PLATE

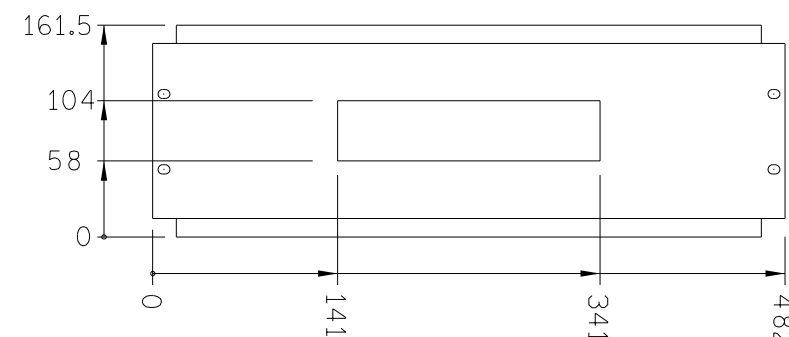


MCB CUT-OUT DETAILS
STANDARD 3U BLANKING PLATE

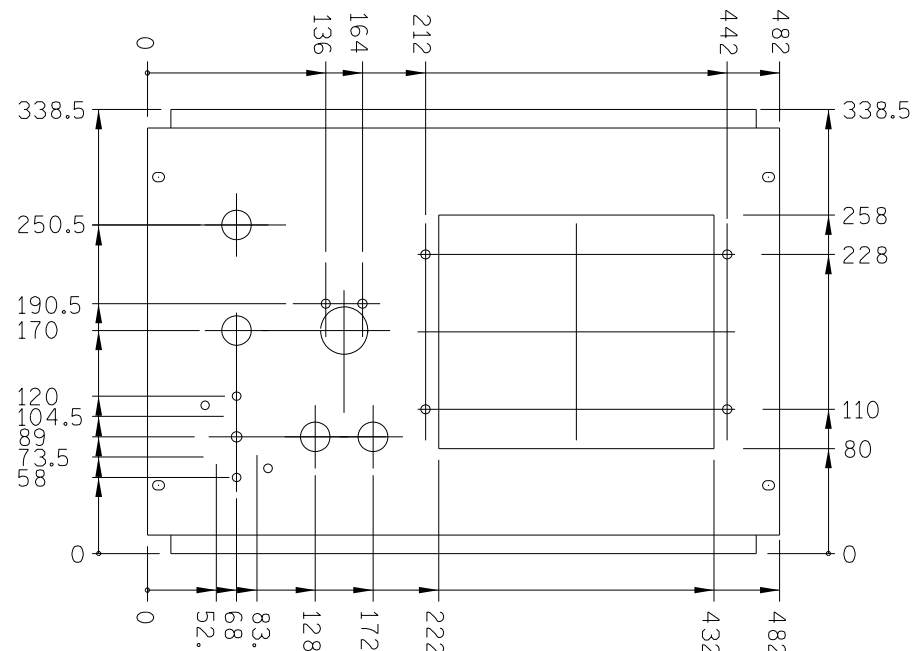


CONTROL & INDICATION CUT-OUT DETAILS
STANDARD 7U BLANKING PLATE

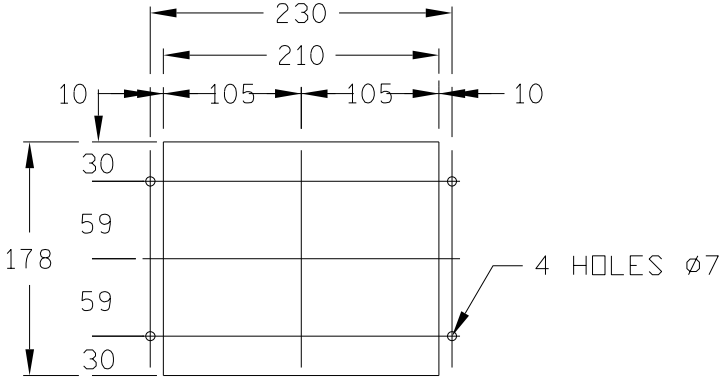


RESTRICTED EARTH
FAULT RELAY

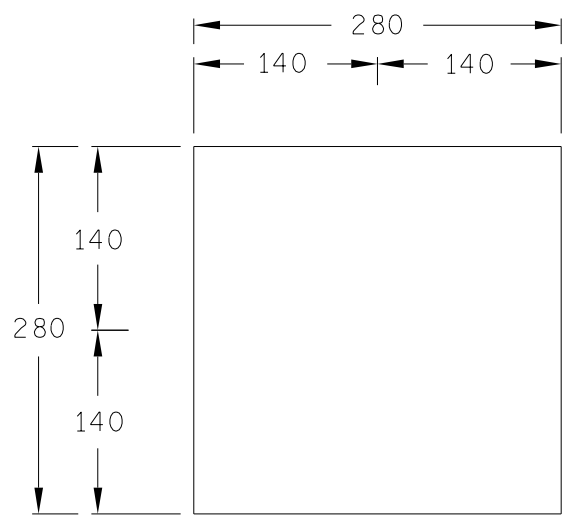


MIMIC PANEL

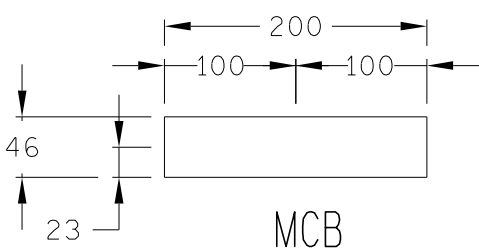


MCB

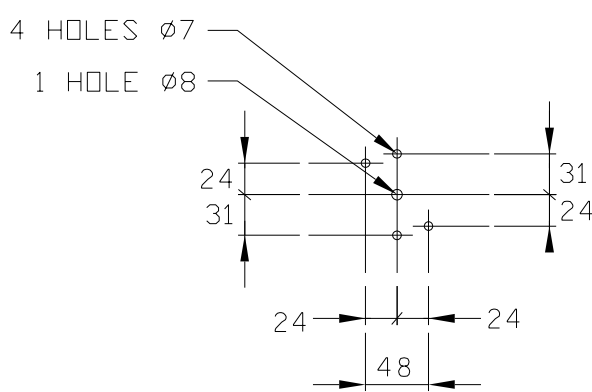


CB FAIL ISOLATE SWITCH

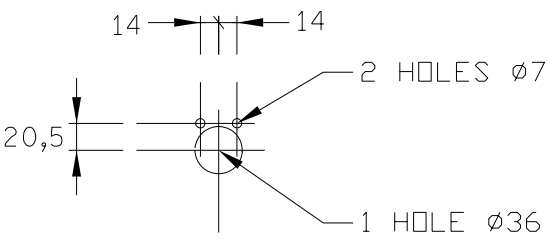


INTERLOCK

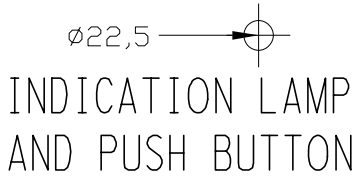


INDICATION LAMP
AND PUSH BUTTON

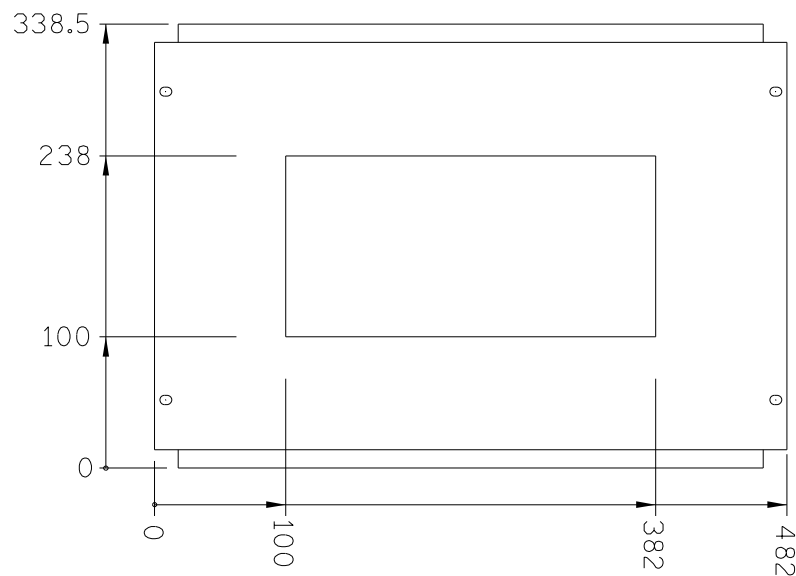


CAPACITOR PROTECTION AND CONTROL RELAY
CUT-OUT DETAILS
STANDARD 7U BLANKING PLATE

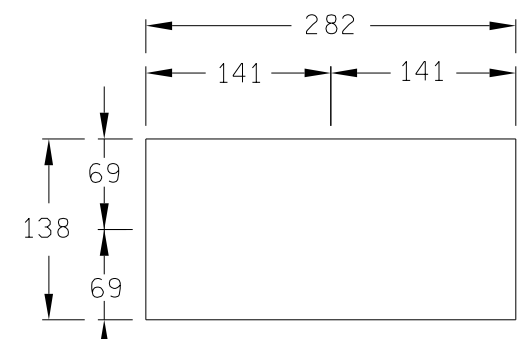


CAPACITOR PROTECTION
AND CONTROL RELAY

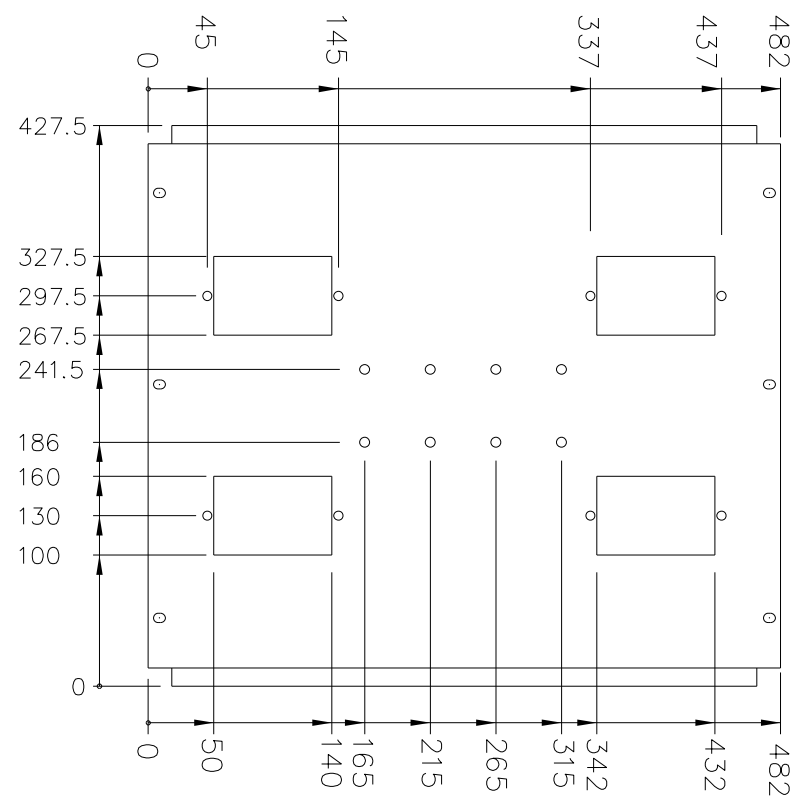

TESTBLOCK & BANANA PLUGS
CUT-OUT DETAILS
STANDARD 9U BLANKING PLATE

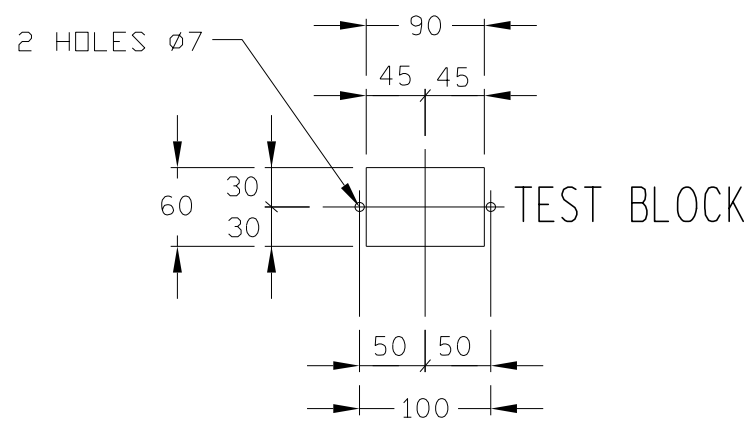

$\phi 7,5$ BANANA PLUG

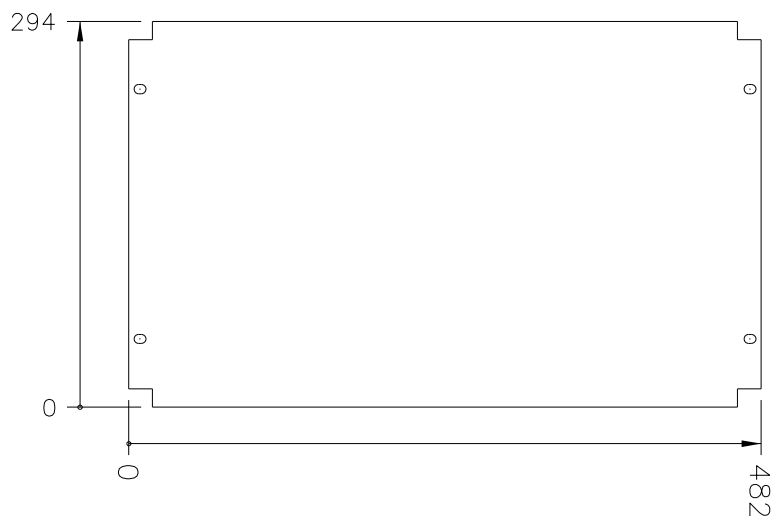


STANDARD 6U BLANKING PLATE

SHT NO	ITEM
37	CABLE BLOCK DIAGRAM
36	PANEL CABLING DIAGRAM
35	PANEL CABLING DIAGRAM
34	PANEL CABLING DIAGRAM
33	PANEL CABLING DIAGRAM
32	TRANSUCER ANALOGUE OUTPUTS
31	REMOTE TERMINAL UNIT INPUTS
30	REMOTE TERMINAL UNIT INPUTS
29	CIRCUIT BREAKER ALARMS
28	REMOTE TERMINAL UNIT OUTPUTS
27	REMOTE TERMINAL UNIT INPUTS
26	REMOTE TERMINAL UNIT INPUTS
25	SPRING CHARGING MOTOR AC,DC
24	OPERATING HEATER AUXILIARY
23	CB SPRING CHARGE MOTOR CIRCUIT
22	ANTICONDENSATION
21	AUXILIARY CIRCUIT
20	MOTOR CIRCUIT
19	MOTOR CIRCUIT ISOLATOR
18	SPRING CHARGING MOTOR AC,DC
17	CAP BANK ALARMS AND INDI.
16	BACK UP DC KEY DIAGRAM
15	BACK UP DC KEY DIAGRAM
14	MECHANISM FSA TRIP CIRCUIT 2
13	BACK UP DC KEY DIAGRAM
12	INPUT & OUTPUT
11	INPUT & OUTPUT
10	BACK UP DC KEY DIAGRAM
9	INPUT & OUTPUT
8	MAIN DC KEY DIAGRAM
7	VT SUPPLY KEY DIAGRAM
6	UNBALANCED CAP AC KEY DIAG.
5	CAP STAR POINT AC KEY DIAG.
4	AC KEY DIAGRAM
3A	PANEL CUTOUTS
3	PANEL LAYOUT
2	SINGLE LINE DIAGRAM
1	COVER PAGE


2	AS BUILT						
REV	REVISION DESCRIPTION	BY	CHKD	AUTH	DATE	REFERENCE DRAWINGS	
		DISTRIBUTION NORTHERN ENGINEERING DIVISION PROTECTION & METERING					
PROJECT APPROVED D. PUDNEY		BRITS INDUSTRIES SUBSTATION					
DATE 09/07/2012		88kV 40MVA _r CAPACITOR BANK					
PROJECT CHECKED N.MOEKETSANE		PANEL CUTOUTS					
DATE 09/07/2012							
DRAWN BY L.TSHABALALA		2-NR/22000		SET NUMBER		SHEET NUMBER	REVISION
DATE 14/09/2012				1	3A	2	
SCALE: N.T.S.							


THIS DRAWING HAS BEEN CREATED
ON A C.A.D. SYSTEM AND ANY
AMENDMENT TO THE DRAWING
MUST BE EFFECTED ONLY
ON THE SAME C.A.D. SYSTEM

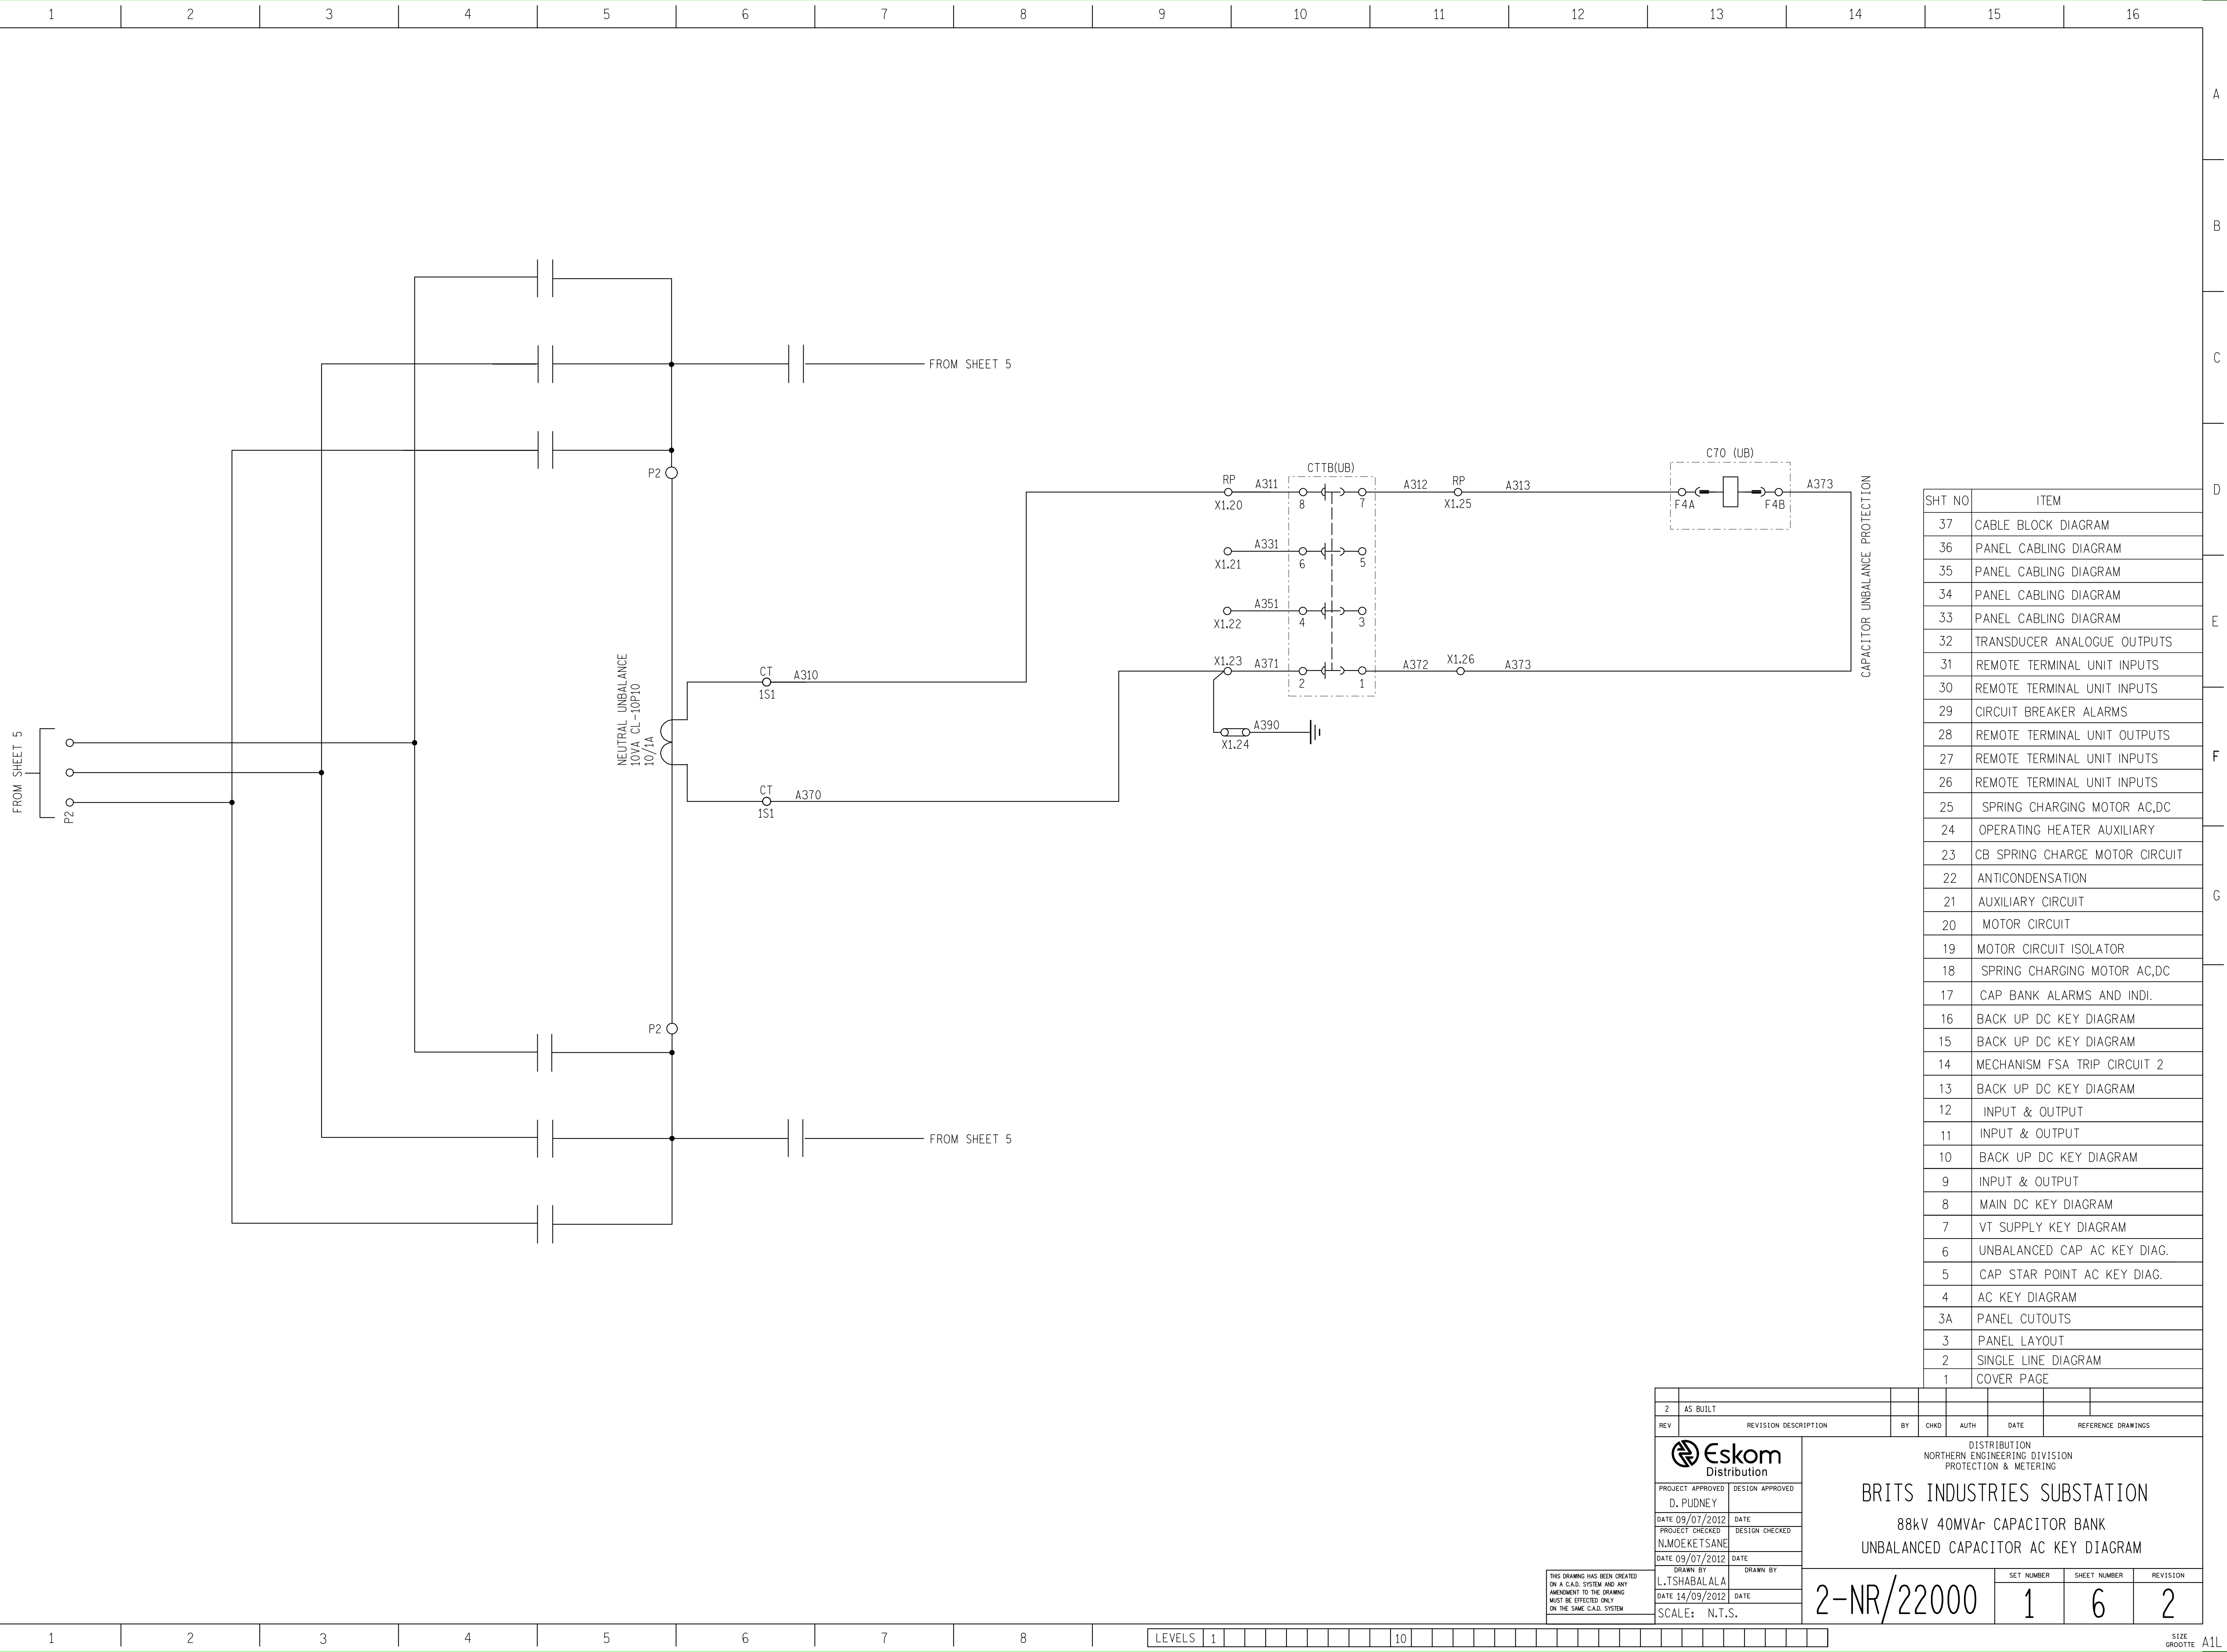


SHT NO	ITEM
37	CABLE BLOCK DIAGRAM
36	PANEL CABLING DIAGRAM
35	PANEL CABLING DIAGRAM
34	PANEL CABLING DIAGRAM
33	PANEL CABLING DIAGRAM
32	TRANSDUCER ANALOGUE OUTPUTS
31	REMOTE TERMINAL UNIT INPUTS
30	REMOTE TERMINAL UNIT INPUTS
29	CIRCUIT BREAKER ALARMS
28	REMOTE TERMINAL UNIT OUTPUTS
27	REMOTE TERMINAL UNIT INPUTS
26	REMOTE TERMINAL UNIT INPUTS
25	SPRING CHARGING MOTOR AC,DC
24	OPERATING HEATER AUXILIARY
23	CB SPRING CHARGE MOTOR CIRCUIT
22	ANTICONDENSATION
21	AUXILIARY CIRCUIT
20	MOTOR CIRCUIT
19	MOTOR CIRCUIT ISOLATOR
18	SPRING CHARGING MOTOR AC,DC
17	CAP BANK ALARMS AND INDI.
16	BACK UP DC KEY DIAGRAM
15	BACK UP DC KEY DIAGRAM
14	MECHANISM FSA TRIP CIRCUIT 2
13	BACK UP DC KEY DIAGRAM
12	INPUT & OUTPUT
11	INPUT & OUTPUT
10	BACK UP DC KEY DIAGRAM
9	INPUT & OUTPUT
8	MAIN DC KEY DIAGRAM
7	VT SUPPLY KEY DIAGRAM
6	UNBALANCED CAP AC KEY DIAG.
5	CAP STAR POINT AC KEY DIAG.
4	AC KEY DIAGRAM
3A	PANEL CUTOUPS
3	PANEL LAYOUT
2	SINGLE LINE DIAGRAM
1	COVER PAGE

2	AS BUILT							
REV	REVISION DESCRIPTION	BY	CHKD	AUTH	DATE	REFERENCE DRAWINGS		
		DISTRIBUTION NORTHERN ENGINEERING DIVISION PROTECTION & METERING						
PROJECT APPROVED D. PUDNEY		BRITS INDUSTRIES SUBSTATION 88kV 40MVAR CAPACITOR BANK UNBALANCED CAPACITOR AC KEY DIAGRAM						
DATE 09/07/2012 PROJECT CHECKED N.MOEKETSAANE								
DATE 09/07/2012								
DRAWN BY L.TSHABALALA								
DATE 14/09/2012		2-NR/22000 SET NUMBER 1 SHEET NUMBER 6 REVISION 2						
SCALE: N.T.S.								

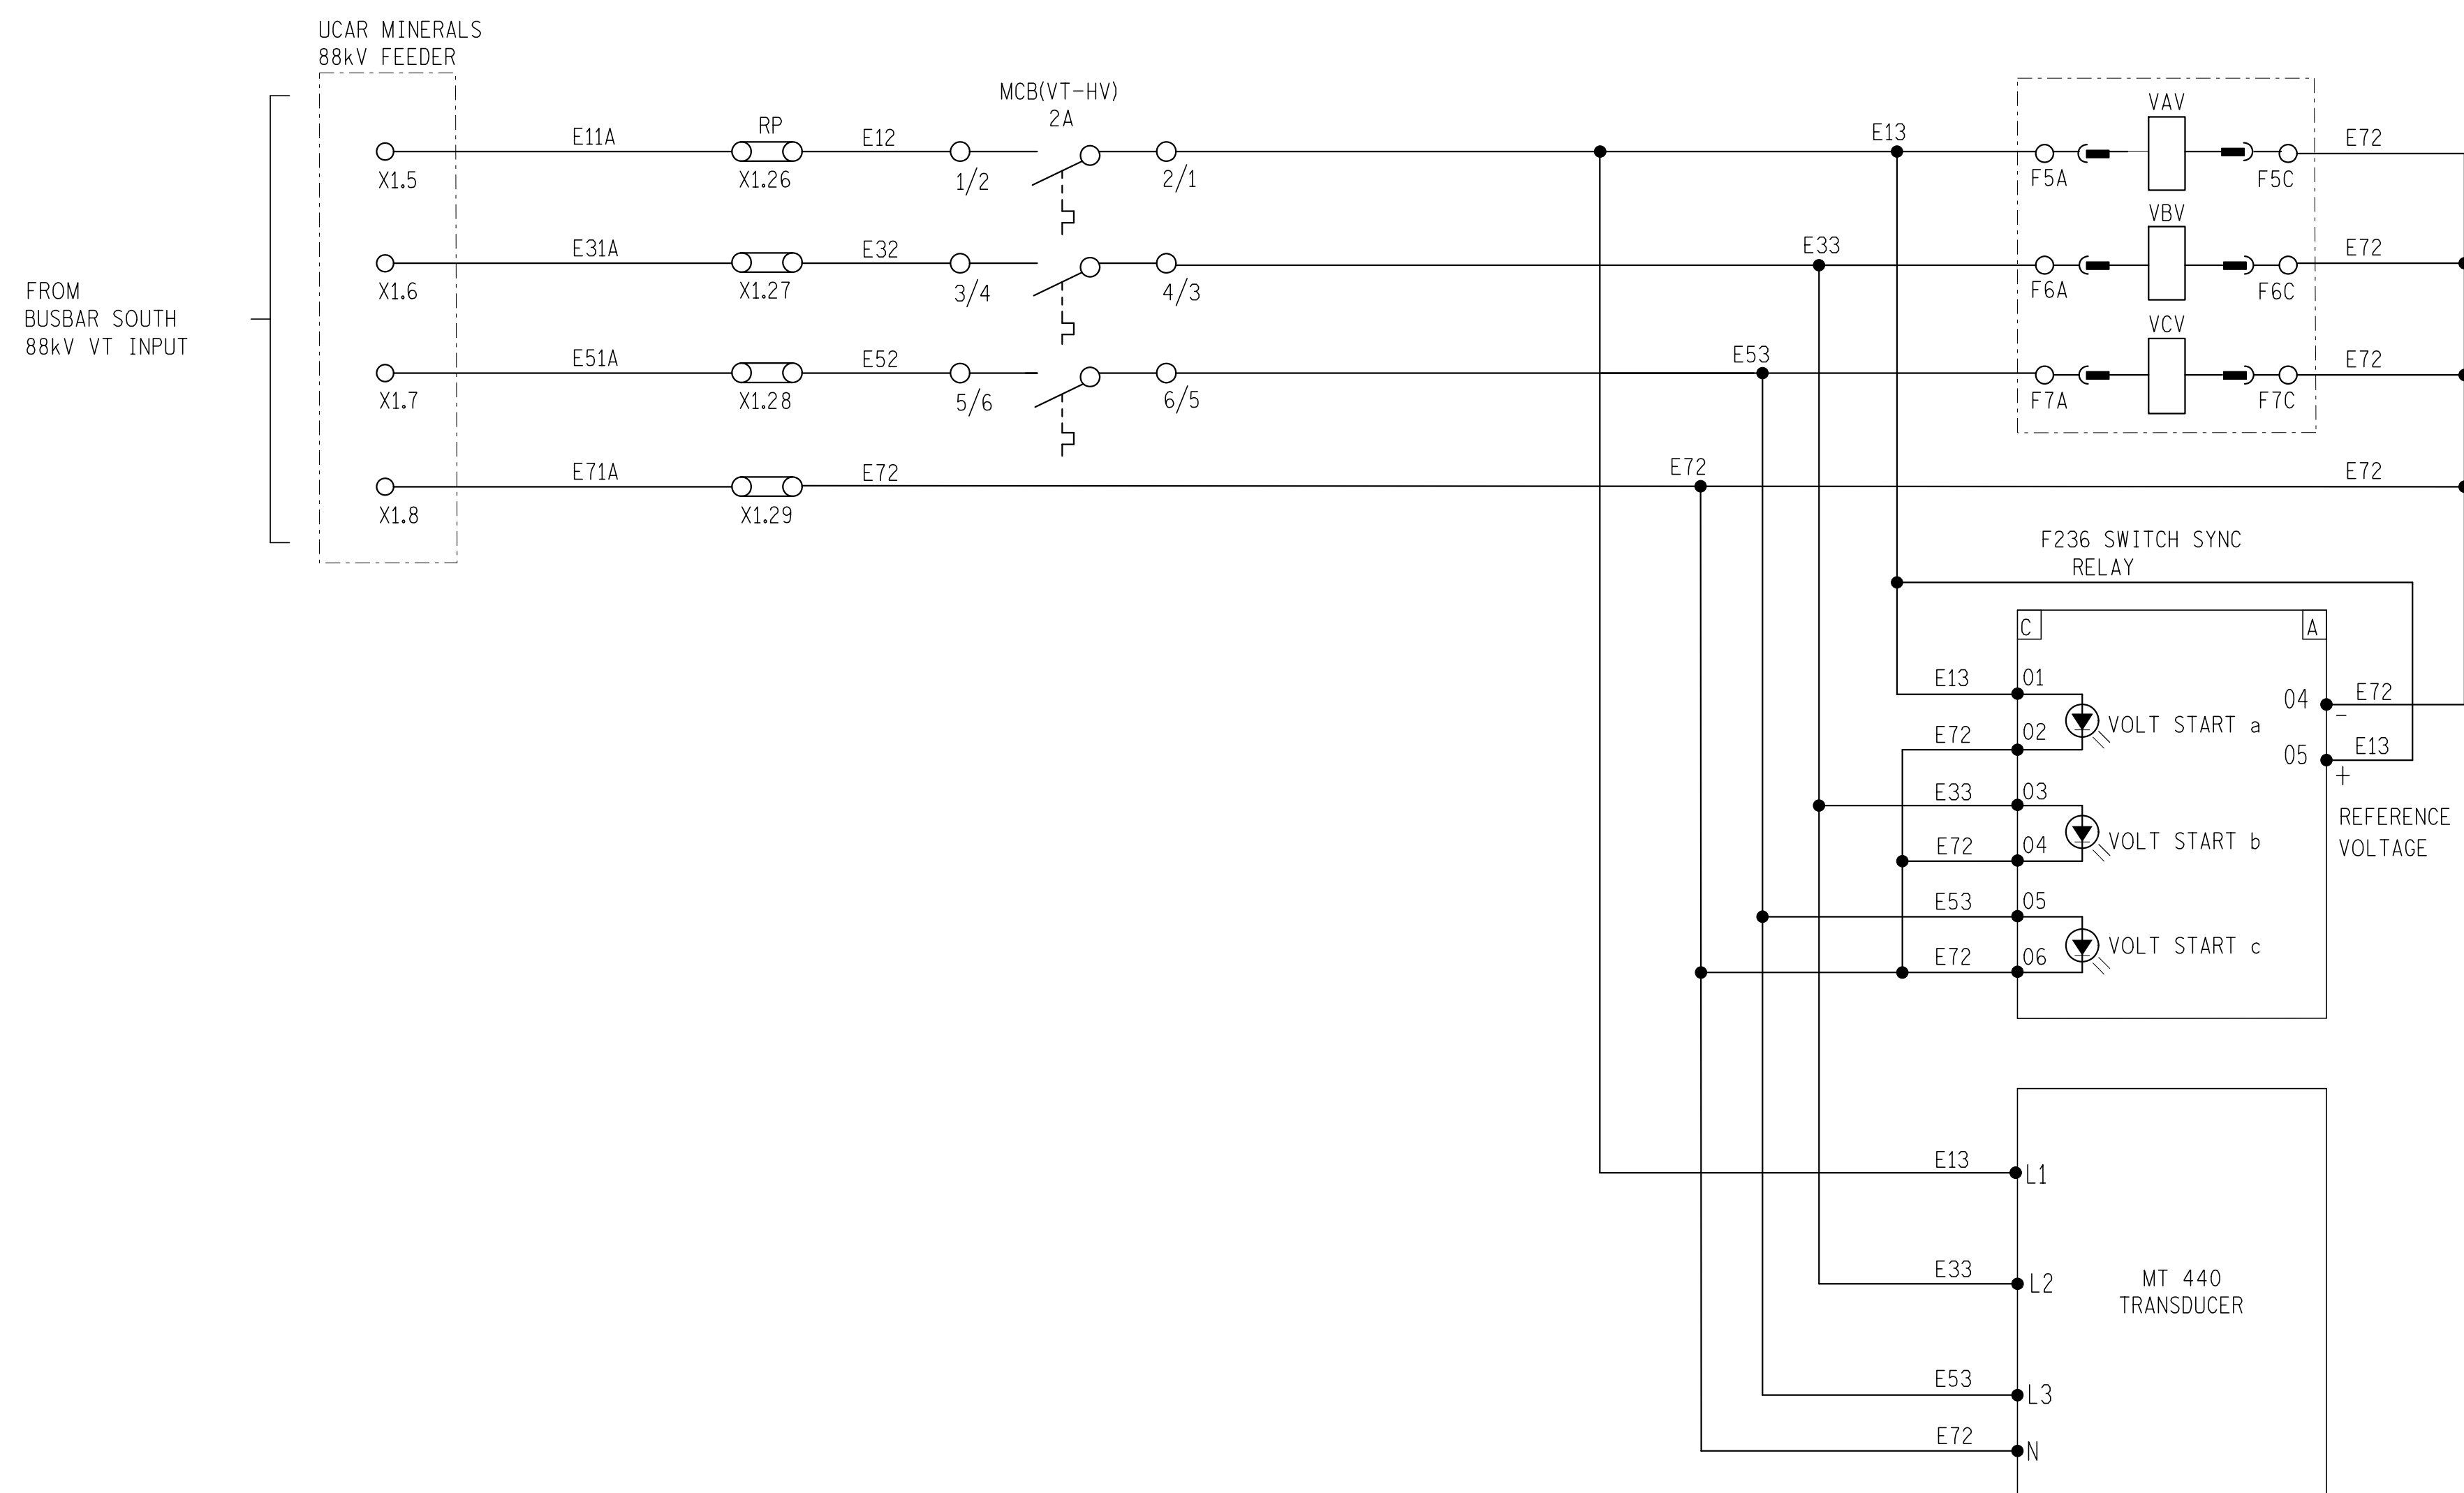


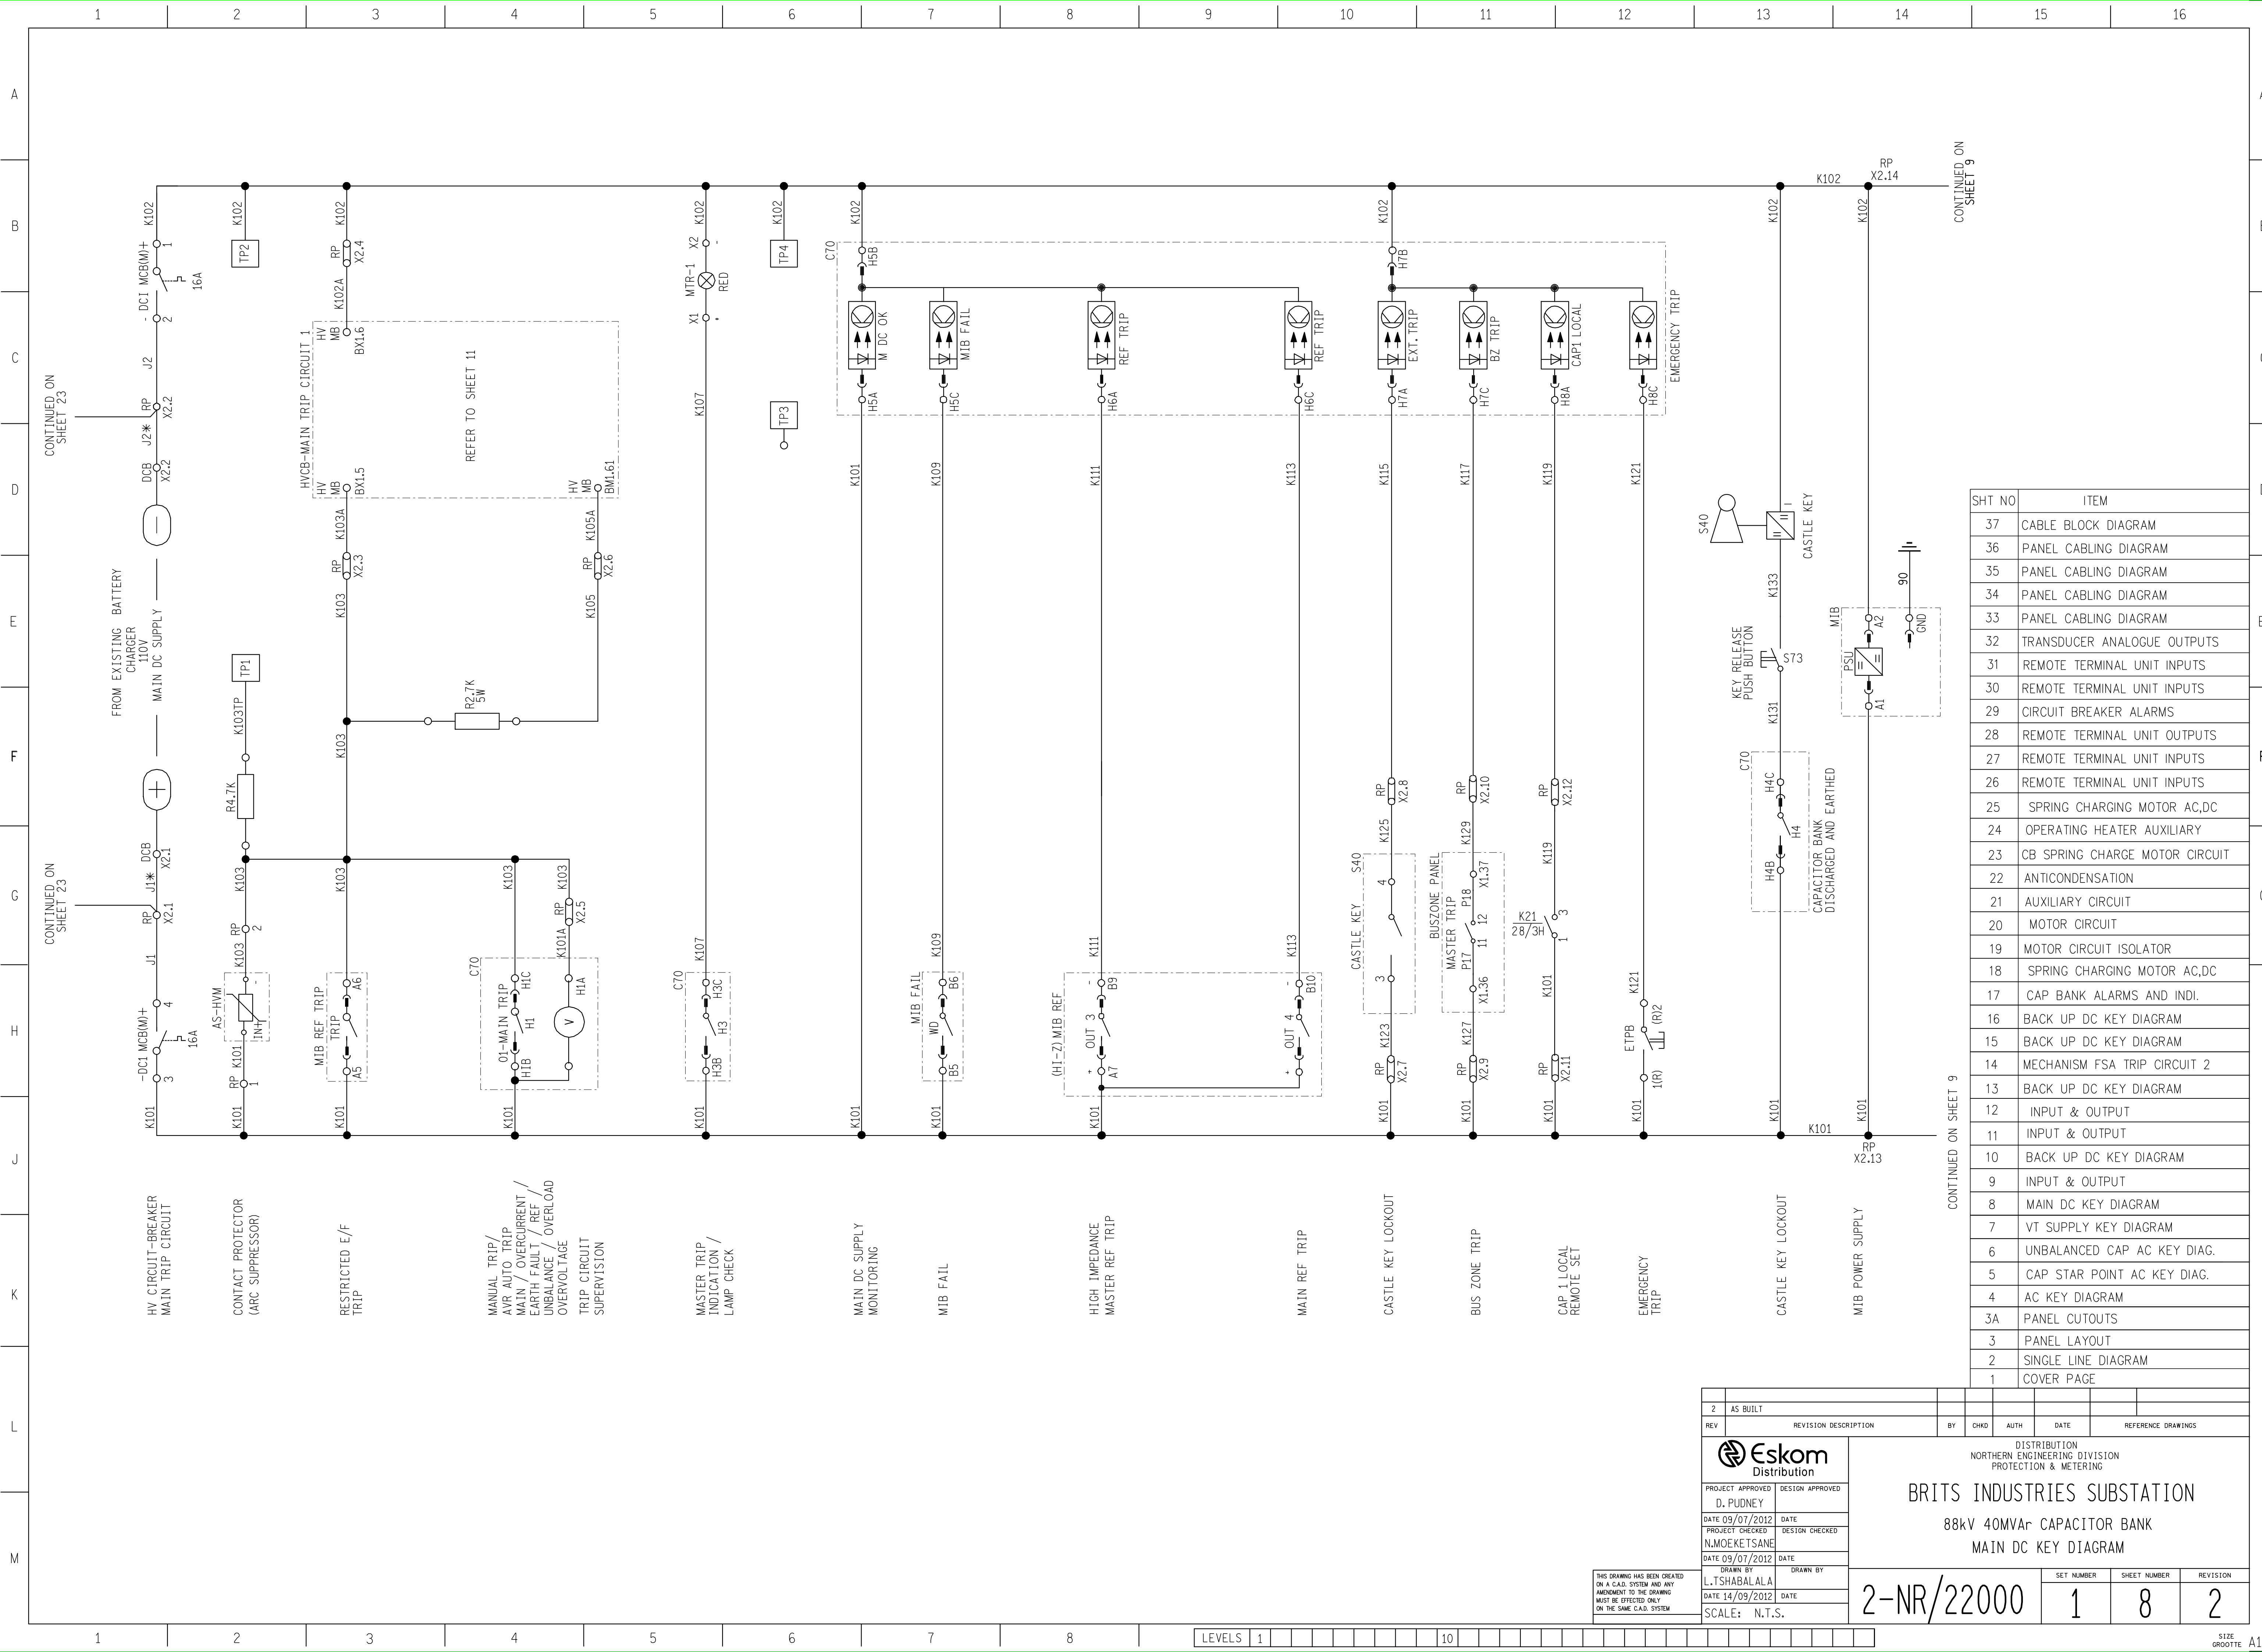

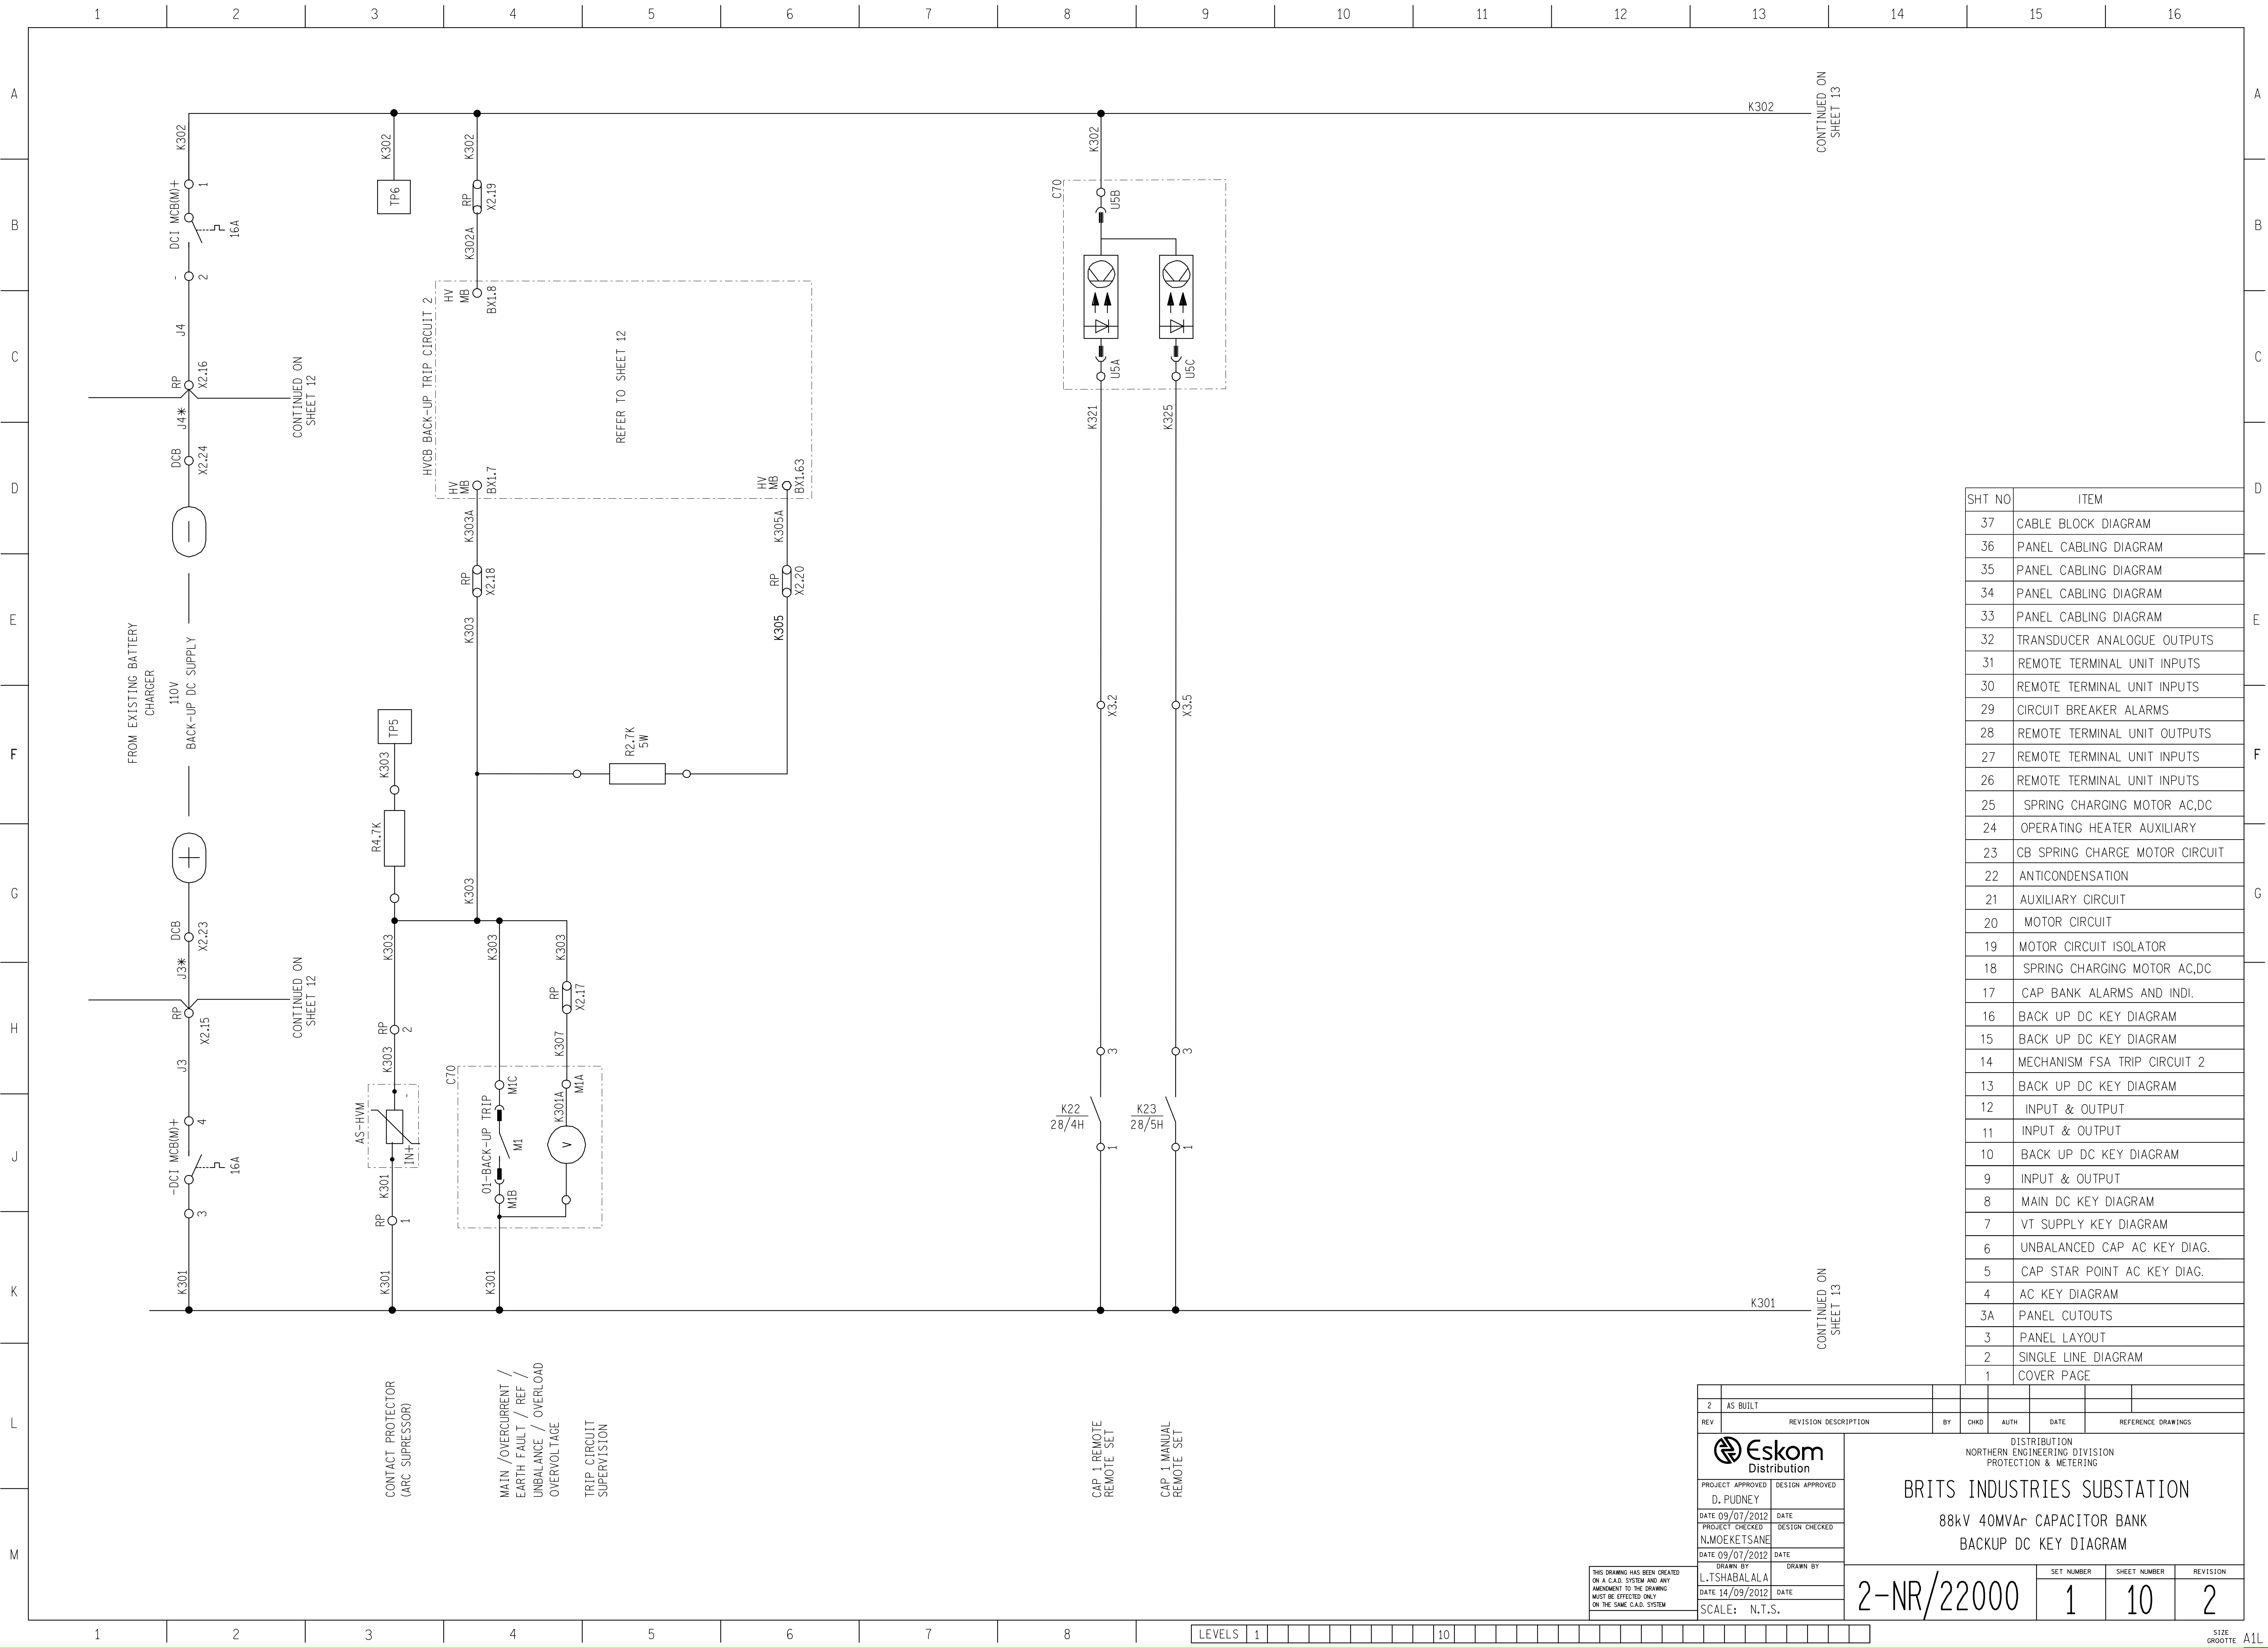


SHT NO	ITEM
37	CABLE BLOCK DIAGRAM
36	PANEL CABLING DIAGRAM
35	PANEL CABLING DIAGRAM
34	PANEL CABLING DIAGRAM
33	PANEL CABLING DIAGRAM
32	TRANSDUCER ANALOGUE OUTPUTS
31	REMOTE TERMINAL UNIT INPUTS
30	REMOTE TERMINAL UNIT INPUTS
29	CIRCUIT BREAKER ALARMS
28	REMOTE TERMINAL UNIT OUTPUTS
27	REMOTE TERMINAL UNIT INPUTS
26	REMOTE TERMINAL UNIT INPUTS
25	SPRING CHARGING MOTOR AC,DC
24	OPERATING HEATER AUXILIARY
23	CB SPRING CHARGE MOTOR CIRCUIT
22	ANTICONDENSATION
21	AUXILIARY CIRCUIT
20	MOTOR CIRCUIT
19	MOTOR CIRCUIT ISOLATOR
18	SPRING CHARGING MOTOR AC,DC
17	CAP BANK ALARMS AND INDI.
16	BACK UP DC KEY DIAGRAM
15	BACK UP DC KEY DIAGRAM
14	MECHANISM FSA TRIP CIRCUIT 2
13	BACK UP DC KEY DIAGRAM
12	INPUT & OUTPUT
11	INPUT & OUTPUT
10	BACK UP DC KEY DIAGRAM
9	INPUT & OUTPUT
8	MAIN DC KEY DIAGRAM
7	VT SUPPLY KEY DIAGRAM
6	UNBALANCED CAP AC KEY DIAG.
5	CAP STAR POINT AC KEY DIAG.
4	AC KEY DIAGRAM
3A	PANEL CUTOUPS
3	PANEL LAYOUT
2	SINGLE LINE DIAGRAM
1	COVER PAGE

2	AS BUILT										
REV	REVISION DESCRIPTION	BY	CHKD	AUTH	DATE	REFERENCE DRAWINGS					
		DISTRIBUTION NORTHERN ENGINEERING DIVISION PROTECTION & METERING BRITS INDUSTRIES SUBSTATION 88kV 40MVA_r CAPACITOR BANK BACKUP DC KEY DIAGRAM									
PROJECT APPROVED D. PUDNEY		DATE 09/07/2012		2-NR/22000					SET NUMBER 1	SHEET NUMBER 10	REVISION 2
PROJECT CHECKED N.MOEKE TSANE		DATE 09/07/2012									
DRAWN BY L.TSHABALALA		DATE 14/09/2012									
SCALE: N.T.S.											

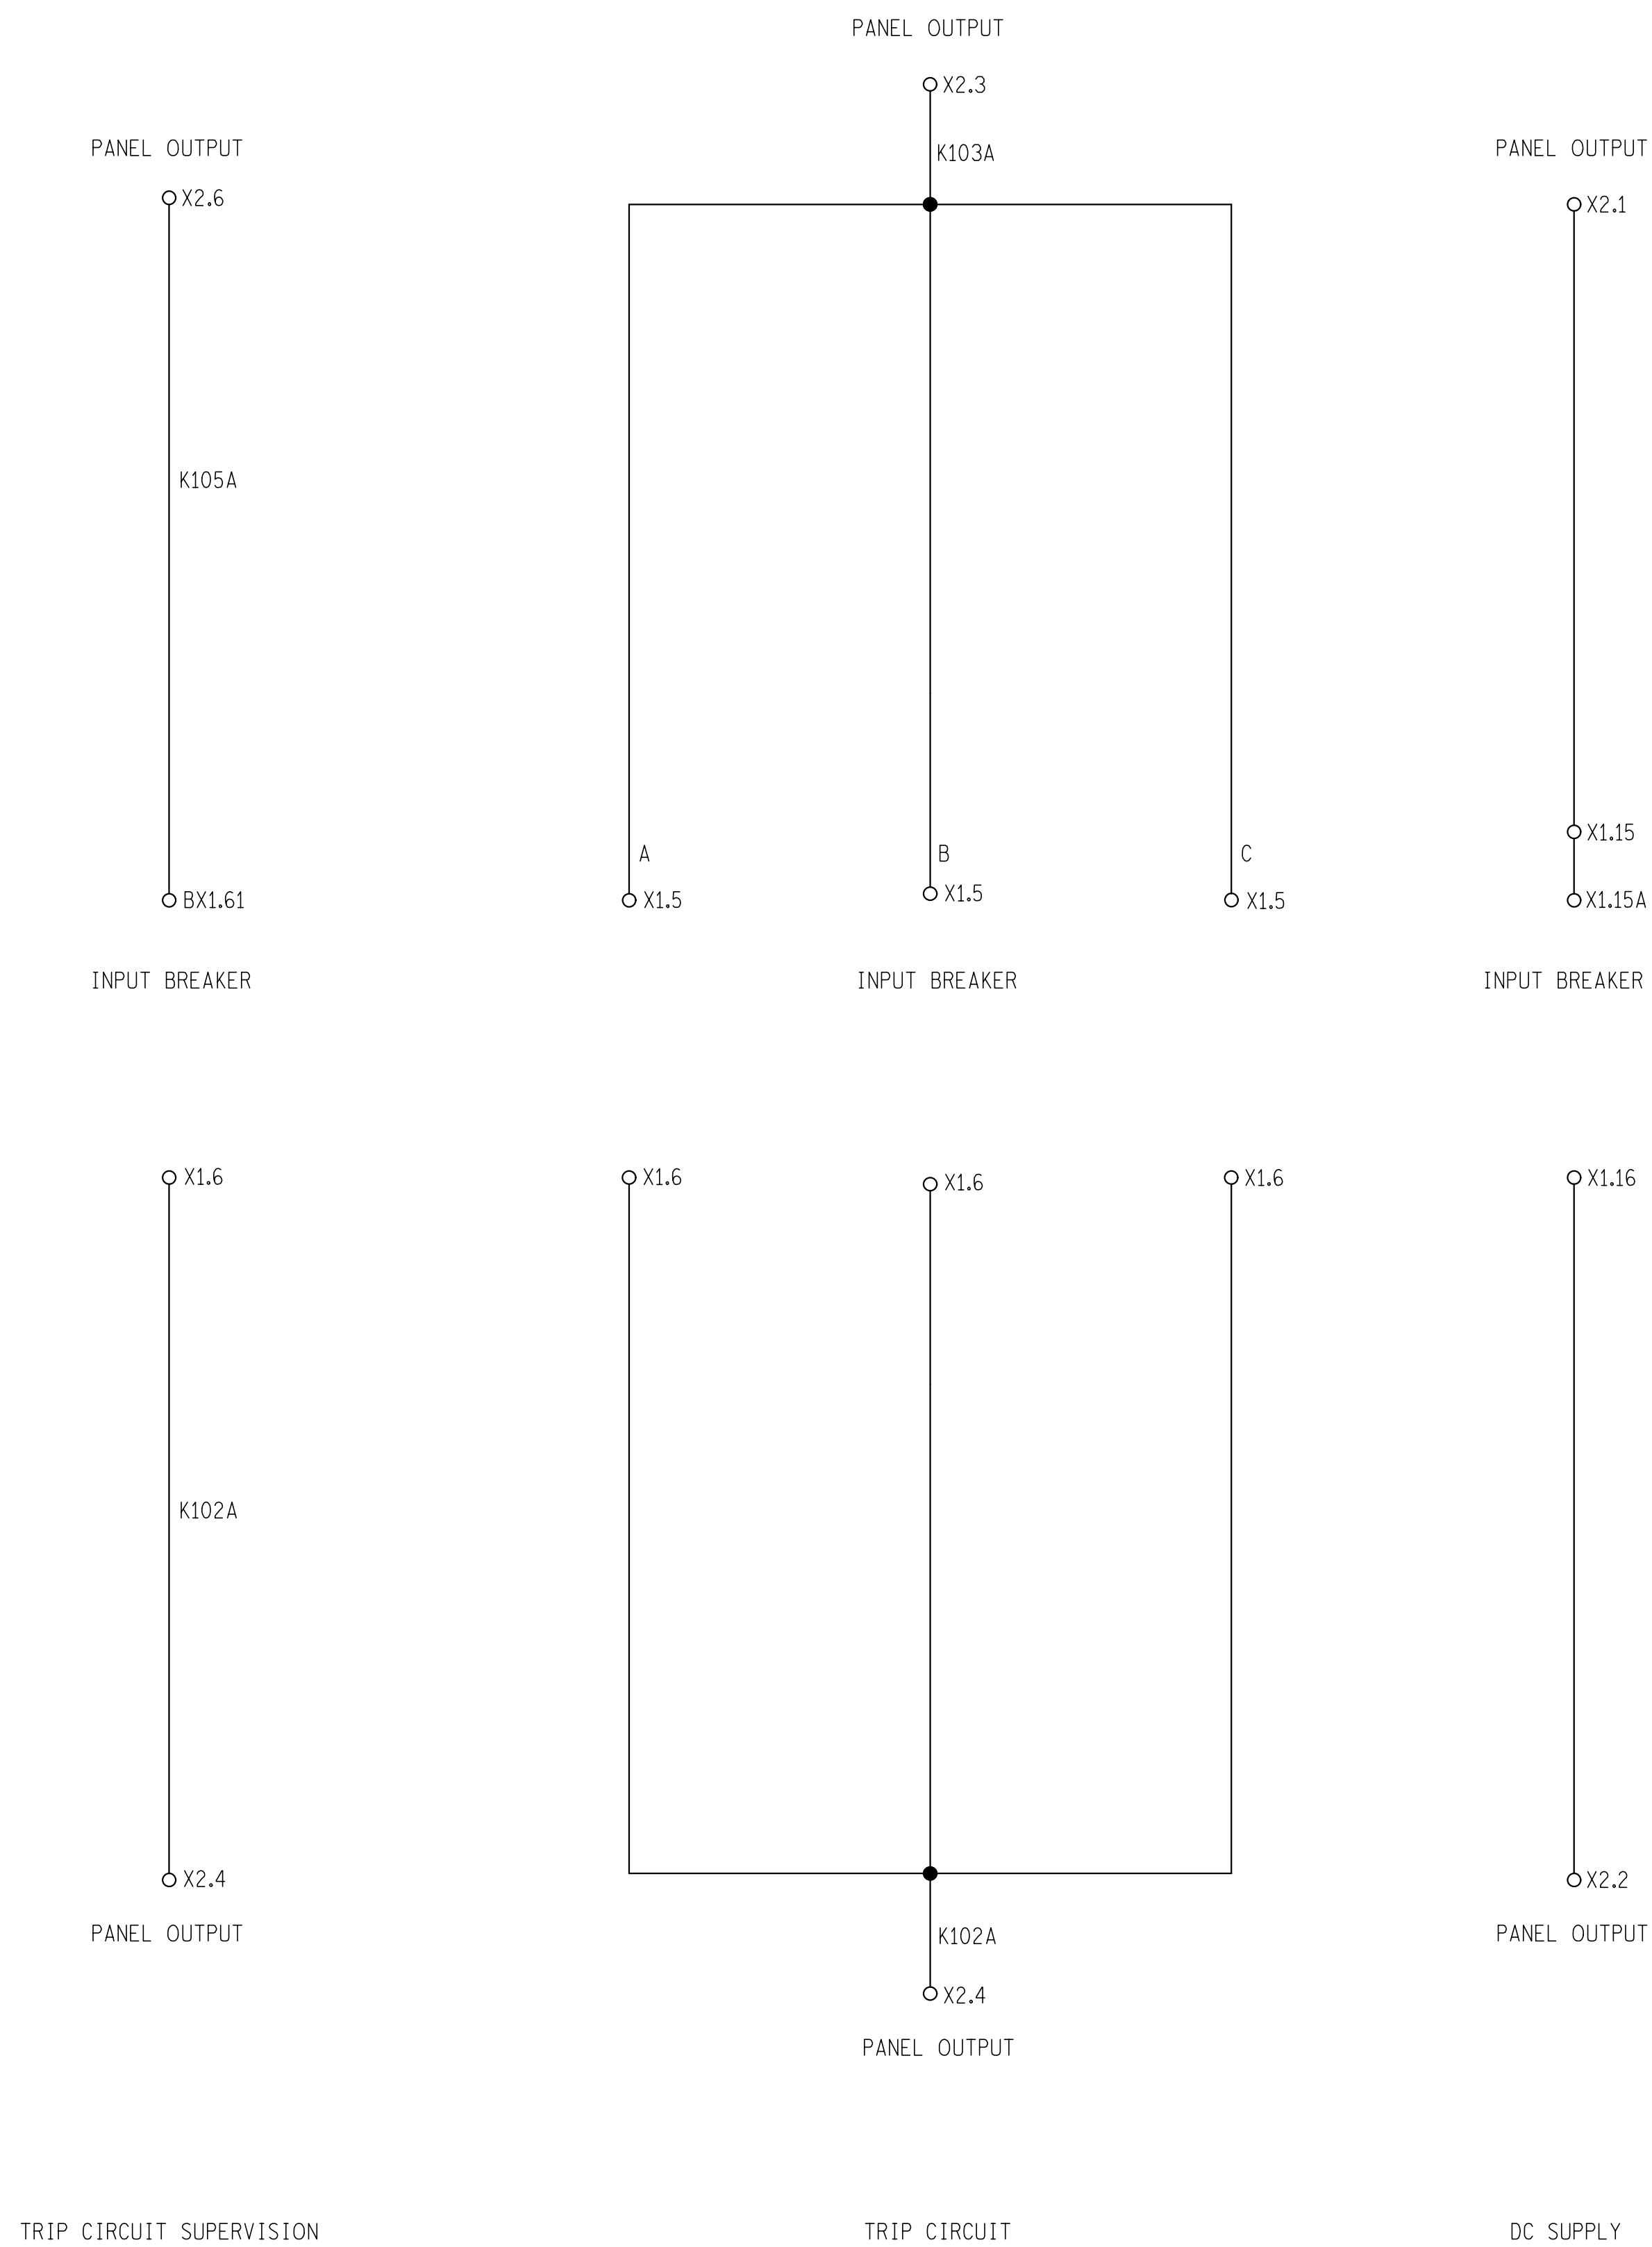



SHT NO	ITEM
37	CABLE BLOCK DIAGRAM
36	PANEL CABLING DIAGRAM
35	PANEL CABLING DIAGRAM
34	PANEL CABLING DIAGRAM
33	PANEL CABLING DIAGRAM
32	TRANSDUCER ANALOGUE OUTPUTS
31	REMOTE TERMINAL UNIT INPUTS
30	REMOTE TERMINAL UNIT INPUTS
29	CIRCUIT BREAKER ALARMS
28	REMOTE TERMINAL UNIT OUTPUTS
27	REMOTE TERMINAL UNIT INPUTS
26	REMOTE TERMINAL UNIT INPUTS
25	SPRING CHARGING MOTOR AC,DC
24	OPERATING HEATER AUXILIARY
23	CB SPRING CHARGE MOTOR CIRCUIT
22	ANTICONDENSATION
21	AUXILIARY CIRCUIT
20	MOTOR CIRCUIT
19	MOTOR CIRCUIT ISOLATOR
18	SPRING CHARGING MOTOR AC,DC
17	CAP BANK ALARMS AND INDI.
16	BACK UP DC KEY DIAGRAM
15	BACK UP DC KEY DIAGRAM
14	MECHANISM FSA TRIP CIRCUIT 2
13	BACK UP DC KEY DIAGRAM
12	INPUT & OUTPUT
11	INPUT & OUTPUT
10	BACK UP DC KEY DIAGRAM
9	INPUT & OUTPUT
8	MAIN DC KEY DIAGRAM
7	VT SUPPLY KEY DIAGRAM
6	UNBALANCED CAP AC KEY DIAG.
5	CAP STAR POINT AC KEY DIAG.
4	AC KEY DIAGRAM
3A	PANEL CUTOUPS
3	PANEL LAYOUT
2	SINGLE LINE DIAGRAM
1	COVER PAGE

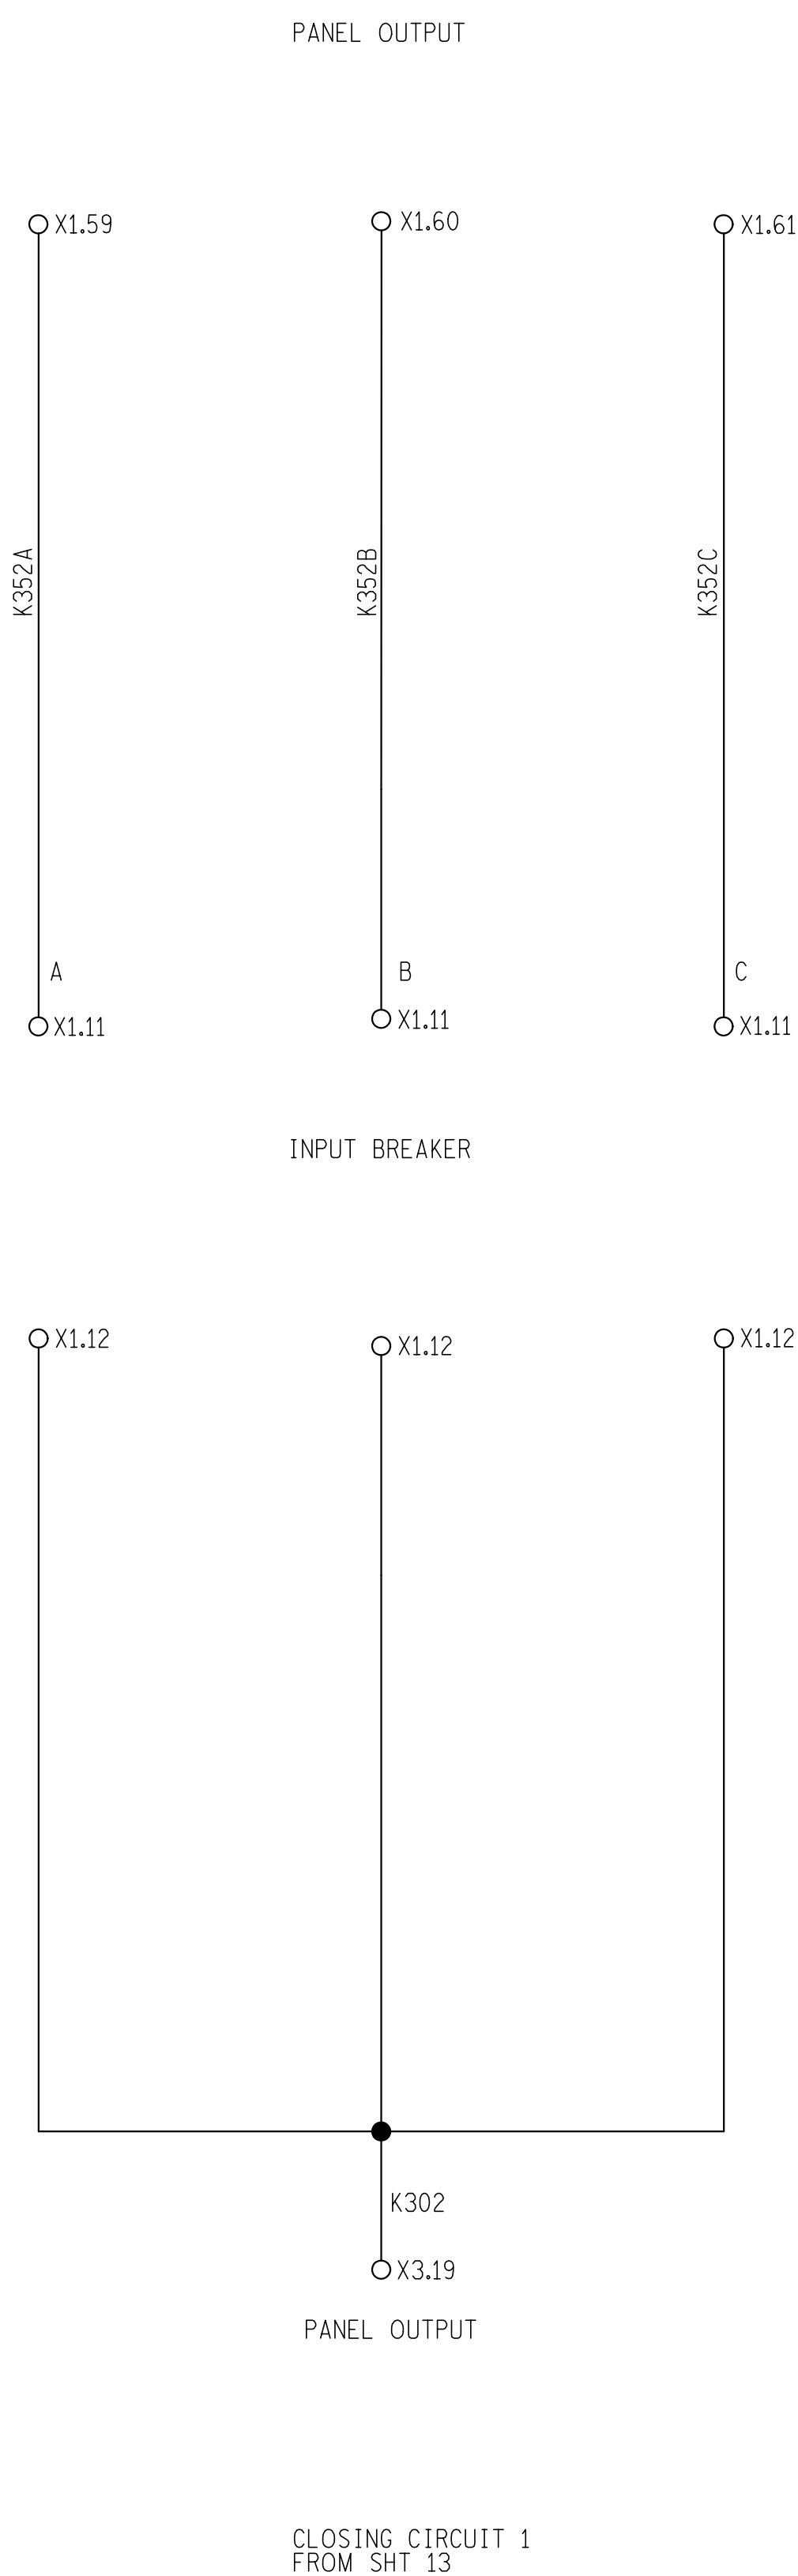


SHT NO	ITEM
37	CABLE BLOCK DIAGRAM
36	PANEL CABLING DIAGRAM
35	PANEL CABLING DIAGRAM
34	PANEL CABLING DIAGRAM
33	PANEL CABLING DIAGRAM
32	TRANSDUCER ANALOGUE OUTPUTS
31	REMOTE TERMINAL UNIT INPUTS
30	REMOTE TERMINAL UNIT INPUTS
29	CIRCUIT BREAKER ALARMS
28	REMOTE TERMINAL UNIT OUTPUTS
27	REMOTE TERMINAL UNIT INPUTS
26	REMOTE TERMINAL UNIT INPUTS
25	SPRING CHARGING MOTOR AC,DC
24	OPERATING HEATER AUXILIARY
23	CB SPRING CHARGE MOTOR CIRCUIT
22	ANTICONDENSATION
21	AUXILIARY CIRCUIT
20	MOTOR CIRCUIT
19	MOTOR CIRCUIT ISOLATOR
18	SPRING CHARGING MOTOR AC,DC
17	CAP BANK ALARMS AND INDI.
16	BACK UP DC KEY DIAGRAM
15	BACK UP DC KEY DIAGRAM
14	MECHANISM FSA TRIP CIRCUIT 2
13	BACK UP DC KEY DIAGRAM
12	INPUT & OUTPUT
11	INPUT & OUTPUT
10	BACK UP DC KEY DIAGRAM
9	INPUT & OUTPUT
8	MAIN DC KEY DIAGRAM
7	VT SUPPLY KEY DIAGRAM
6	UNBALANCED CAP AC KEY DIAG.
5	CAP STAR POINT AC KEY DIAG.
4	AC KEY DIAGRAM
3A	PANEL CUTOUPS
3	PANEL LAYOUT
2	SINGLE LINE DIAGRAM
1	COVER PAGE

2	AS BUILT						
REV	REVISION DESCRIPTION	BY	CHKD	AUTH	DATE	REFERENCE DRAWINGS	
		DISTRIBUTION NORTHERN ENGINEERING DIVISION PROTECTION & METERING					
PROJECT APPROVED		BRITS INDUSTRIES SUBSTATION 88kV 40MVAR CAPACITOR BANK MECHANISM FSA TRIP CIRCUIT 2					
D. PUDNEY							
DATE 09/07/2012	DATE						
PROJECT CHECKED							
N.MOKEITSANE							
DATE 09/07/2012	DATE						
DRAWN BY		SET NUMBER		SHEET NUMBER		REVISION	
L.TSHABALALA		2-NR/22000		1		14	
DATE 14/09/2012							
SCALE: N.T.S.						2	

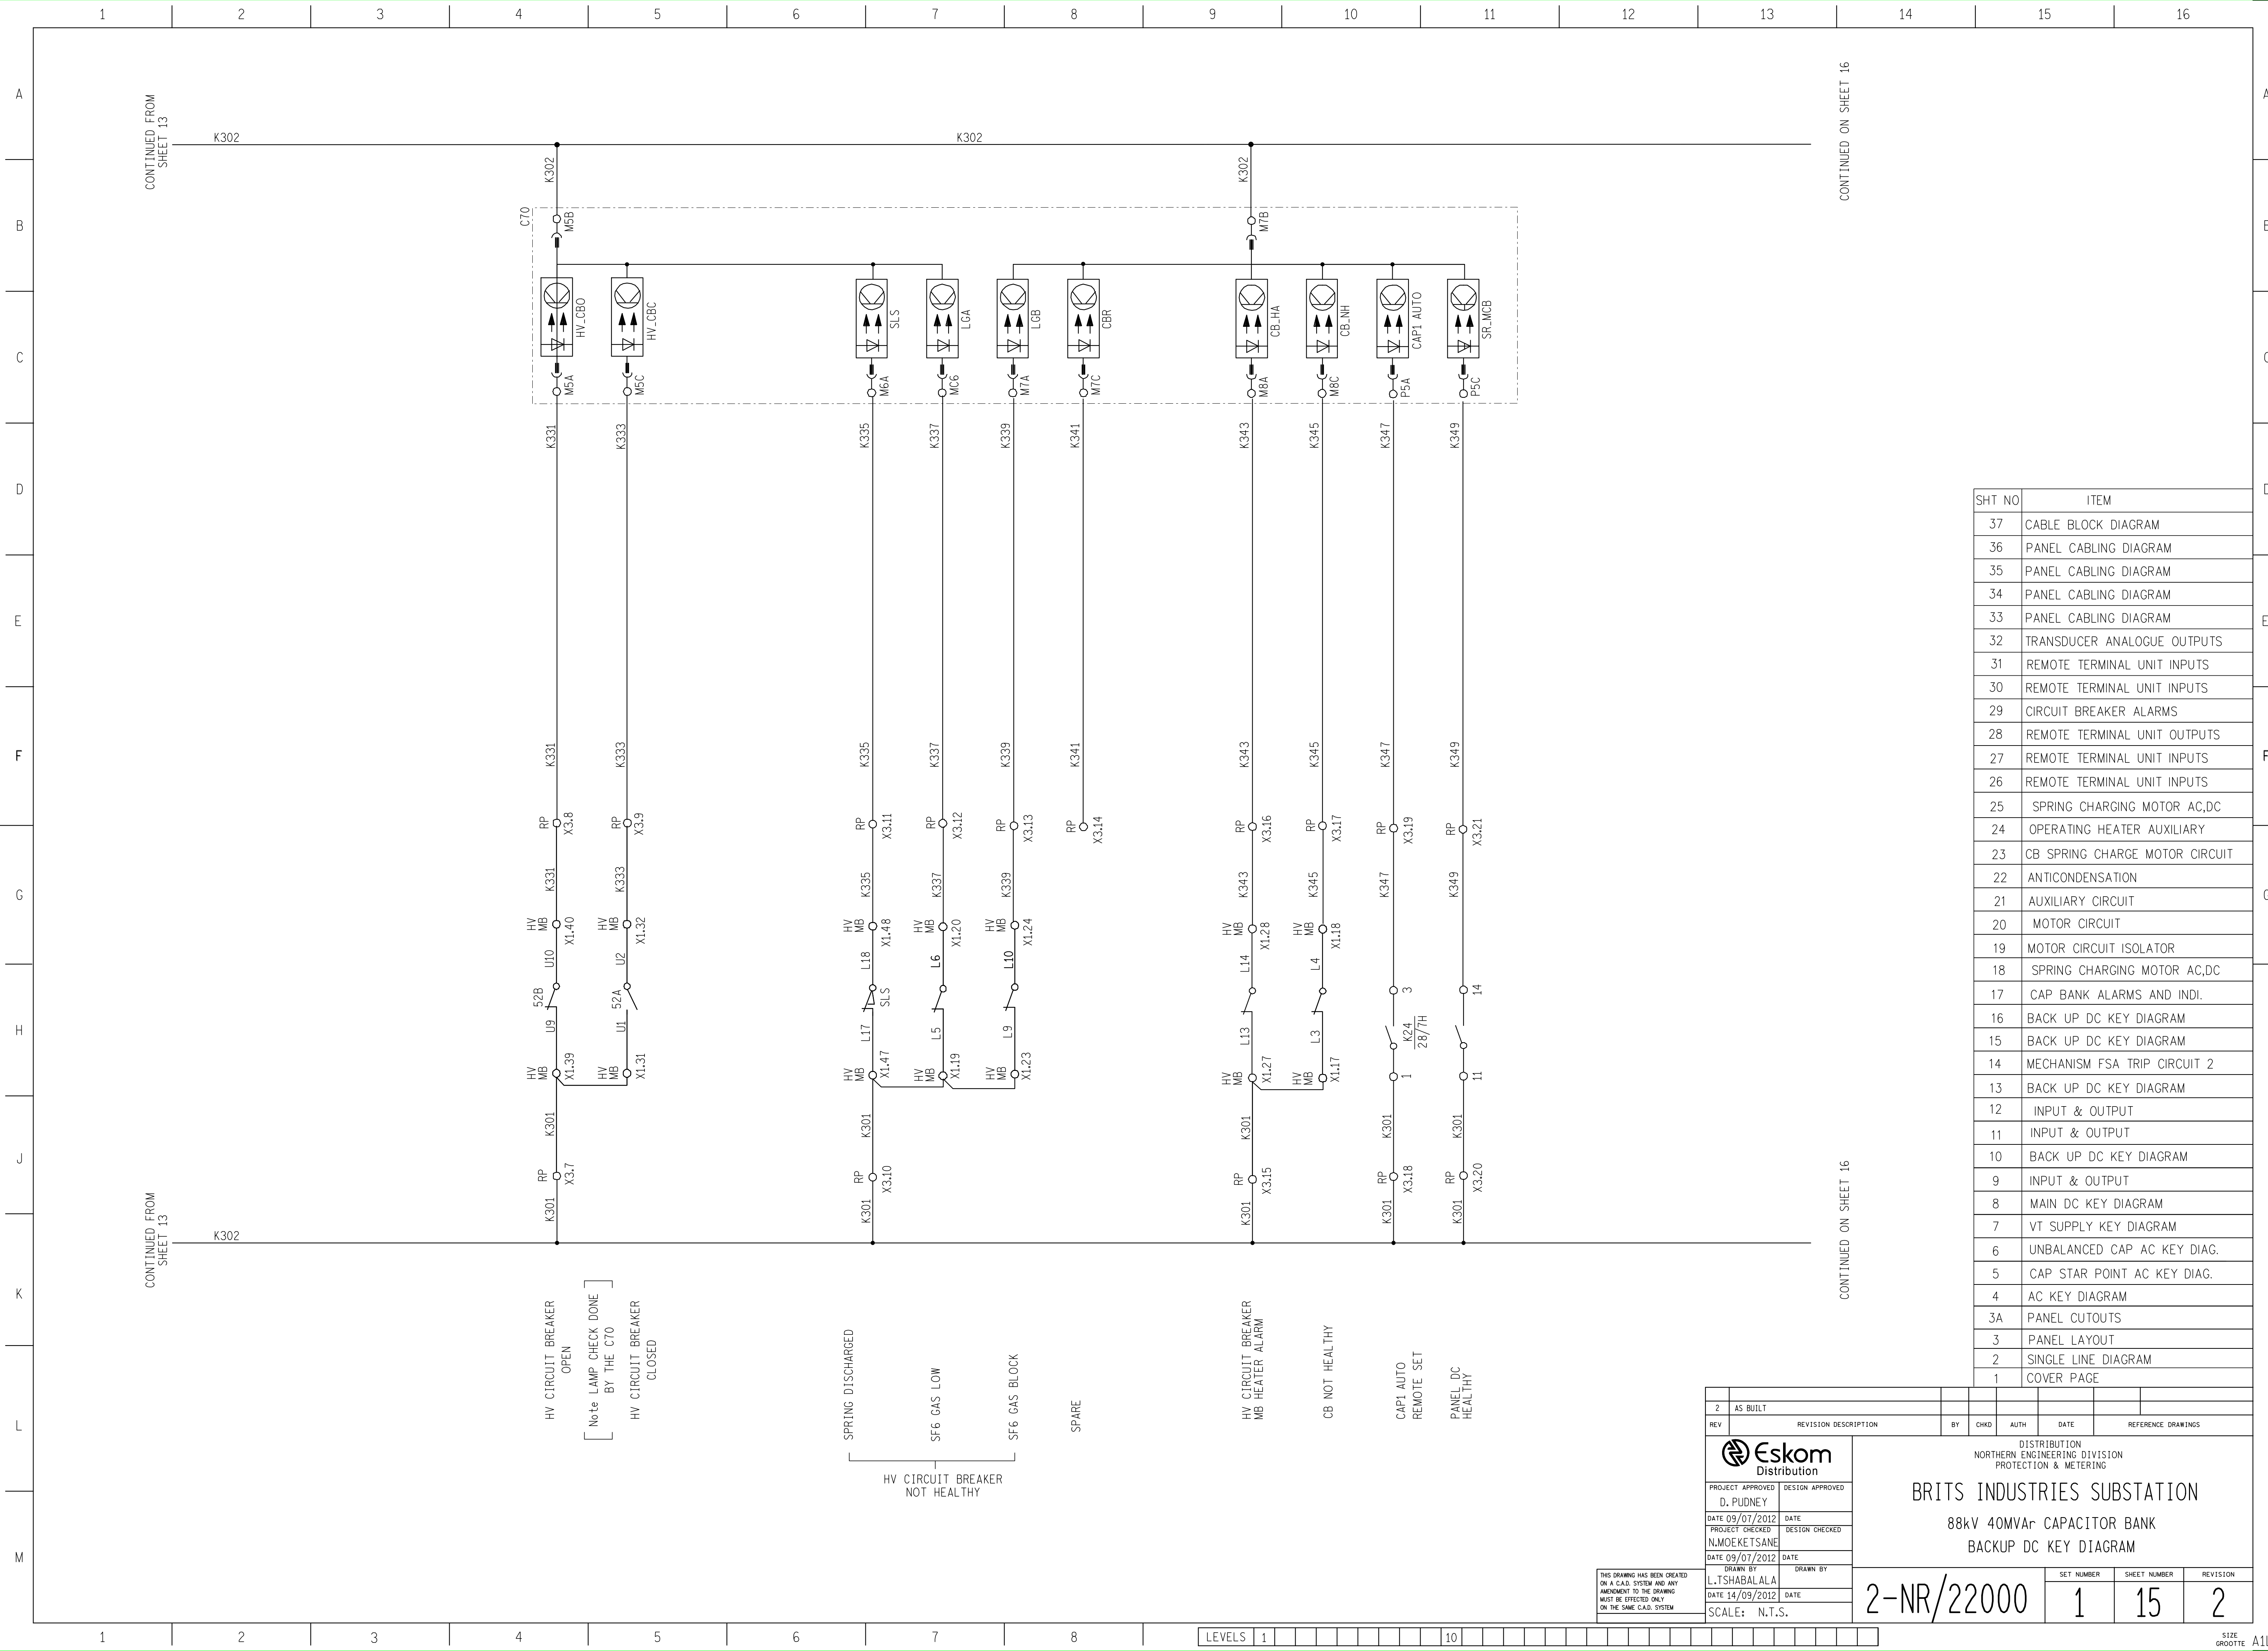

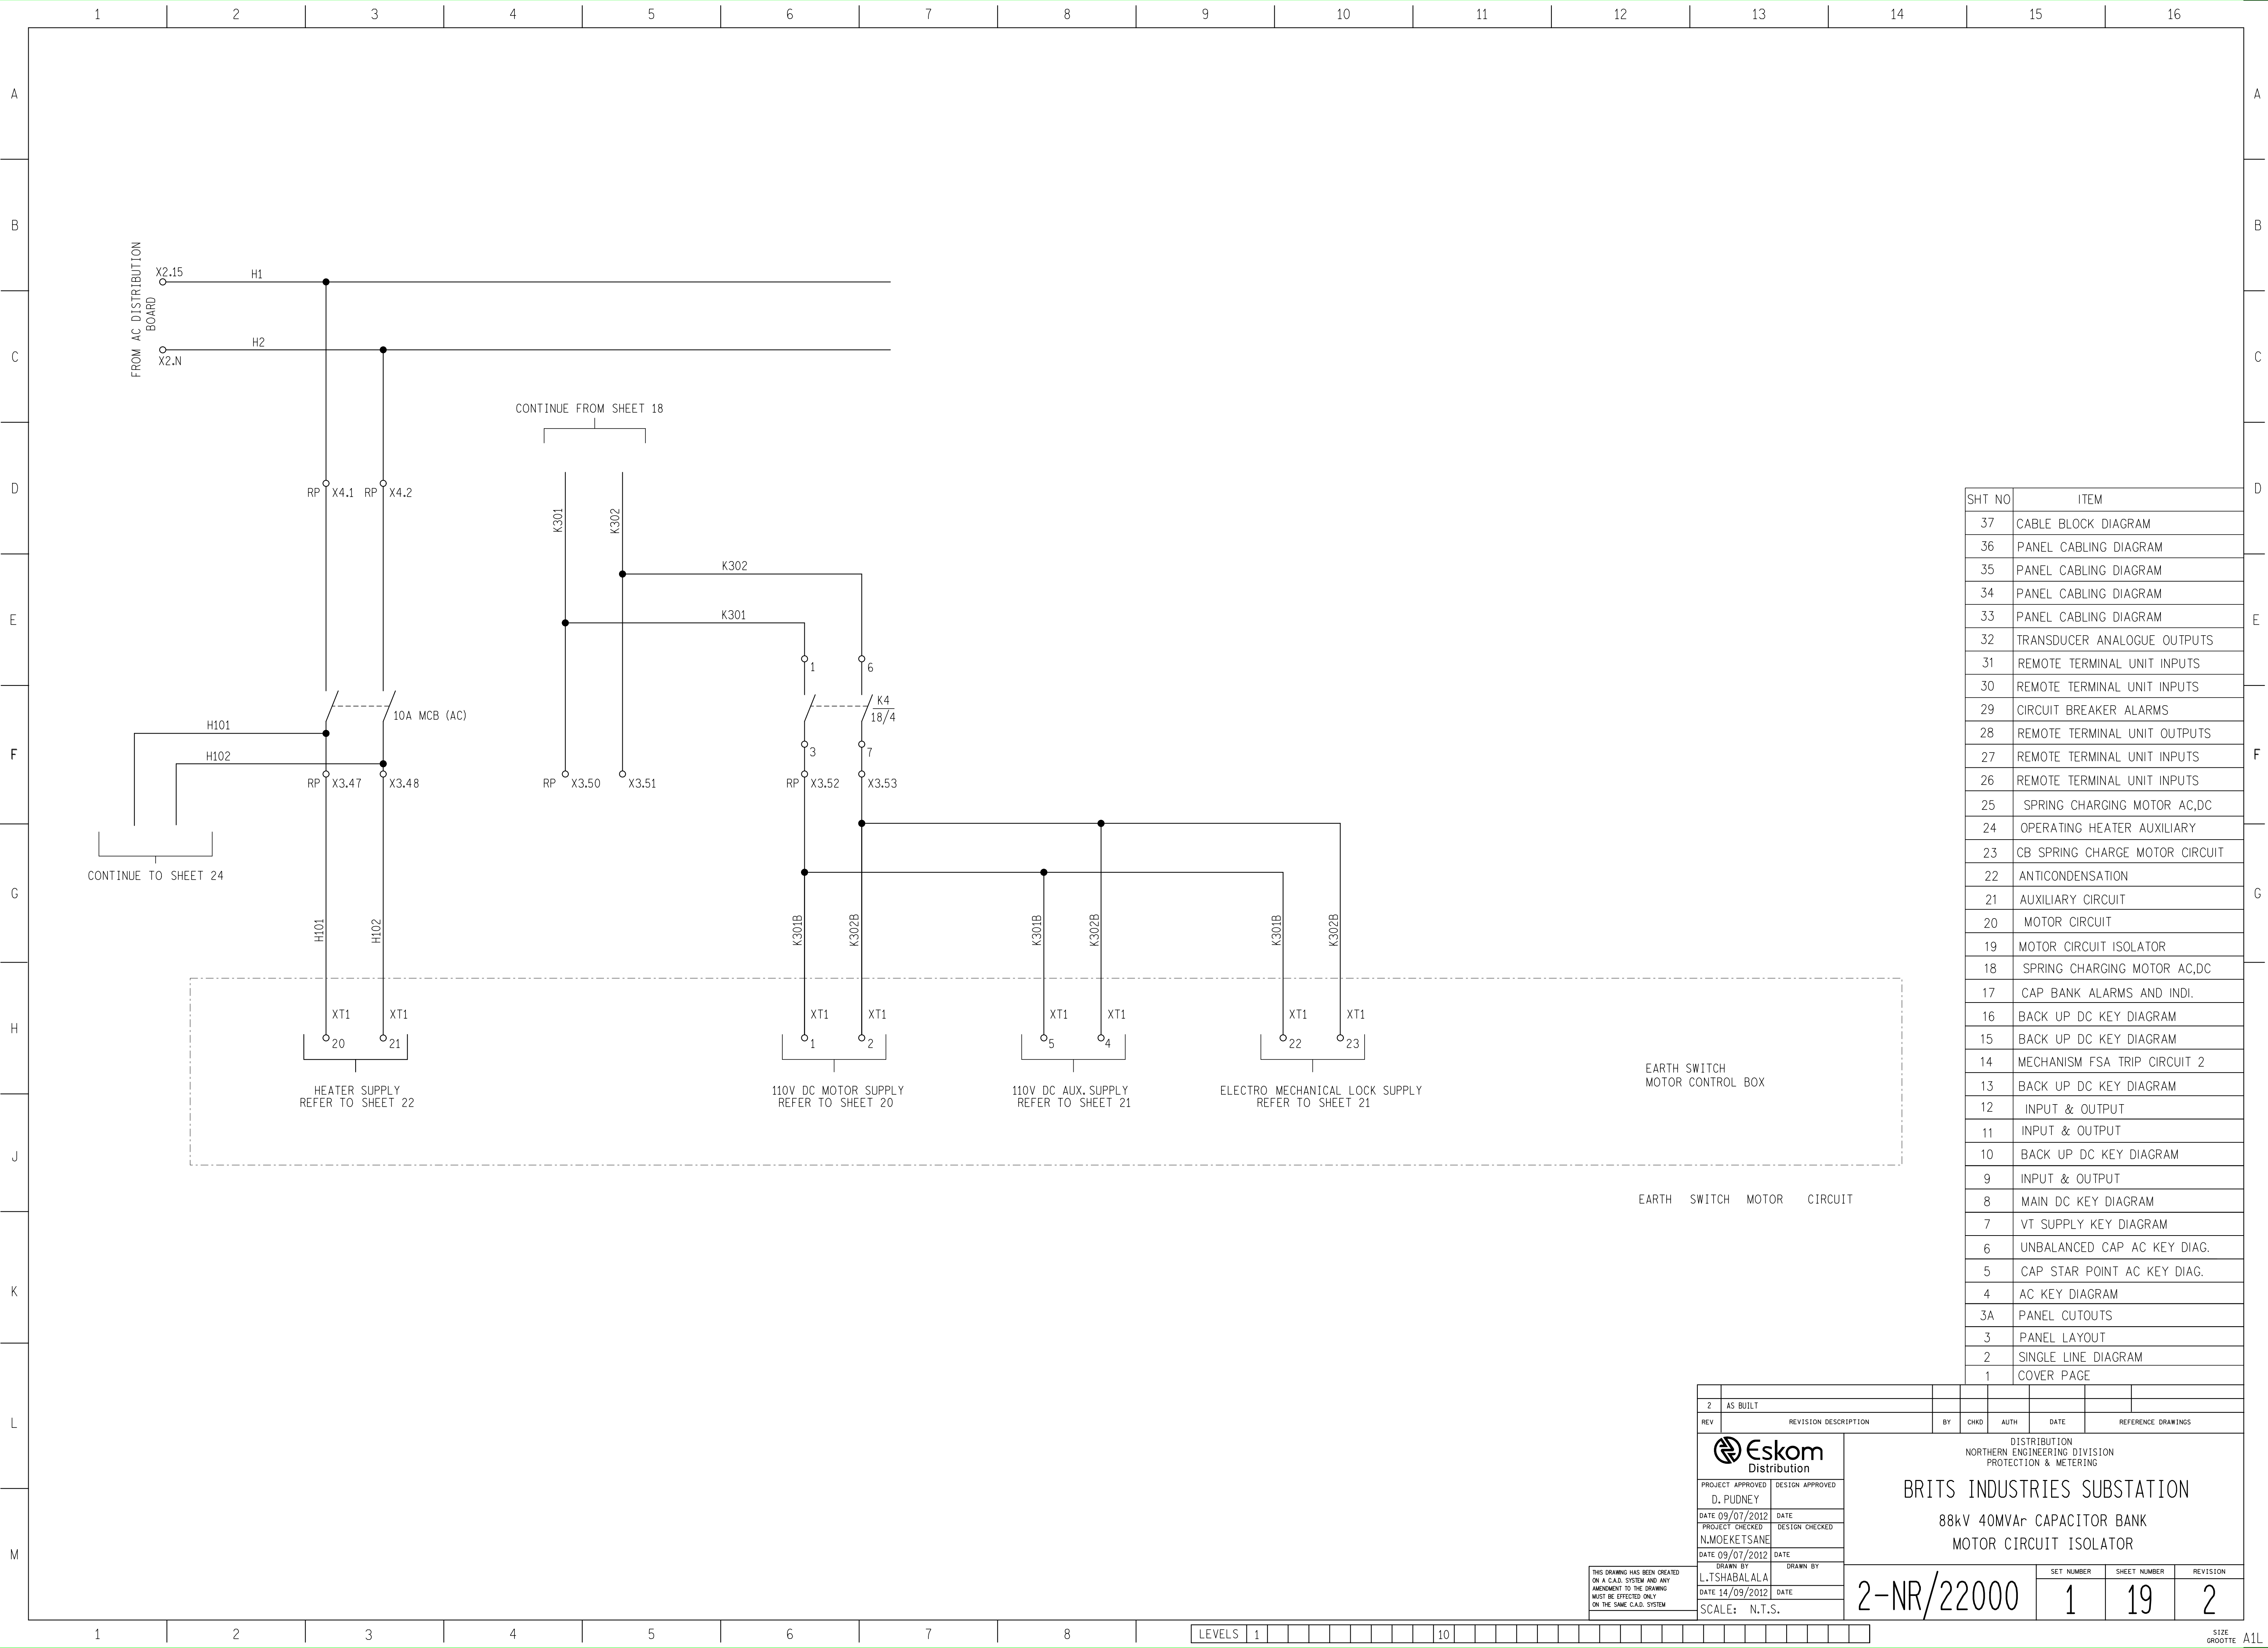

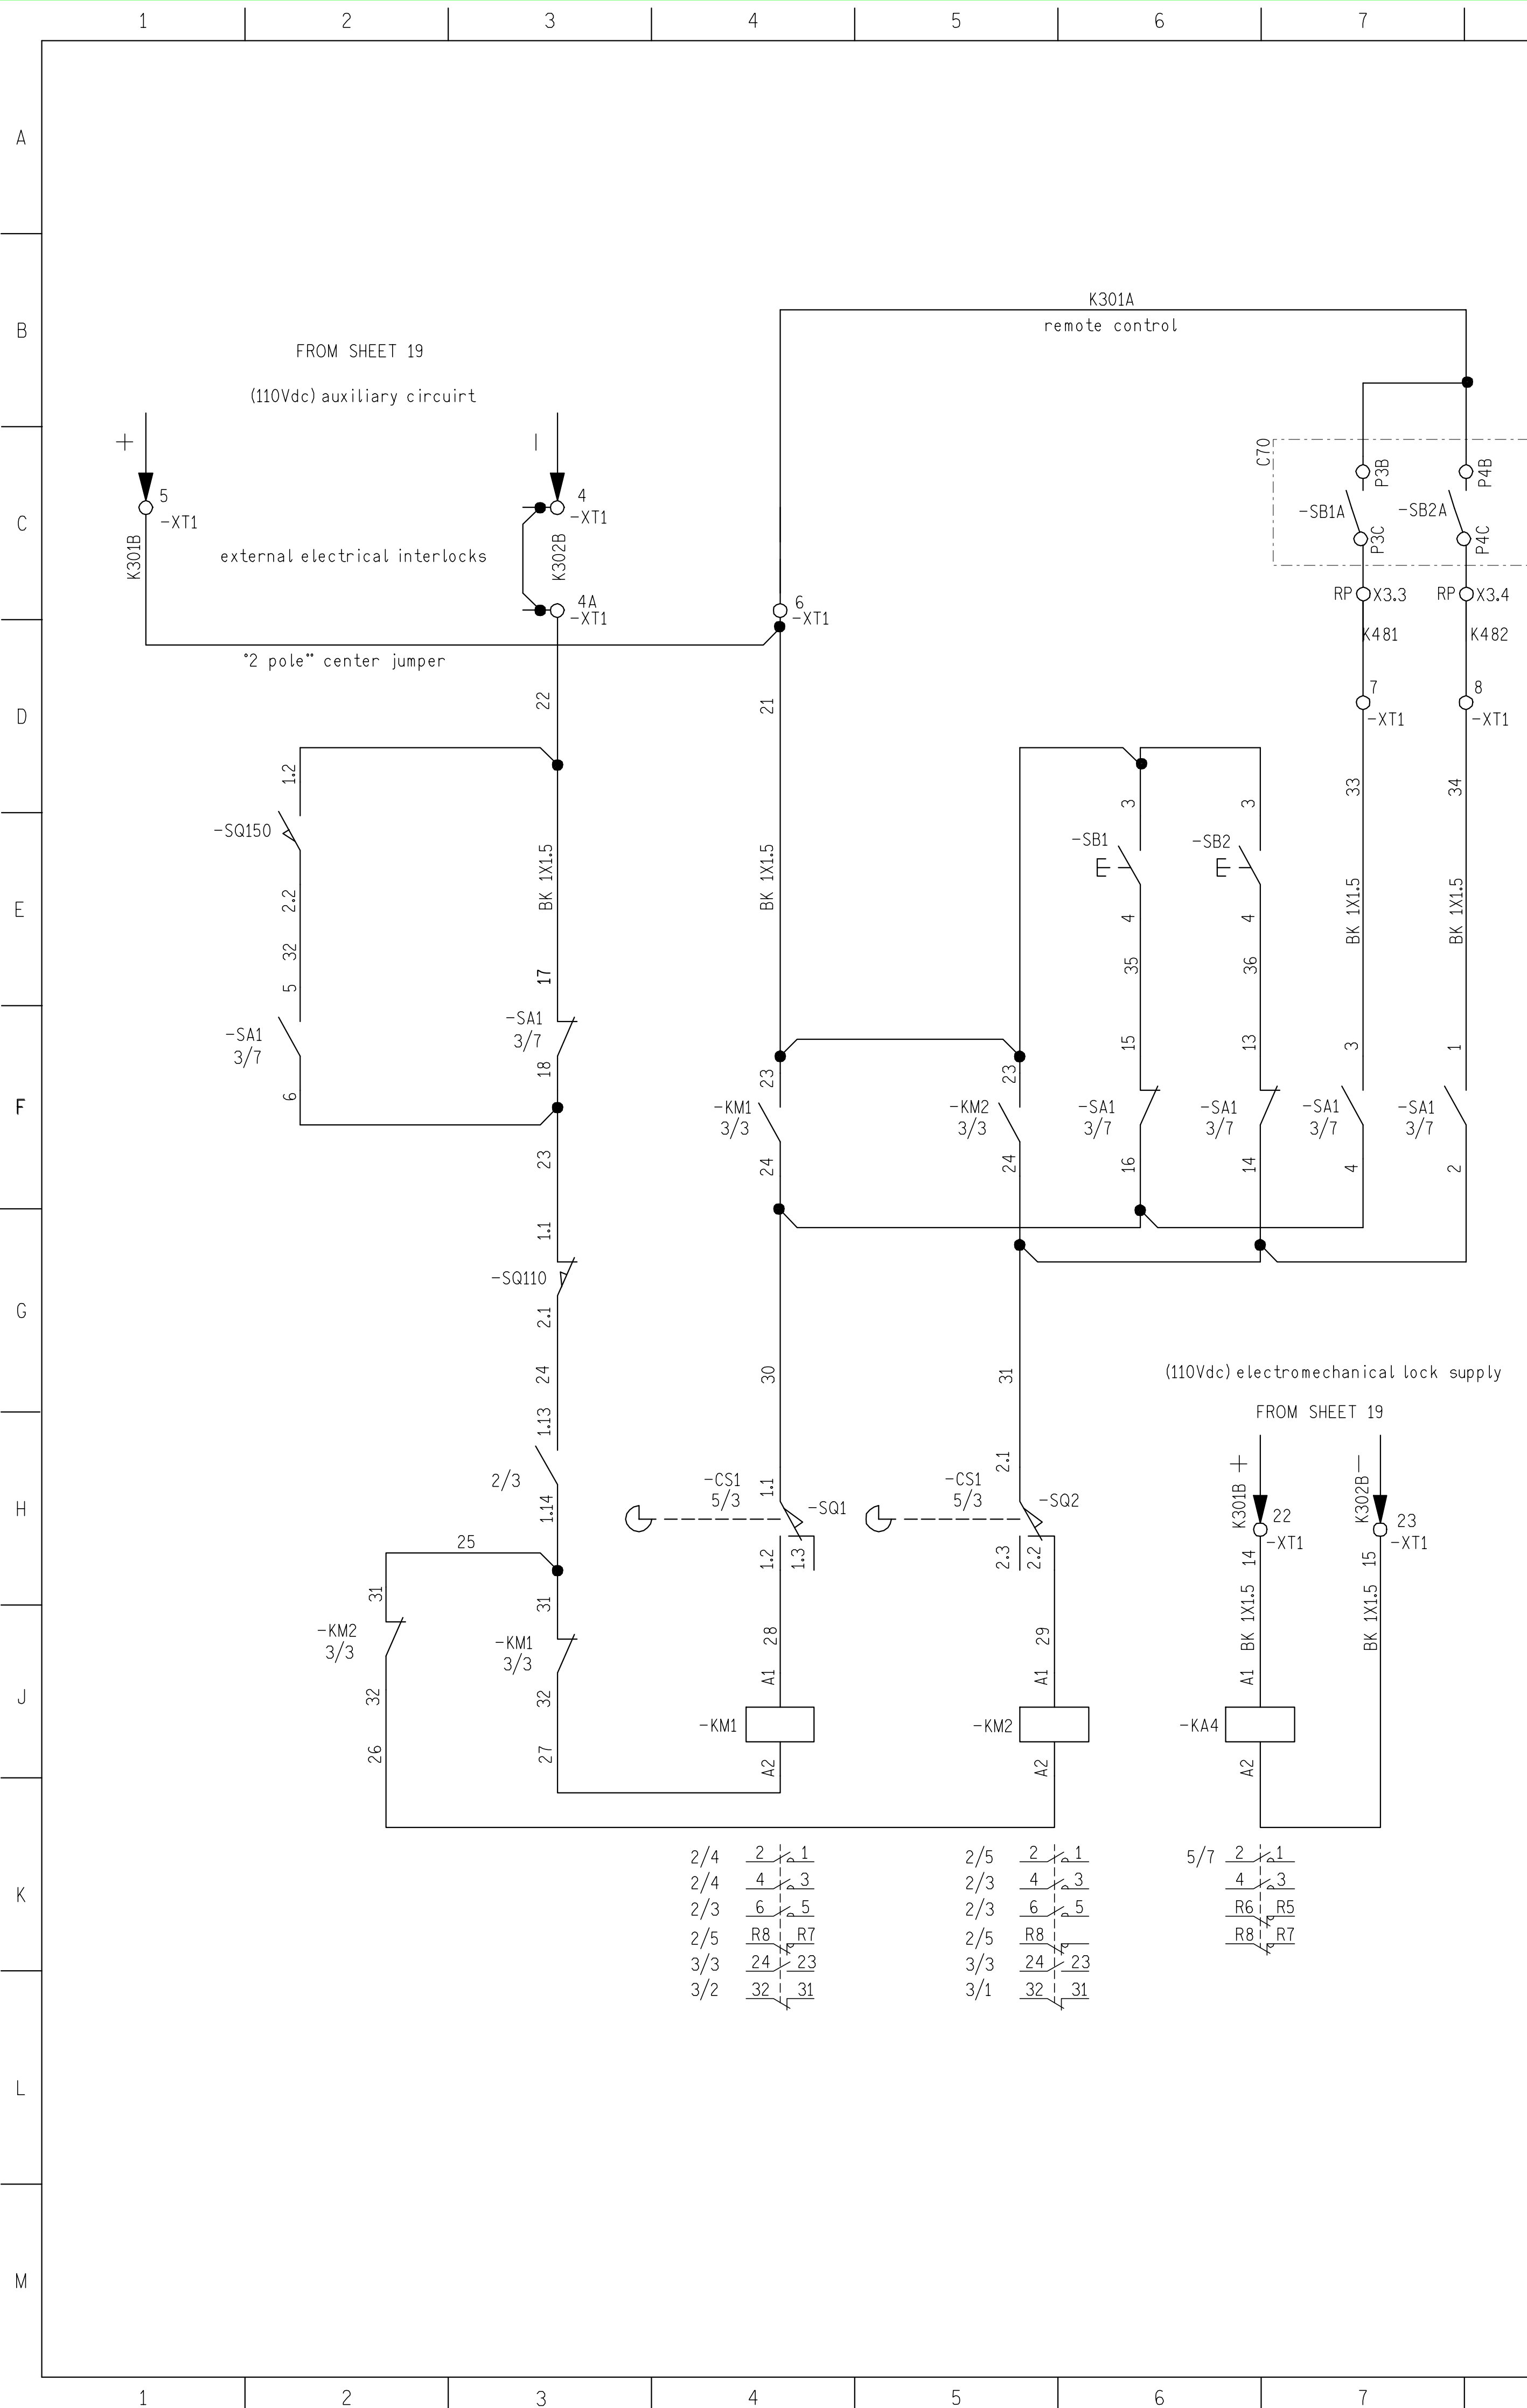



Item	Type	Description	Manufacture
–KA4	see description [NTC–2500]	electromechanical lock	ALSTOM grid
–KM1	100–K05 300	opening contactor	ALLEN BRADLEY
–KM2	100–K05 300	closing contactor	ALLEN BRADLEY
–SA1	P0120526S	[LOC–OFF–REM] selector switch	GIOVENZANA
–SB1	PPRN8NL/0	opening push button [BLACK/0]	MOELLER
–SB2	PPRN5NL/1	closing push button [WHITE/1]	MOELLER
–SQ1	Z15GW22–B	opening motor limit switch	OMRON
–SQ2	Z15GW22–B	closing motor limit switch	OMRON
–SQ110	see description [NTC–2500]	limit switch to prevent motor operation during manual operation	ALSTOM grid
–SQ150	1117.0101	external door limit switch	MARQUARDT
–XT1	WDU 10 SL	terminal blocks [10mm ²]	WEIDMULLER

SHT NO	ITEM
37	CABLE BLOCK DIAGRAM
36	PANEL CABLING DIAGRAM
35	PANEL CABLING DIAGRAM
34	PANEL CABLING DIAGRAM
33	PANEL CABLING DIAGRAM
32	TRANSDUCER ANALOGUE OUTPUTS
31	REMOTE TERMINAL UNIT INPUTS
30	REMOTE TERMINAL UNIT INPUTS
29	CIRCUIT BREAKER ALARMS
28	REMOTE TERMINAL UNIT OUTPUTS
27	REMOTE TERMINAL UNIT INPUTS
26	REMOTE TERMINAL UNIT INPUTS
25	SPRING CHARGING MOTOR AC,DC
24	OPERATING HEATER AUXILIARY
23	CB SPRING CHARGE MOTOR CIRCUIT
22	ANTICONDENSATION
21	AUXILIARY CIRCUIT
20	MOTOR CIRCUIT
19	MOTOR CIRCUIT ISOLATOR
18	SPRING CHARGING MOTOR AC,DC
17	CAP BANK ALARMS AND INDI.
16	BACK UP DC KEY DIAGRAM
15	BACK UP DC KEY DIAGRAM
14	MECHANISM FSA TRIP CIRCUIT 2
13	BACK UP DC KEY DIAGRAM
12	INPUT & OUTPUT
11	INPUT & OUTPUT
10	BACK UP DC KEY DIAGRAM
9	INPUT & OUTPUT
8	MAIN DC KEY DIAGRAM
7	VT SUPPLY KEY DIAGRAM
6	UNBALANCED CAP AC KEY DIAG.
5	CAP STAR POINT AC KEY DIAG.
4	AC KEY DIAGRAM
3A	PANEL CUTOUPS
3	PANEL LAYOUT
2	SINGLE LINE DIAGRAM
1	COVER PAGE


		1-2	REMOTE	OFF	LOCAL
5	19-20				X
	17/18				X
4	15/16				X
	13/14				X
3	11/12			X	
	9-10			X	
2	7-8			X	
	5/6	X			
1	3-4	X			
	1-2	X			
WATER	CONTACT	1	0	2	
		POSITION			


2	AS BUILT						
REV	REVISION DESCRIPTION	BY	CHKD	AUTH	DATE	REFERENCE DRAWINGS	
		DISTRIBUTION NORTHERN ENGINEERING DIVISION PROTECTION & METERING					
PROJECT APPROVED D. PUDNEY		BRITS INDUSTRIES SUBSTATION					
DATE 09/07/2012		88kv 40MVAR CAPACITOR BANK					
PROJECT CHECKED N.MOEKETSANE		AUXILIARY CIRCUIT					
DATE 09/07/2012							
DRAWN BY L.TSHABALALA		2-NR/22000				SET NUMBER 1	SHEET NUMBER 21
DATE 14/09/2012						REVISION 2	
SCALE: N.T.S.							

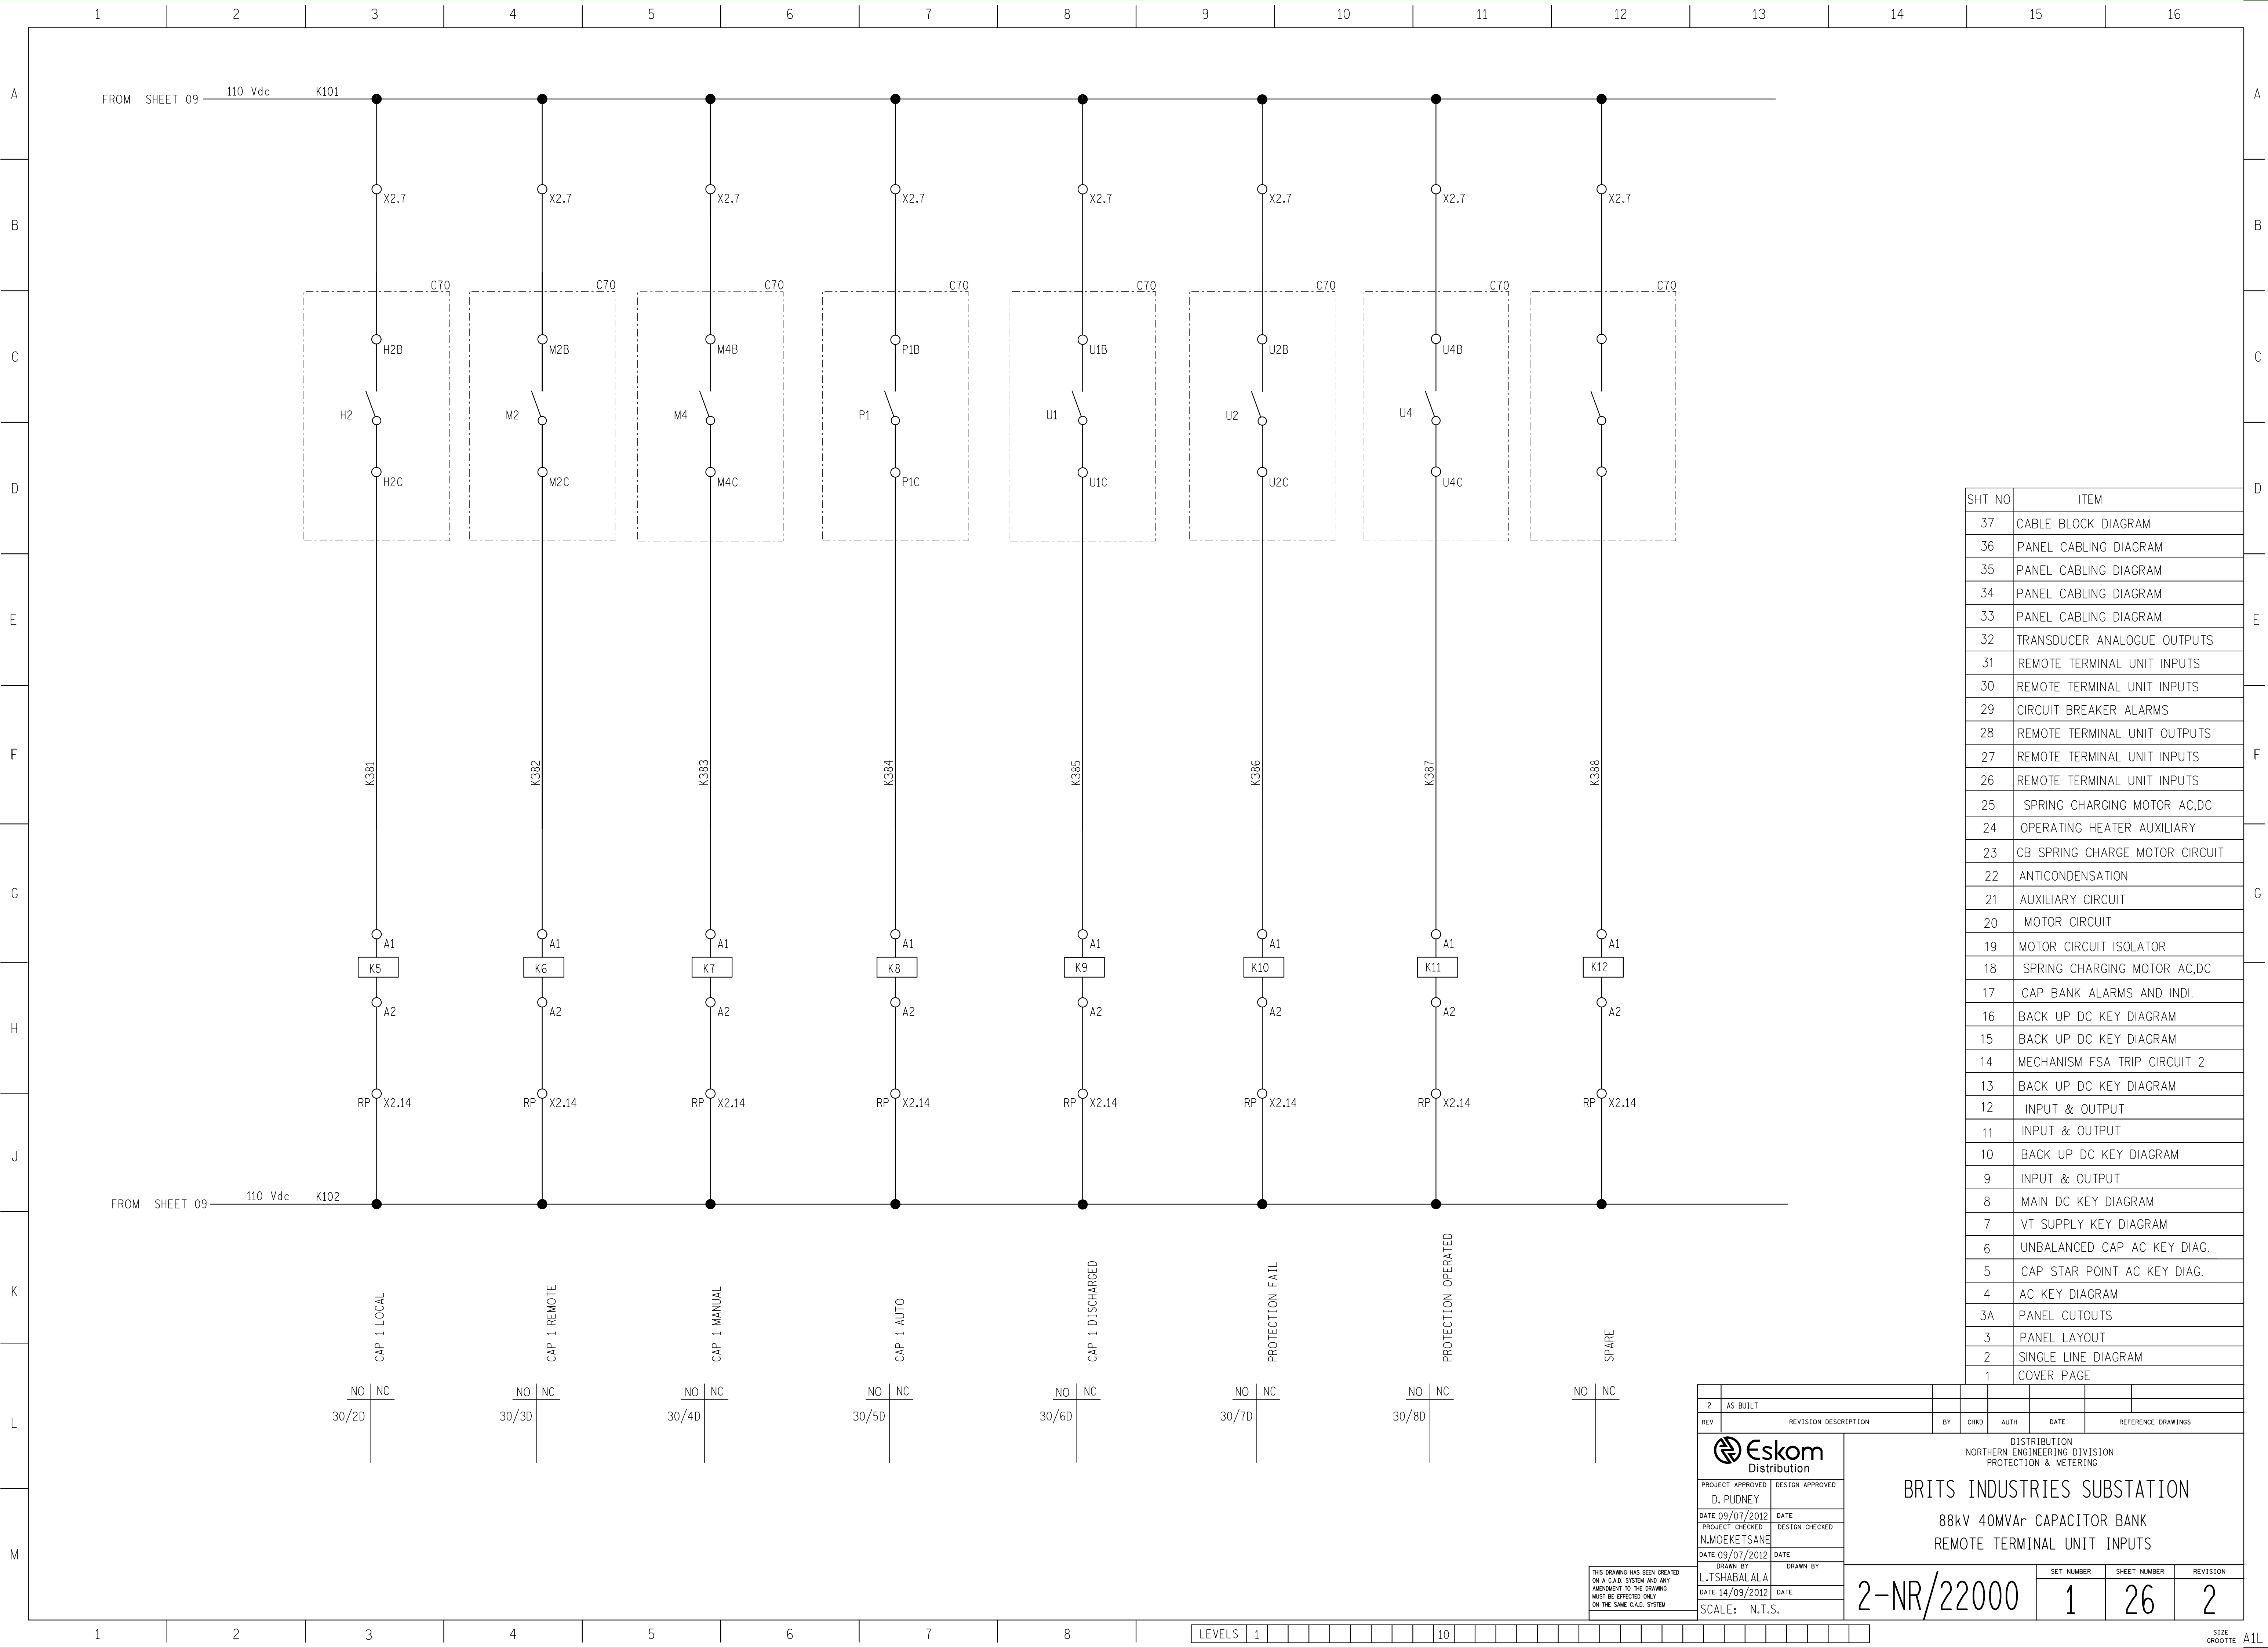

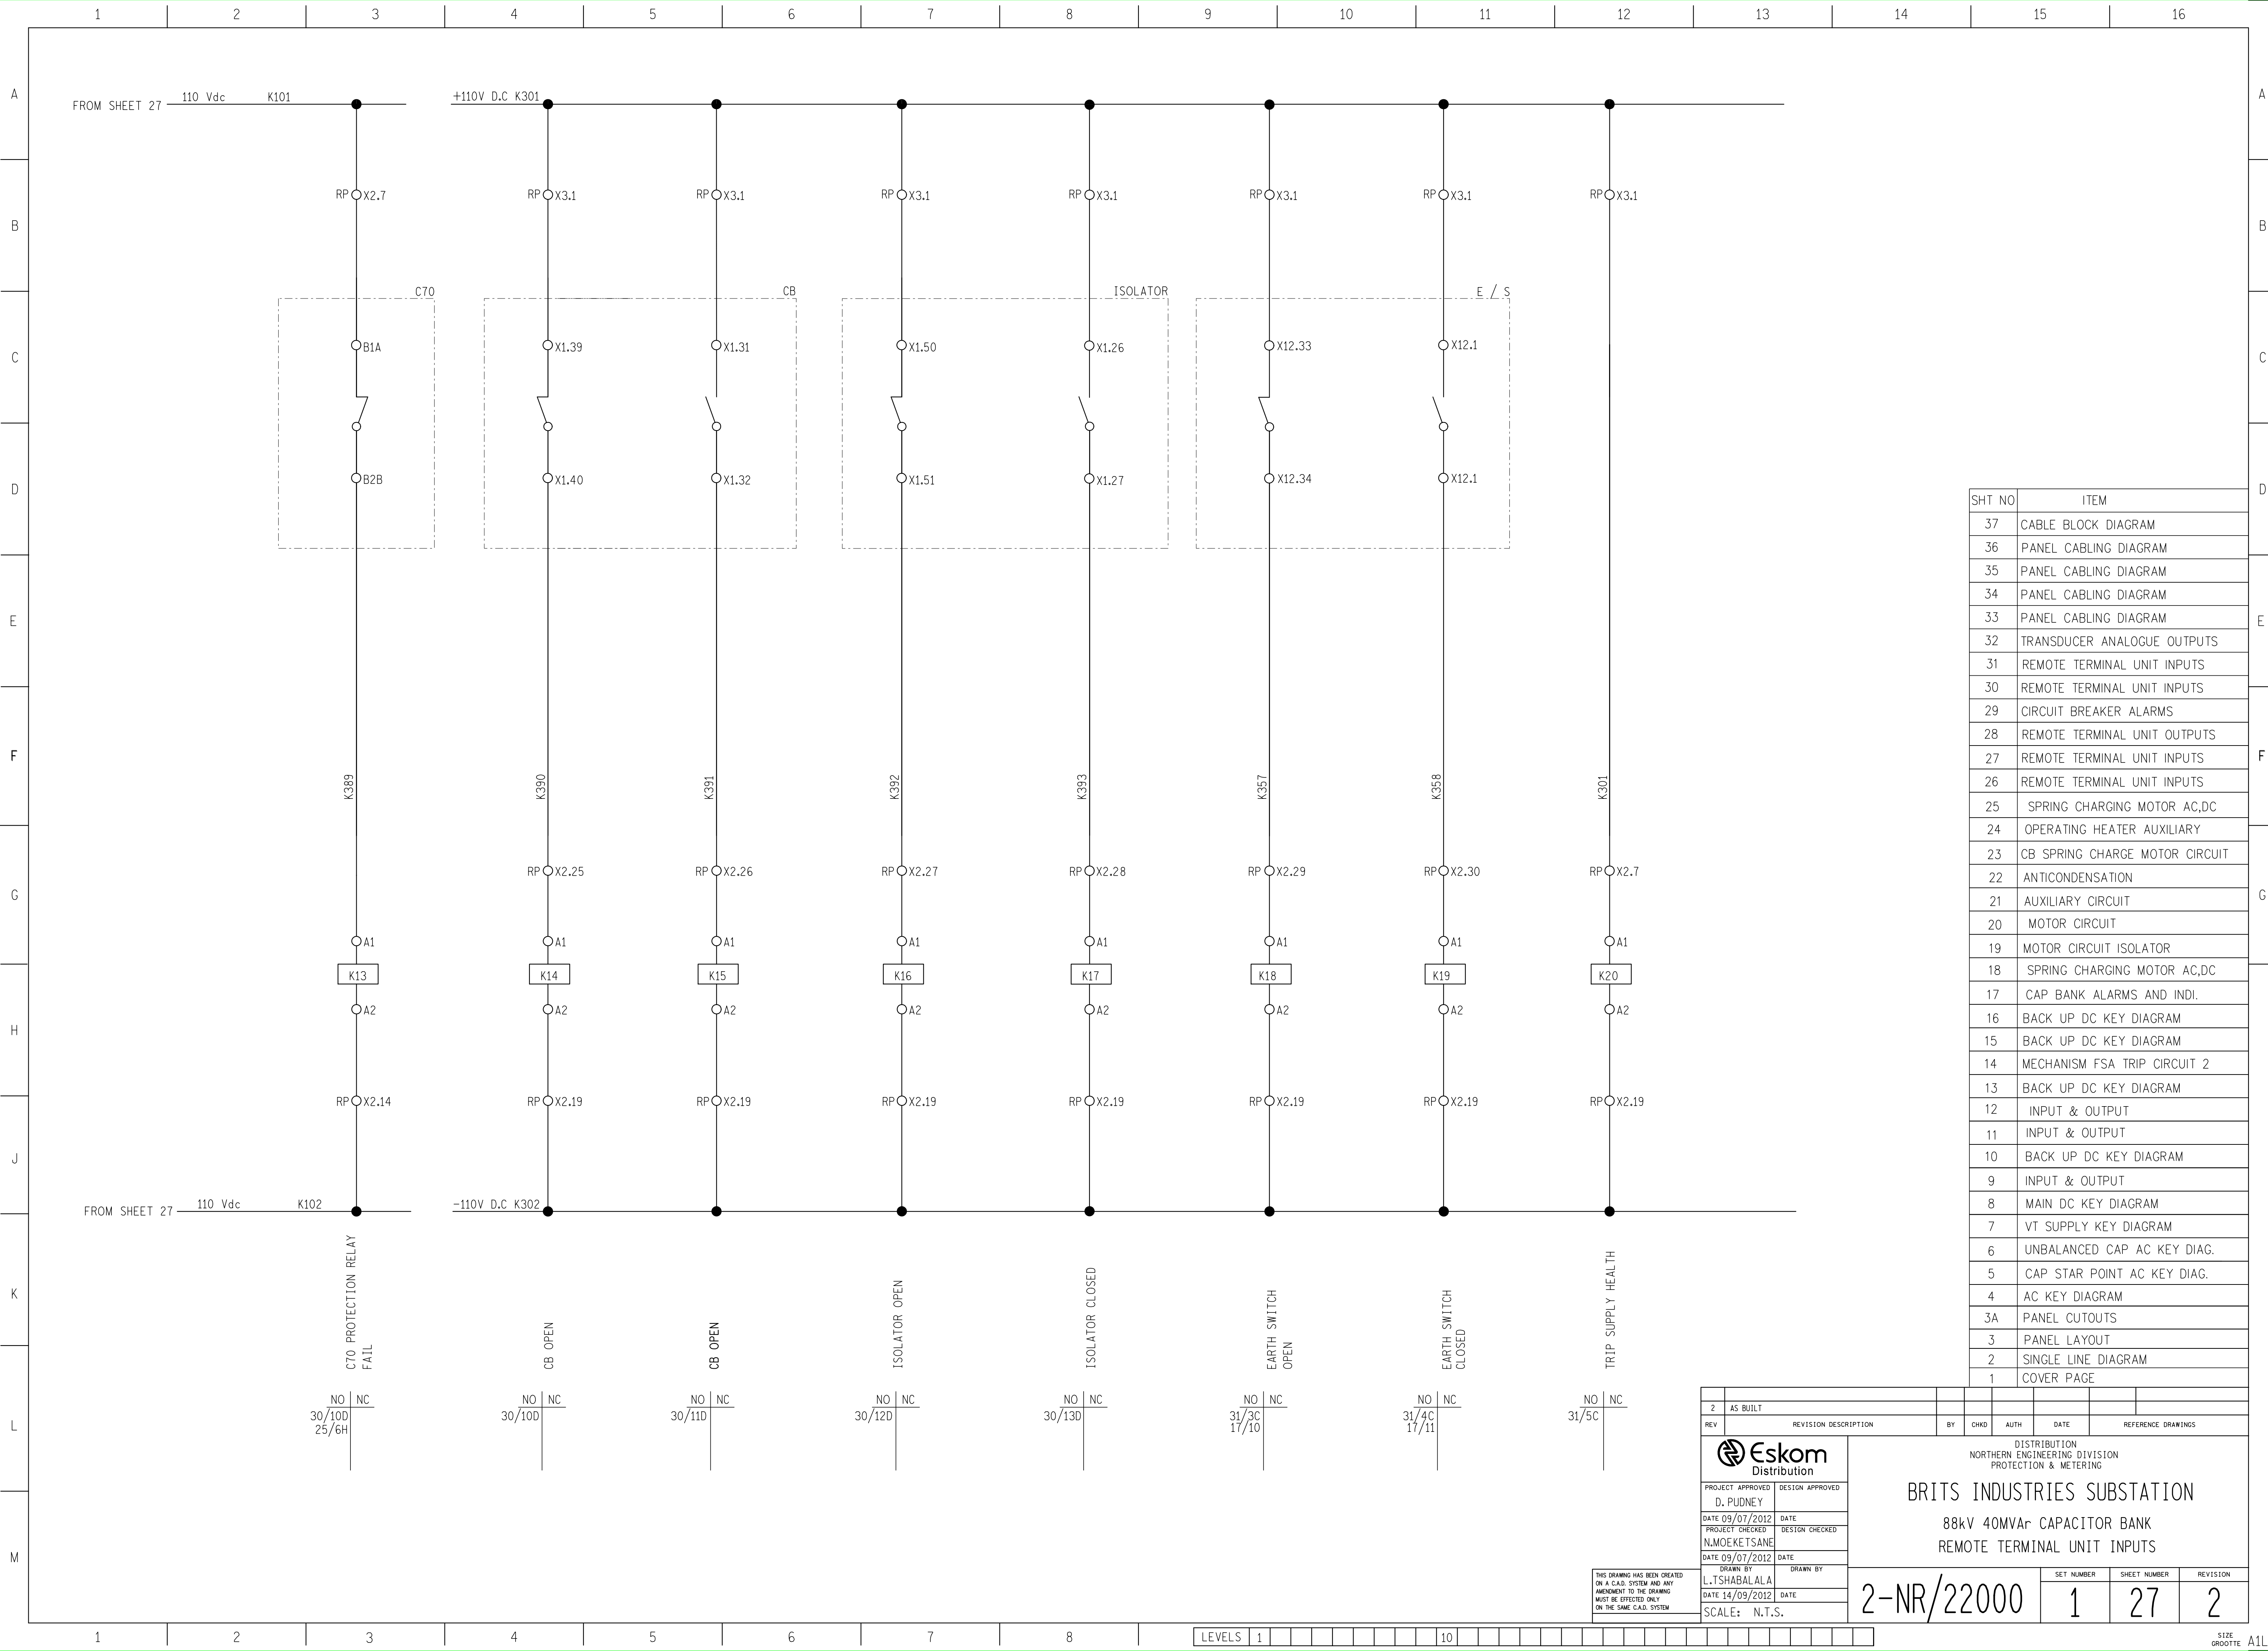

SHT NO	ITEM
37	CABLE BLOCK DIAGRAM
36	PANEL CABLING DIAGRAM
35	PANEL CABLING DIAGRAM
34	PANEL CABLING DIAGRAM
33	PANEL CABLING DIAGRAM
32	TRANSDUCER ANALOGUE OUTPUTS
31	REMOTE TERMINAL UNIT INPUTS
30	REMOTE TERMINAL UNIT INPUTS
29	CIRCUIT BREAKER ALARMS
28	REMOTE TERMINAL UNIT OUTPUTS
27	REMOTE TERMINAL UNIT INPUTS
26	REMOTE TERMINAL UNIT INPUTS
25	SPRING CHARGING MOTOR AC,DC
24	OPERATING HEATER AUXILIARY
23	CB SPRING CHARGE MOTOR CIRCUIT
22	ANTICONDENSATION
21	AUXILIARY CIRCUIT
20	MOTOR CIRCUIT
19	MOTOR CIRCUIT ISOLATOR
18	SPRING CHARGING MOTOR AC,DC
17	CAP BANK ALARMS AND INDI.
16	BACK UP DC KEY DIAGRAM
15	BACK UP DC KEY DIAGRAM
14	MECHANISM FSA TRIP CIRCUIT 2
13	BACK UP DC KEY DIAGRAM
12	INPUT & OUTPUT
11	INPUT & OUTPUT
10	BACK UP DC KEY DIAGRAM
9	INPUT & OUTPUT
8	MAIN DC KEY DIAGRAM
7	VT SUPPLY KEY DIAGRAM
6	UNBALANCED CAP AC KEY DIAG.
5	CAP STAR POINT AC KEY DIAG.
4	AC KEY DIAGRAM
3A	PANEL CUTOUTS
3	PANEL LAYOUT
2	SINGLE LINE DIAGRAM
1	COVER PAGE

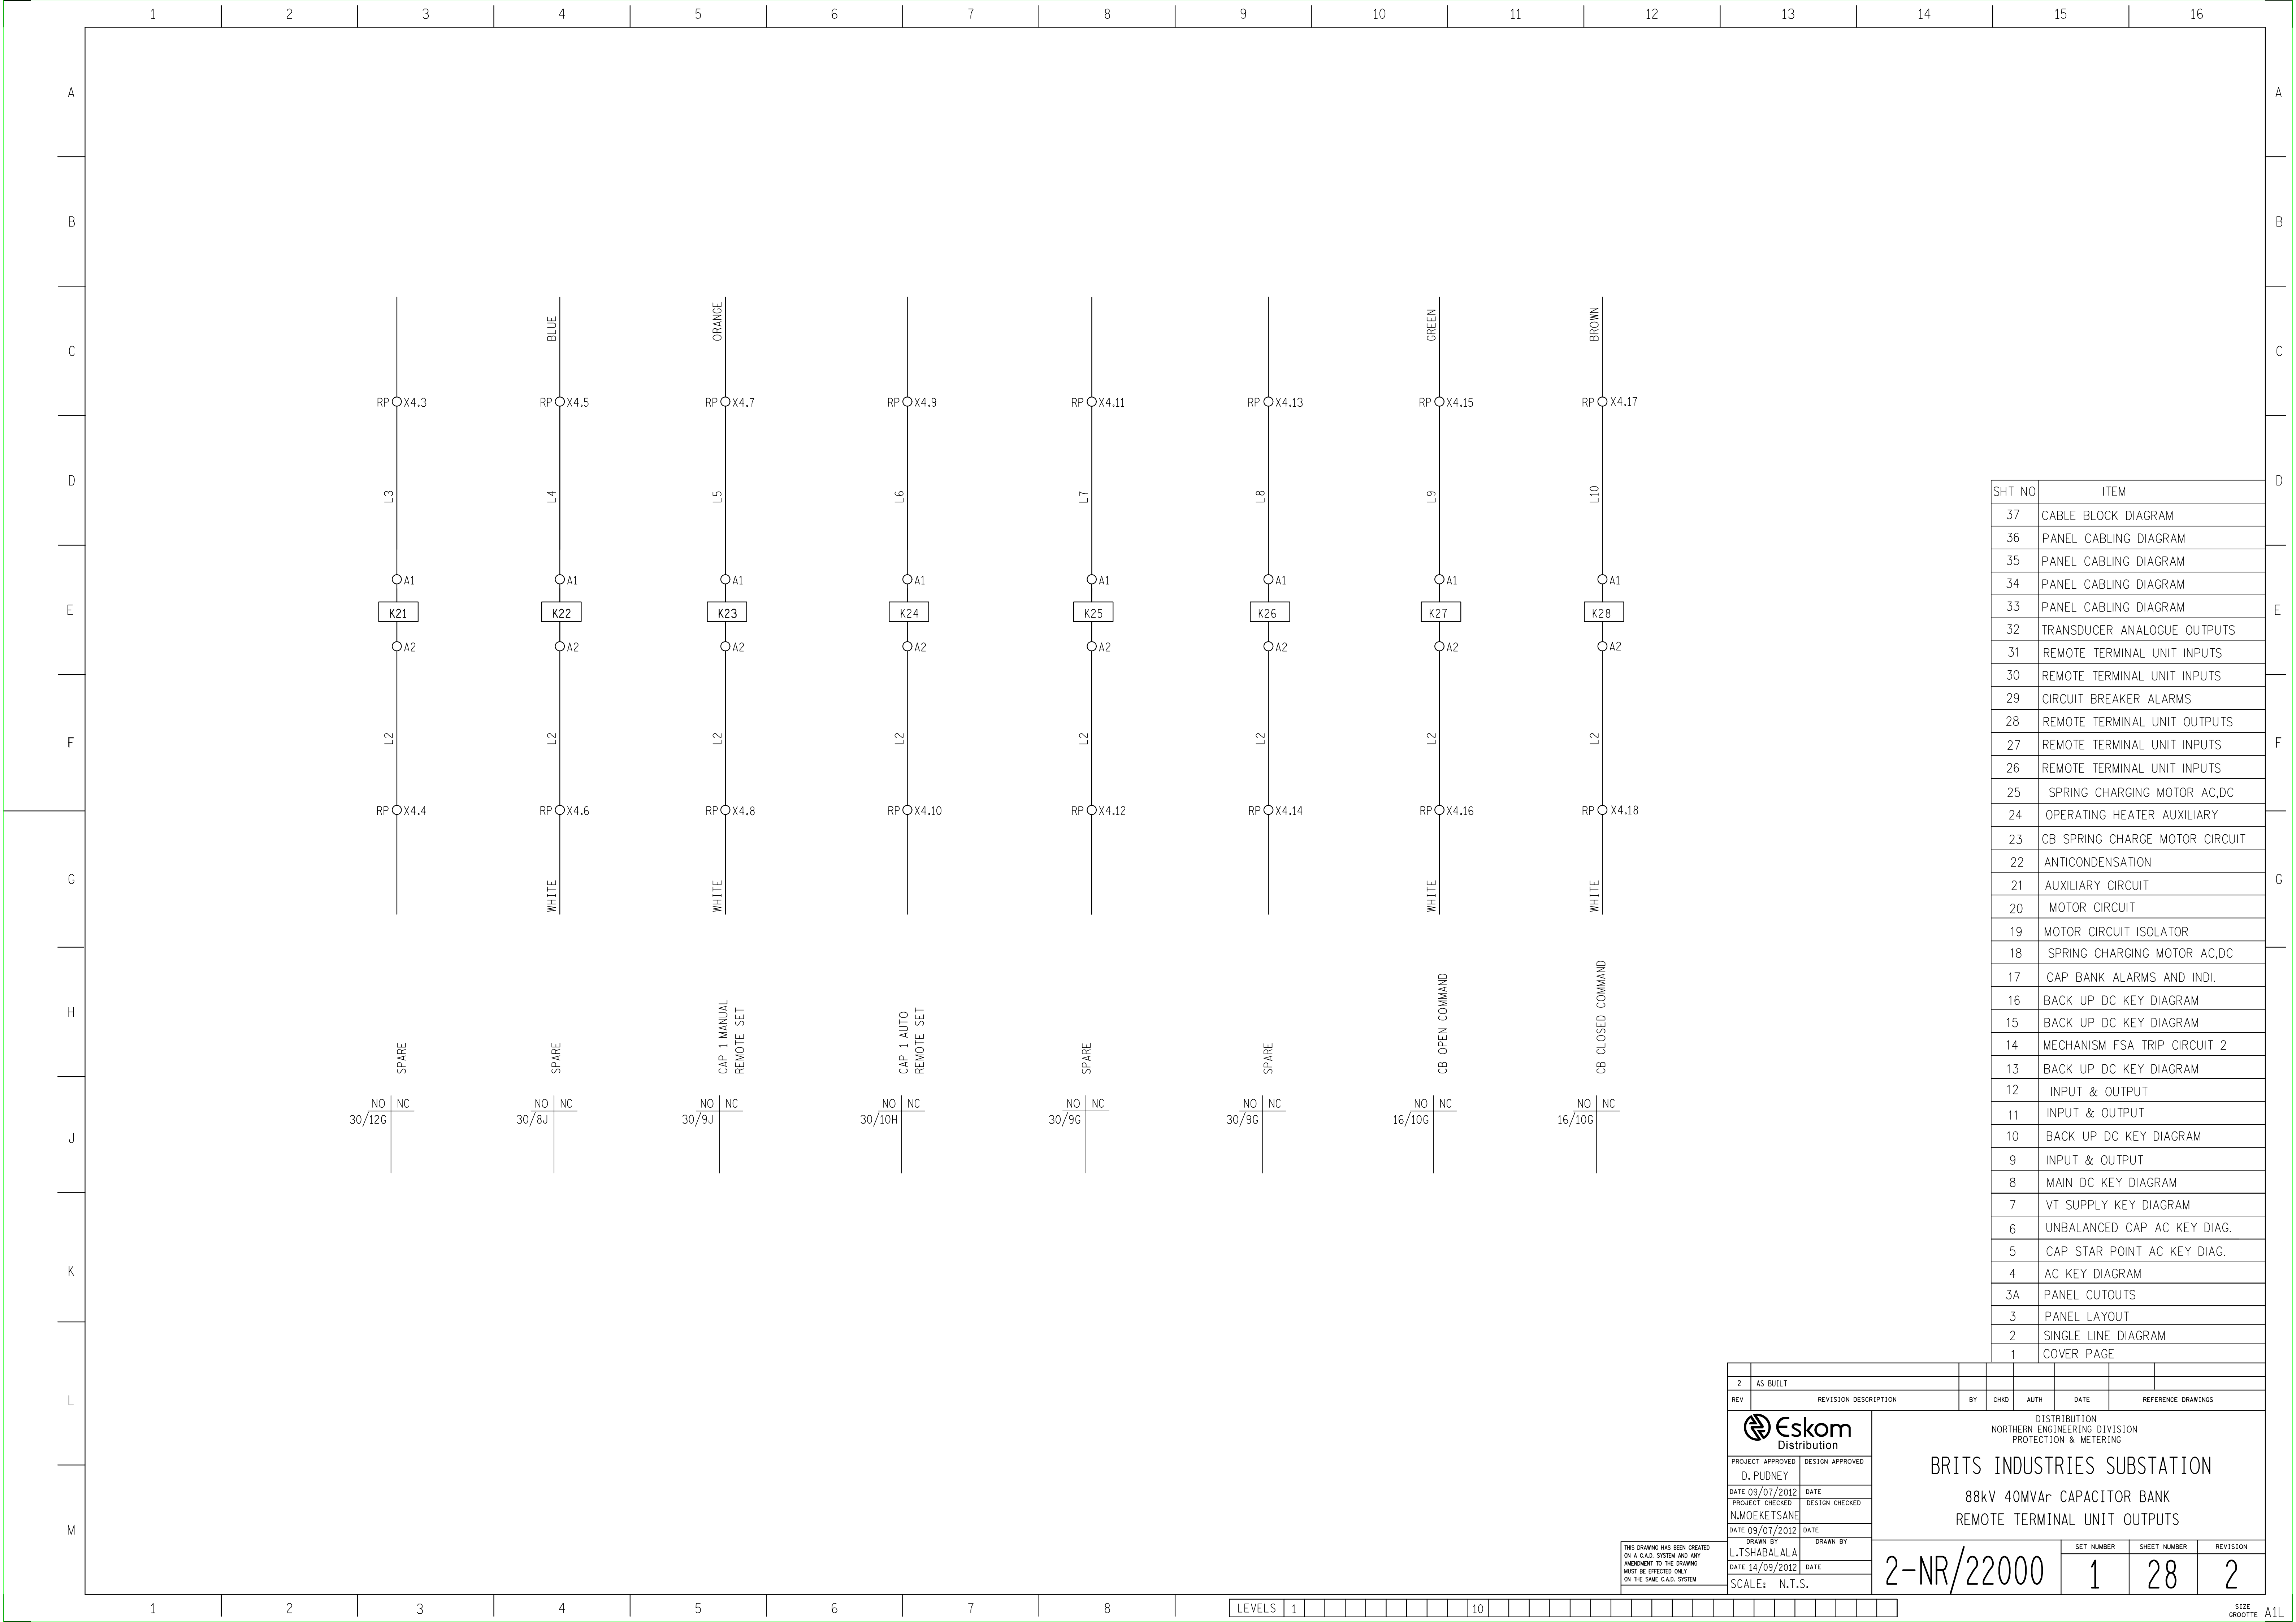

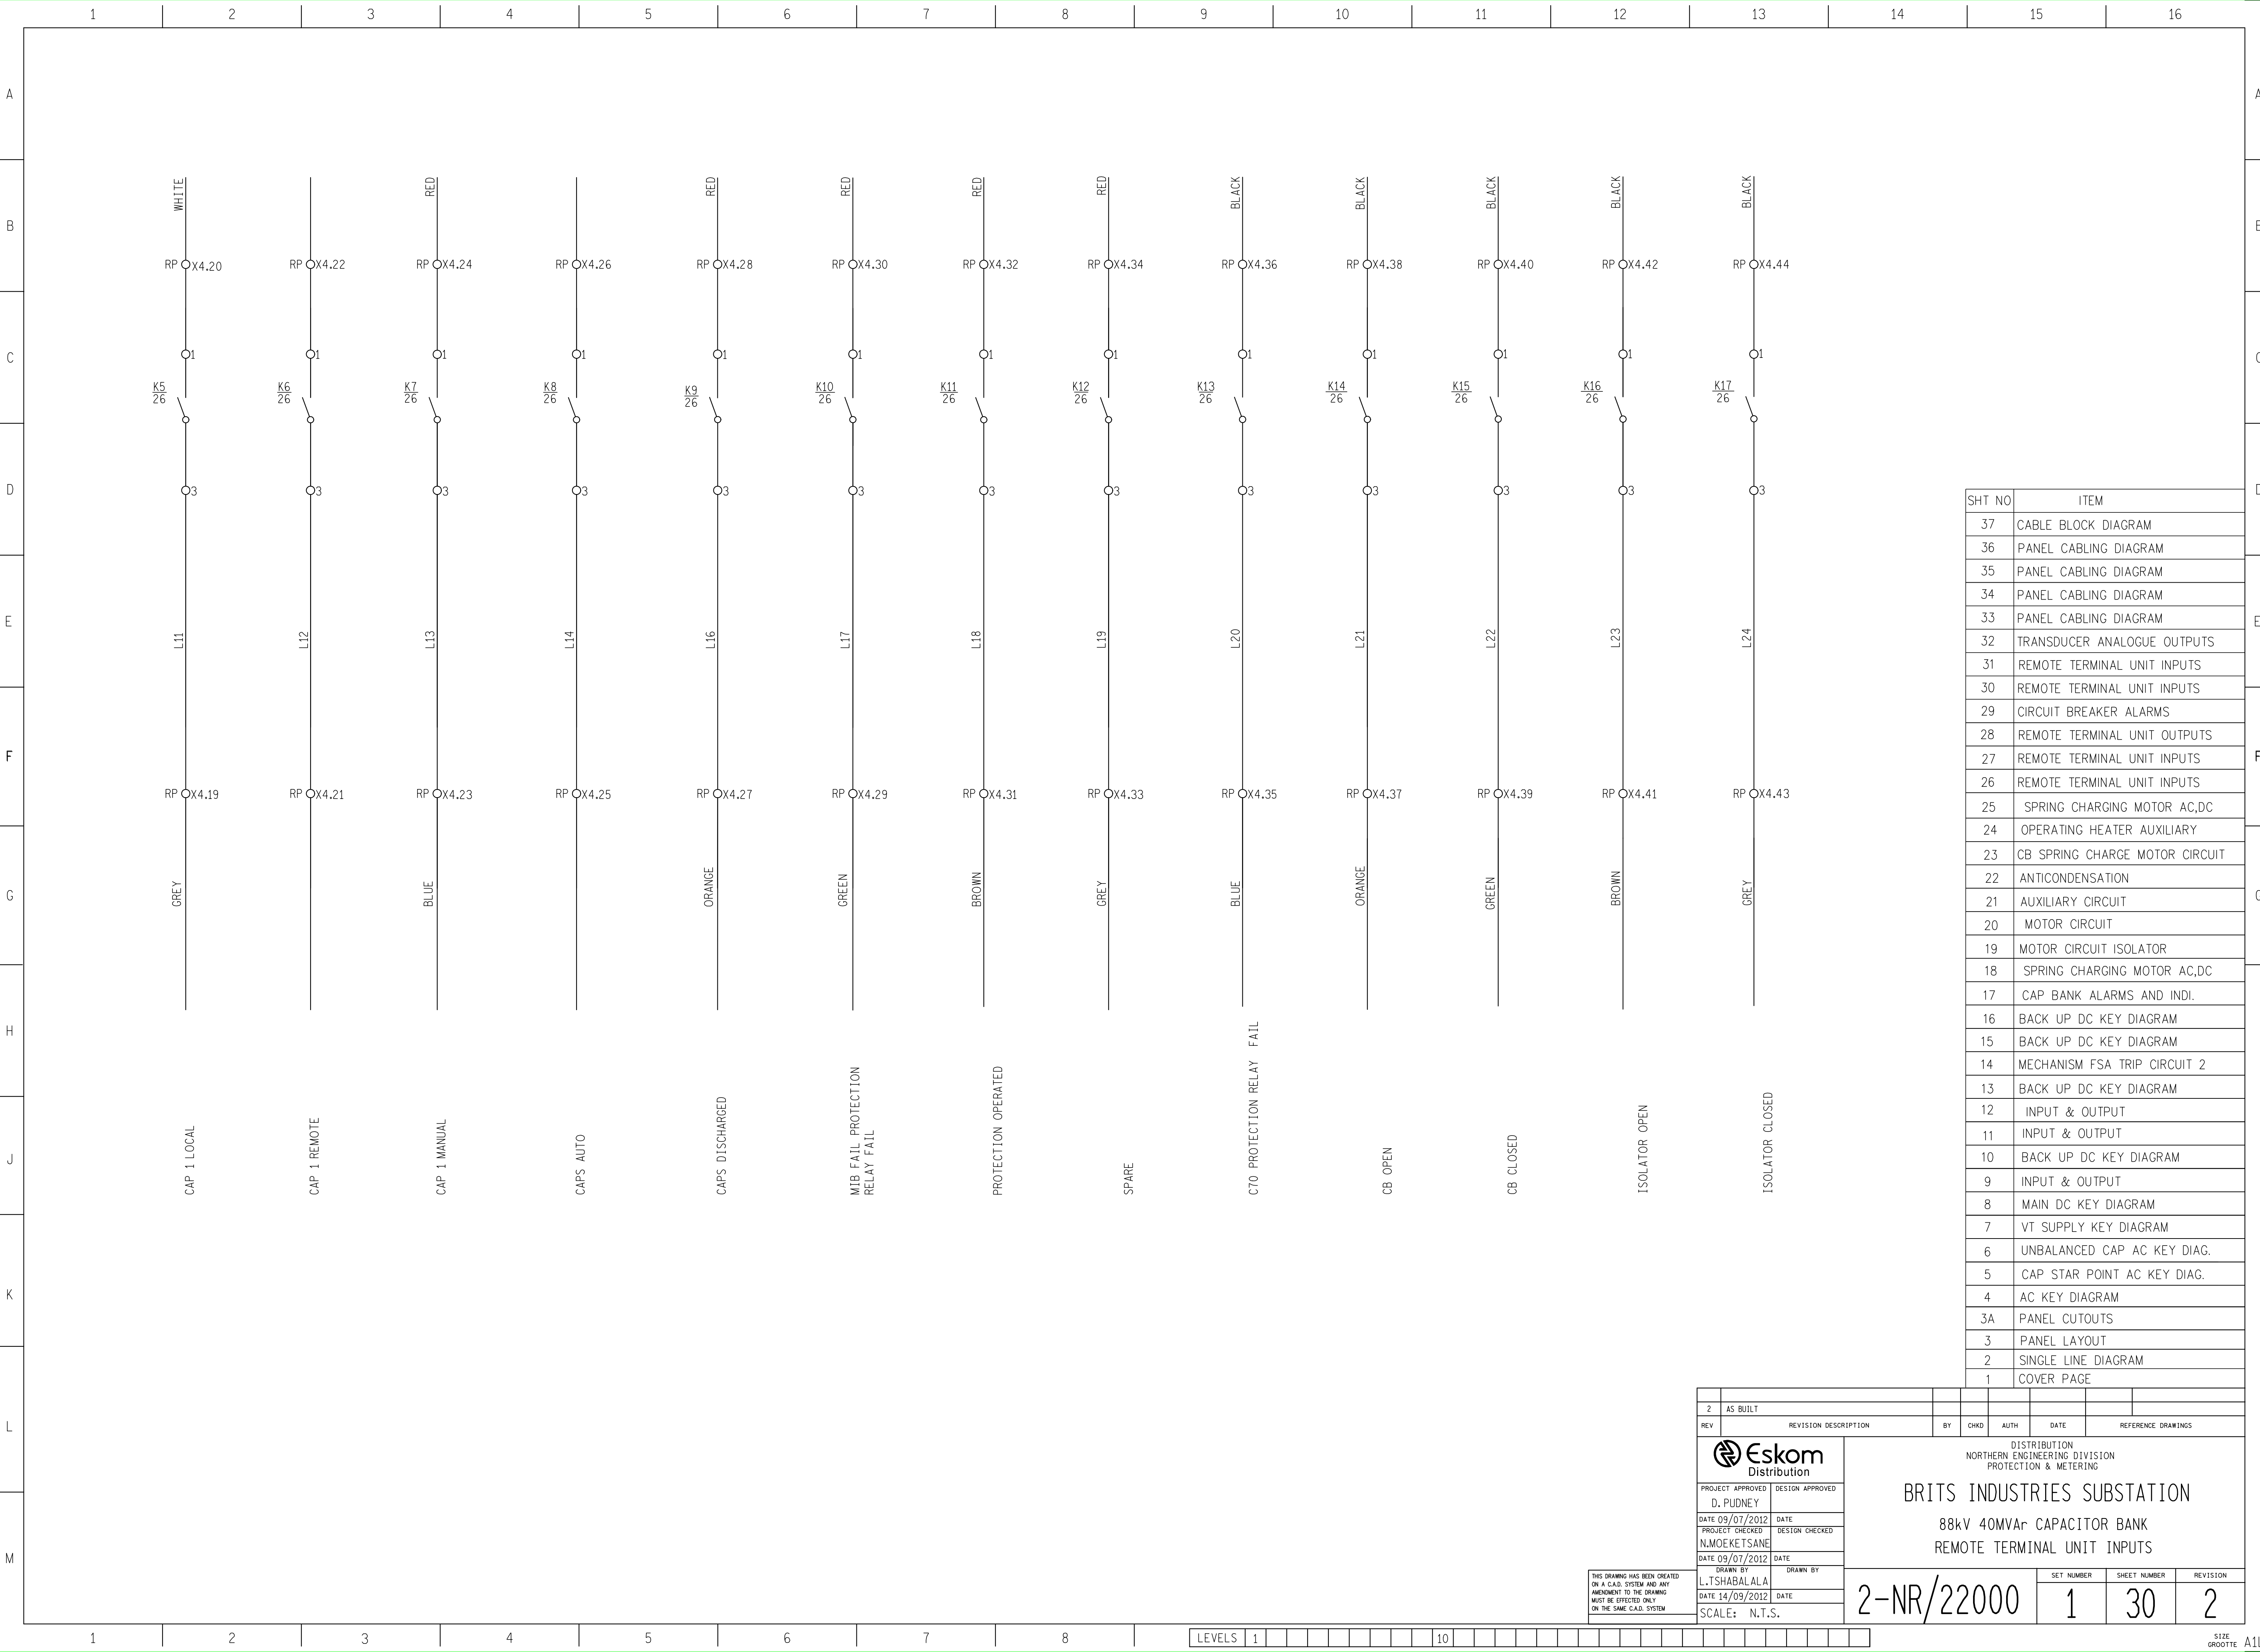

SHT NO	ITEM
37	CABLE BLOCK DIAGRAM
36	PANEL CABLING DIAGRAM
35	PANEL CABLING DIAGRAM
34	PANEL CABLING DIAGRAM
33	PANEL CABLING DIAGRAM
32	TRANSDUCER ANALOGUE OUTPUTS
31	REMOTE TERMINAL UNIT INPUTS
30	REMOTE TERMINAL UNIT INPUTS
29	CIRCUIT BREAKER ALARMS
28	REMOTE TERMINAL UNIT OUTPUTS
27	REMOTE TERMINAL UNIT INPUTS
26	REMOTE TERMINAL UNIT INPUTS
25	SPRING CHARGING MOTOR AC,DC
24	OPERATING HEATER AUXILIARY
23	CB SPRING CHARGE MOTOR CIRCUIT
22	ANTICONDENSATION
21	AUXILIARY CIRCUIT
20	MOTOR CIRCUIT
19	MOTOR CIRCUIT ISOLATOR
18	SPRING CHARGING MOTOR AC,DC
17	CAP BANK ALARMS AND INDI.
16	BACK UP DC KEY DIAGRAM
15	BACK UP DC KEY DIAGRAM
14	MECHANISM FSA TRIP CIRCUIT 2
13	BACK UP DC KEY DIAGRAM
12	INPUT & OUTPUT
11	INPUT & OUTPUT
10	BACK UP DC KEY DIAGRAM
9	INPUT & OUTPUT
8	MAIN DC KEY DIAGRAM
7	VT SUPPLY KEY DIAGRAM
6	UNBALANCED CAP AC KEY DIAG.
5	CAP STAR POINT AC KEY DIAG.
4	AC KEY DIAGRAM
3A	PANEL CUTOUTS
3	PANEL LAYOUT
2	SINGLE LINE DIAGRAM
1	COVER PAGE

2AS BUILT

REVBYCHKDAUTHDATEREFERENCE DRAWINGS

PROJECT APPROVED
D. PUDNEY

DATE 09/07/2012

DESIGN APPROVED

DATE

DESIGN CHECKED
N.MOEKETSANE

DATE 09/07/2012

THIS DRAWING HAS BEEN CREATED ON A C.A.D. SYSTEM AND ANY AMENDMENT TO THE DRAWING MUST BE EFFECTED ONLY ON THE SAME C.A.D. SYSTEM

DRAWN BY
L.TSHABALALA

DATE 14/09/2012

DRAWN BY

DATE

SCALE: N.T.S.

DISTRIBUTION
NORTHERN ENGINEERING DIVISION
PROTECTION & METERING

BRITS INDUSTRIES SUBSTATION
88kV 40MVA_r CAPACITOR BANK
REMOTE TERMINAL UNIT INPUTS


SET NUMBER
2-NR/22000


SHEET NUMBER
1

REVISION
30

2

SIZE
GROOTTE A1L

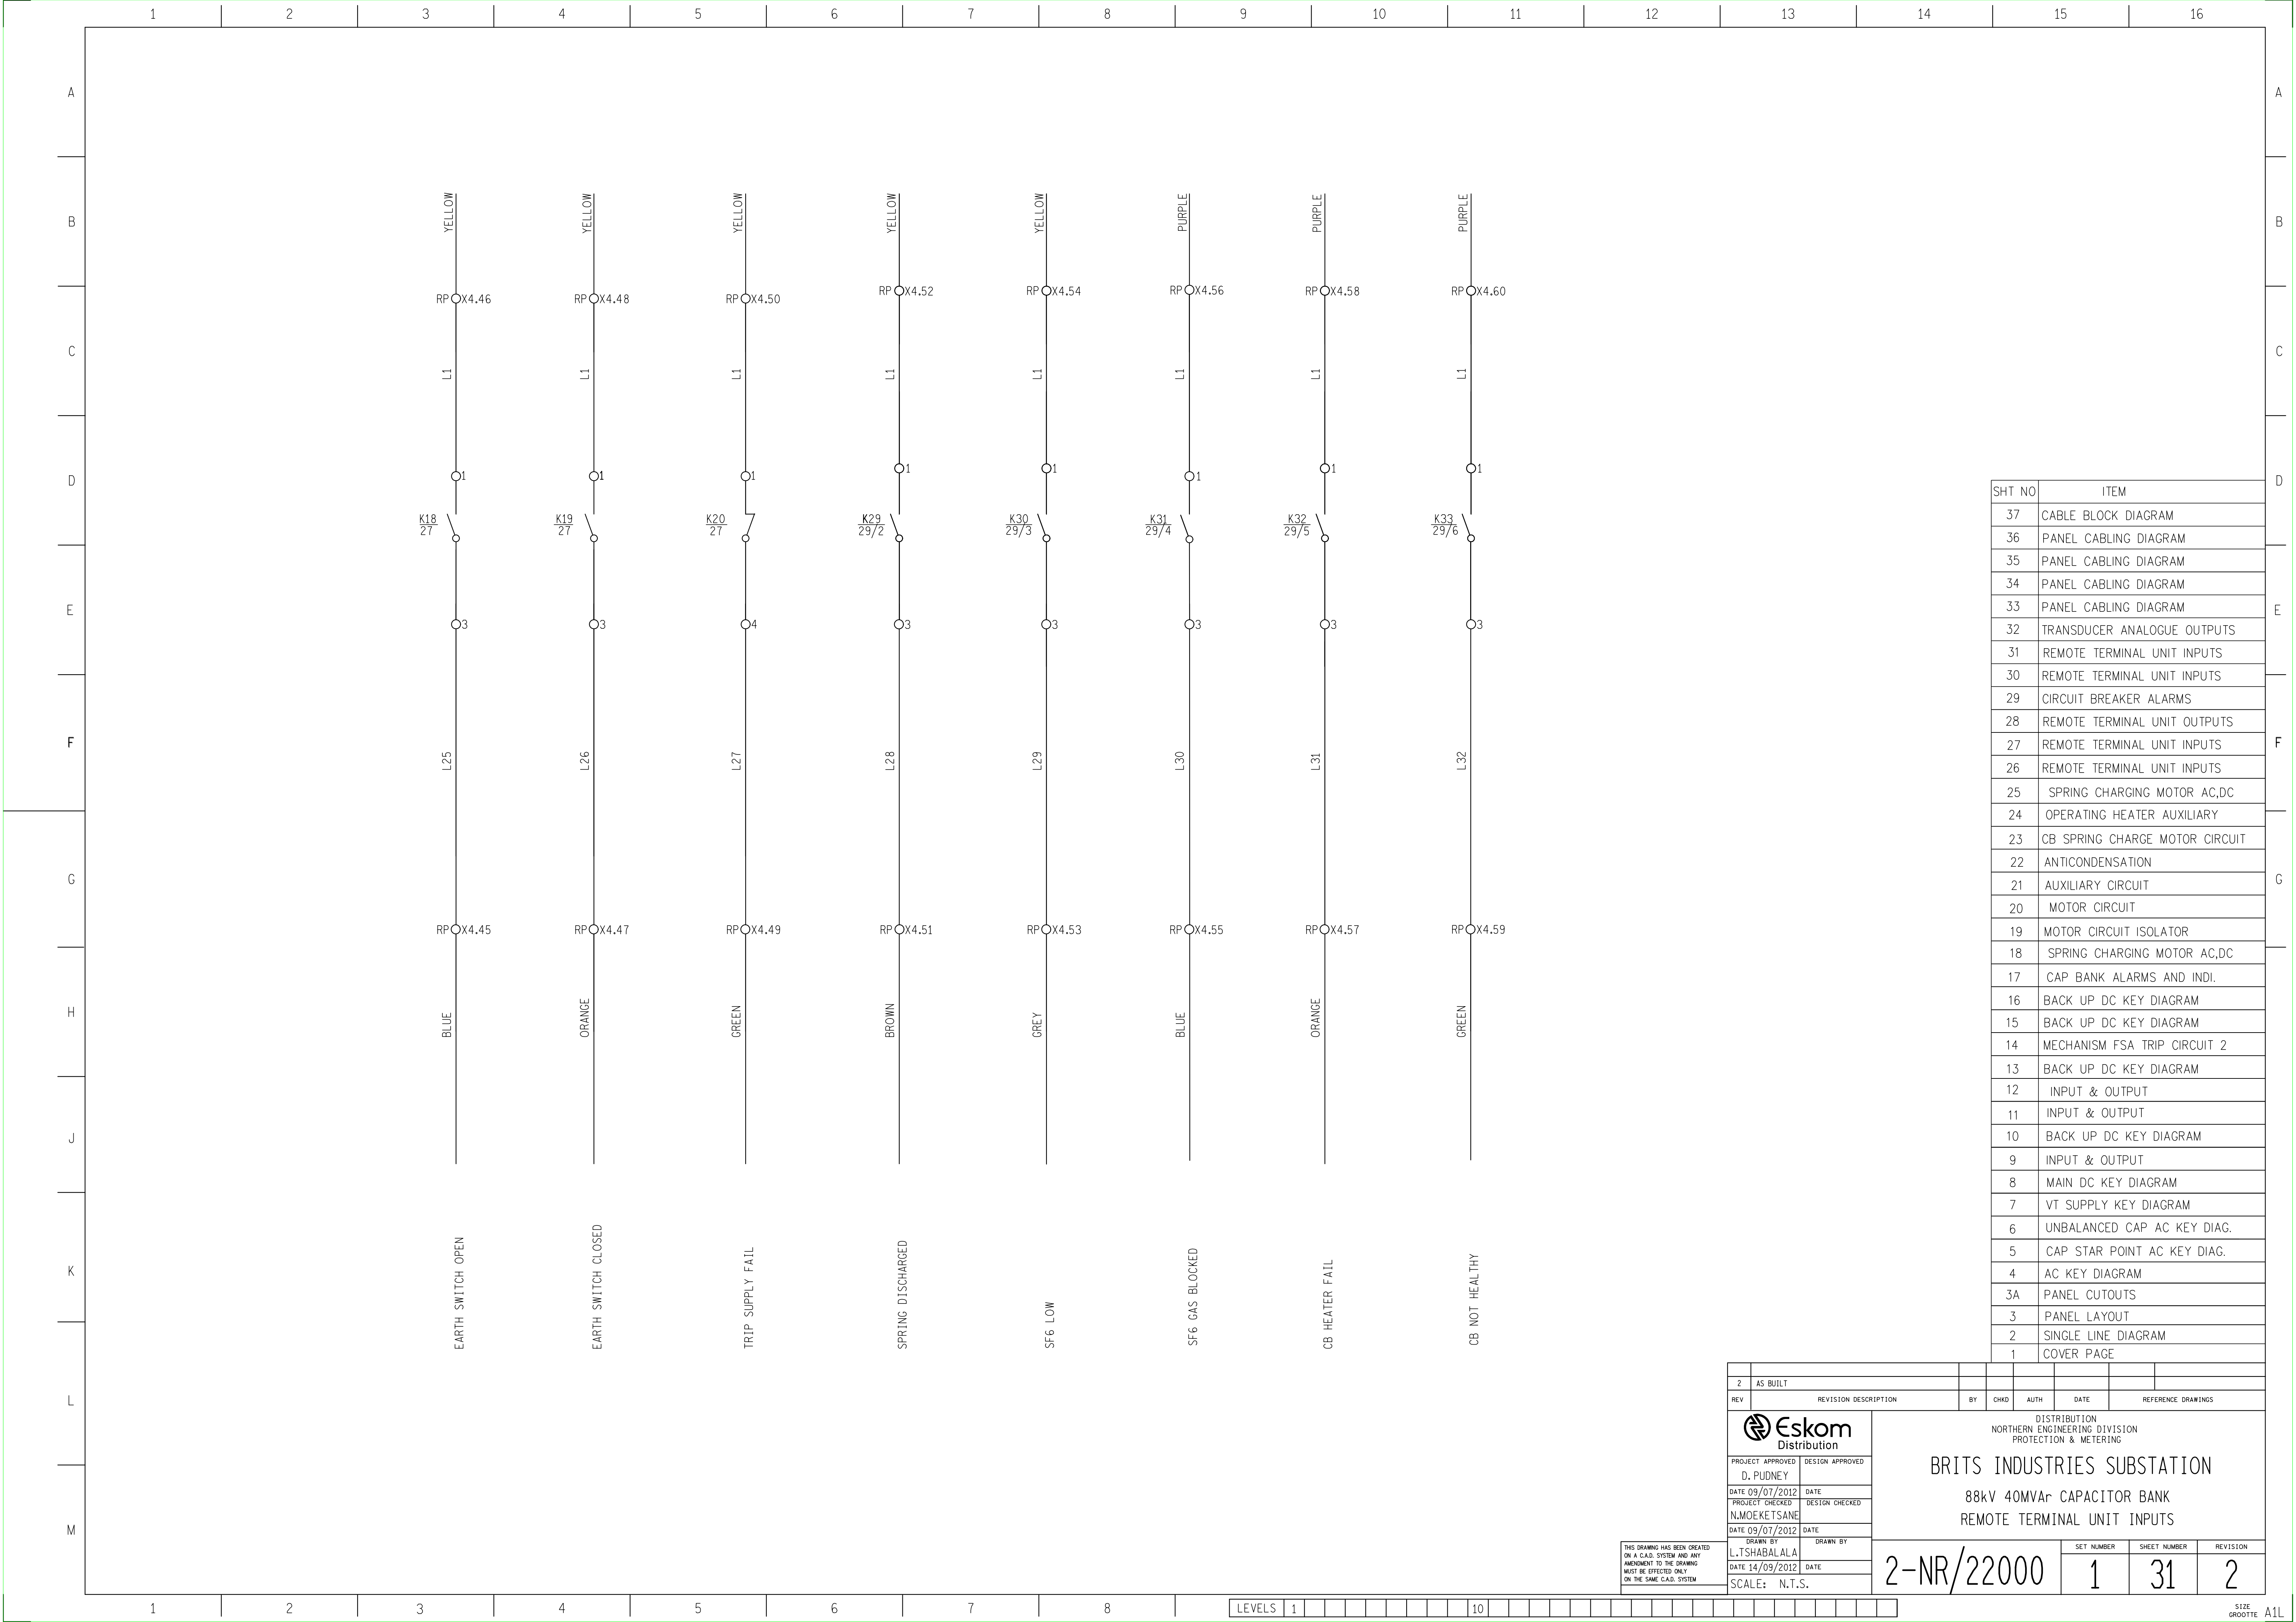

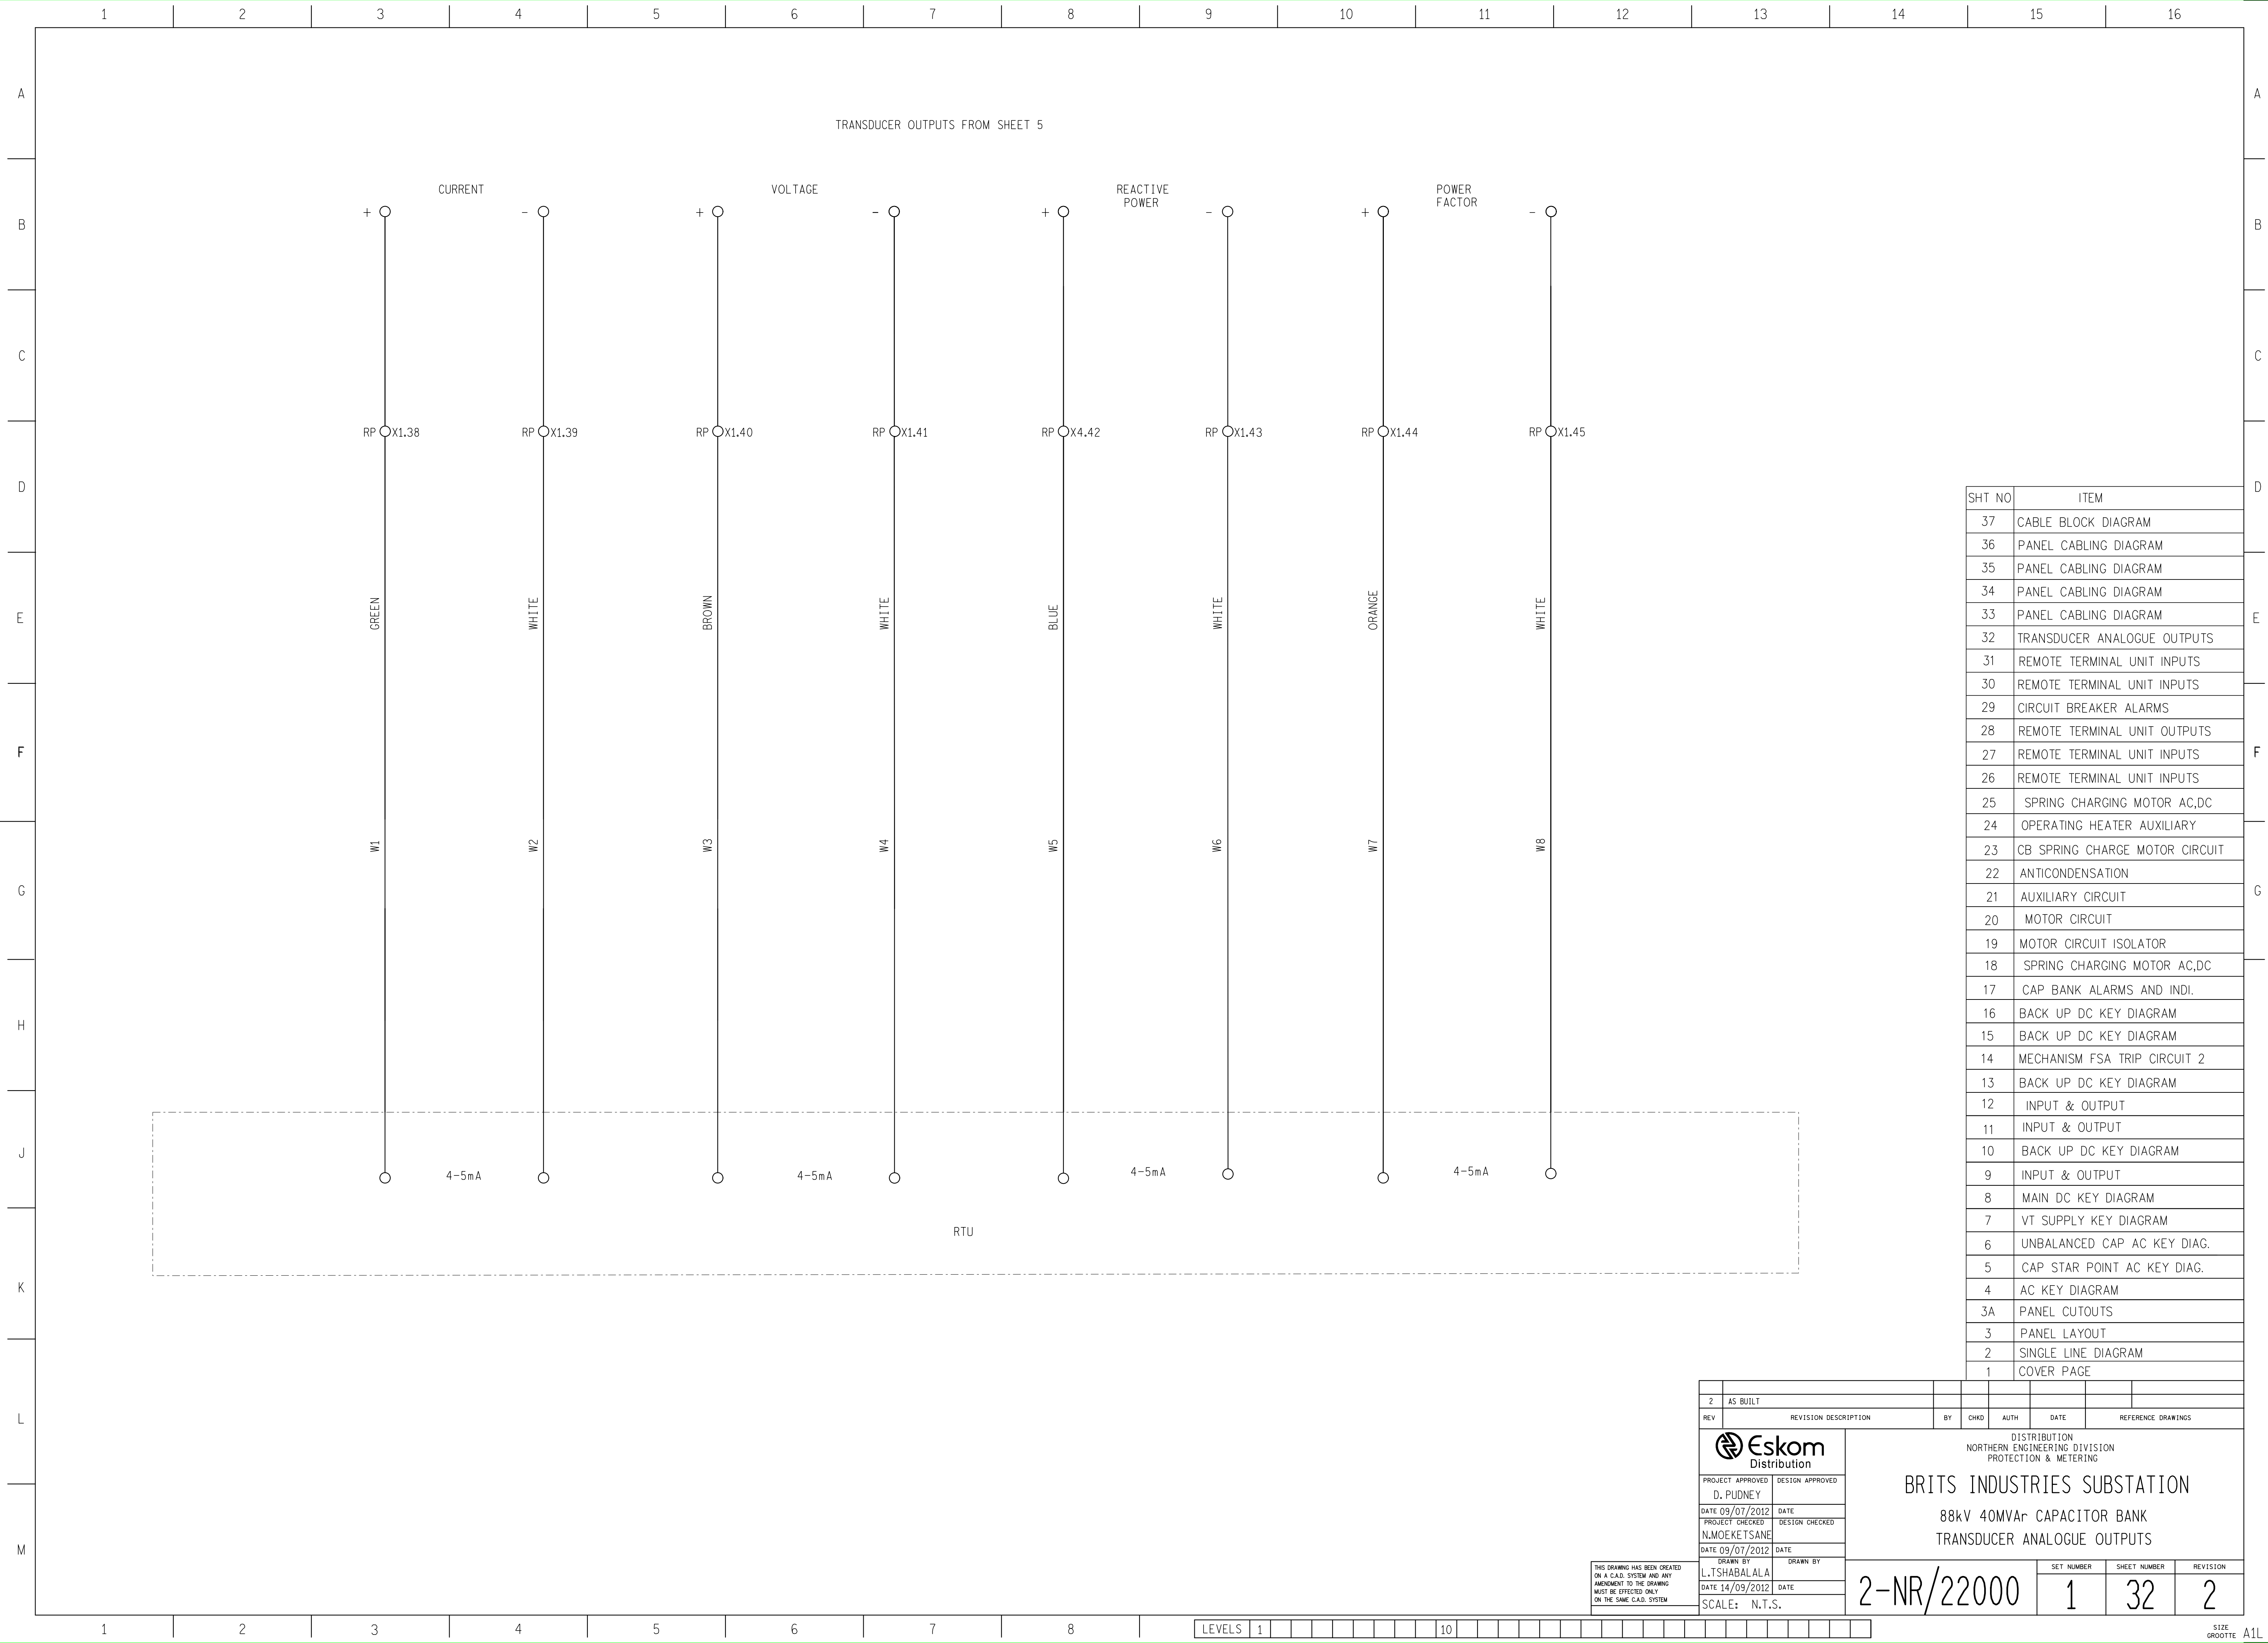


[illegible]

[illegible]

[illegible]

[illegible]

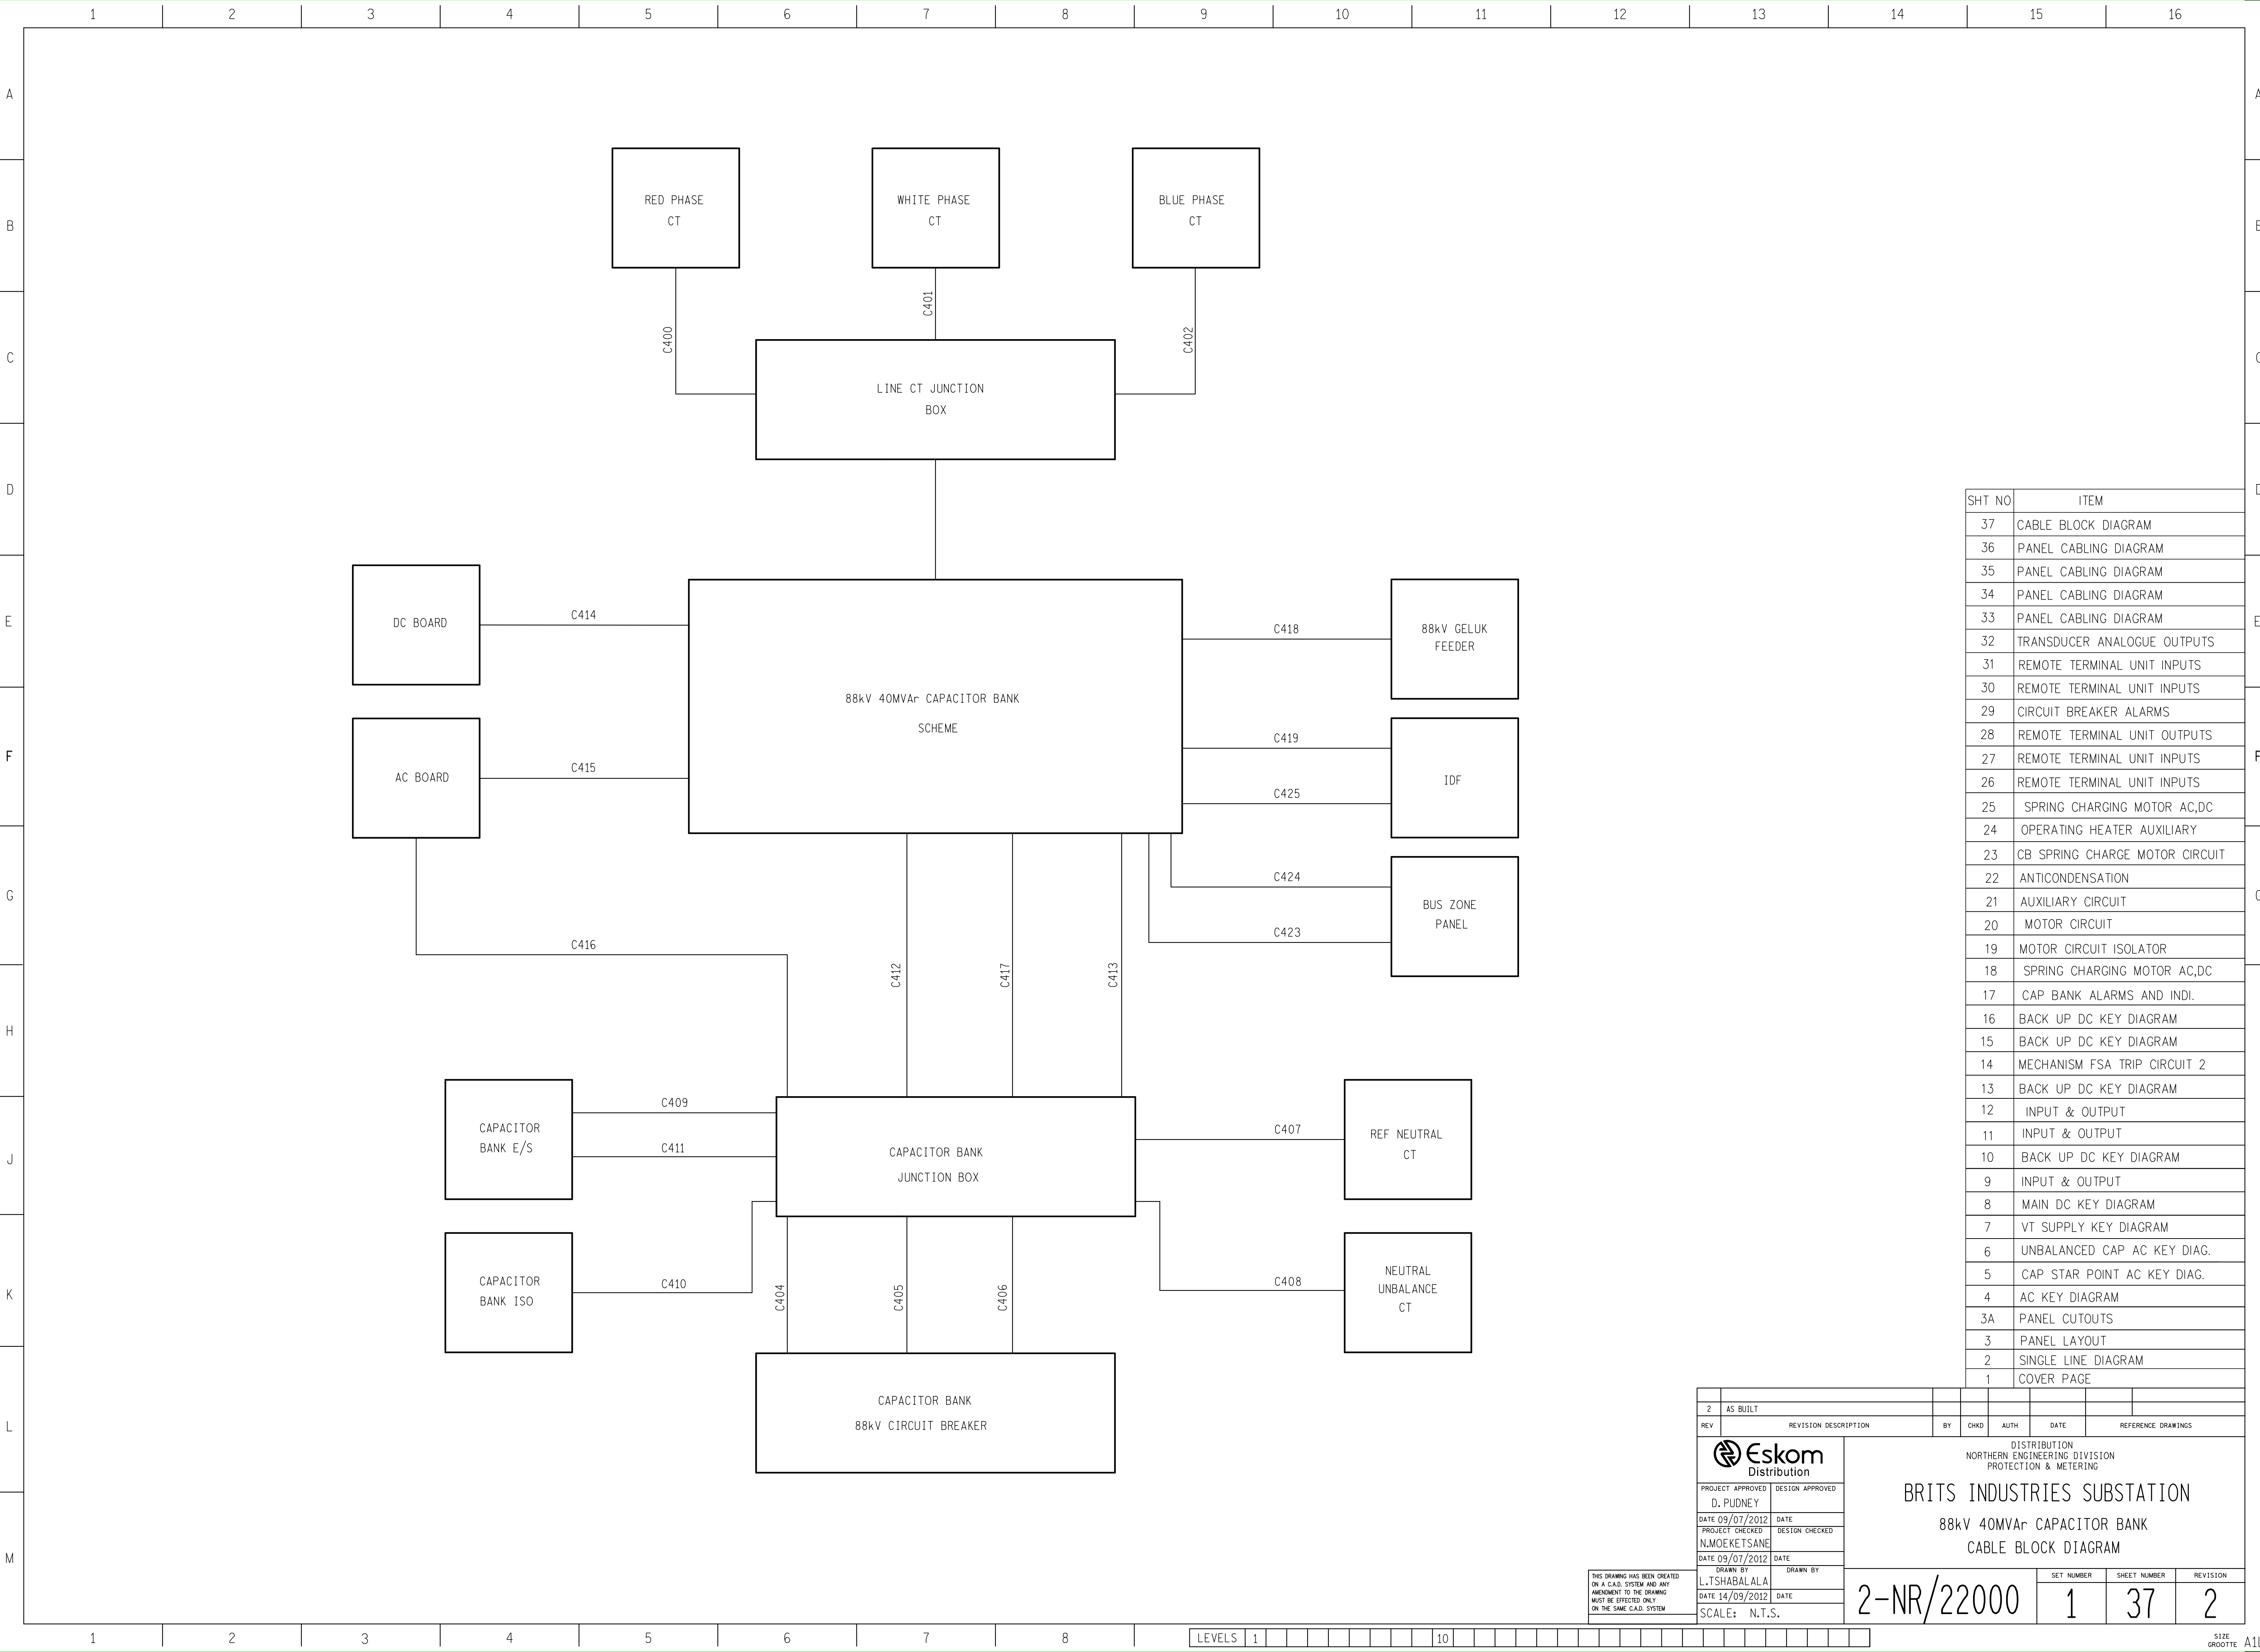

2	AS BUILT						
REV	REVISION DESCRIPTION	BY	CHKD	AUTH	DATE	REFERENCE DRAWINGS	
Eskom Distribution PROJECT APPROVED D. PUDNEY DATE 09/07/2012 PROJECT CHECKED N.MOEKETSANE DATE 09/07/2012 DRAWN BY L.TSHABALALA DATE 14/09/2012 SCALE: N.T.S. DISTRIBUTION NORTHERN ENGINEERING DIVISION PROTECTION & METERING BRITS INDUSTRIES SUBSTATION 88kV 40MVar CAPACITOR BANK CABLE BLOCK DIAGRAM		SET NUMBER		SHEET NUMBER	REVISION		
2-NR/22000		1		37	2		