

ROADMARKING SHEET 1		
BROKEN WHITE LINE		
ENTIRE LENGTH OF ROAD 100mm WIDE		
CONTINUOUS YELLOW LINE:		
ENTIRE LENGTH OF ROAD BOTH SIDES		
100mm WIDE AND 600mm FROM		
CHIPS EDGE		
BARRIER LINES:		
LHS		
SV	2033 - 2806,2	2213,6 - 2296,5
SV	3042 - 3152,7	3146,7 - 3307,0
SV	3307 - 3676,4	3446,0 - 3824,0
SV	3813 - 4162,0	4019,0 - 4316,5

PIPE SPECIFICATION:		
POINT	CLASS	No. OF LENGTHS
C to D	12	16
D to E	16	12

AIR RELEASE = 1/4" COPPER GATE VALVE

ROUTE OF BURIED PIPE LINE

NO	DATE	REVISIONS	BY	CHKD
1	2020	AS BUILT	D.C.	84/72
2	2021	AMENDMENTS	APPR	DATE
3	2022	DESIGNED BY	D.C.	82/73
4	2023	DESIGN CHECKED	R.S.	82/73
5	2024	DRAWN BY	D.C.	82/73
6	2025	DRAWING CHECKED	R.S.	82/74

SVE CONSULTANTS

NINHAM SHAND INC
VAN NIEKERK KLEYN & EDWARDS
ELECTROWATT ENGINEERING SERVICES LTD

CONSULTING ENGINEERS

FOR SVE CONSULTANTS

DATE: 3/5/22

Pr Eng

PALMIET PUMPED STORAGE SCHEME

LAYOUT PLAN
STATION
ACCESS ROAD

SHEET 2

Eskom

FOR **ESKOM** DATE:

FRMS REF No: 0370 / 5

SVE REF No: 3700 - C - 81

ESKOM DRAWING No:

0.48/20030 Sht. 2

3a

THIS DRAWING IS COPYRIGHT RESERVED

DRAWING CLASSIFICATION


(Controlled Disclosure)

000012

PRELIMINARY

SCALE 1:1 000

REV	DATE	REVISION	BY	CHKD	APPD	REF
1	2020	DESIGNED BY	D.C.	82/73		
2	2021	DESIGN CHECKED	R.S.	82/73		
3	2022	DRAWN BY	D.C.	82/73		
4	2023	DRAWING CHECKED	R.S.	82/74		

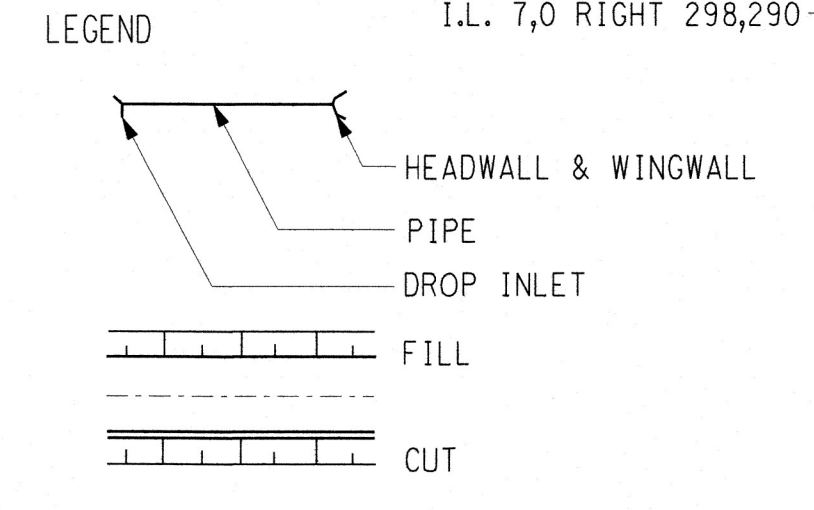

NOTES : 1. ALL 600mm ϕ CONCRETE PIPES ARE CLASS C ON CLASS C BEDDING

2. ALL INVERT LEVELS ARE GIVEN AT TOE OF FILL OR CENTRE OF SIDEDRAIN