
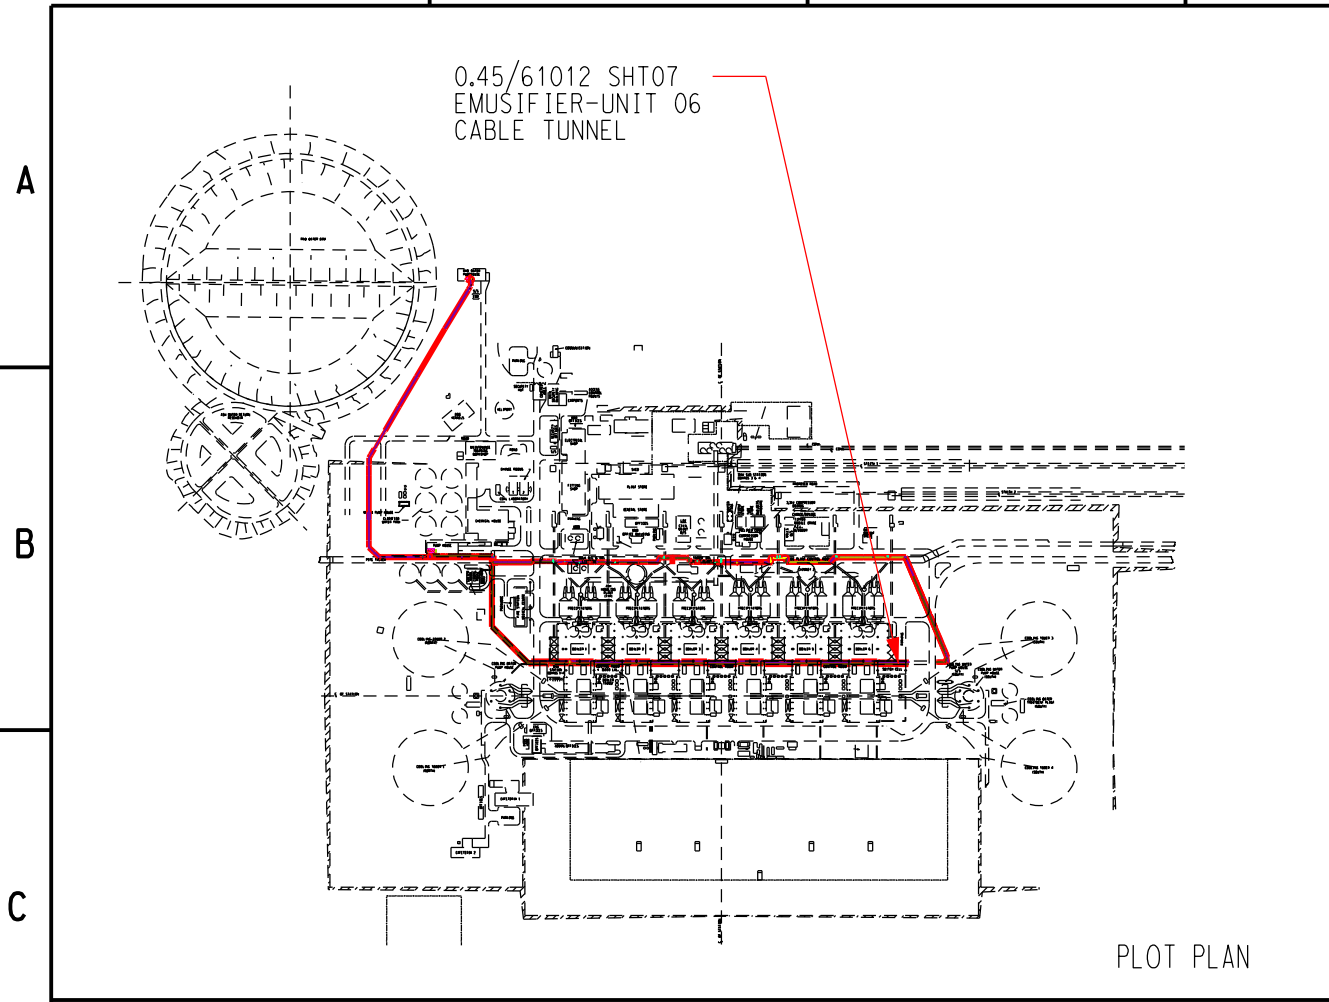


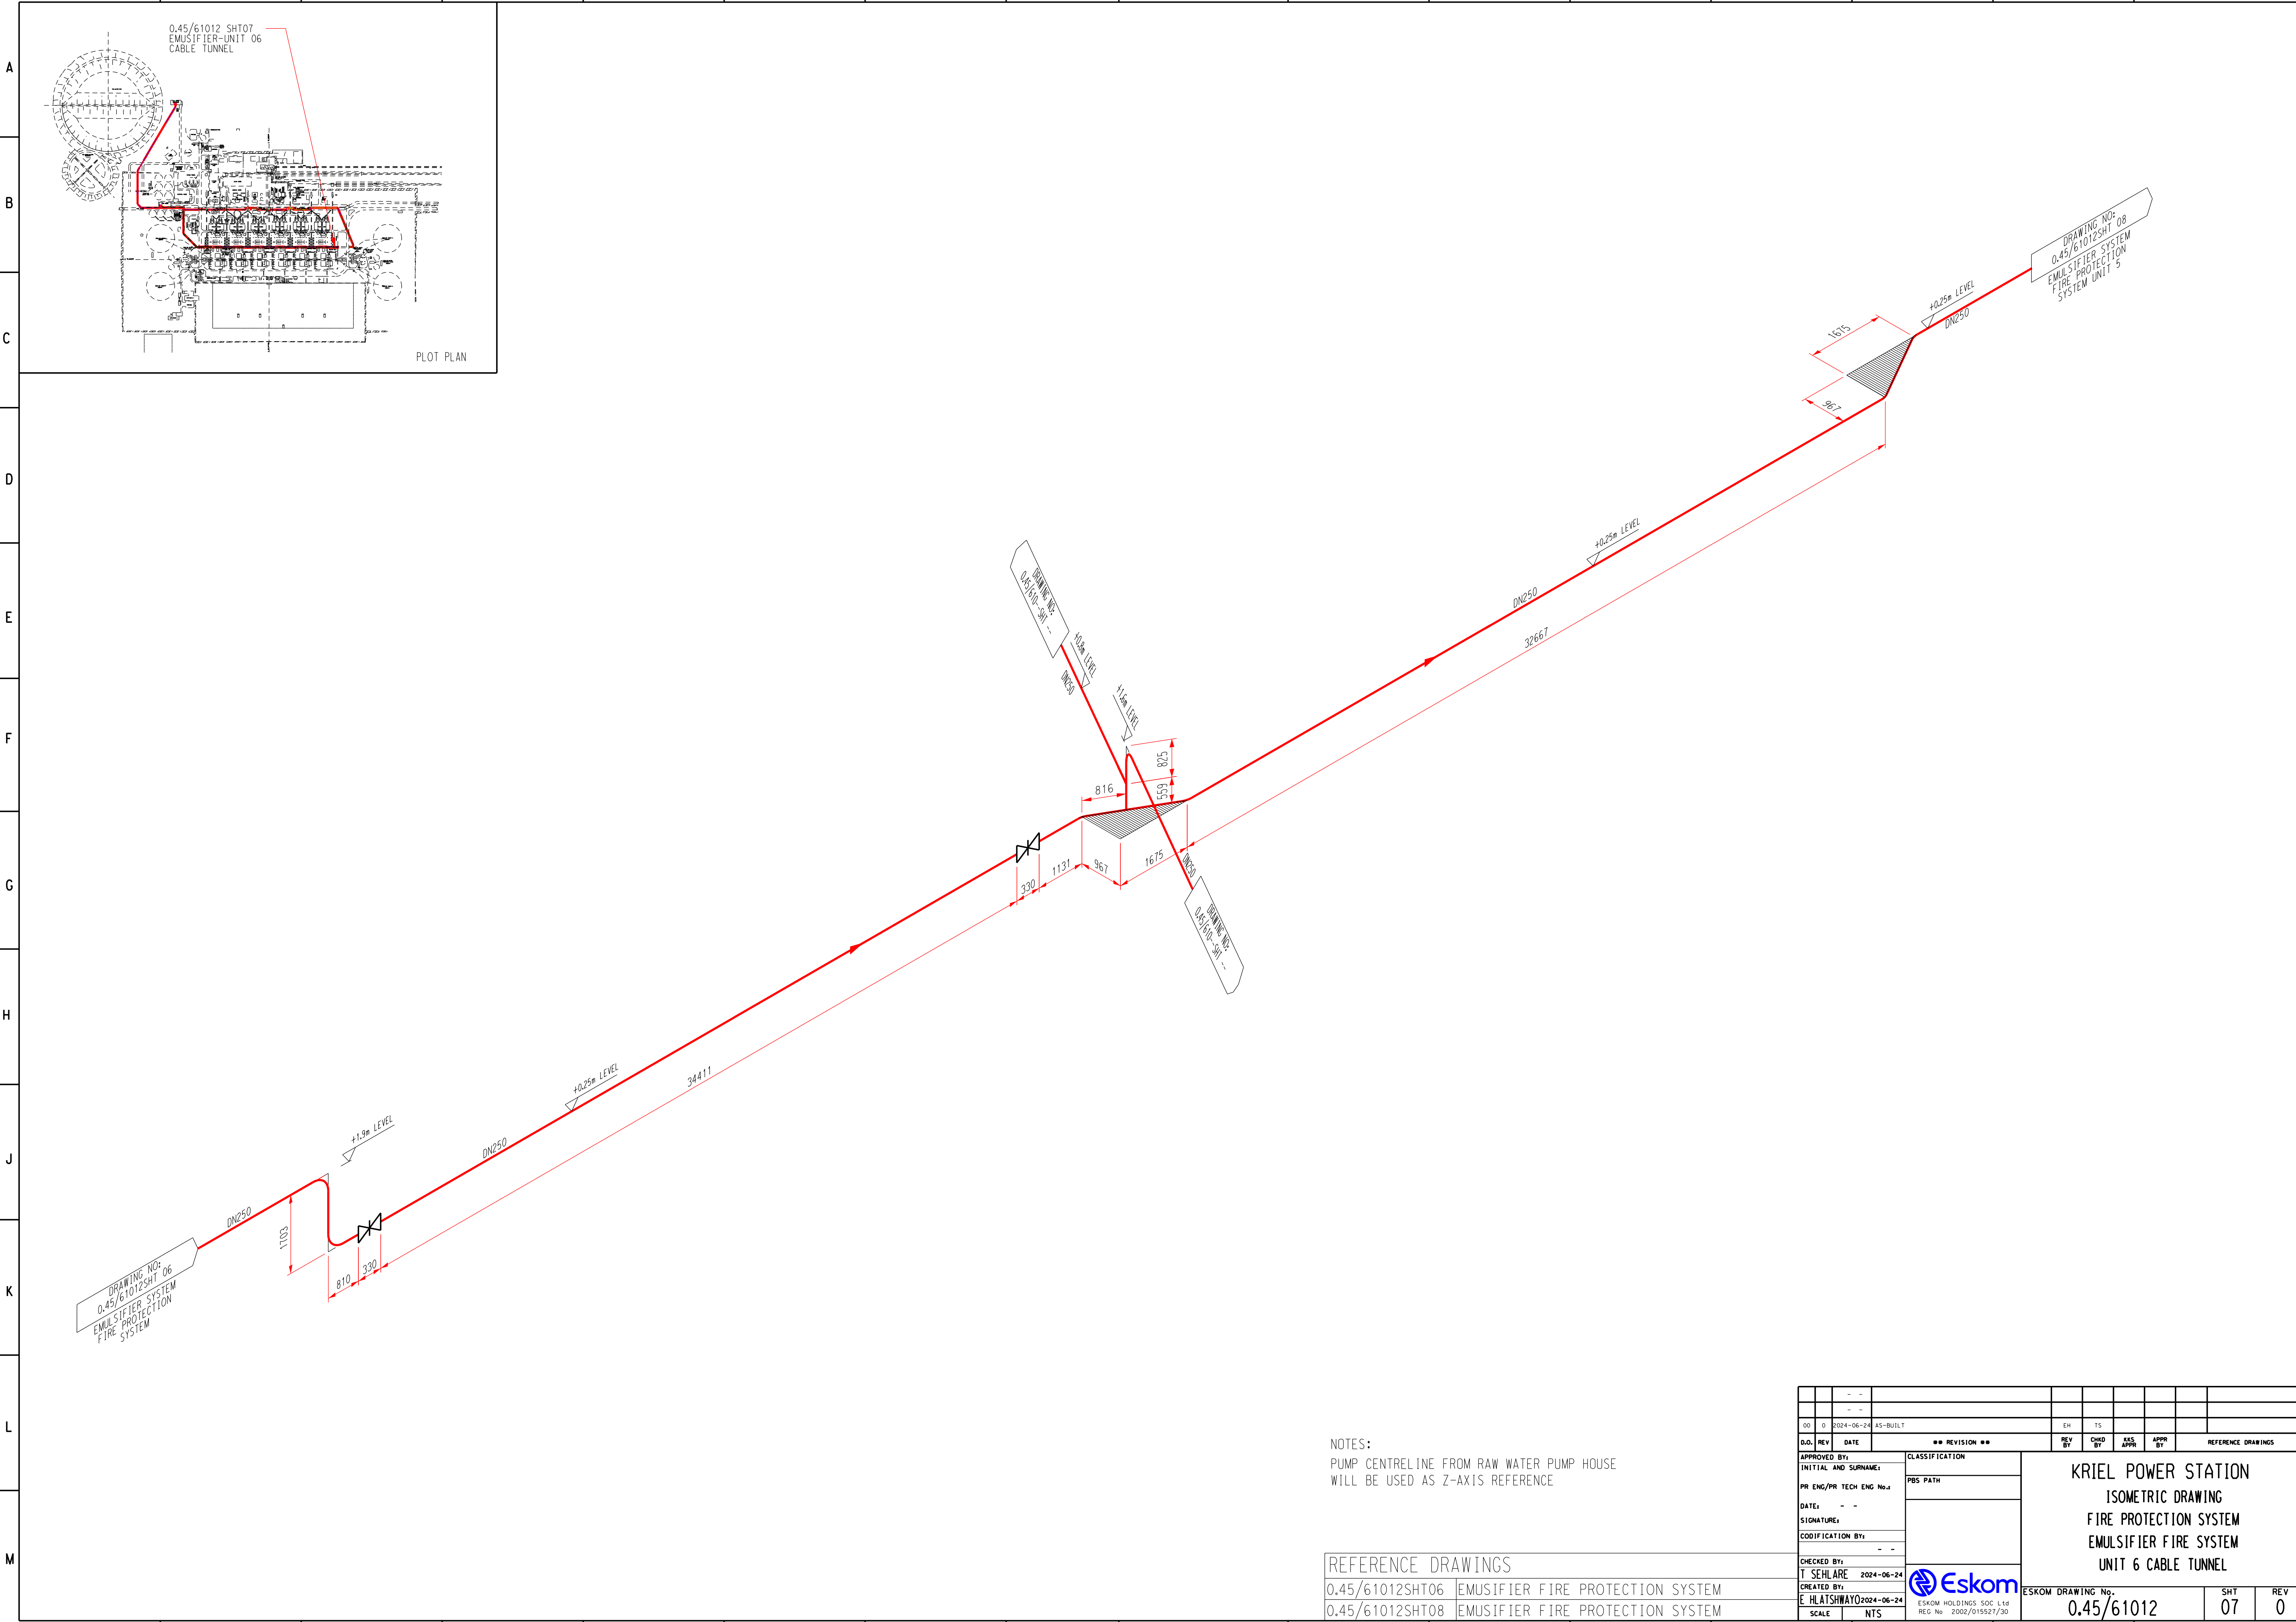

NOTES:
PUMP CENTRELINE FROM RAW WATER PUMP HOUSE
WILL BE USED AS Z-AXIS REFERENCE

REFERENCE DRAWINGS	
0.45/61012SHT06	EMULSIFIER FIRE PROTECTION SYSTEM
0.45/61012SHT08	EMULSIFIER FIRE PROTECTION SYSTEM

00		0		2024-06-24		AS-BUILT		EH		TS													
D.O.		REV		DATE		** REVISION **				REV BT		CHKD BY		HKS APPR		APPR BT		REFERENCE DRAWINGS					
APPROVED BY:						CLASSIFICATION PBS PATH KRIEL POWER STATION ISOMETRIC DRAWING FIRE PROTECTION SYSTEM EMULSIFIER FIRE SYSTEM UNIT 6 CABLE TUNNEL ESKOM DRAWING No. 0.45/61012 SHT 07 REV 0																	
INITIAL AND SURNAME:																							
PR ENG/PR TECH ENG No.:																							
DATE:																							
SIGNATURE:																							
CODIFICATION BY:																							
CHECKED BY:																							
T. SEHLARE						2024-06-24																	
CREATED BY:																							
E. HLATSHWAYO						2024-06-24		ESKOM HOLDINGS SOC LTD REG No 2002/015521/30															
SCALE		NTS																					