
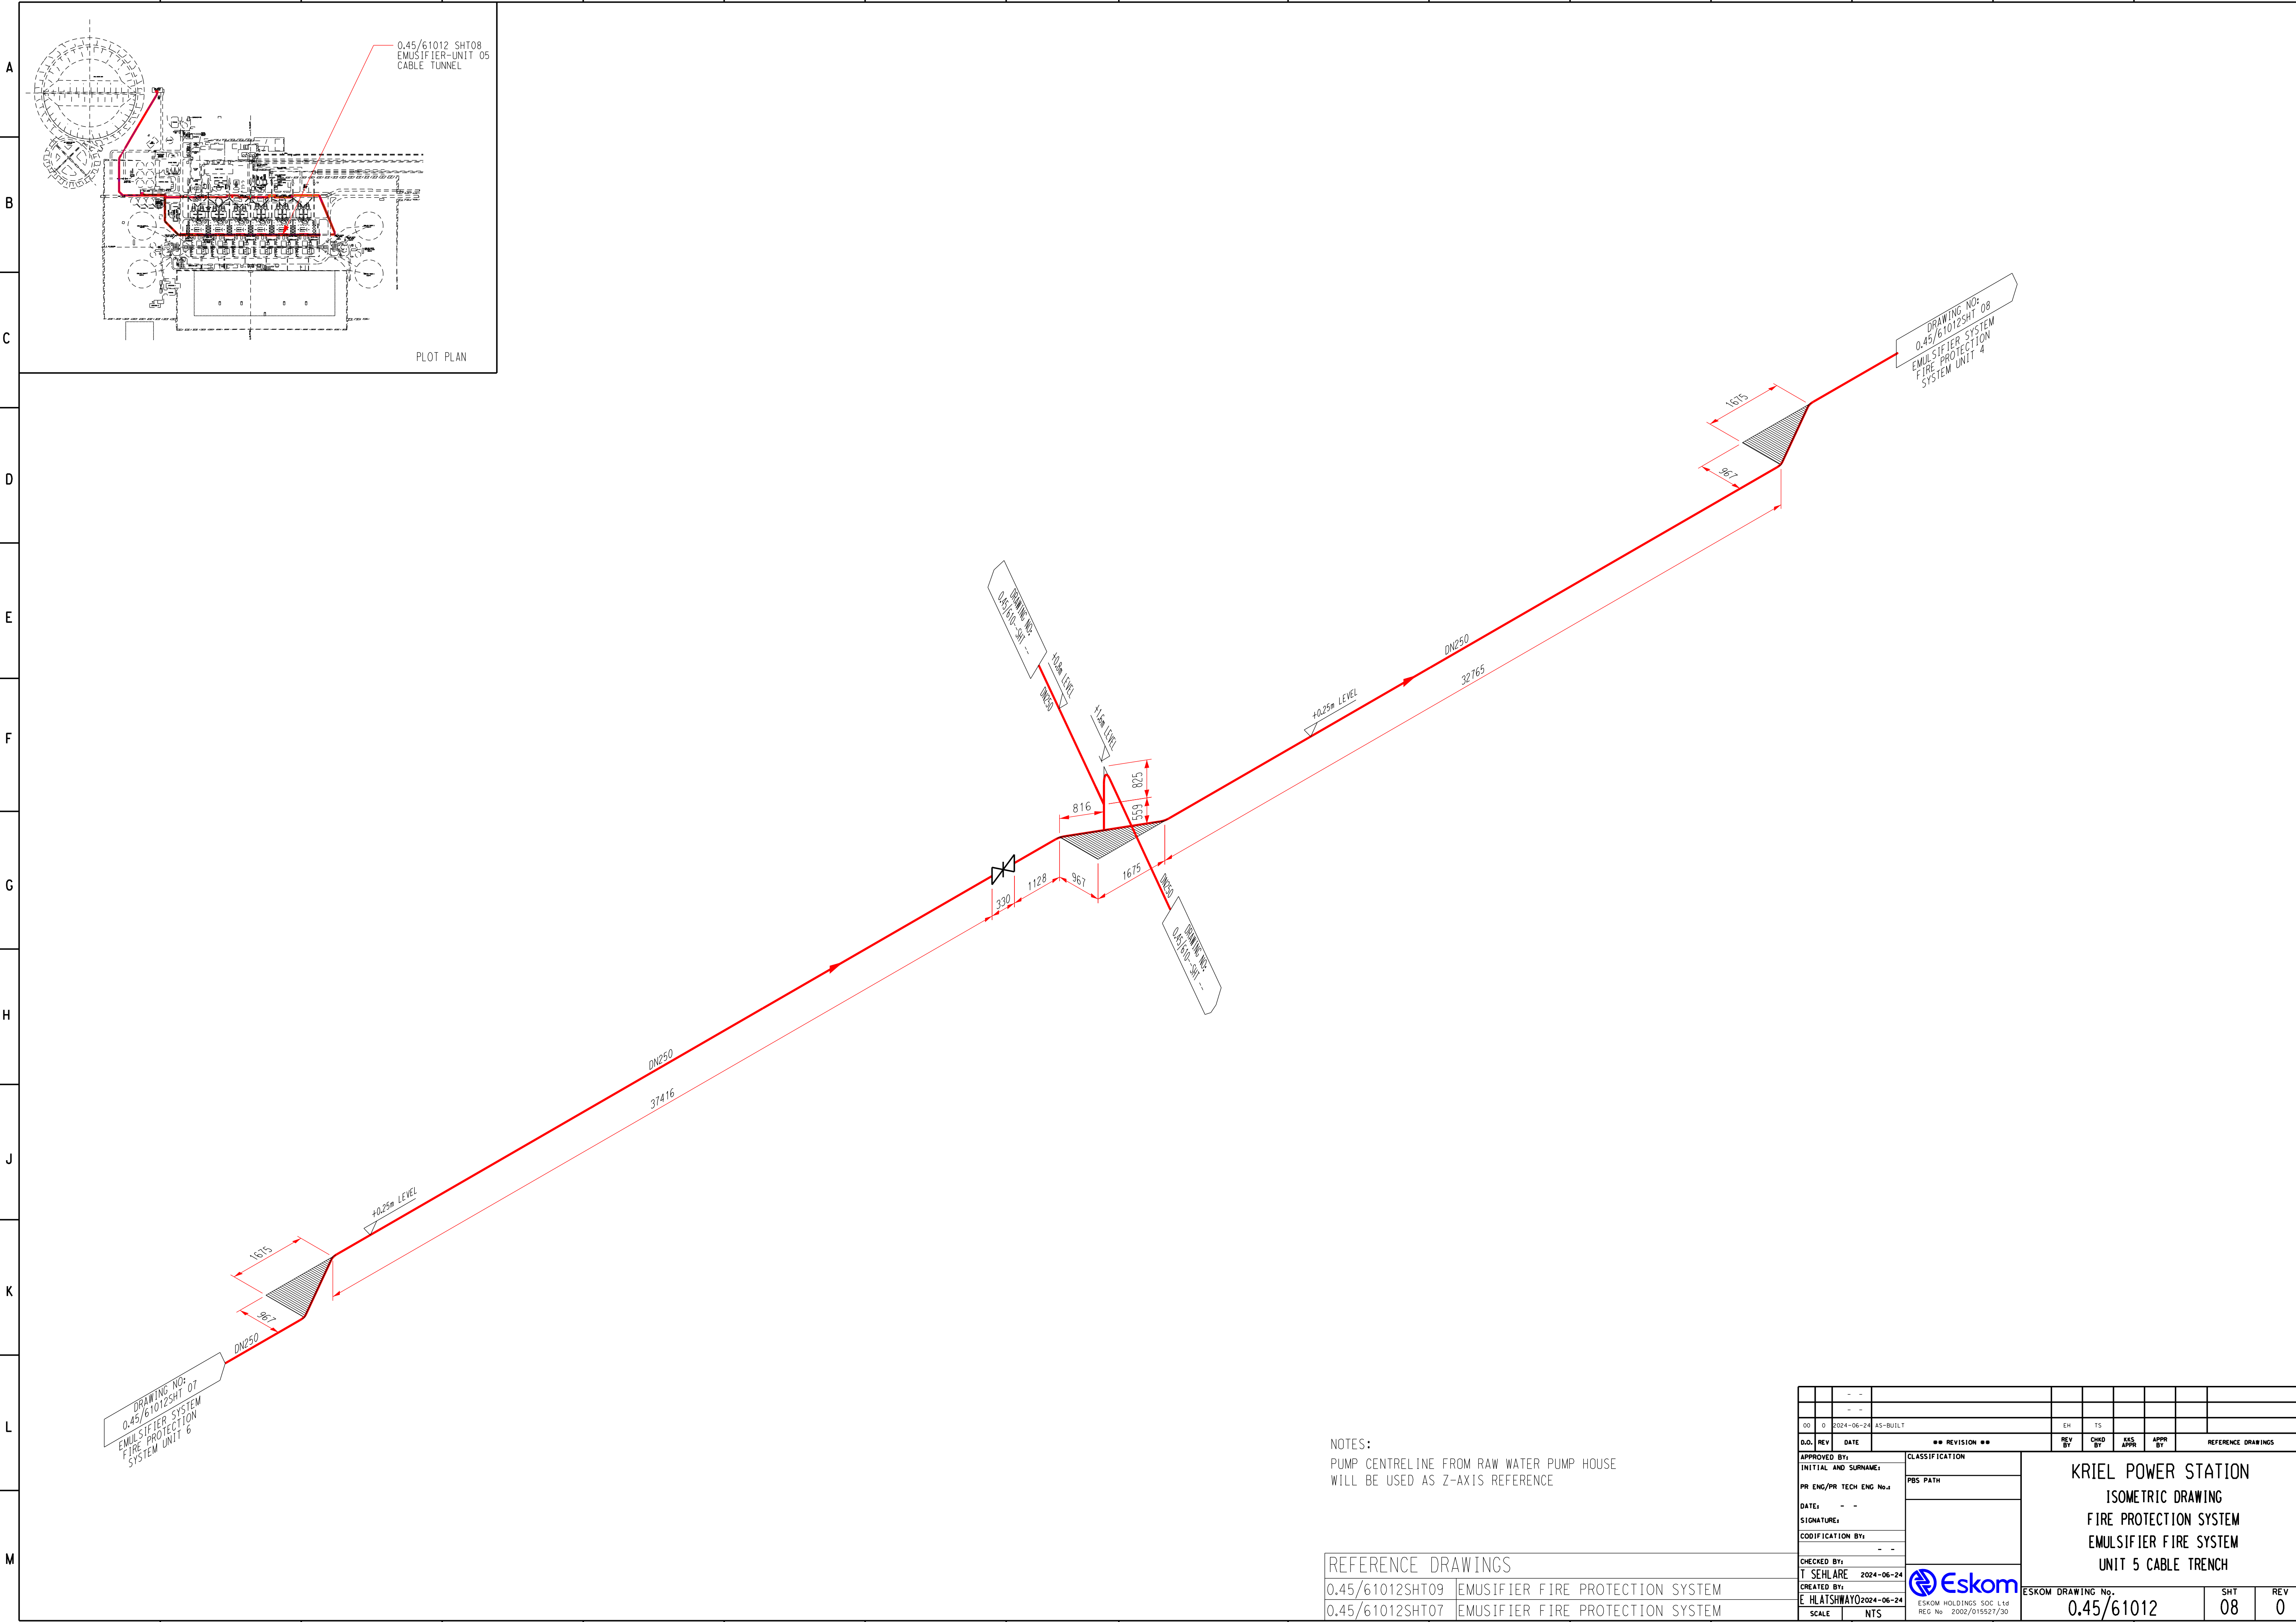


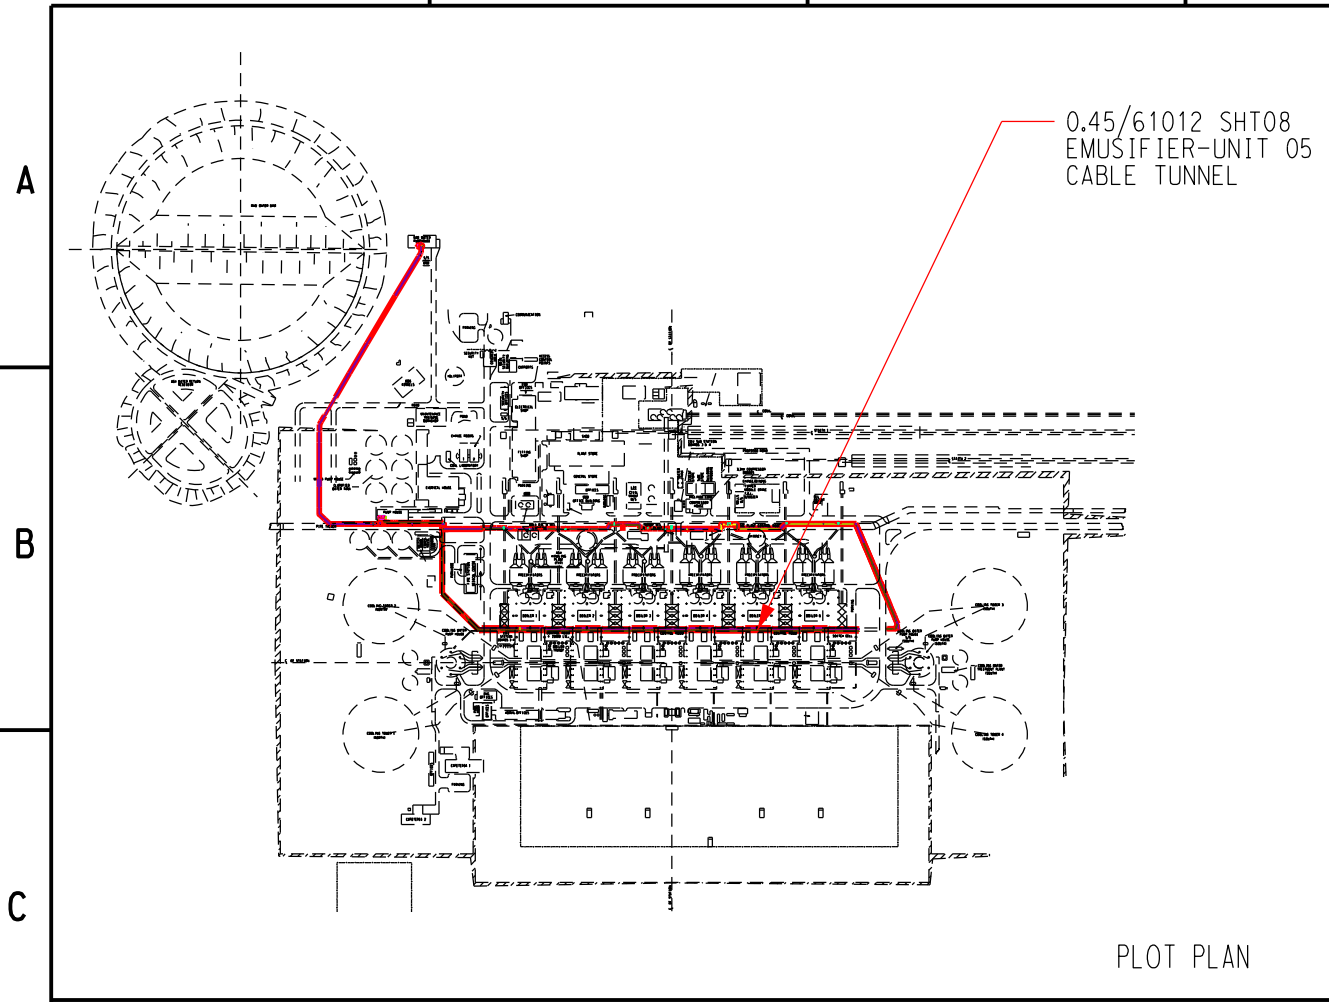

NOTES:
PUMP CENTRELINE FROM RAW WATER PUMP HOUSE
WILL BE USED AS Z-AXIS REFERENCE

REFERENCE DRAWINGS	
0.45/61012SHT09	EMULSIFIER FIRE PROTECTION SYSTEM
0.45/61012SHT07	EMULSIFIER FIRE PROTECTION SYSTEM

00	0	2024-06-24	AS-BUILT	EH	TS	KES	APPR	BY	REFERENCE DRAWINGS
APPROVED BY:		CLASSIFICATION		KRIEL POWER STATION ISOMETRIC DRAWING FIRE PROTECTION SYSTEM EMULSIFIER FIRE SYSTEM UNIT 5 CABLE TRENCH					
PR ENG/PR TECH ENG No.:		PBS PATH							
DATE:									
SIGNATURE:									
CODIFICATION BY:									
CHECKED BY:		2024-06-24		Eskom ESKOM HOLDINGS SOC. LTD REG No: 2002/015521/30					
CREATED BY:		E HLATSHWAYO							
SCALE:		NTS							
DRAWING No. 0.45/61012				SHT 08		REV 0		DRAWING CLASSIFICATION: CONTROLLED DISCLOSURE	