


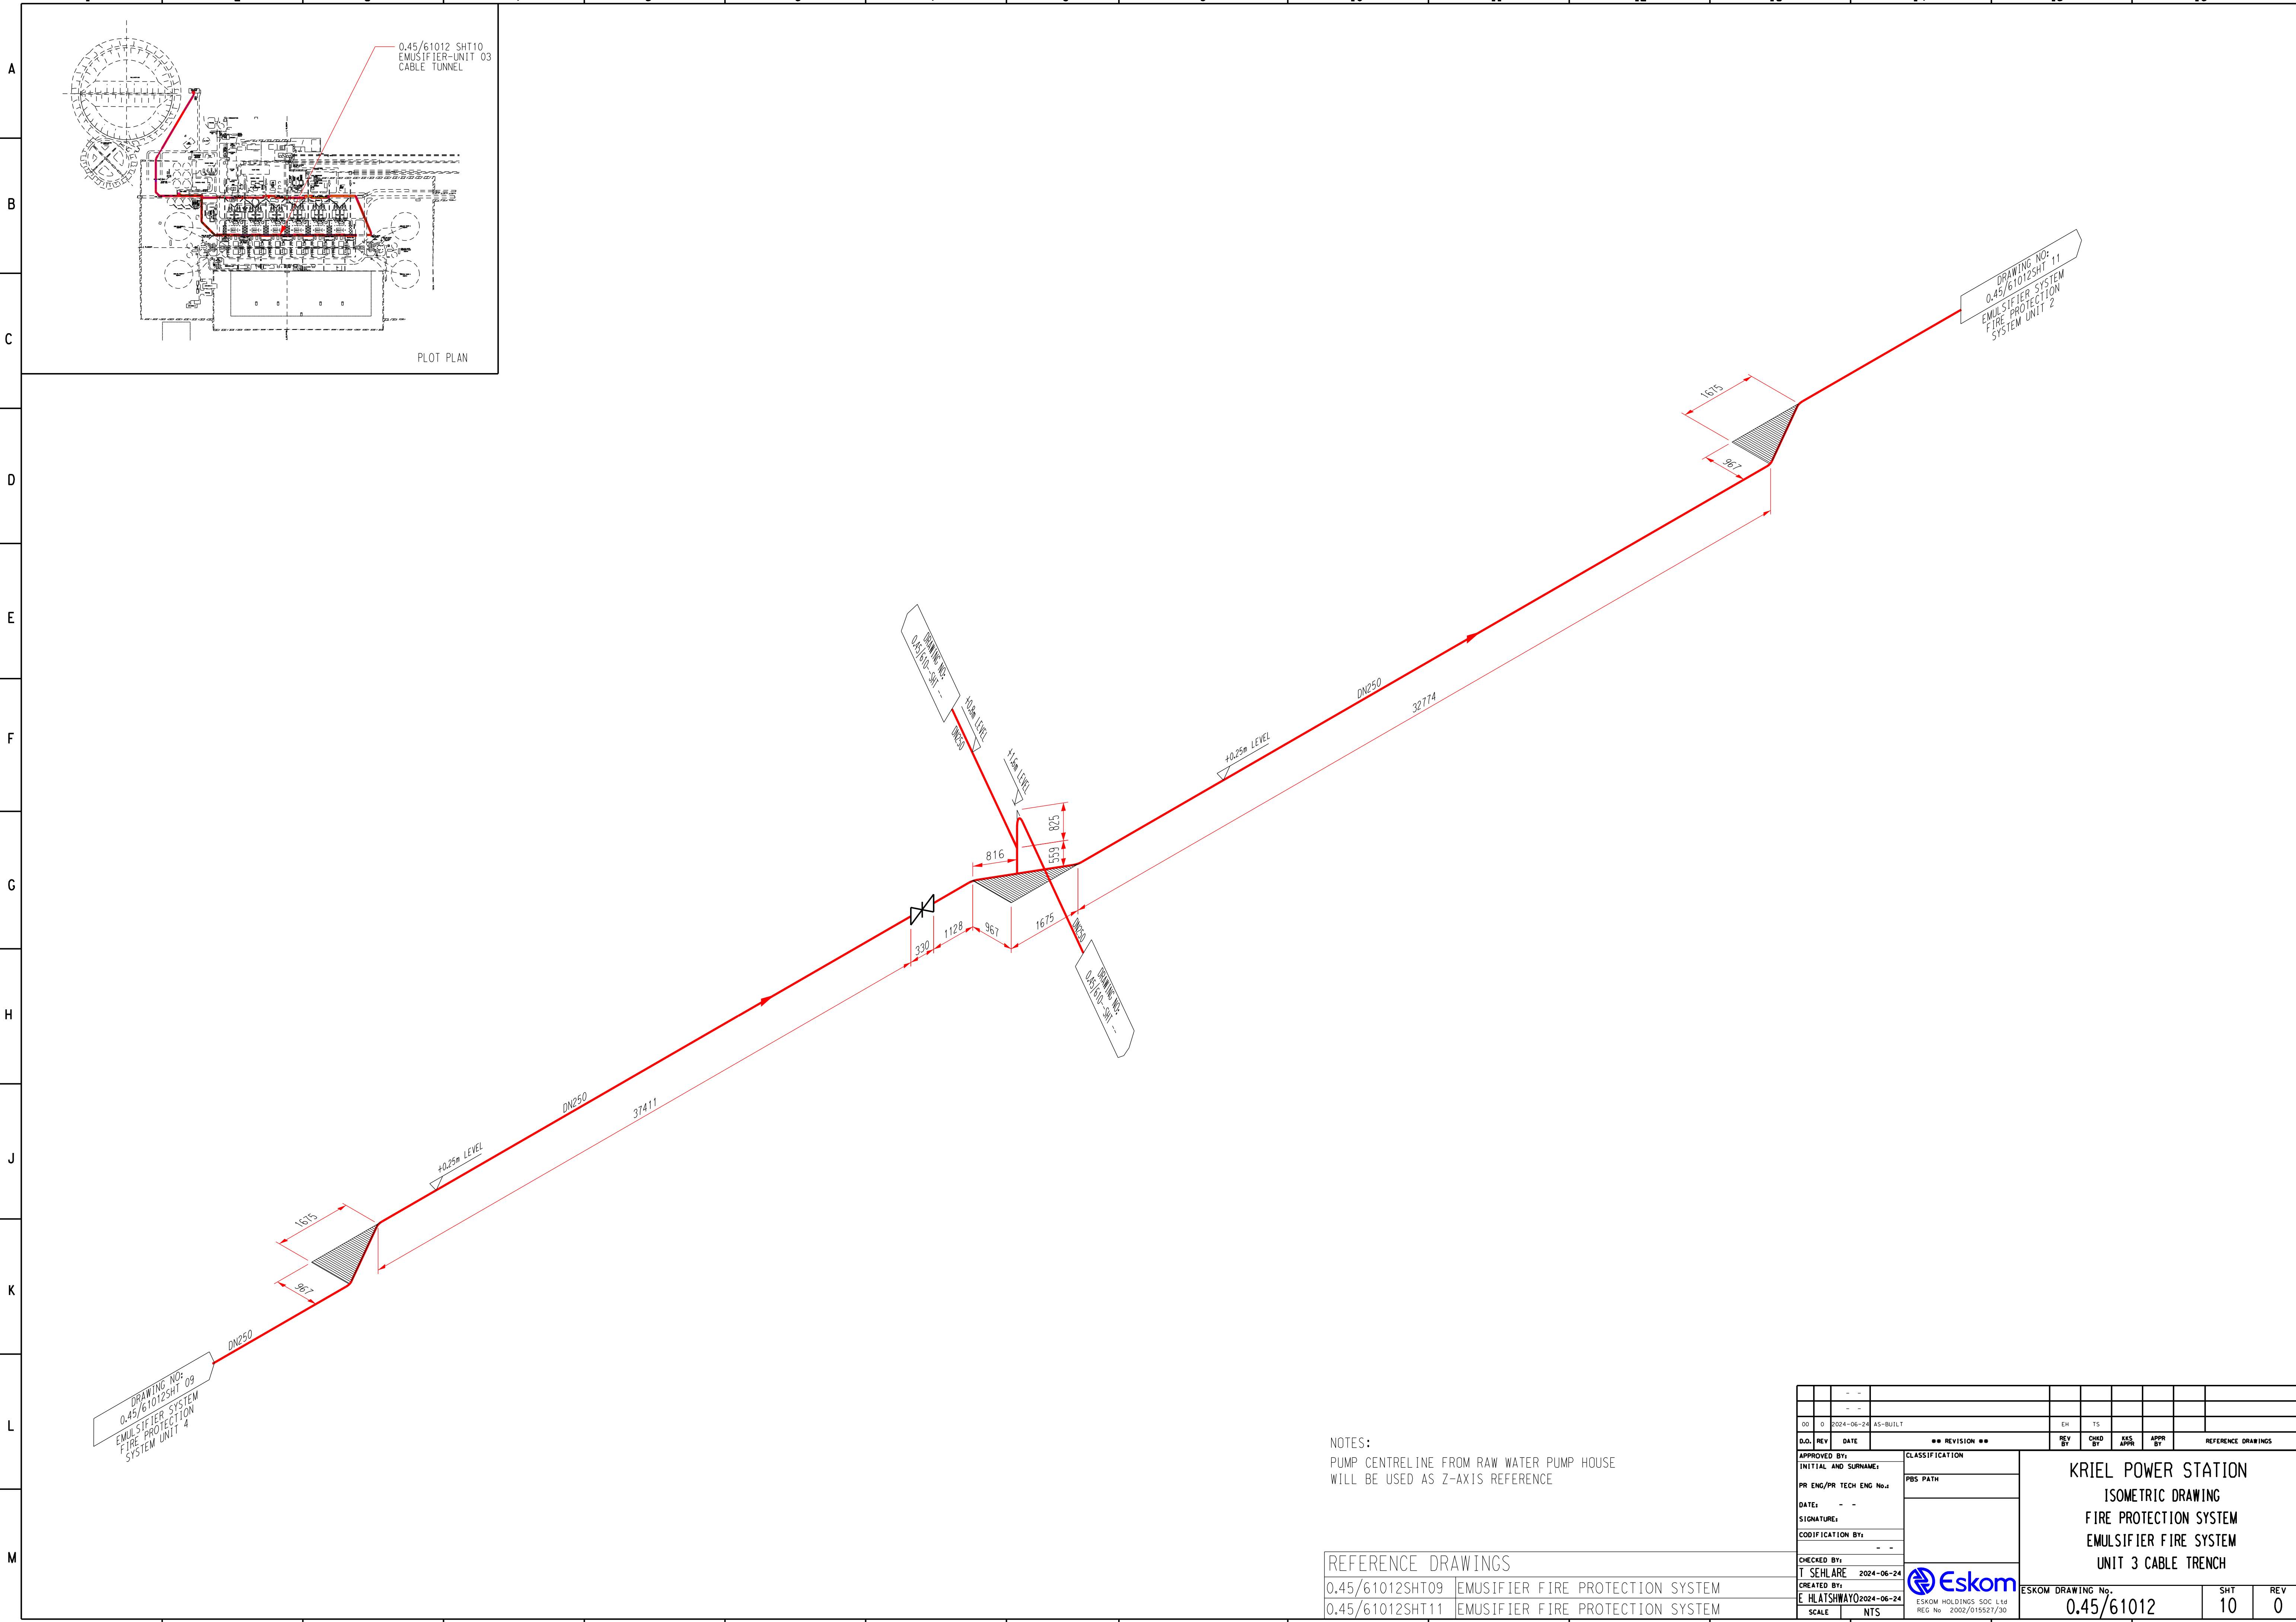

NOTES:
PUMP CENTRELINE FROM RAW WATER PUMP HOUSE
WILL BE USED AS Z-AXIS REFERENCE

REFERENCE DRAWINGS	
0.45/61012SHT09	EMUSIFIER FIRE PROTECTION SYSTEM
0.45/61012SHT11	EMUSIFIER FIRE PROTECTION SYSTEM

00		0	2024-06-24	AS-BUILT	EH	TS	KSS	APPR	BY	REFERENCE DRAWINGS	
APPROVED BY:		CLASSIFICATION		KRIEL POWER STATION		ISOMETRIC DRAWING		FIRE PROTECTION SYSTEM		EMULSIFIER FIRE SYSTEM	
PR ENG/PR TECH ENG No.:		PBS PATH		UNIT 3 CABLE TRENCH		ESKOM DRAWING No.		SHT		REV	
DATE:		2024-06-24		0.45/61012		10		0		SIZE	
SIGNATURE:		Eskom		ESKOM HOLDINGS SOC. LTD		REG No: 2002/015521/30					
CODIFICATION BY:		SCALE		NTS							
CHECKED BY:		T. SEHLARE									
CREATED BY:		E. HLATSHWAYO									