


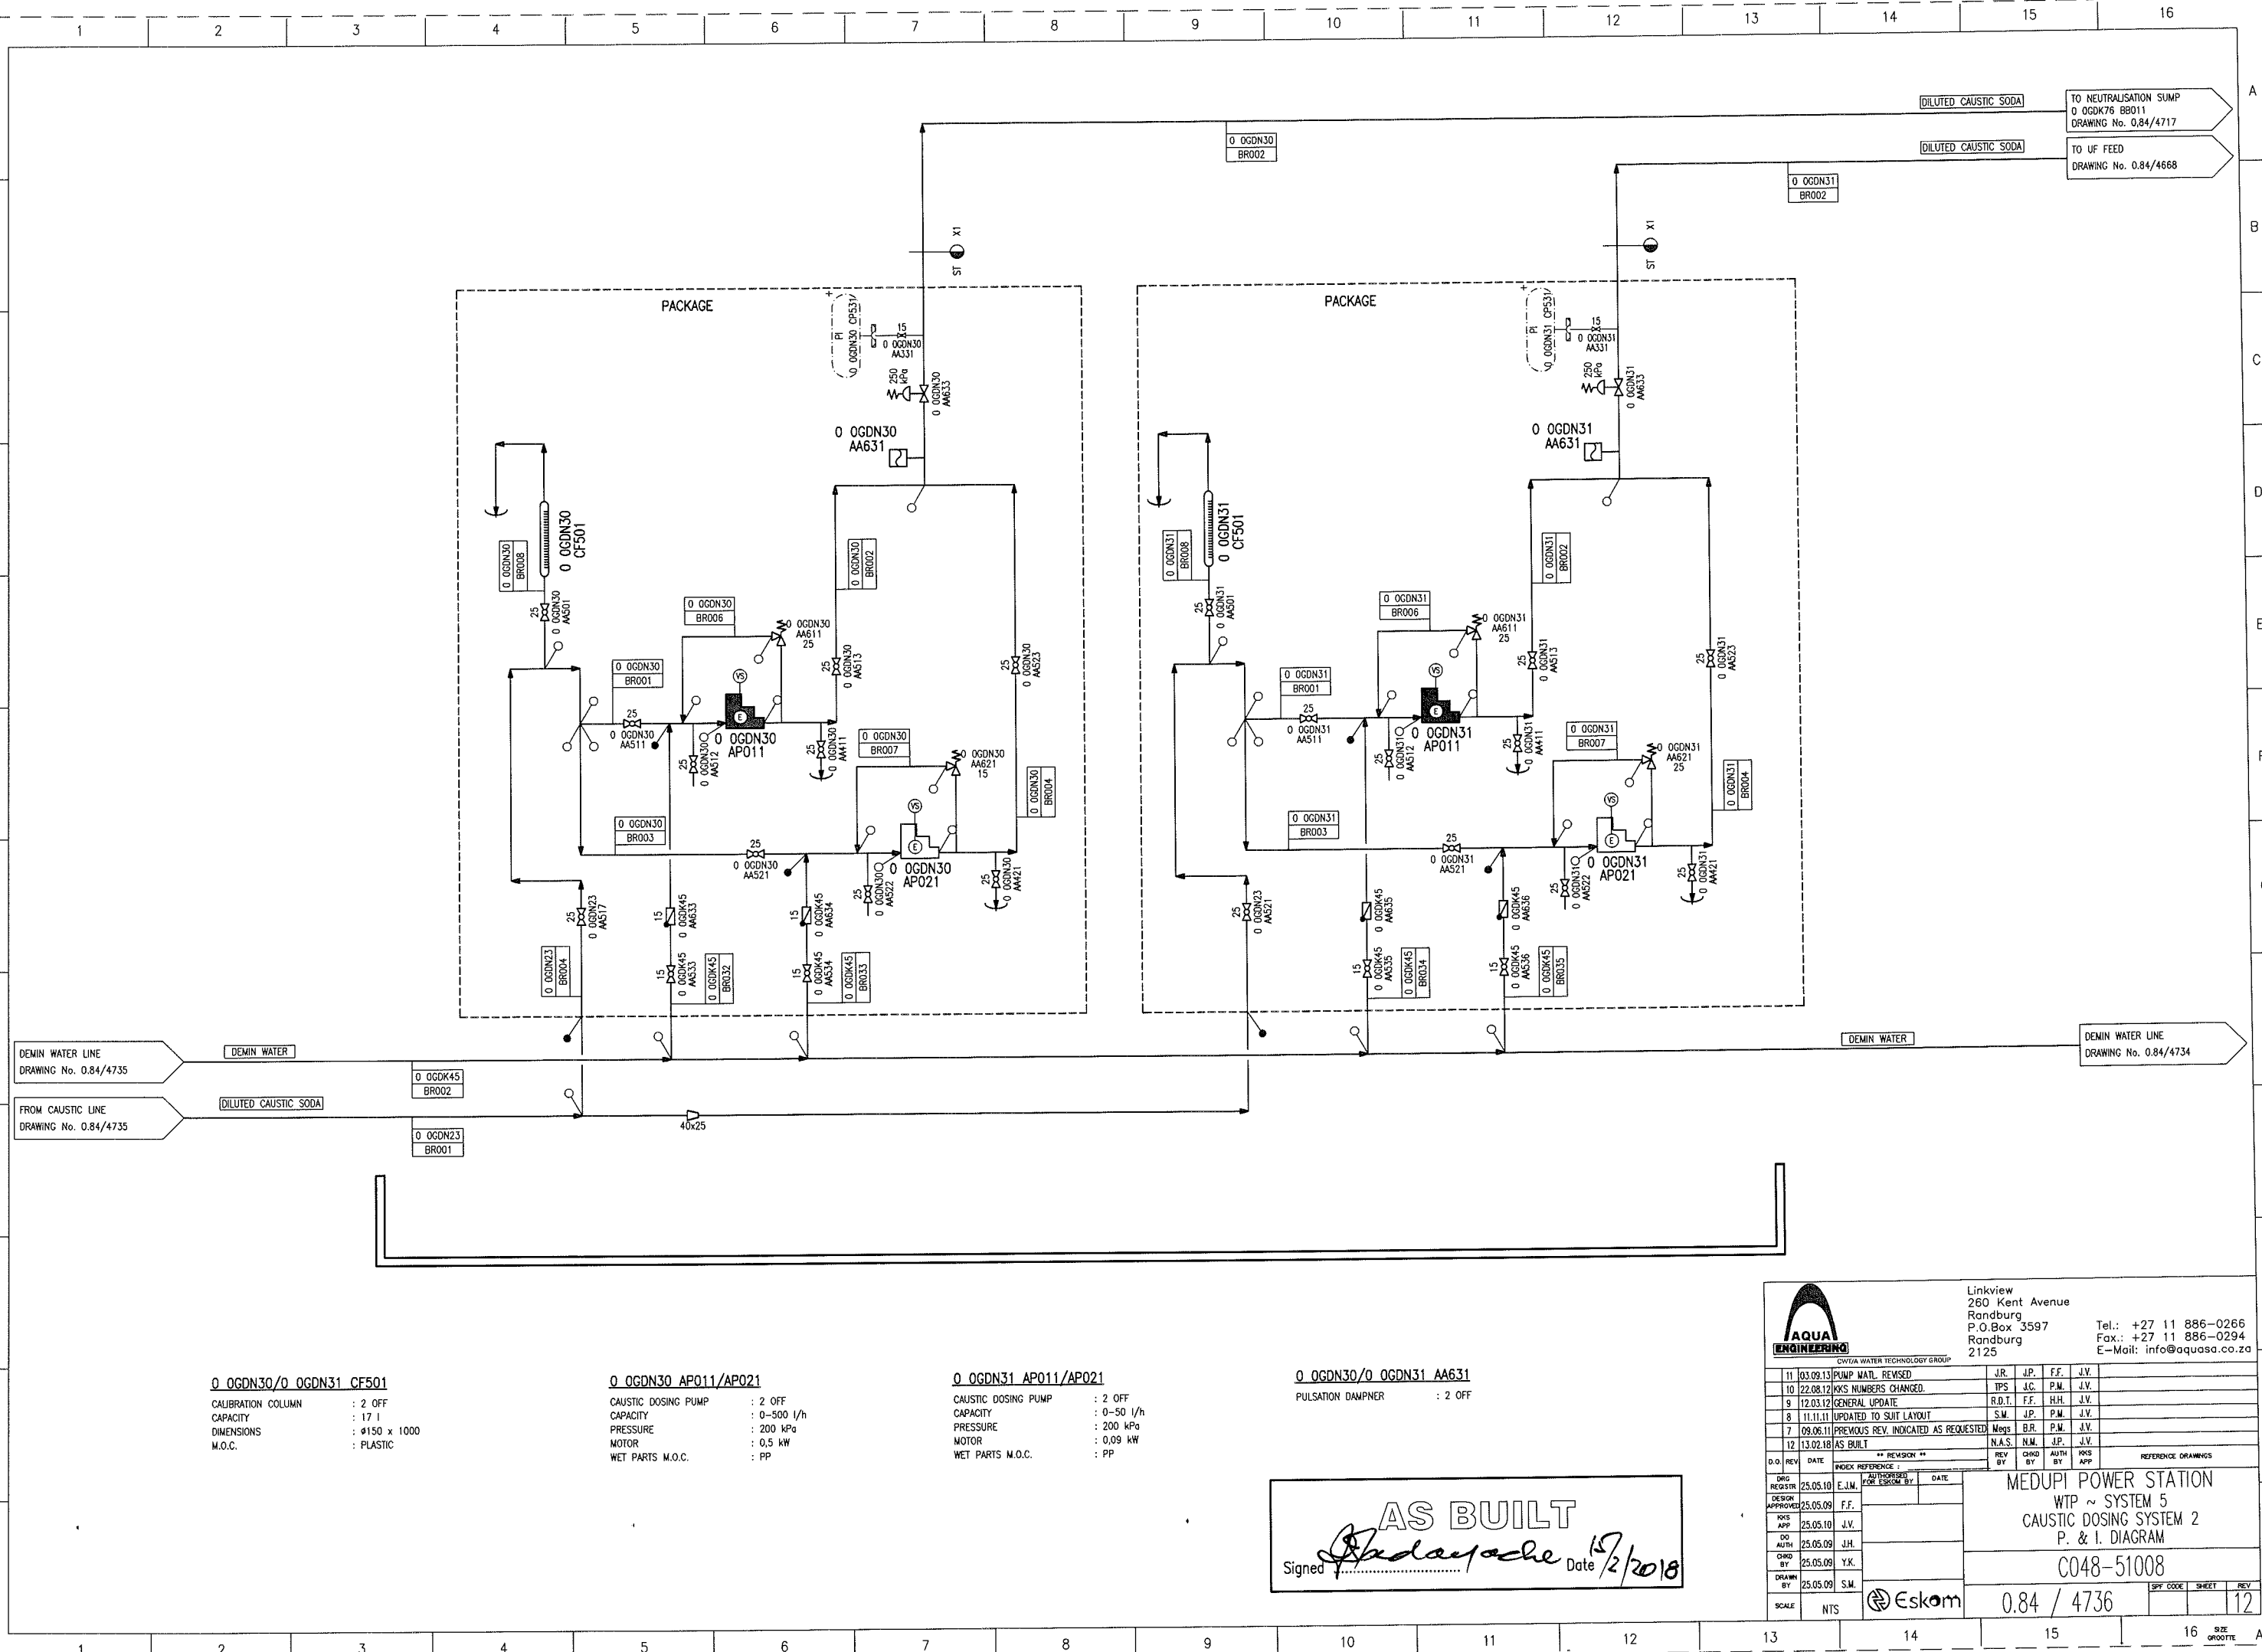

0 OGDN30/0 OGDN31 CF501
CALIBRATION COLUMN : 2 OFF
CAPACITY : 17 l
DIMENSIONS : 150 x 1000
M.O.C. : PLASTIC

0 OGDN30 AP011/AP021
CAUSTIC DOSING PUMP : 2 OFF
CAPACITY : 0-500 l/h
PRESSURE : 200 kPa
MOTOR : 0,5 kW
WET PARTS M.O.C. : PP

0 OGDN31 AP011/AP021
CAUSTIC DOSING PUMP : 2 OFF
CAPACITY : 0-50 l/h
PRESSURE : 200 kPa
MOTOR : 0,09 kW
WET PARTS M.O.C. : PP

0 OGDN30/0 OGDN31 AA631
PULSATION DAMPER : 2 OFF

AS BUILT
Signed *R. Dayache* Date *15/2/2018*



Linkview
260 Kent Avenue
Randburg
P.O.Box 3597
Randburg
2125

Tel.: +27 11 886-0266
Fax.: +27 11 886-0294
E-Mail: info@aquasa.co.za

NO.	REV.	DATE	DESCRIPTION	BY	CHKD BY	APP BY
11	03.09.13		PUMP MATL. REVISED	J.R.	J.P.	F.F.
10	22.08.12		KKS NUMBERS CHANGED	TPS	J.C.	P.M.
9	12.03.12		GENERAL UPDATE	R.D.T.	F.F.	H.H.
8	11.11.11		UPDATED TO SUIT LAYOUT	S.M.	J.P.	P.M.
7	09.06.11		PREVIOUS REV. INDICATED AS REQUESTED	N.M.	B.R.	P.M.
12	13.02.18		AS BUILT	N.A.S.	N.M.	J.P.

DESIGN APPROVED: 25.05.09 F.F.

KKS APP: 25.05.10 J.V.

DO AUTH: 25.05.09 J.H.

CHKD BY: 25.05.09 Y.K.

DRAWN BY: 25.05.09 S.M.

SCALE: NTS

MEDUPI POWER STATION
WTP ~ SYSTEM 5
CAUSTIC DOSING SYSTEM 2
P. & I. DIAGRAM

C048-51008

0.84 / 4736

SPY CODE	SHEET	REV
	12	