


NOTES / LEGEND	APPROVED
	<hr/> <p style="text-align: center;">CITY ENGINEER / CLIENT</p> <hr/> <p style="text-align: right;">AMEN</p> <hr/> <p>A,B,C.. / : BEFORE TENDER / APPROVAL T0 / : TENDER DRAWING 1,2,3... / : AFTER TENDER Z / : AS BUILT</p>

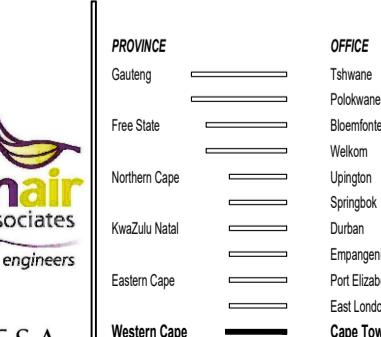


APPROVED PORT ENGINEER (B NGCOBO Pr ENG) DATE _____	APPROVED ELECTRICAL MANAGER (R REDDY) DATE _____	APPROVED MANAGER CIVIL MAINTENANCE (N KHUMALO) DATE _____	APPROVED PORT FACILITIES MANAGER (P MISRA) DATE _____
APPROVAL DOES NOT INDICATE ACCEPTANCE OF ANY RESPONSIBILITY FOR SAFETY OR ADEQUACY OF STRUCTURES	APPROVAL DOES NOT INDICATE ACCEPTANCE OF ANY RESPONSIBILITY FOR SAFETY OR ADEQUACY OF STRUCTURES	APPROVAL DOES NOT INDICATE ACCEPTANCE OF ANY RESPONSIBILITY FOR SAFETY OR ADEQUACY OF STRUCTURES	APPROVAL DOES NOT INDICATE ACCEPTANCE OF ANY RESPONSIBILITY FOR SAFETY OR ADEQUACY OF STRUCTURES
PROJECT RICHARDS BAY - PORT CONTROL TOWER		APPROVED BY BVi  970 672 07/07/2020 ENGINEER/TECHNOLOGIST REG. NO. DATE SCALE AS SHOWN @ A1 DRAWN DA DESIGNED BJ CHECKED LP PLAN NUMBER REVISION NO. DATE SAVED 32442.00-201-11 5 Thursday, 09 July 2020	
DRAWING TITLE NEW THIRD FLOOR			
E-MAIL pla@bvigp.co.za js@bvilp.co.za bfm@bvfis.co.za wel@bvfis.co.za upt@bvinc.co.za spk@bvinc.co.za dbn@bvkln.co.za emp@bvkln.co.za bvioc@mweb.co.za Bk@bvioc.co.za cpt@bviwc.co.za			

RICHARDS BAY - PORT CONTROL TOWER

NEW THIRD FLOOR

32442.00-201-08 10 12 SIRUCURAL REV4.DWG

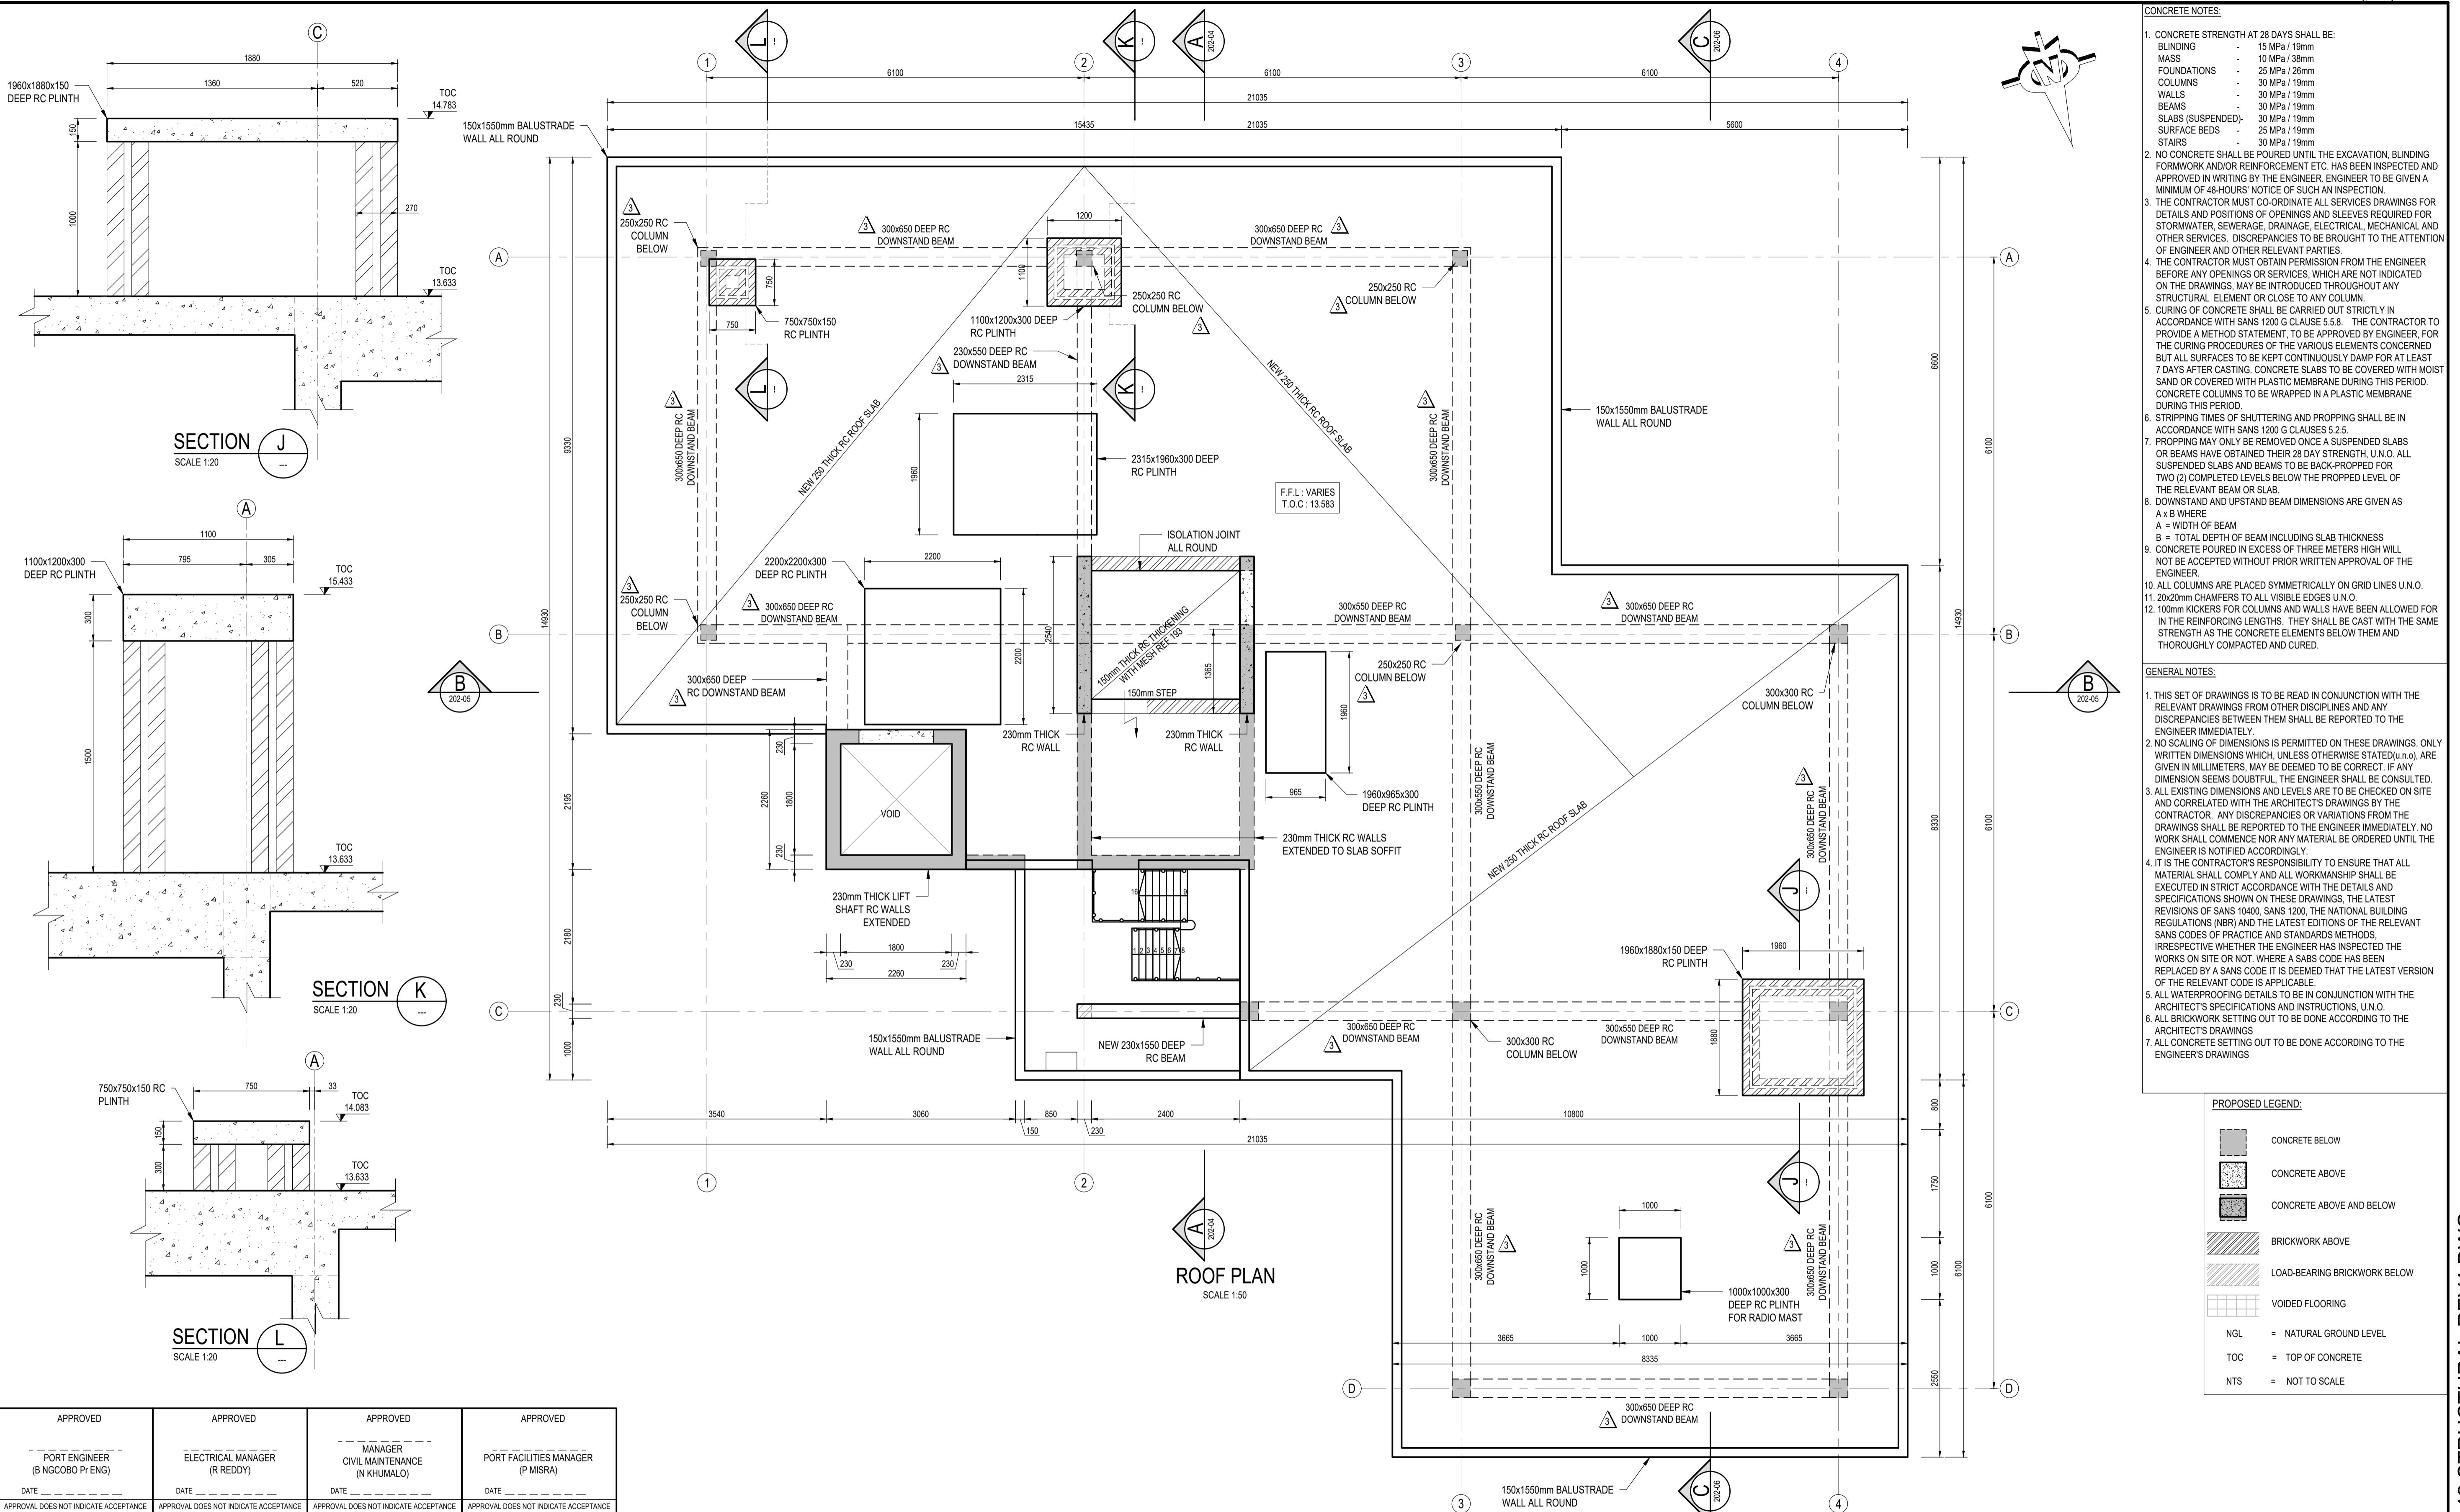

APPROVED PORT ENGINEER (B NGCOBO Pr ENG) DATE _____	APPROVED ELECTRICAL MANAGER (R REDDY) DATE _____	APPROVED MANAGER CIVIL MAINTENANCE (N KHUMALO) DATE _____	APPROVED PORT FACILITIES MANAGER (P MISRA) DATE _____
APPROVAL DOES NOT INDICATE ACCEPTANCE OF ANY RESPONSIBILITY FOR SAFETY OR ADEQUACY OF STRUCTURES	APPROVAL DOES NOT INDICATE ACCEPTANCE OF ANY RESPONSIBILITY FOR SAFETY OR ADEQUACY OF STRUCTURES	APPROVAL DOES NOT INDICATE ACCEPTANCE OF ANY RESPONSIBILITY FOR SAFETY OR ADEQUACY OF STRUCTURES	APPROVAL DOES NOT INDICATE ACCEPTANCE OF ANY RESPONSIBILITY FOR SAFETY OR ADEQUACY OF STRUCTURES

NOTES / LEGEND	APPROVED BY COUNCIL / CLIENT
	<hr/> <div style="display: flex; justify-content: space-between;"> <div style="text-align: center;"> CITY ENGINEER / CLIENT </div> <div style="text-align: center;"> REG. NO. </div> <div style="text-align: center;"> DATE </div> </div> <hr/> <div style="text-align: center;"> AMENDMENTS CODE </div> <hr/> <div style="display: flex; justify-content: space-between;"> <div style="width: 50%;"> A,B,C.../ : BEFORE TENDER / APPROVAL 0 / : TENDER DRAWING 1,2,3.../ : AFTER TENDER Z / : AS BUILT </div> <div style="width: 50%;"> /A : BY CLIENT /B : BY ARCHITECT /C : BY MECHANICAL OR ELECTRICAL /D : BY BV /E : BY OTHER / ... </div> </div>



Visit or contact us online at

at www.bvigroup.co.za

- 1 -

1

1


32442

2.00-20










1-12

1-12

32442.00-201-08 10 '25 | RUC | URAL REV4.DWG

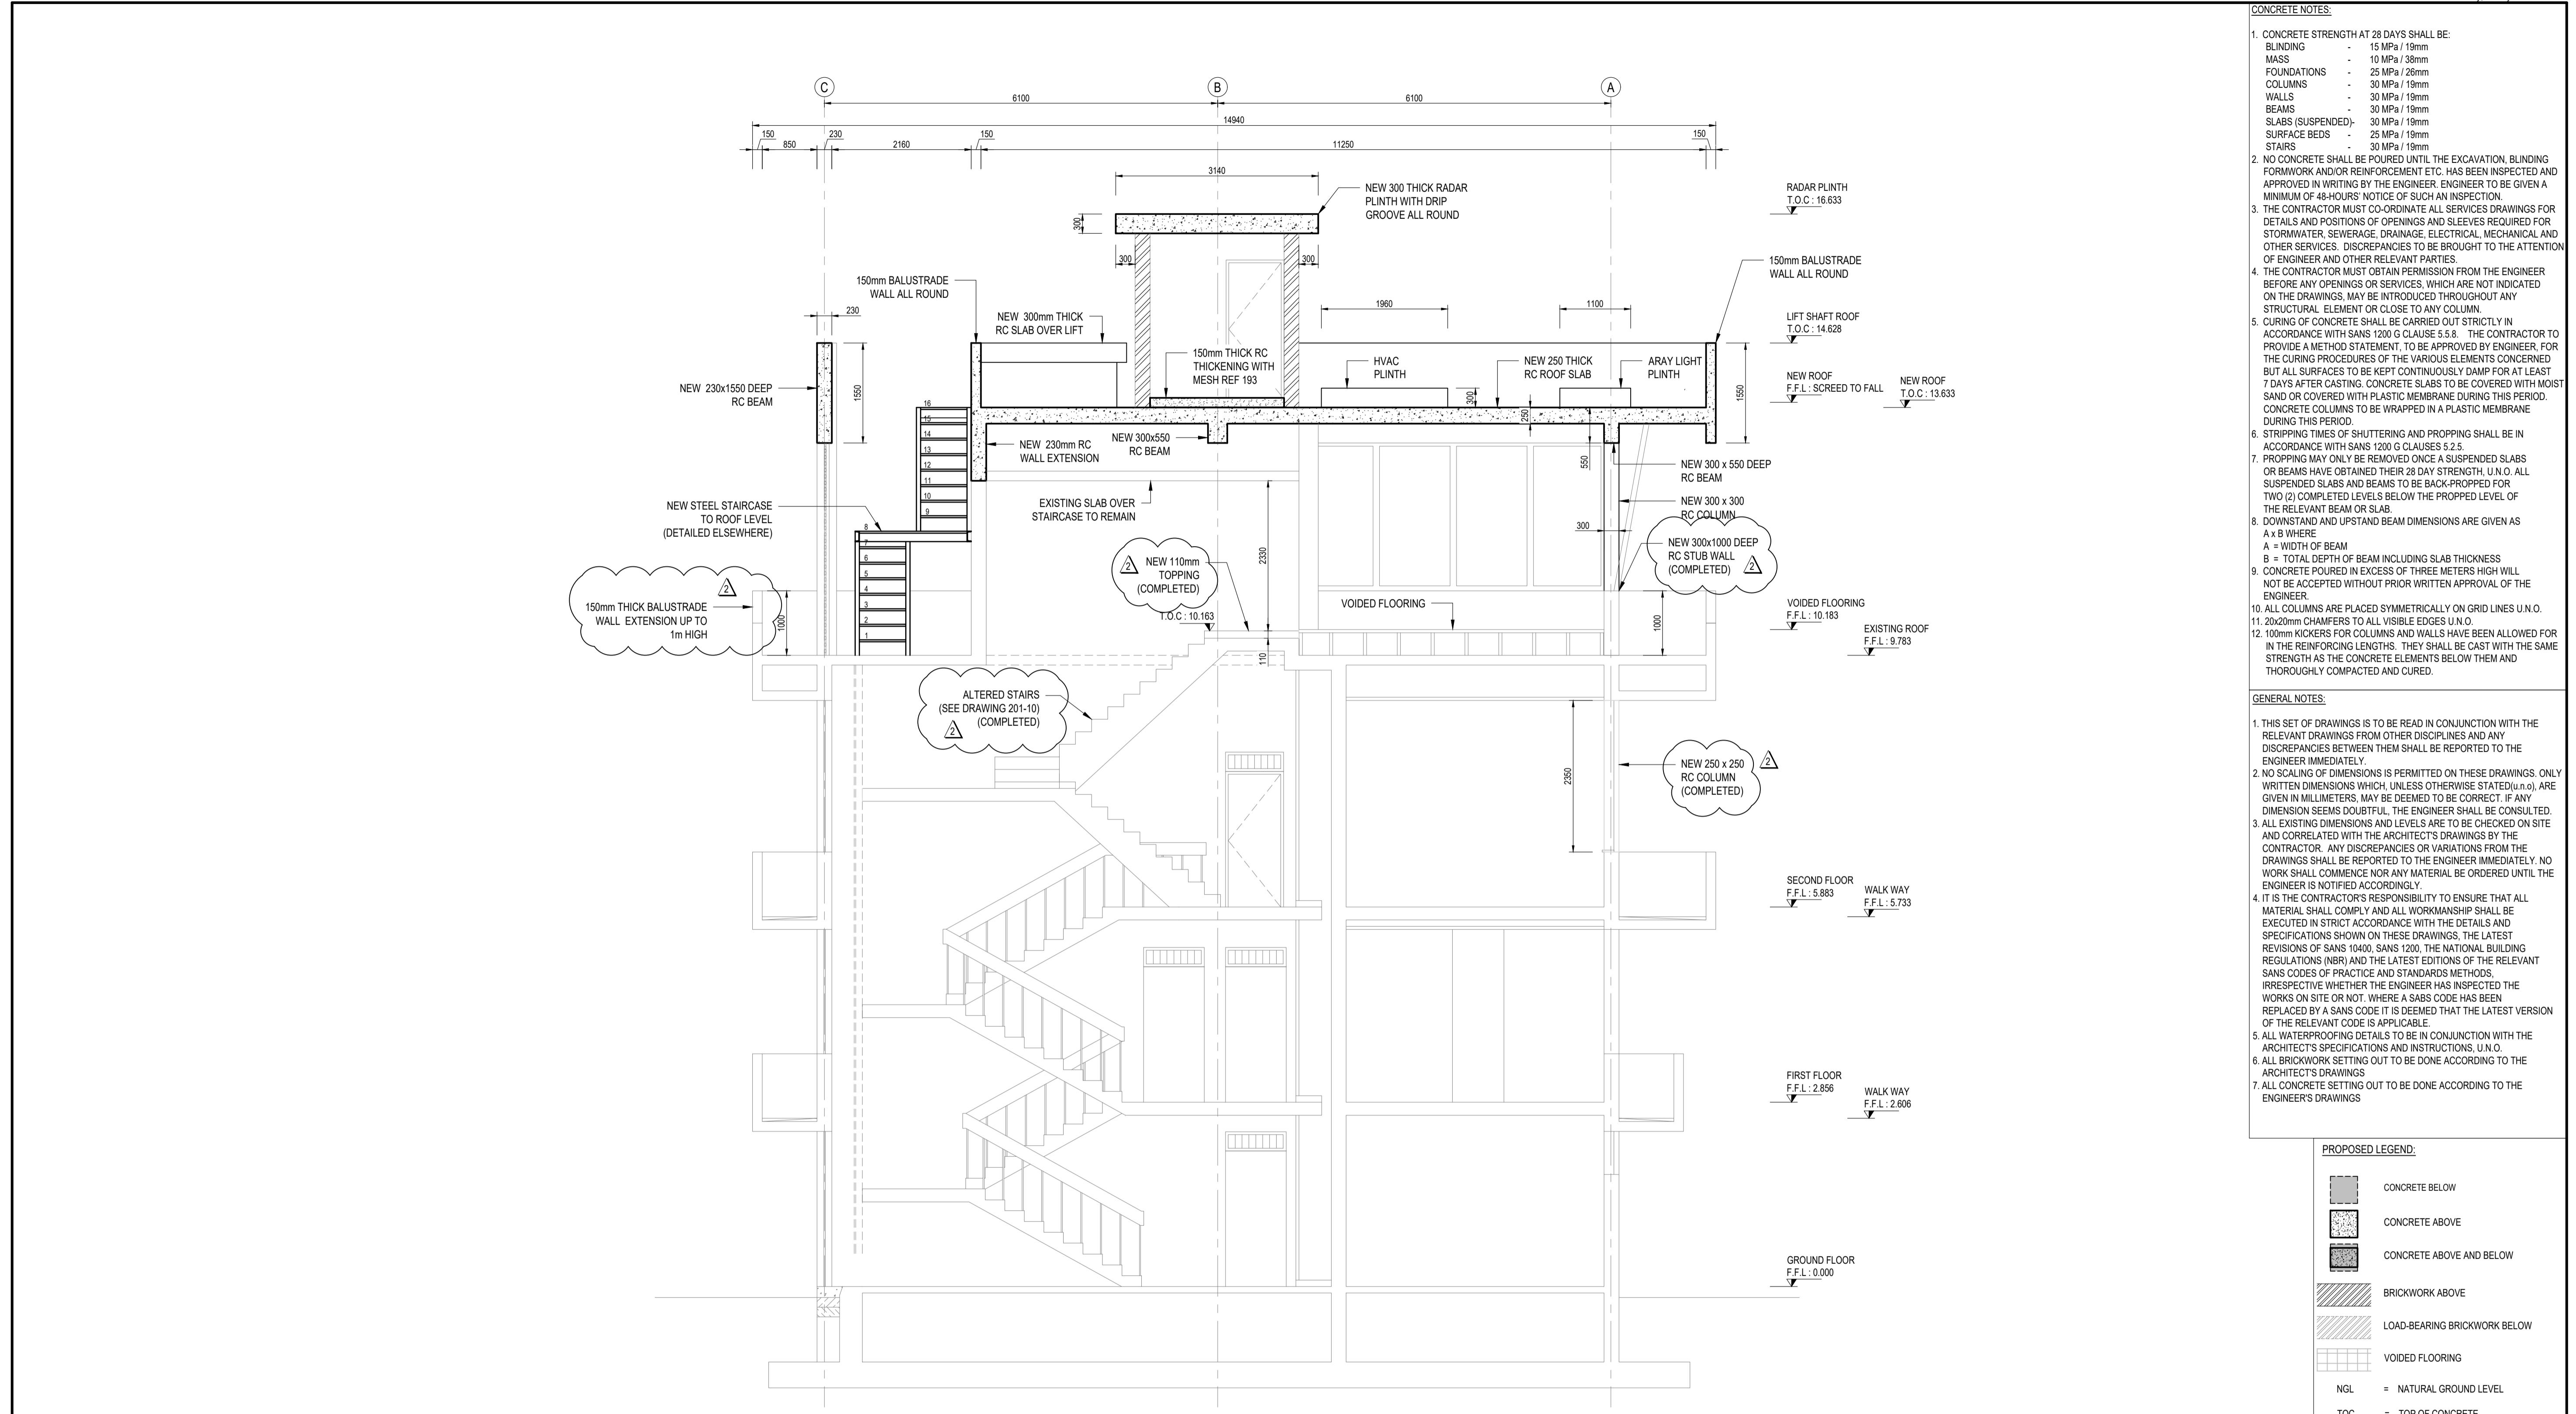

APPROVED ----- PORT ENGINEER (B NGCOBO Pr ENG) DATE -----	APPROVED ----- ELECTRICAL MANAGER (R REDDY) DATE -----	APPROVED ----- MANAGER CIVIL MAINTENANCE (N KHUMALO) DATE -----	APPROVED ----- PORT FACILITIES MANAGER (P MISRA) DATE -----
APPROVAL DOES NOT INDICATE ACCEPTANCE OF ANY RESPONSIBILITY FOR SAFETY OR ADEQUACY OF STRUCTURES	APPROVAL DOES NOT INDICATE ACCEPTANCE OF ANY RESPONSIBILITY FOR SAFETY OR ADEQUACY OF STRUCTURES	APPROVAL DOES NOT INDICATE ACCEPTANCE OF ANY RESPONSIBILITY FOR SAFETY OR ADEQUACY OF STRUCTURES	APPROVAL DOES NOT INDICATE ACCEPTANCE OF ANY RESPONSIBILITY FOR SAFETY OR ADEQUACY OF STRUCTURES

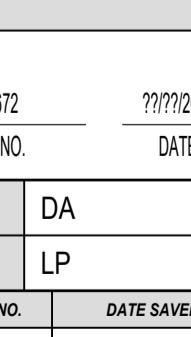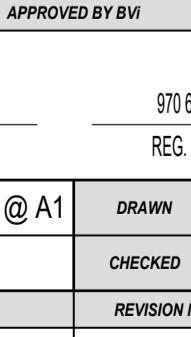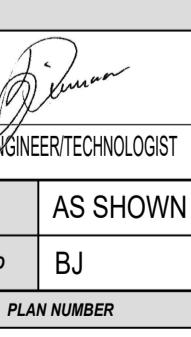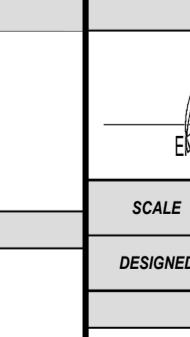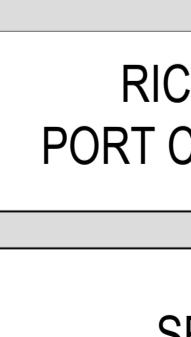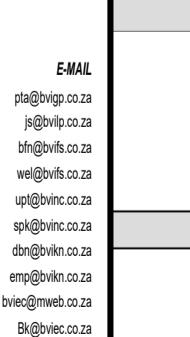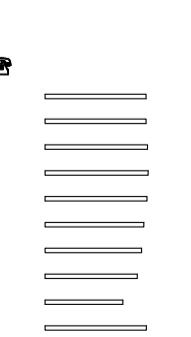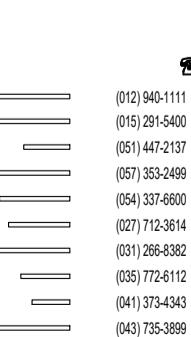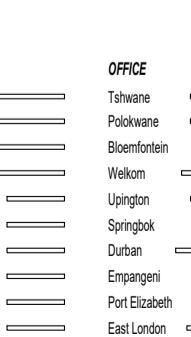


PROJECT

RICHARDS BAY - PORT CONTROL TOWER

DRAWING TITLE

SECTION A A

SECTION A A

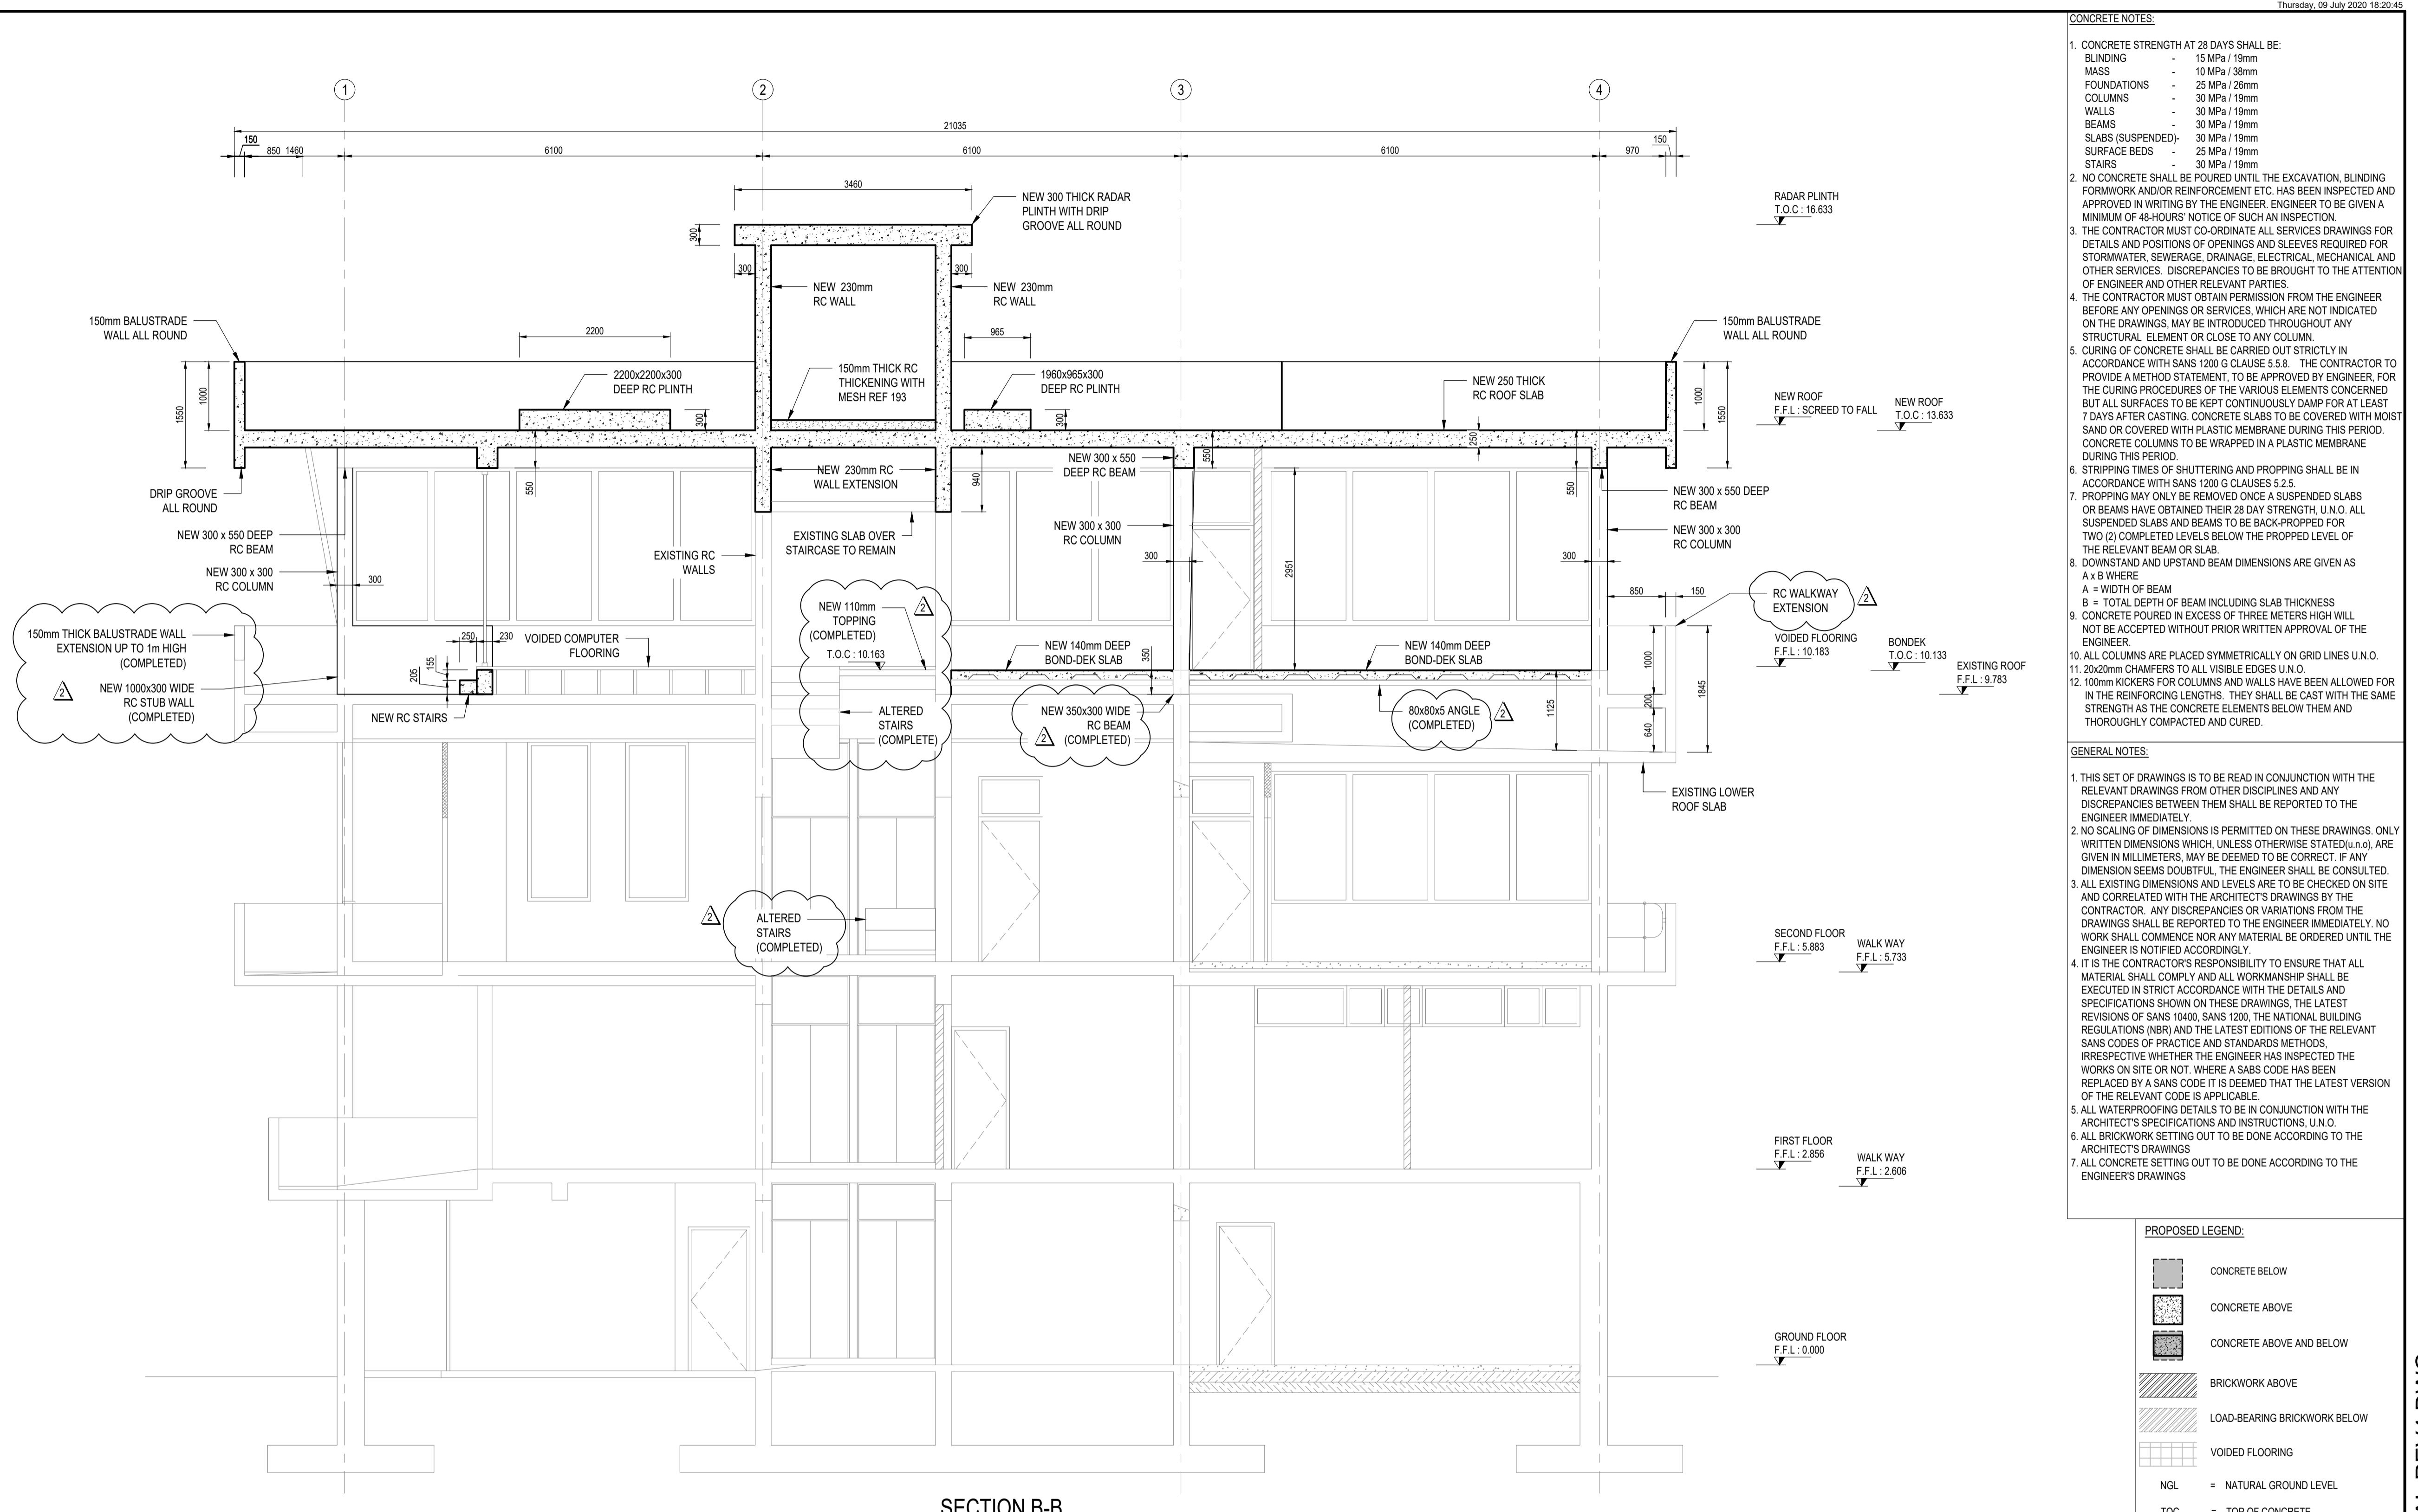

APPROVED ----- PORT ENGINEER (B NGCOBO Pr ENG) DATE -----	APPROVED ----- ELECTRICAL MANAGER (R REDDY) DATE -----	APPROVED ----- MANAGER CIVIL MAINTENANCE (N KHUMALO) DATE -----	APPROVED ----- PORT FACILITIES MANAGER (P MISRA) DATE -----
APPROVAL DOES NOT INDICATE ACCEPTANCE OF ANY RESPONSIBILITY FOR SAFETY OR ADEQUACY OF STRUCTURES	APPROVAL DOES NOT INDICATE ACCEPTANCE OF ANY RESPONSIBILITY FOR SAFETY OR ADEQUACY OF STRUCTURES	APPROVAL DOES NOT INDICATE ACCEPTANCE OF ANY RESPONSIBILITY FOR SAFETY OR ADEQUACY OF STRUCTURES	APPROVAL DOES NOT INDICATE ACCEPTANCE OF ANY RESPONSIBILITY FOR SAFETY OR ADEQUACY OF STRUCTURES

ADEQUACY OF STRUCTURES	ADEQUACY OF STRUCTURES	ADEQUACY OF STRUCTURES	ADEQUACY OF STRUCTURES
NOTES / LEGEND	APPROVED BY COUNCIL / CLIENT		
			01 07
	CITY ENGINEER / CLIENT	REG. NO.	DATE
AMENDMENTS CODE			
A,B,C.../ : BEFORE TENDER / APPROVAL	/ : TENDER DRAWING	/ : AFTER TENDER	/A : BY CLIENT
0			/B : BY ARCHITECT
1,2,3.../ : AFTER TENDER			/C : BY MECHANICAL OR ELECTRICAL
Z			/D : BY BVI
			/E : BY OTHER /



PROVINCE	OFFICE	PHONE
Gauteng	Tshwane	(012) 940-1111
Free State	Polokwane	(015) 291-5400
Northern Cape	Bloemfontein	(051) 447-2137
KwaZulu Natal	Welkom	(057) 353-2499
Eastern Cape	Upington	(054) 337-6600
Western Cape	Springbok	(027) 712-3610
	Durban	(031) 266-8382
	Empangeni	(035) 772-6112
	Port Elizabeth	(041) 373-4343
	East London	(043) 735-3899
	Cape Town	(021) 527-7000

RICHARDS BAY - PORT CONTROL TOWER

SECTION B-B

APPROVED BY BVi			
		970 672	07/07/2018
ENGINEER/TECHNOLOGIST		REG. NO.	DATE
MALE	AS SHOWN @ A1	DRAWN	DA
SIGNED	BJ	CHECKED	LP
PLAN NUMBER		REVISION NO.	DATE SAVED
442.00-202-05		2	Thursday, 09 July 2020

