


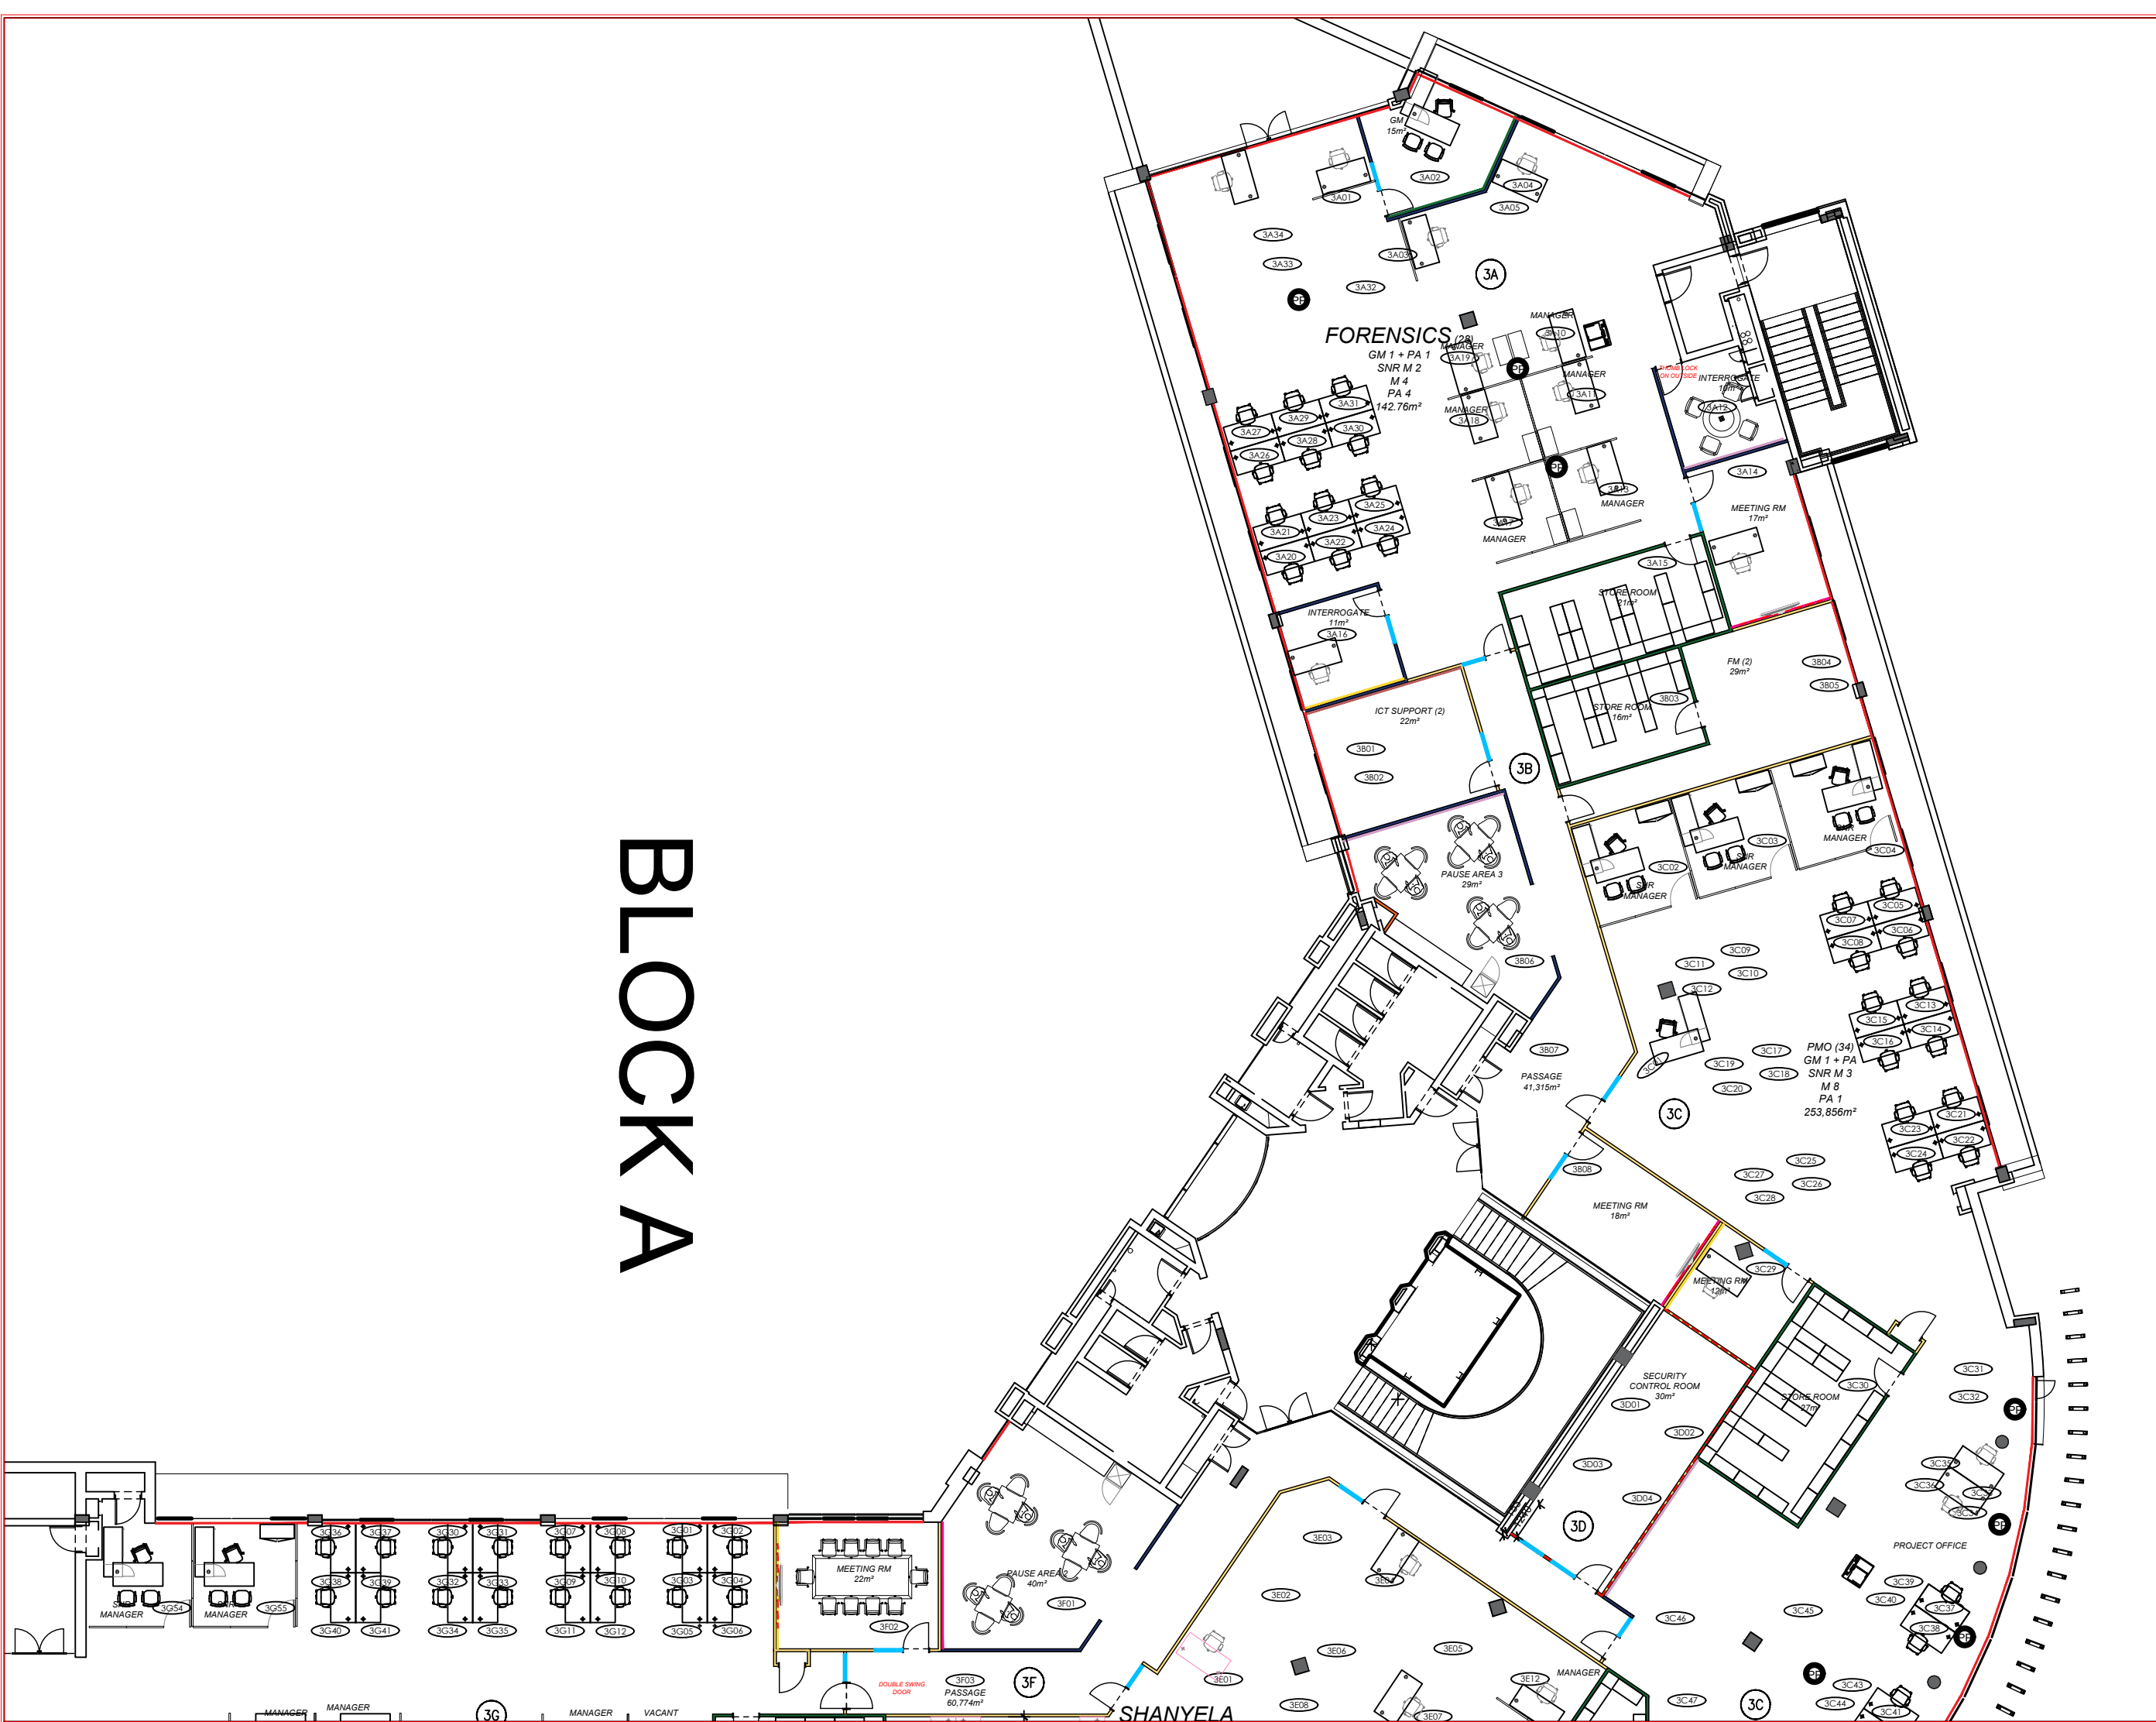

COPYRIGHT AND RIGHT OF REPRODUCTION OF THIS DRAWING OR ANY PORTION THEREOF IS RESERVED. CONTRACTOR TO VERIFY ALL LEVELS, HEIGHTS, AND DIMENSIONS ON SITE AND CHECK SAME AGAINST DRAWING BEFORE PUTTING ANY WORK IN HAND. ANY DISCREPANCIES TO BE REPORTED IMMEDIATELY TO THE ARCHITECT FOR CLARIFICATION. THIS DRAWING IS NOT TO BE SCALED - FIGURED DIMENSIONS TO BE USED AT ALL TIMES. ALL WORK TO BE CARRIED OUT IN STRICT ACCORDANCE WITH THE LOCAL AUTHORITIES' REQUIREMENTS, NATIONAL BUILDING REGULATIONS, AND THE RELEVANT S.A.B.S. STANDARDS. THIS DRAWING TO BE READ IN CONJUNCTION WITH OTHER CONSULTANTS DRAWINGS, DETAILS, AND ALL RELEVANT SPECIFICATIONS OR SCHEDULES AS MAY BE ISSUED.

REVISIONS		
REV.	DESCRIPTION	DATE


NOTES:



ROAD ACCIDENT FUND
FACILITIES MANAGEMENT
420 WHICH-HAZEL AVE
ECO GLADES 2 BLOCK F
CENTURION
www.raf.co.za

PRIVATE BAG X178
CENTURION
0046
SOUTH AFRICA
TELEPHONE : +27 12 621-1789
tertiakh@raf.co.za

PROJECT TITLE		
CENTURION ECO GLADES 1 BLOCK A FLOOR PLAN		
DRAWING TITLE		
THIRD FLOOR b PARTITION LAYOUT FURNITURE LAYOUT ASSET LOCATIONS		
DATE:	SCALE:	DRAWN BY:
18.09.2023	1:100	TKH
DRAWING NUMBER:	SHEET NUMBER	REVISION
EGA 003 MAS	01	00

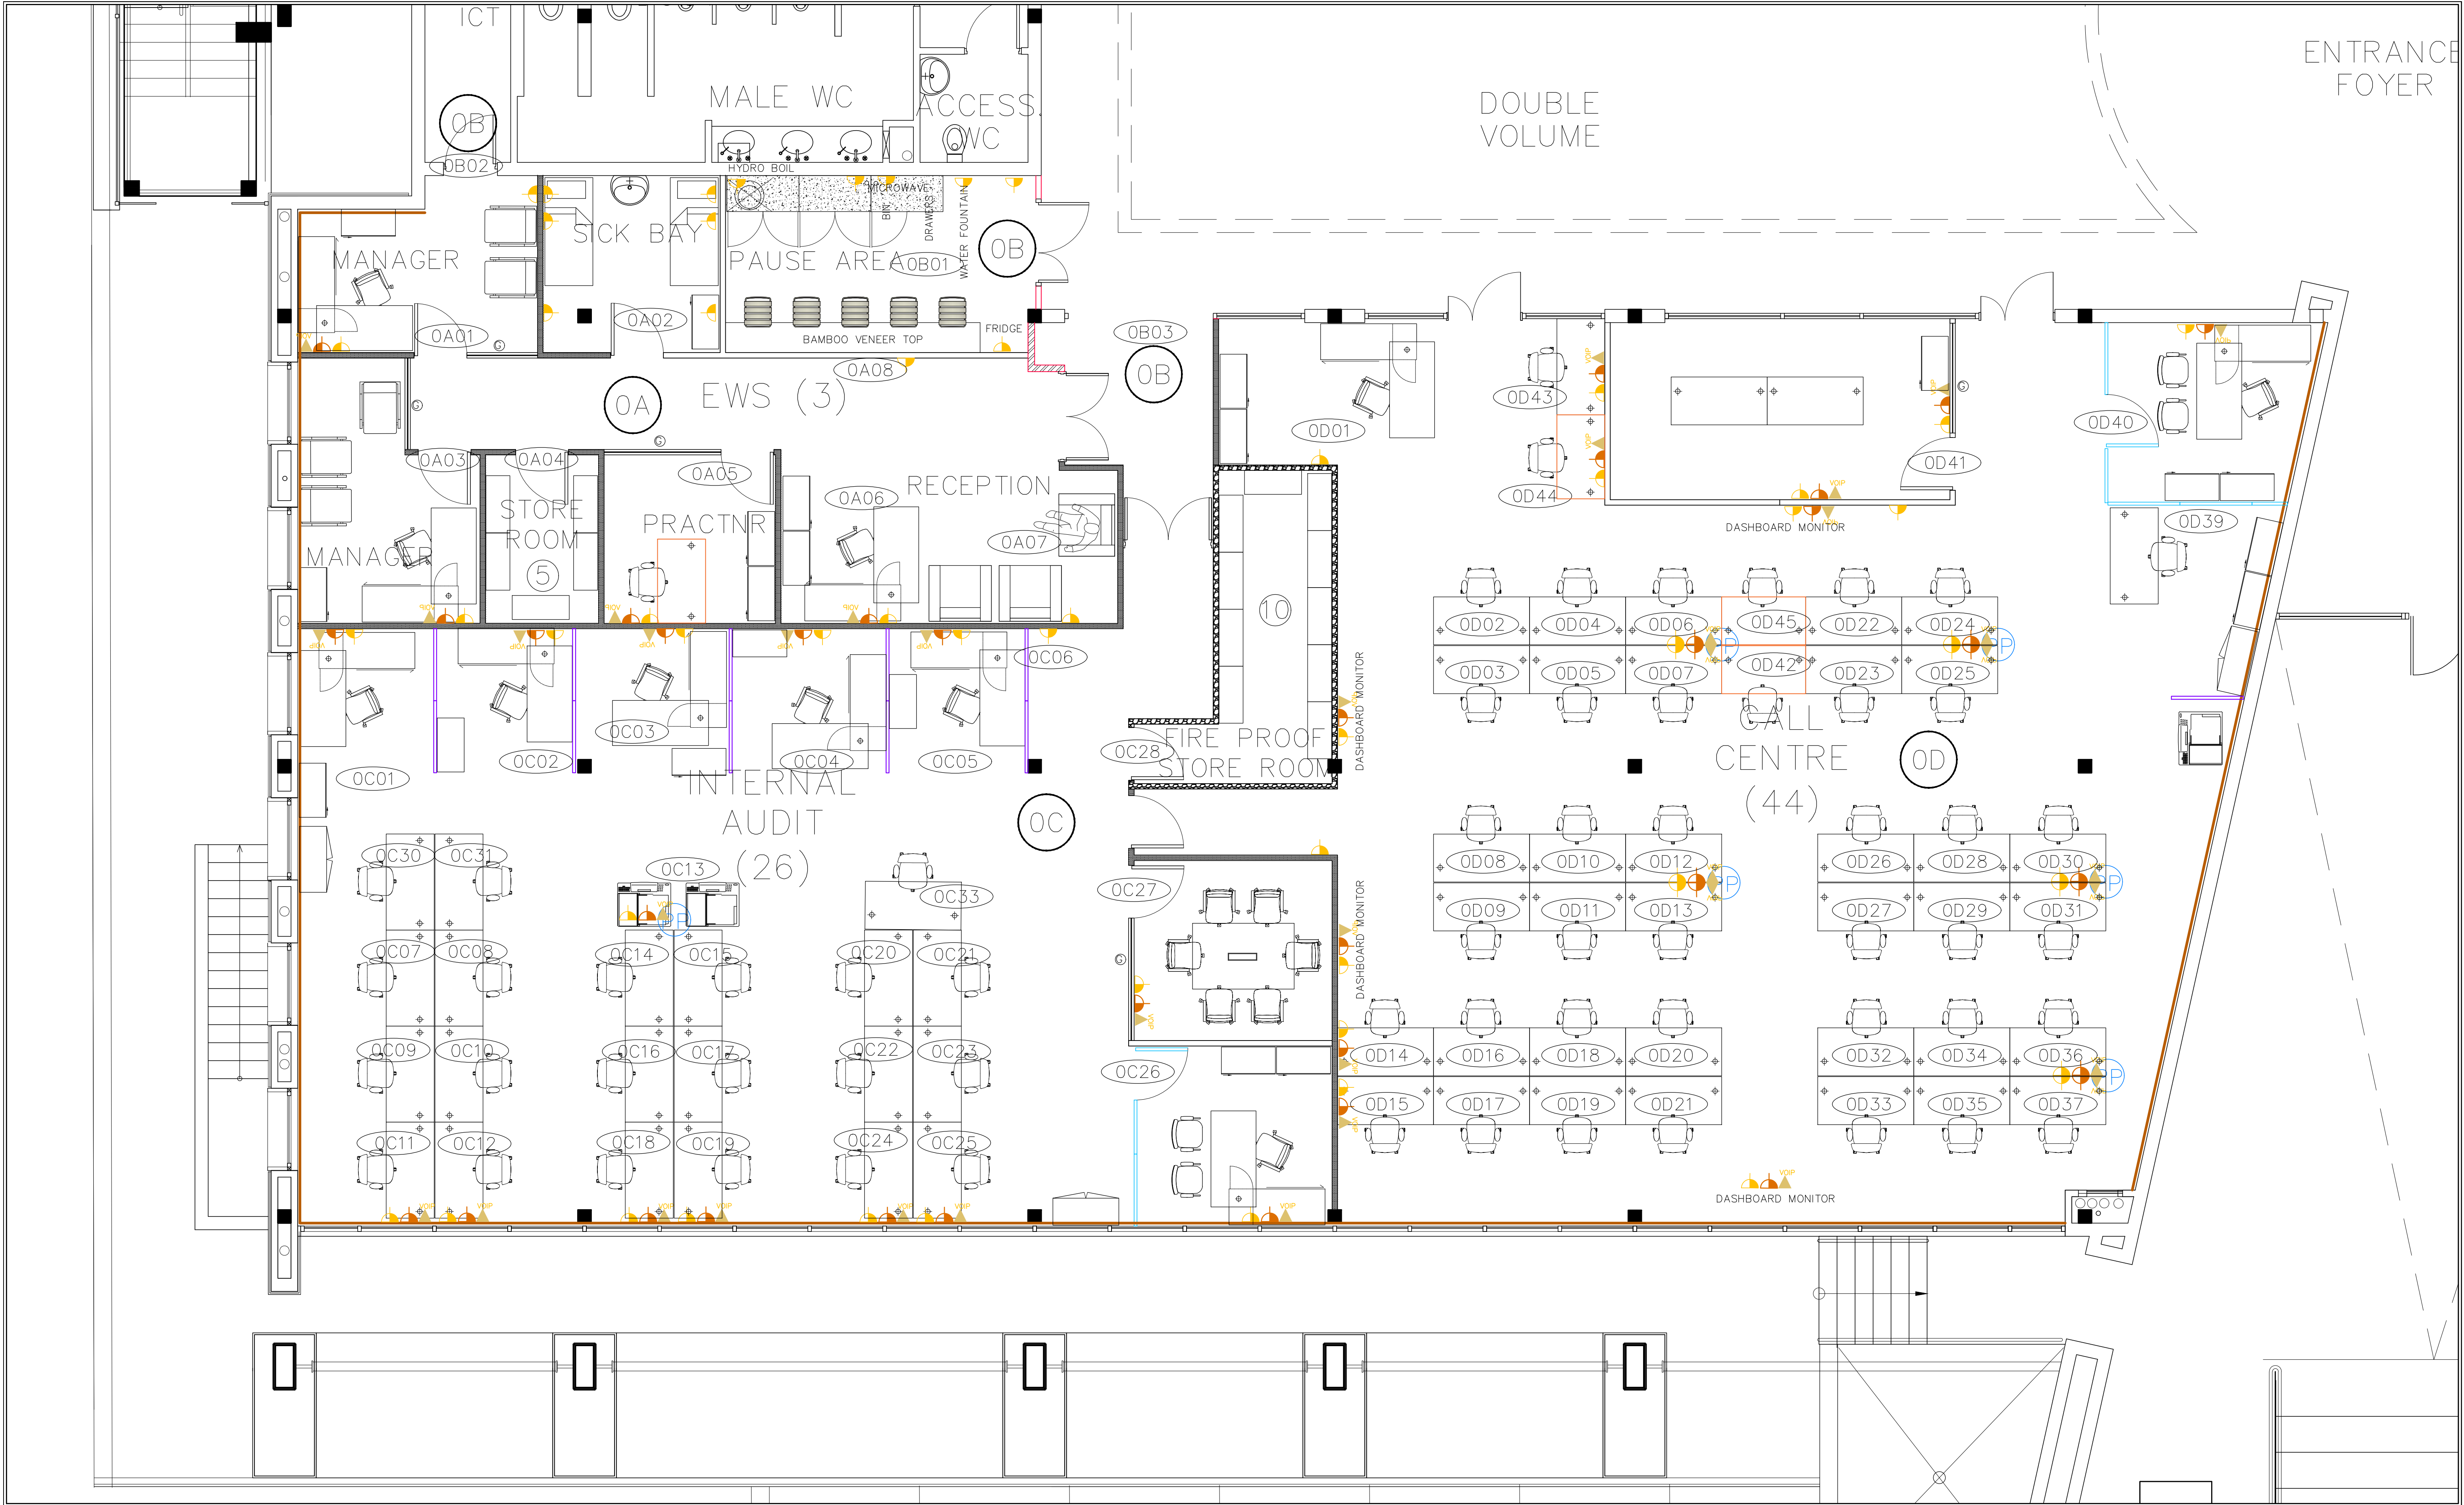

COPYRIGHT AND RIGHT OF REPRODUCTION OF THIS DRAWING OR ANY PORTION THEREOF IS RESERVED. CONTRACTOR TO VERIFY ALL LEVELS, HEIGHTS, AND DIMENSIONS ON SITE AND CHECK SAME AGAINST DRAWING BEFORE PUTTING ANY WORK IN HAND. ANY DISCREPANCIES TO BE REPORTED IMMEDIATELY TO THE ARCHITECT FOR CLARIFICATION. THIS DRAWING IS NOT TO BE SCALED - FIGURED DIMENSIONS TO BE USED AT ALL TIMES. ALL WORK TO BE CARRIED OUT IN STRICT ACCORDANCE WITH THE LOCAL AUTHORITIES' REQUIREMENTS, NATIONAL BUILDING REGULATIONS, AND THE RELEVANT S.A.B.S. STANDARDS. THIS DRAWING TO BE READ IN CONJUNCTION WITH OTHER CONSULTANTS DRAWINGS, DETAILS, AND ALL RELEVANT SPECIFICATIONS OR SCHEDULES AS MAY BE ISSUED.

REV.	REVISIONS DESCRIPTION	DATE

NOTES




Road Accident Fund

ROAD ACCIDENT FUND
FACILITIES MANAGEMENT
420 WHITCH-HAZEL AVE
CENTURION 0046
ECO PARK, CENTURION
www.raf.co.za

ROAD ACCIDENT FUND
PRIVATE BAG X178
CENTURION 0046
SOUTH AFRICA
TELEPHONE : +27 12 621-1789
tertiakh@raf.co.za

DRAWING TITLE:
EMPLOYEE WELLNESS INTERNAL AUDIT CALL CENTRE FURNITURE LAYOUT

PROJECT TITLE:		
CENTURION ECO GLADES BUILDING C ECO PARK GROUND FLOOR		
DATE:	SCALE:	DRAWN BY:
11.04.2022	1:100	TKH
DRAWING NUMBER:		SHEET NUMBER/REVISION:
EGC 000 MAS		06 v00

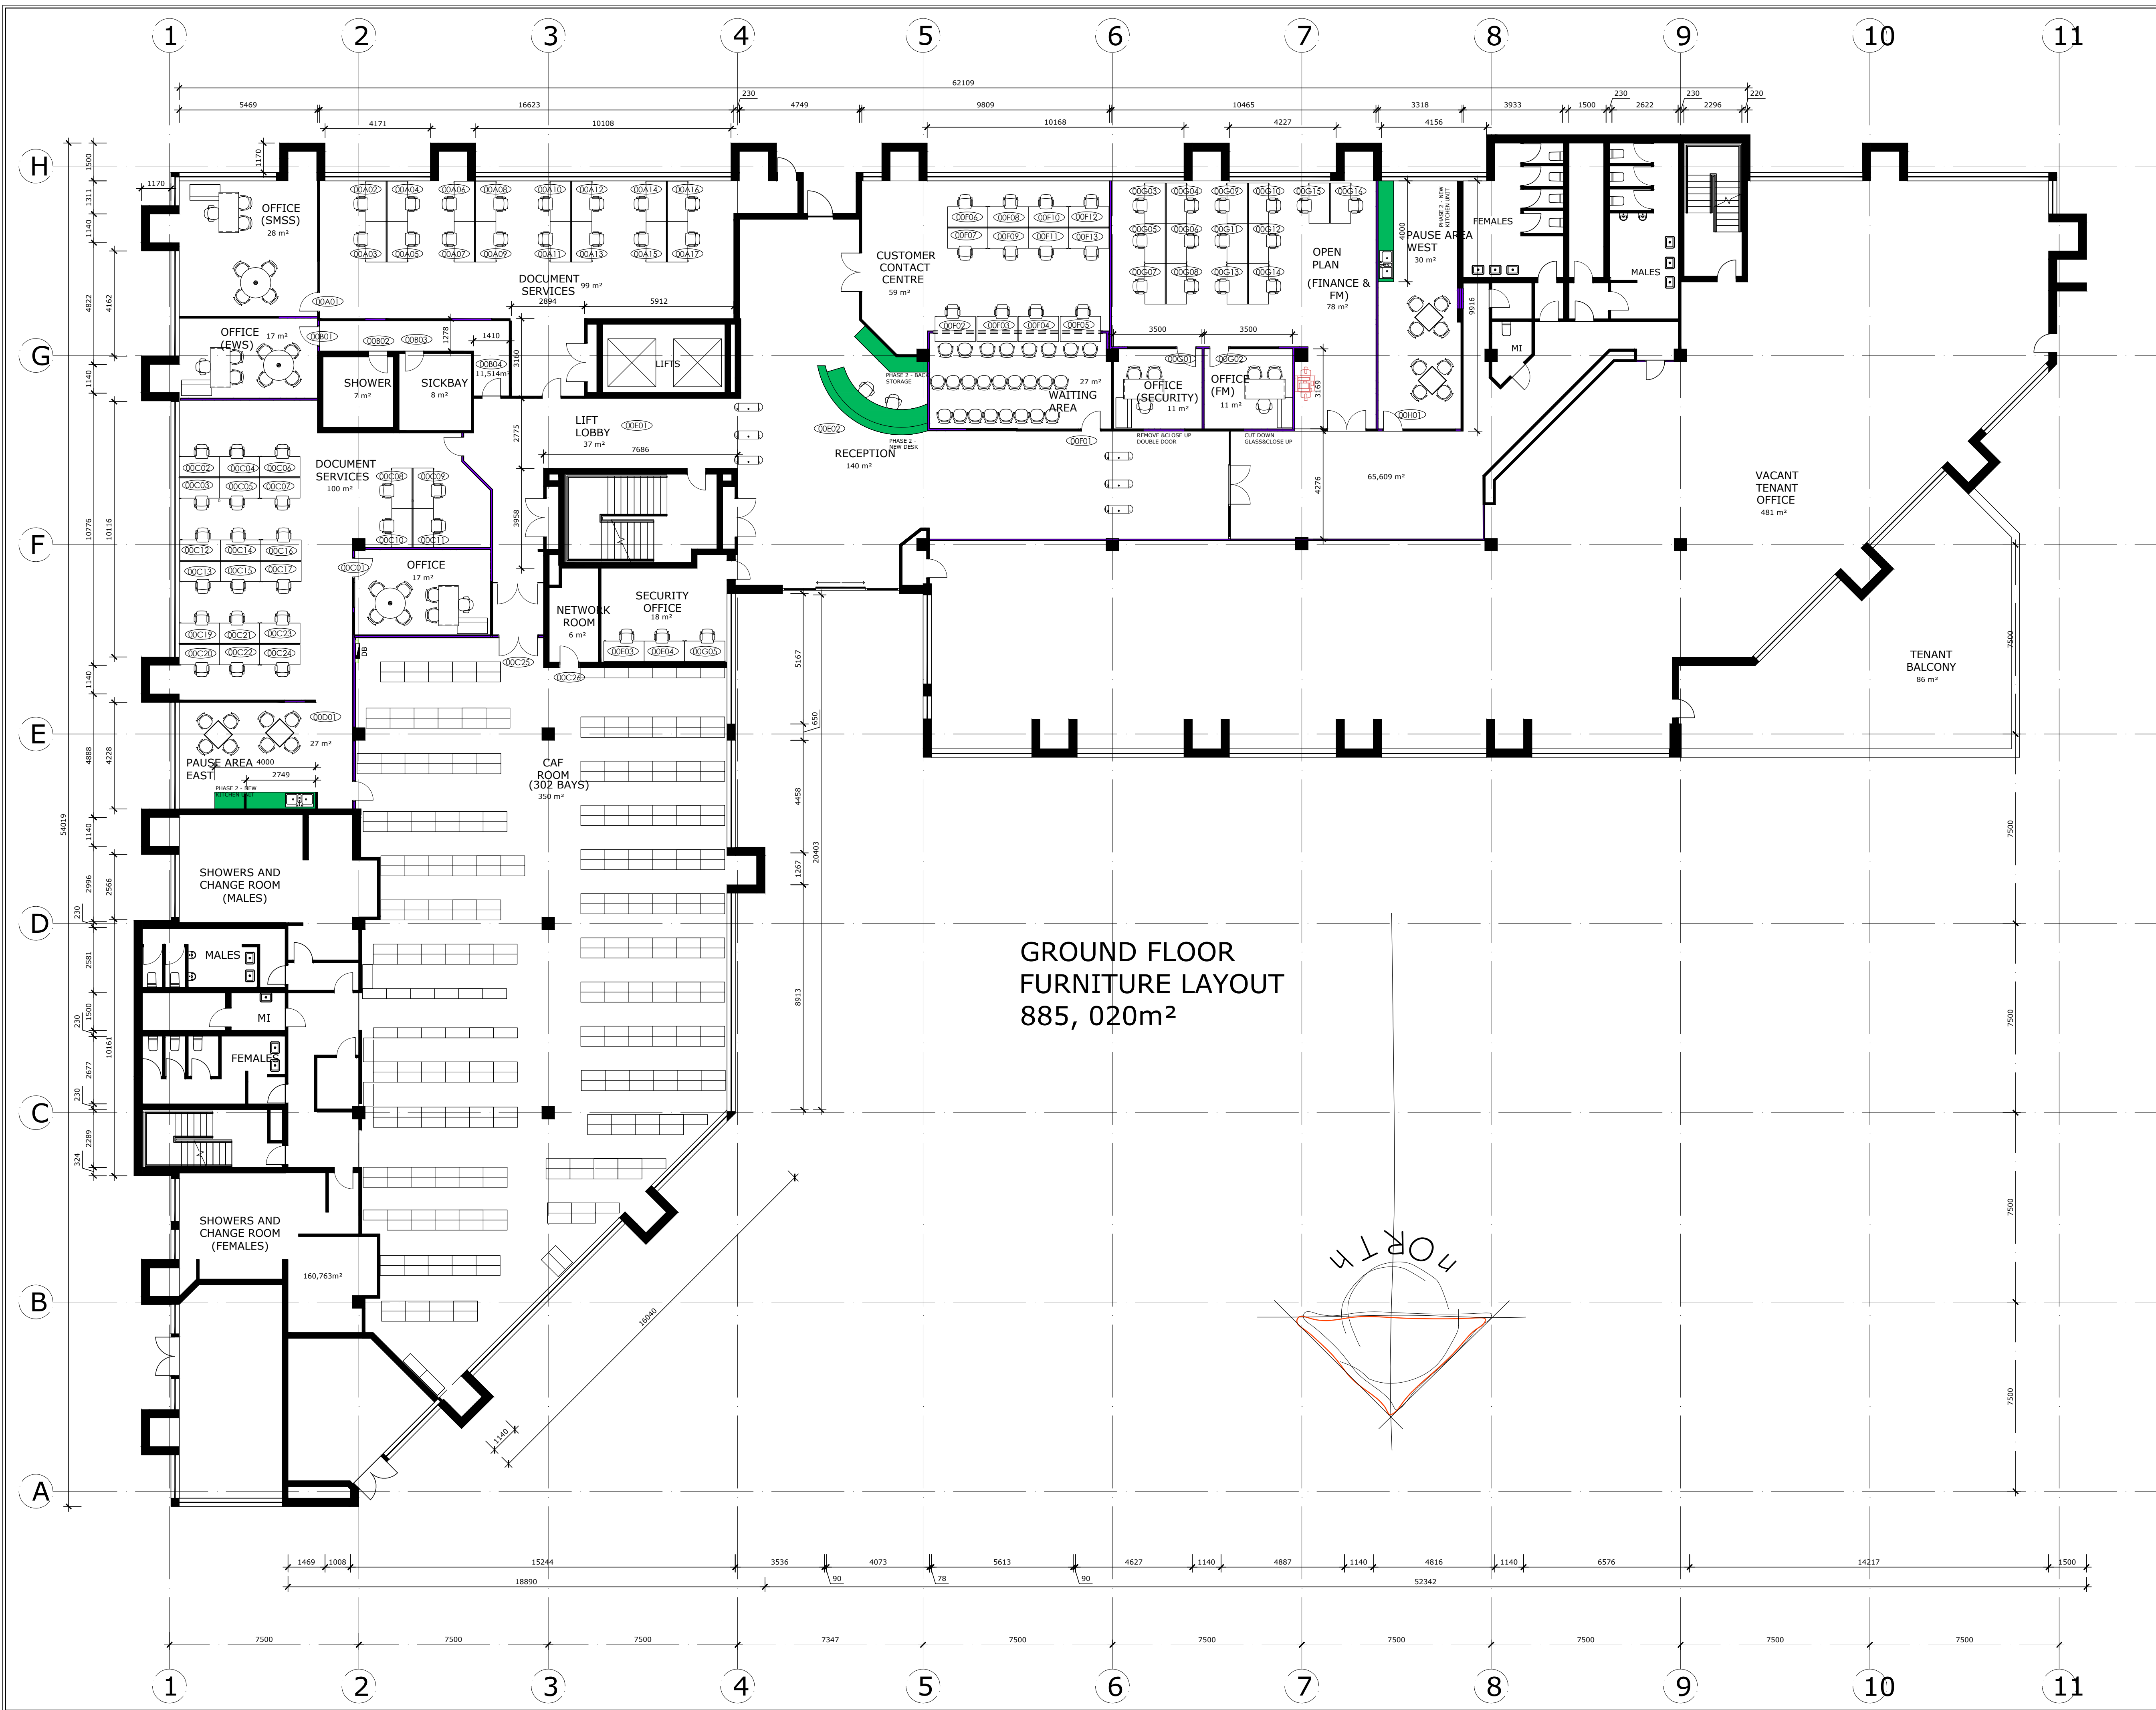

COPYRIGHT AND RIGHT OF REPRODUCTION OF THIS DRAWING OR ANY PORTION THEREOF IS RESERVED. CONTRACTOR TO VERIFY ALL LEVELS, HEIGHTS, AND DIMENSIONS ON SITE AND CHECK SAME AGAINST DRAWING BEFORE PUTTING ANY WORK IN HAND. ANY DISCREPANCIES TO BE REPORTED IMMEDIATELY TO THE ARCHITECT FOR CLARIFICATION. THIS DRAWING IS NOT TO BE SCALED - FIGURED DIMENSIONS TO BE USED AT ALL TIMES. ALL WORK TO BE CARRIED OUT IN STRICT ACCORDANCE WITH THE LOCAL AUTHORITIES' REQUIREMENTS, NATIONAL BUILDING REGULATIONS, AND THE RELEVANT S.A.B.S. STANDARDS. THIS DRAWING TO BE READ IN CONJUNCTION WITH OTHER CONSULTANTS DRAWINGS, DETAILS, AND ALL RELEVANT SPECIFICATIONS OR SCHEDULES AS MAY BE ISSUED.

REVISIONS		
REV.	DESCRIPTION	DATE

NOTES:

--	--



ROAD ACCIDENT FUND
FACILITIES MANAGEMENT
420 WHICH-HAZEL AVE
ECO GLADES - BLOCK F
CENTURION
www.raf.co.za

PRIVATE BAG X178
CENTURION 0046
SOUTH AFRICA
TELEPHONE : +27 12 621-1789
tertiakh@raf.co.za


PROJECT TITLE:

JOHANNESBURG
PARKTOWN
8 JUNCTION ROAD

DRAWING TITLE:

GROUND FLOOR
FLOOR PLAN
FURNITURE LAYOUT
ASSET LOCATIONS

DATE:	SCALE:	DRAWN BY:
12.06.2024	1:120	TKH
DRAWING NUMBER:		SHEET NUMBER REVISION
JJR 000 MAS		01 00

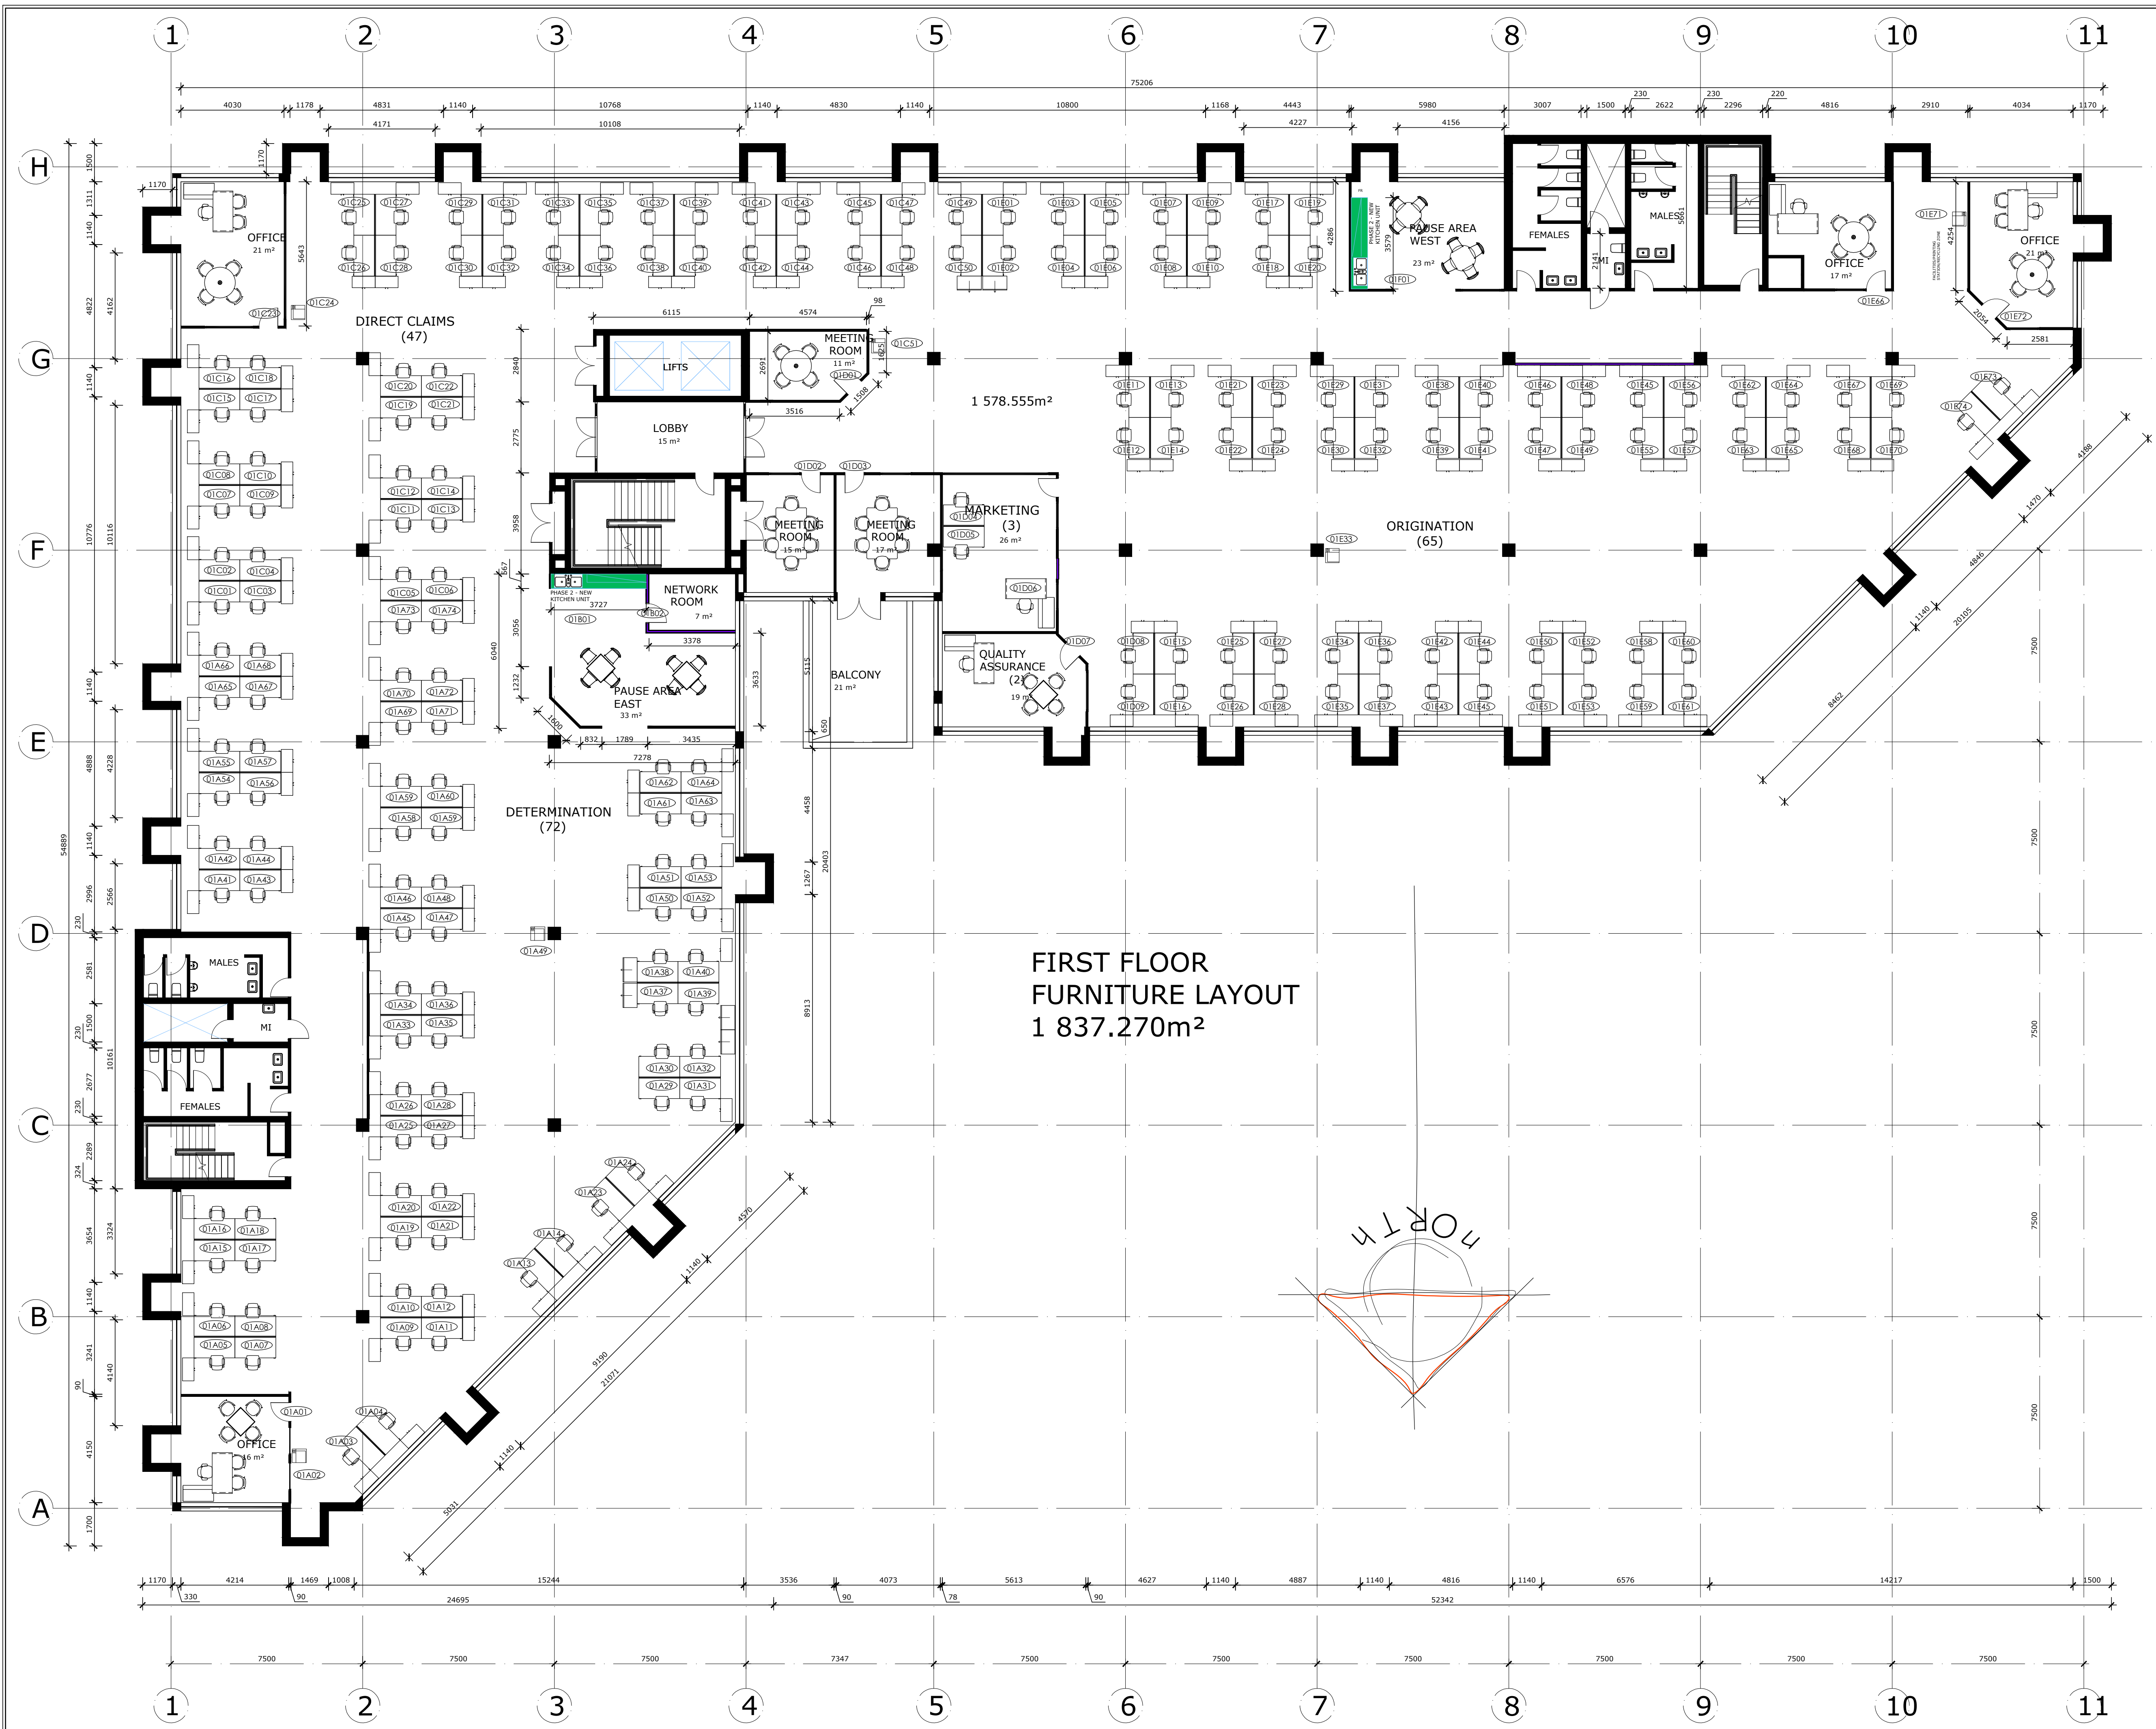

COPYRIGHT AND RIGHT OF REPRODUCTION OF THIS DRAWING OR ANY PORTION THEREOF IS RESERVED. CONTRACTOR TO VERIFY ALL LEVELS, HEIGHTS, AND DIMENSIONS ON SITE AND CHECK SAME AGAINST DRAWING BEFORE PUTTING ANY WORK IN HAND. ANY DISCREPANCIES TO BE REPORTED IMMEDIATELY TO THE ARCHITECT FOR CLARIFICATION. THIS DRAWING IS NOT TO BE SCALED - FIGURED DIMENSIONS TO BE USED AT ALL TIMES. ALL WORK TO BE CARRIED OUT IN STRICT ACCORDANCE WITH THE LOCAL AUTHORITIES' REQUIREMENTS, NATIONAL BUILDING REGULATIONS, AND THE RELEVANT S.A.B.S. STANDARDS. THIS DRAWING TO BE READ IN CONJUNCTION WITH OTHER CONSULTANTS DRAWINGS, DETAILS, AND ALL RELEVANT SPECIFICATIONS OR SCHEDULES AS MAY BE ISSUED.

REVISIONS		
REV.	DESCRIPTION:	DATE:

NOTES:




ROAD ACCIDENT FUND
FACILITIES MANAGEMENT
420 WHICH-HAZEL AVE
ECO PARK
CENTURION
www.raf.co.za

PRIVATE BAG X178
CENTURION 0046
SOUTH AFRICA
TELEPHONE : +27 12 621-1789
tertiakh@raf.co.za


PROJECT TITLE:
**JOHANNESBURG
PARKTOWN
8 JUNCTION ROAD**

DRAWING TITLE:
**FIRST FLOOR
FLOOR PLAN
FURNITURE LAYOUT
ASSET LOCATIONS**

DATE: 12.06.2023	SCALE: 1:120	DRAWN BY: TKH
DRAWING NUMBER: JJR 001 MAS	SHEET NUMBER 01	REVISION 00

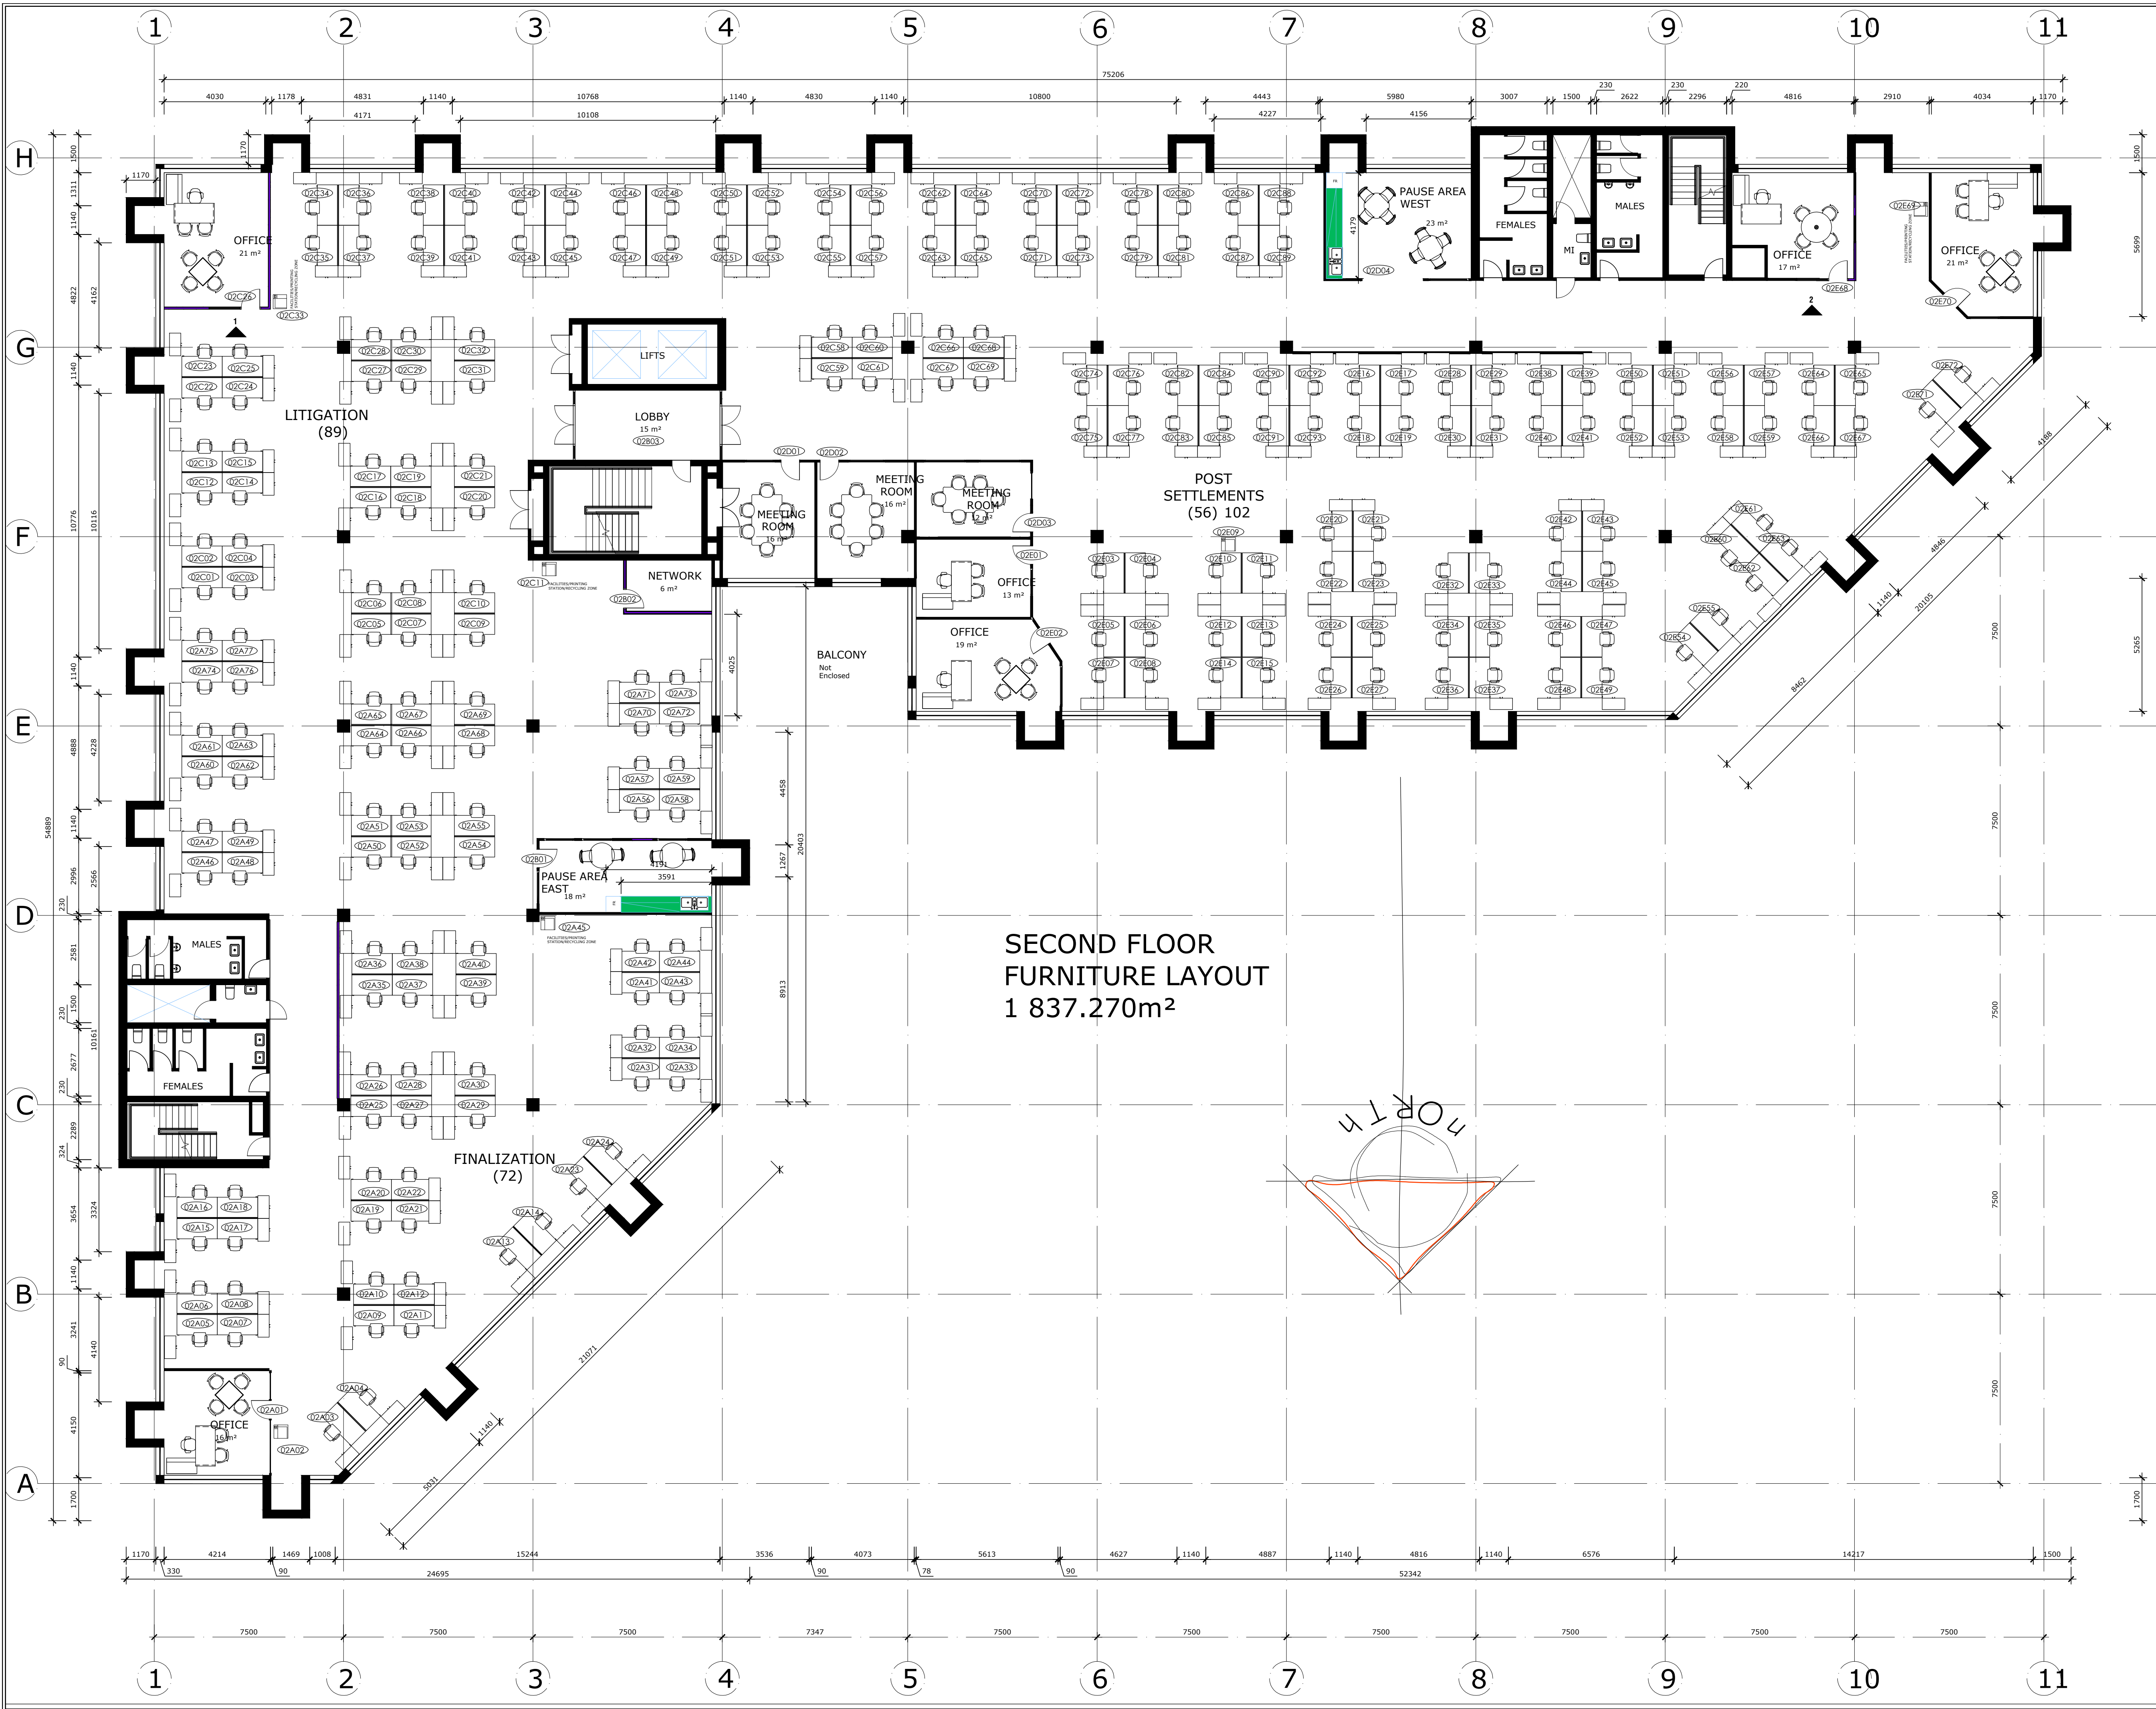

SECOND FLOOR
FURNITURE LAYOUT
1 837.270m²

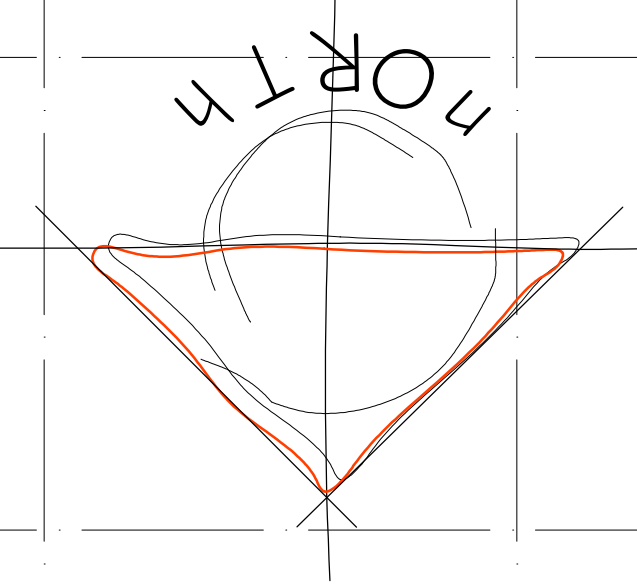

COPYRIGHT AND RIGHT OF REPRODUCTION OF THIS DRAWING OR ANY PORTION THEREOF IS RESERVED. CONTRACTOR TO VERIFY ALL LEVELS, HEIGHTS, AND DIMENSIONS ON SITE AND CHECK SAME AGAINST DRAWING BEFORE PUTTING ANY WORK IN HAND. ANY DISCREPANCIES TO BE REPORTED IMMEDIATELY TO THE ARCHITECT FOR CLARIFICATION. THIS DRAWING IS NOT TO BE SCALED - FIGURED DIMENSIONS TO BE USED AT ALL TIMES. ALL WORK TO BE CARRIED OUT IN STRICT ACCORDANCE WITH THE LOCAL AUTHORITIES' REQUIREMENTS, NATIONAL BUILDING REGULATIONS, AND THE RELEVANT S.A.B.S. STANDARDS. THIS DRAWING TO BE READ IN CONJUNCTION WITH OTHER CONSULTANTS DRAWINGS, DETAILS, AND ALL RELEVANT SPECIFICATIONS OR SCHEDULES AS MAY BE ISSUED.

REVISIONS		
REV.	DESCRIPTION	DATE

NOTES:




ROAD ACCIDENT FUND
FACILITIES MANAGEMENT
420 WHICH-HAZEL AVE
ECO GLADES 2 BLOCK F
CENTURION
www.raf.co.za

PRIVATE BAG X178
CENTURION 0046
SOUTH AFRICA
TELEPHONE : +27 12 621-1789
tertiakh@raf.co.za

PROJECT TITLE:
**JOHANNESBURG
PARKTOWN
8 JUNCTION ROAD**

DRAWING TITLE:
**2ND FLOOR
FLOOR PLAN
FURNITURE LAYOUT
ASSET LOCATIONS**

DATE: 12.06.2023	SCALE: 1:120	DRAWN BY: TKH
DRAWING NUMBER: JJR 002 MAS	SHEET NUMBER 01	REVISION 00

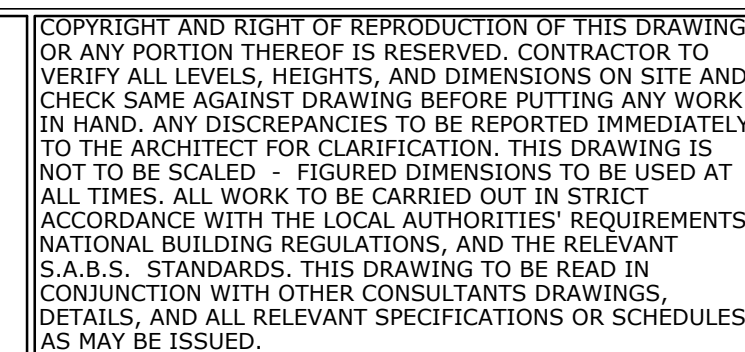
[illegible]

PROJECT TITLE:
JOHANNESBURG
PARKTOWN
8 JUNCTION ROAD

DRAWING TITLE:

FOURTH FLOOR
FLOOR PLAN
FURNITURE LAYOUT
ASSET LOCATIONS

DATE:	SCALE:	DRAWN BY:
12.06.2023	1:120	TKH
DRAWING NUMBER:		SHEET NUMBER REVISION
JJR 003 MAS		01 00

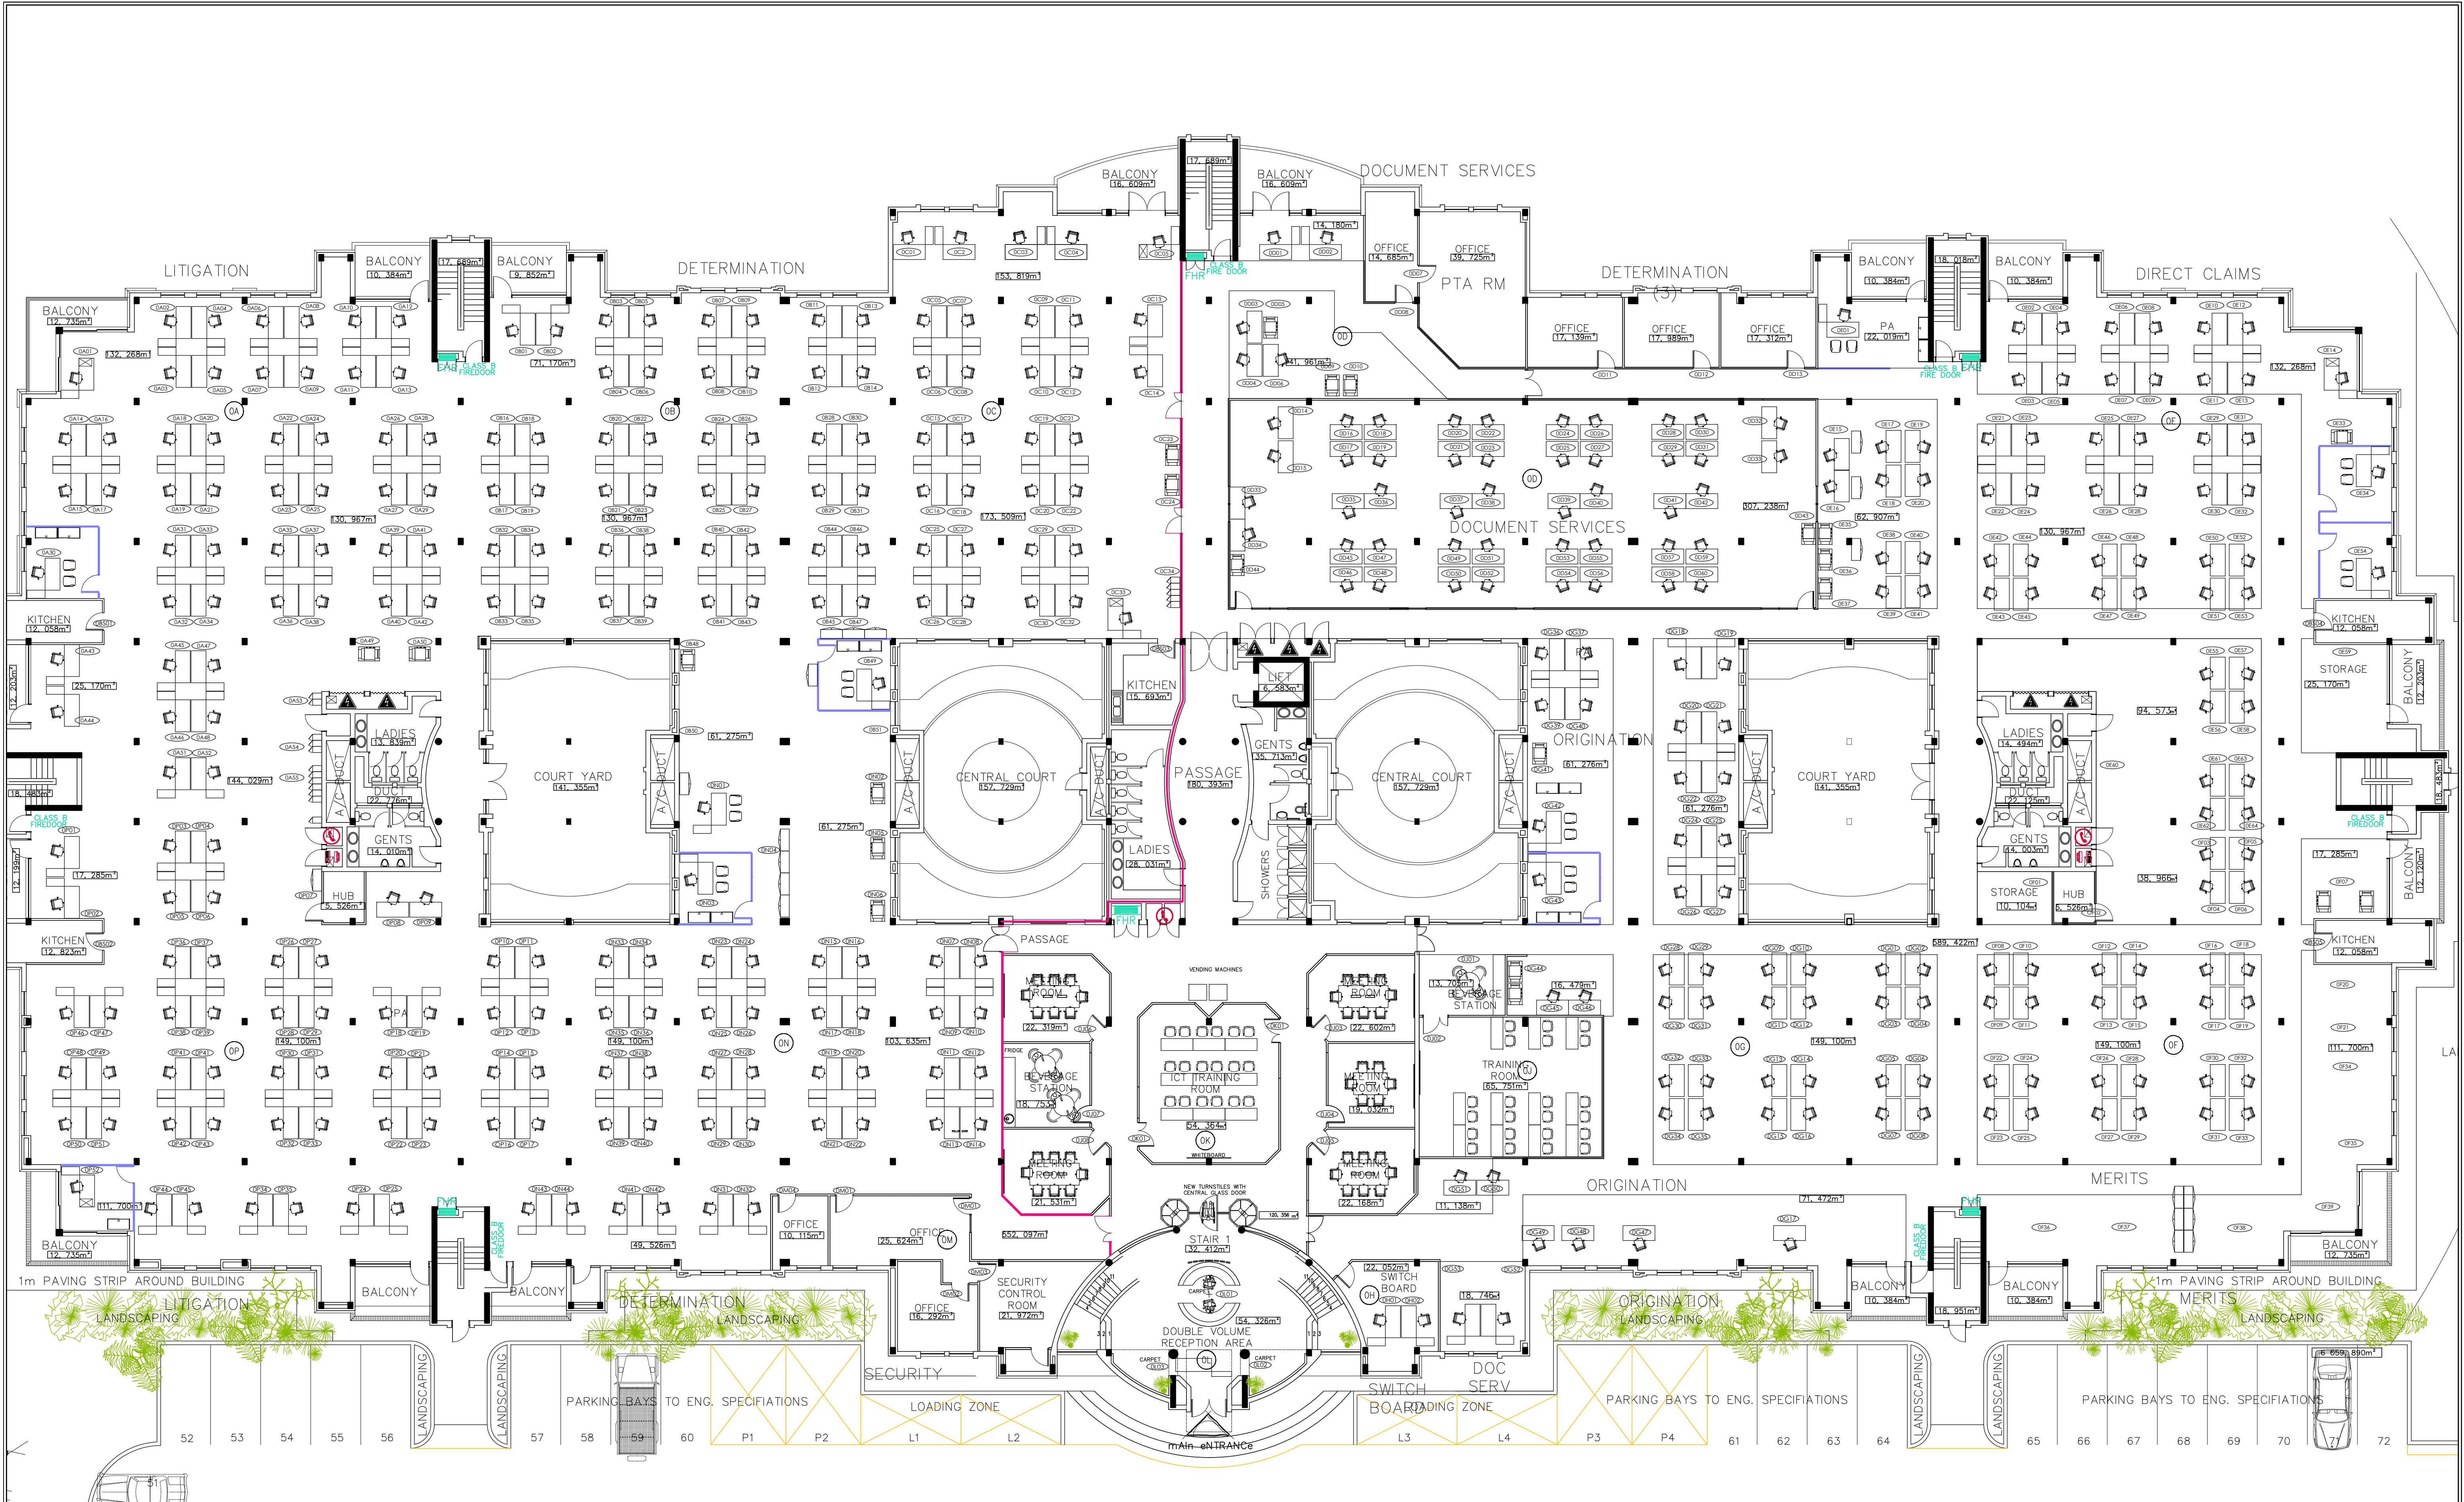


COPYRIGHT AND RIGHT OF REPRODUCTION OF THIS DRAWING OR ANY PORTION THEREOF IS RESERVED. CONTRACTOR TO VERIFY ALL LEVELS, HEIGHTS, AND DIMENSIONS ON SITE AND CHECK SAME AGAINST DRAWING BEFORE PUTTING ANY WORK IN HAND. ANY DISCREPANCIES TO BE REPORTED IMMEDIATELY TO THE ARCHITECT FOR CLARIFICATION. THIS DRAWING IS NOT TO BE SCALED - FIGURED DIMENSIONS TO BE USED AT ALL TIMES. ALL WORK TO BE CARRIED OUT IN STRICT ACCORDANCE WITH THE LOCAL AUTHORITIES' REGULATIONS, NATIONAL BUILDING STANDARDS, AND THE RELEVANT S.A.B.S. STANDARDS. THIS DRAWING TO BE READ IN CONJUNCTION WITH OTHER CONSULTANTS DRAWINGS, DETAILS, AND ALL RELEVANT SPECIFICATIONS OR SCHEDULES AS MAY BE ISSUED.			REV: REVISIONS DESCRIPTION: DATE:			NOTES:			DRAWING TITLE: — — — —			PROJECT TITLE: MENLYN PLAN GROUND FLOOR FURNITURE LAYOUT		
												DATE: 24/01/2022		
												SCALE: 1:150		
												DRAWN BY: TKH		
												DRAWING NUMBER: MLN 000 MAS		
												SHEET NUMBER/REVISION: 01 00		




ROAD ACCIDENT FUND
FACILITIES MANAGEMENT
420 WILHELM-HAASEL AVE
CENTURION 0046
www.rafc.co.za

ROAD ACCIDENT FUND
PRIVATE BAG X178
CENTURION 0046
SOUTH AFRICA
TELEPHONE : +27 12 621-1789
tertiakh@raf.co.za

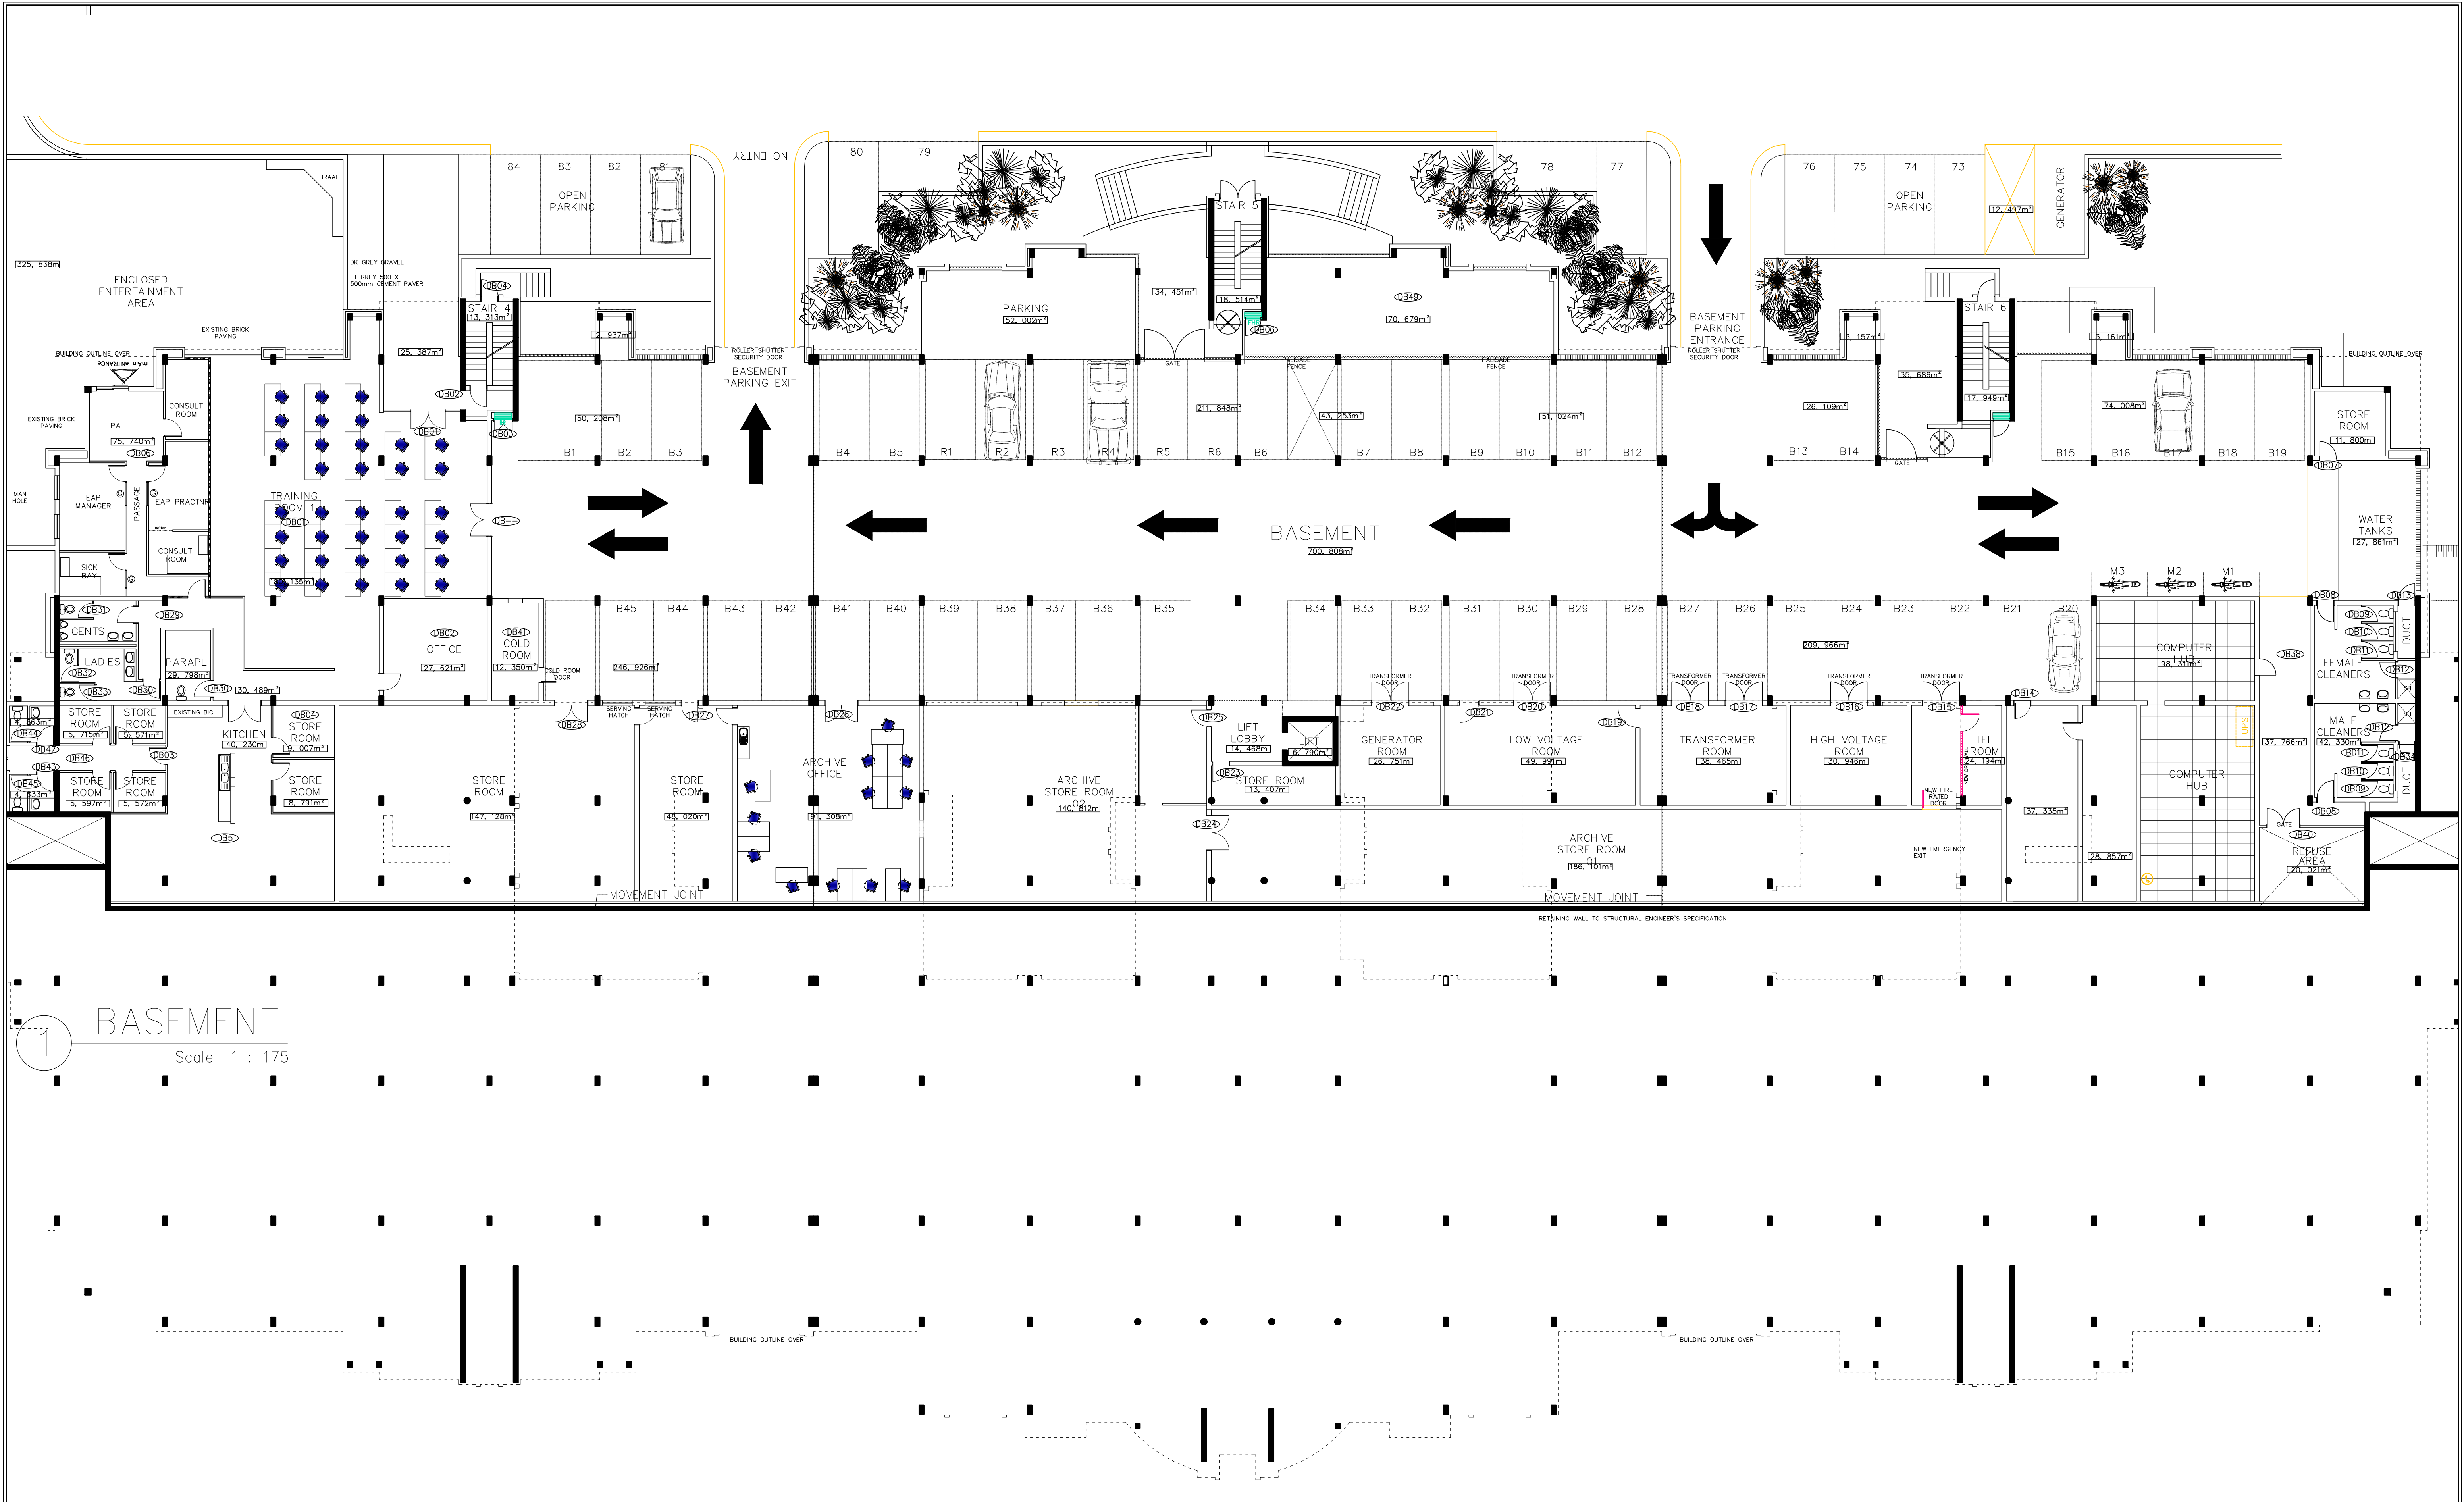

COPYRIGHT AND RIGHT OF REPRODUCTION OF THIS DRAWING OR ANY PORTION THEREOF IS RESERVED. CONTRACTOR TO VERIFY ALL LEVELS, HEIGHTS, AND DIMENSIONS ON SITE AND CHECK SAME AGAINST DRAWING BEFORE PUTTING ANY WORK IN HAND. ANY DISCREPANCIES TO BE REPORTED IMMEDIATELY TO THE ARCHITECT FOR CLARIFICATION. THIS DRAWING IS NOT TO BE SCALED - FIGURED DIMENSIONS TO BE USED AT ALL TIMES. ALL WORK TO BE CARRIED OUT IN STRICT ACCORDANCE WITH THE LOCAL AUTHORITIES' REQUIREMENTS, NATIONAL BUILDING REGULATIONS, AND THE RELEVANT S.A.B.S. STANDARDS. THIS DRAWING TO BE READ IN CONJUNCTION WITH OTHER CONSULTANTS DRAWINGS, DETAILS, AND ALL RELEVANT SPECIFICATIONS OR SCHEDULES AS MAY BE ISSUED.			REV: REVISIONS DESCRIPTION: DATE:		NOTES:		ROAD ACCIDENT FUND FACILITIES MANAGEMENT 420 WHITTON-HAZEL AVE ECO GLADES 2 BLOCK F 0046 SOUTH AFRICA www.raf.co.za		ROAD ACCIDENT FUND PRIVATE BAG X178 CENTURION 0048 SOUTH AFRICA TELEPHONE : +27 12 621-1789 tertia@raf.co.za		DRAWING TITLE: MASTER DRAWING FLOOR PLAN		PROJECT TITLE: MENLYN ROAD ACCIDENT FUND HEAD OFFICE BASEMENT		
													DATE: 24/01/2022		
													SCALE: 1:175		
													DRAWN BY: TKH		
													DRAWING NUMBER: RHO -01 MAS		
													SHEET NUMBER: 01		
													REVISION: 00		

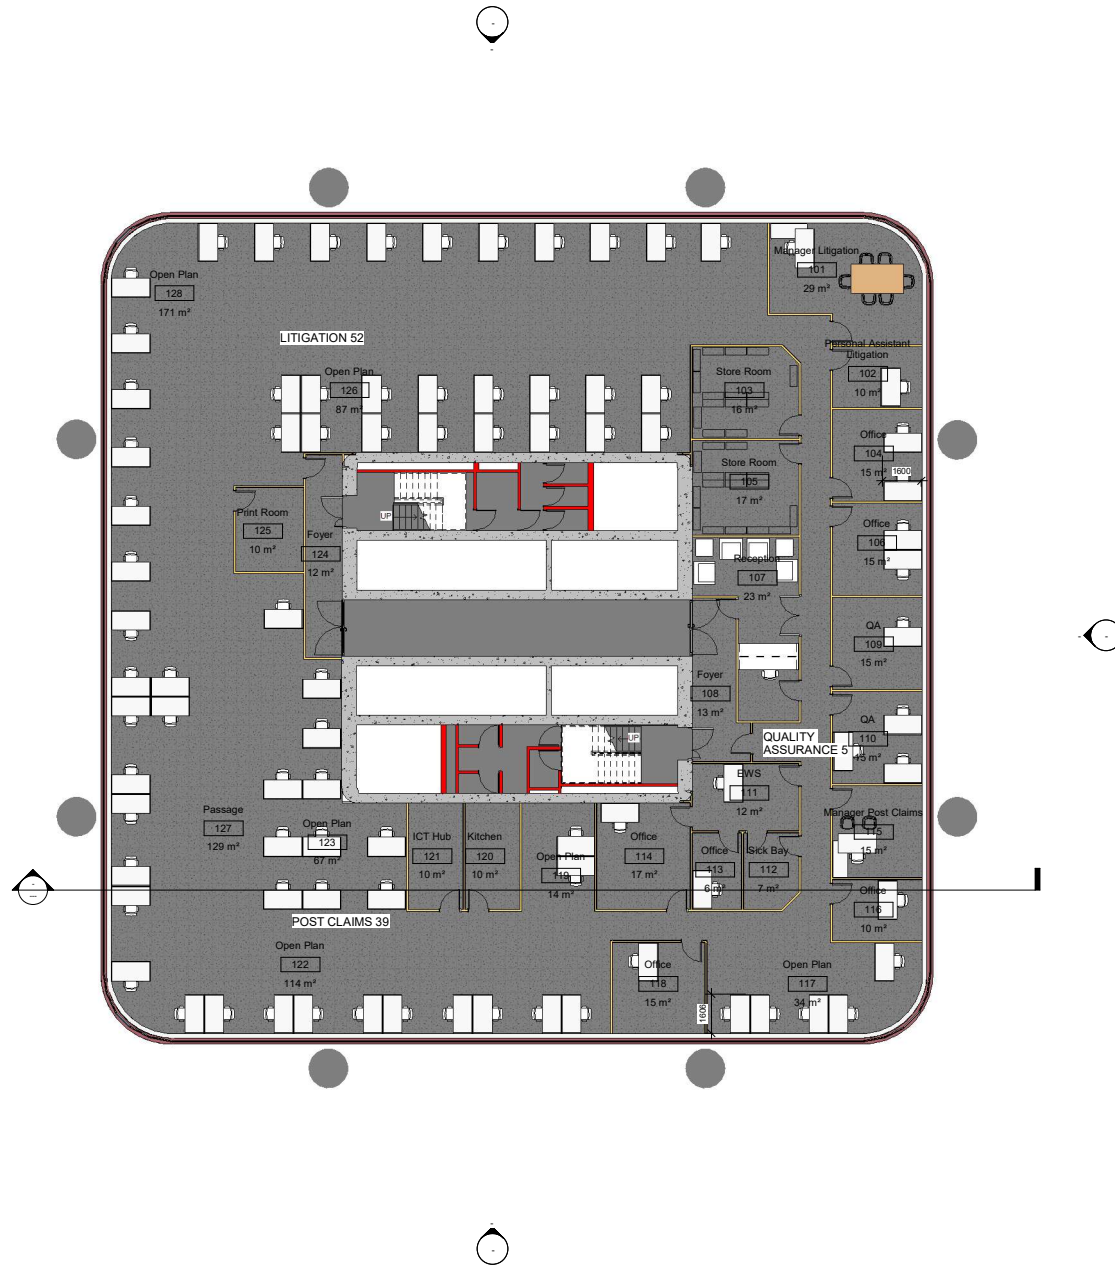

1 Level 1 For Construction
1 : 100

COPYRIGHT AND RIGHT OF REPRODUCTION OF THIS DRAWING OR ANY PORTION THEREOF IS RESERVED. CONTRACTOR TO VERIFY ALL LEVELS, HEIGHTS, AND DIMENSIONS ON SITE AND CHECK SAME AGAINST DRAWING BEFORE PUTTING ANY WORK IN HAND. ANY DISCREPANCIES TO BE REPORTED IMMEDIATELY TO THE ARCHITECT FOR CLARIFICATION. THIS DRAWING IS NOT TO BE SCALED - FIGURED DIMENSIONS TO BE USED AT ALL TIMES. ALL WORK TO BE CARRIED OUT IN STRICT ACCORDANCE WITH THE LOCAL AUTHORITIES' REQUIREMENTS, NATIONAL BUILDING REGULATIONS, AND THE RELEVANT S.A.B.S. STANDARDS. THIS DRAWING TO BE READ IN CONJUNCTION WITH OTHER CONSULTANTS DRAWINGS, DETAILS, AND ALL RELEVANT SPECIFICATIONS OR SCHEDULES AS MAY BE ISSUED.

REVISIONS		
Rev	Description	Date
A	Rev 1	22/07/19

NOTES		

NOTES		




ROAD ACCIDENT FUND PRIVATE BAG X178
FACILITIES CENTURION
MANAGEMENT 0046
420 WHICH-HAZEL AVE SOUTH AFRICA
ECO GLADES 2 TEL : +27 12 621-1789
BLOCK F teriakhi@raf.co.za
ECO PARK
CENTURION
www.raf.co.za

PROJECT NAME		
CAPE TOWN THIBAUT SQUARE		

SHEET NAME		
1ST FLOOR		

DATE	SCALE	DRAWN BY
01/12/2022	1 : 100	TKH
DRAWING/SHEET NUMBER	REVISION	
01	A	

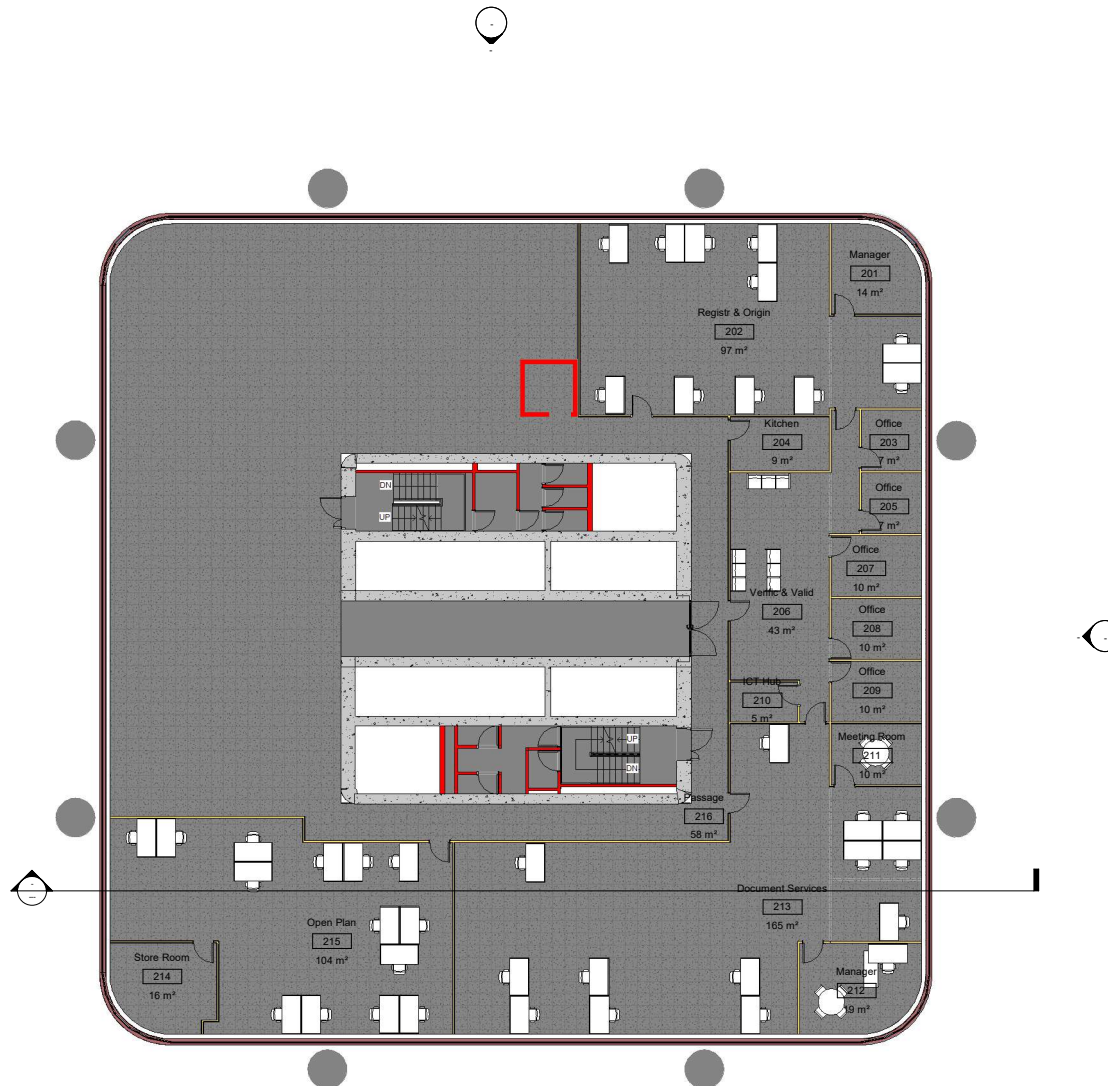

① Level 2 For Construction
1 : 100

COPYRIGHT AND RIGHT OF REPRODUCTION OF THIS DRAWING OR ANY PORTION THEREOF IS RESERVED. CONTRACTOR TO VERIFY ALL LEVELS, HEIGHTS, AND DIMENSIONS ON SITE AND CHECK SAME AGAINST DRAWING BEFORE PUTTING ANY WORK IN HAND. ANY DISCREPANCIES TO BE REPORTED IMMEDIATELY TO THE ARCHITECT FOR CLARIFICATION. THIS DRAWING IS NOT TO BE SCALED - FIGURED DIMENSIONS TO BE USED AT ALL TIMES. ALL WORK TO BE CARRIED OUT IN STRICT ACCORDANCE WITH THE LOCAL AUTHORITIES' REQUIREMENTS, NATIONAL BUILDING REGULATIONS, AND THE RELEVANT S.A.B.S. STANDARDS. THIS DRAWING TO BE READ IN CONJUNCTION WITH OTHER CONSULTANTS DRAWINGS, DETAILS, AND ALL RELEVANT SPECIFICATIONS OR SCHEDULES AS MAY BE ISSUED.

REVISIONS		
Rev	Description	Date

--	--	--

NOTES

--	--	--




ROAD ACCIDENT FUND PRIVATE BAG X178
FACILITIES CENTURION
MANAGEMENT 0046
420 WHICH-HAZEL AVE SOUTH AFRICA
ECO GLADES 2 TEL : +27 12 621-1789
BLOCK F tertlakh@raf.co.za
ECO PARK
CENTURION
www.raf.co.za

PROJECT NAME		
CAPE TOWN THIBAUT SQUARE		


SHEET NAME		
------------	--	--

2ND FLOOR		
-----------	--	--

DATE	SCALE	DRAWN BY
01/12/2022	1 : 100	Author
DRAWING/SHEET NUMBER	REVISION	
02		

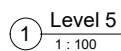

DATE	SCALE	DRAWN BY
01/12/2022	1 : 100	Author
DRAWING/SHEET NUMBER		REVISION
05		

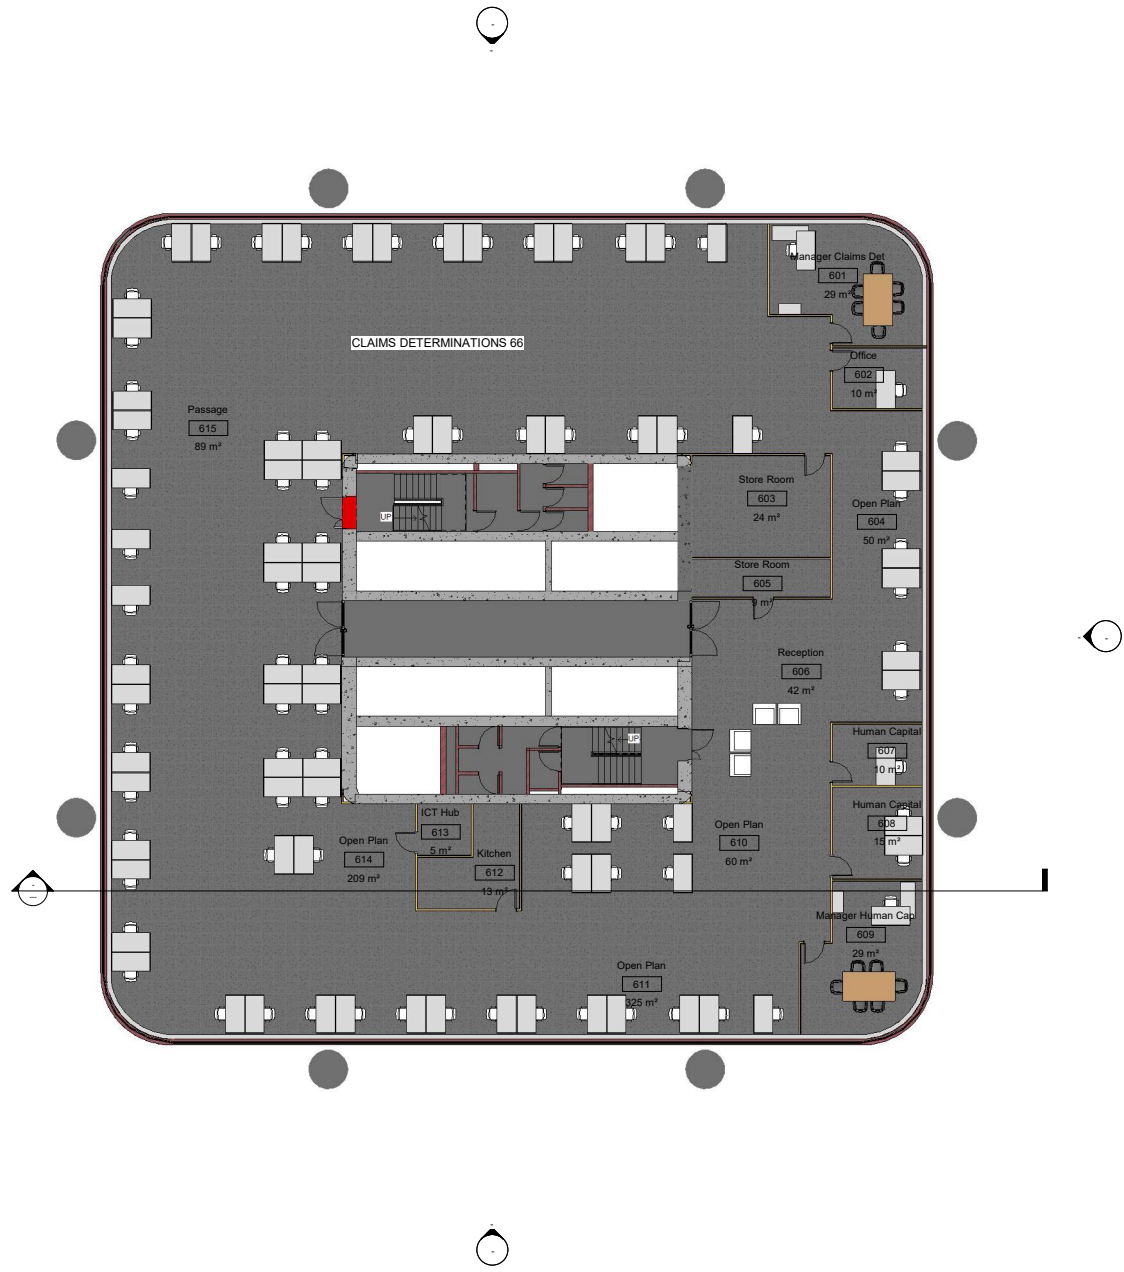

1 Level 6
1 : 100

COPYRIGHT AND RIGHT OF REPRODUCTION OF THIS DRAWING OR ANY PORTION THEREOF IS RESERVED. CONTRACTOR TO VERIFY ALL LEVELS, HEIGHTS, AND DIMENSIONS ON SITE AND CHECK SAME AGAINST DRAWING BEFORE PUTTING ANY WORK IN HAND. ANY DISCREPANCIES TO BE REPORTED IMMEDIATELY TO THE ARCHITECT FOR CLARIFICATION. THIS DRAWING IS NOT TO BE SCALED - FIGURED DIMENSIONS TO BE USED AT ALL TIMES. ALL WORK TO BE CARRIED OUT IN STRICT ACCORDANCE WITH THE LOCAL AUTHORITIES' REQUIREMENTS, NATIONAL BUILDING REGULATIONS, AND THE RELEVANT S.A.B.S. STANDARDS. THIS DRAWING TO BE READ IN CONJUNCTION WITH OTHER CONSULTANTS DRAWINGS, DETAILS, AND ALL RELEVANT SPECIFICATIONS OR SCHEDULES AS MAY BE ISSUED.


REVISIONS		
Rev	Description	Date

NOTES



ROAD ACCIDENT FUND PRIVATE BAG X178
CENTURION 0046
420 WHICH-HAZEL AVE SOUTH AFRICA
ECO GLADES 2 TEL : +27 12 621-1789
BLOK F tertlakh@raf.co.za
ECO PARK
CENTURION
www.raf.co.za

PROJECT NAME		
CAPE TOWN THIBAUT SQUARE		
SHEET NAME		
6TH FLOOR		
DATE	SCALE	DRAWN BY
01/12/2022	1 : 100	Author
DRAWING/SHEET NUMBER		REVISION
06		

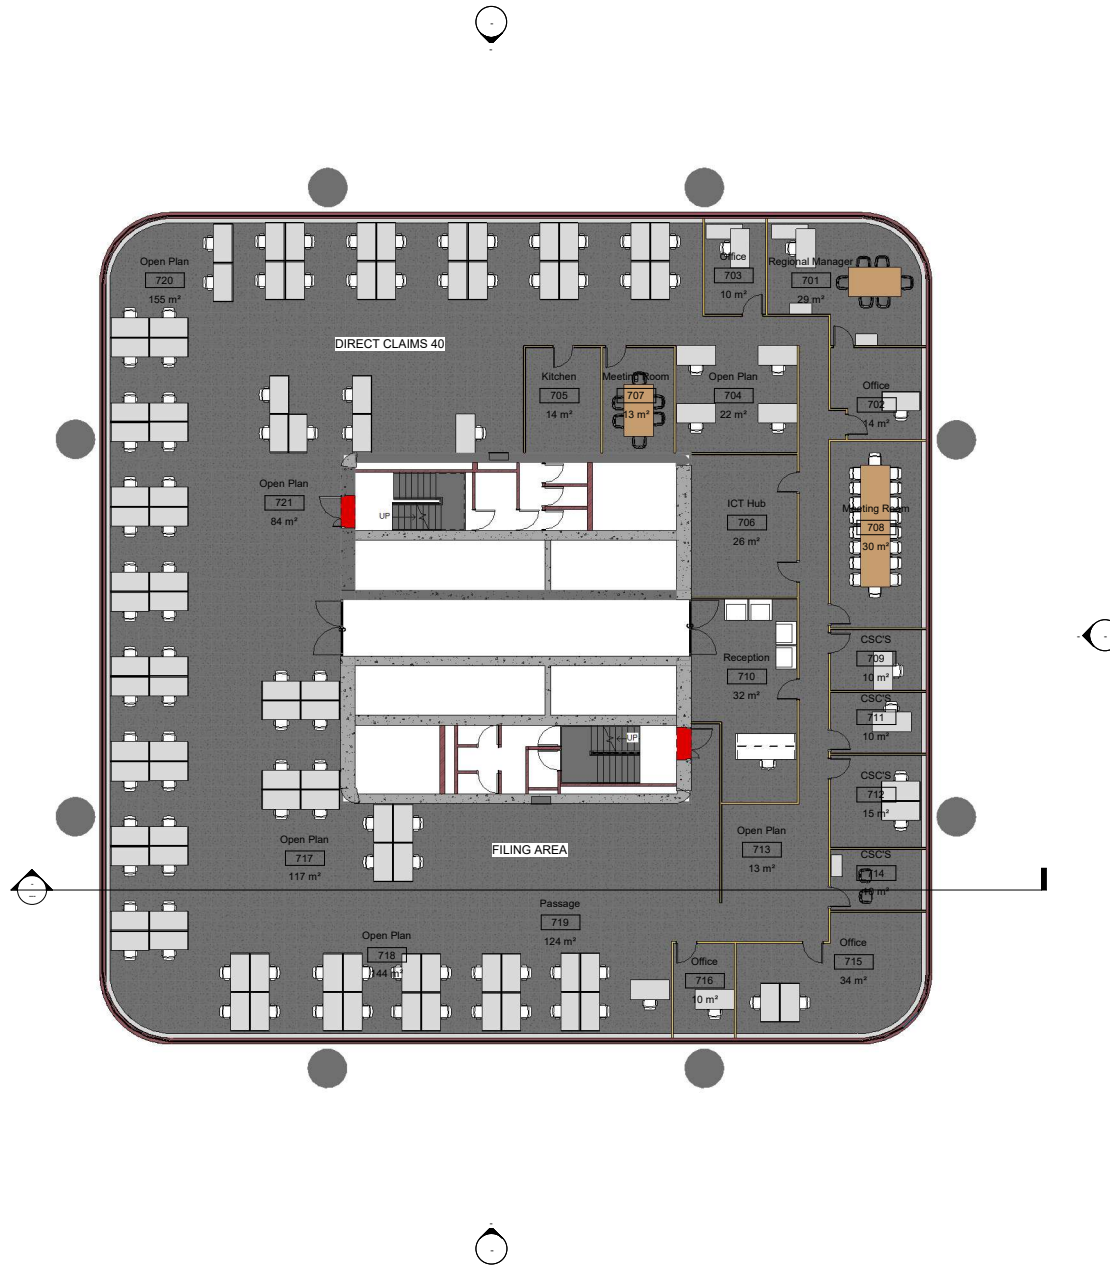

① Level 7
1 : 100

COPYRIGHT AND RIGHT OF REPRODUCTION OF THIS DRAWING OR ANY PORTION THEREOF IS RESERVED. CONTRACTOR TO VERIFY ALL LEVELS, HEIGHTS, AND DIMENSIONS ON SITE AND CHECK SAME AGAINST DRAWING BEFORE PUTTING ANY WORK IN HAND. ANY DISCREPANCIES TO BE REPORTED IMMEDIATELY TO THE ARCHITECT FOR CLARIFICATION. THIS DRAWING IS NOT TO BE SCALED - FIGURED DIMENSIONS TO BE USED AT ALL TIMES. ALL WORK TO BE CARRIED OUT IN STRICT ACCORDANCE WITH THE LOCAL AUTHORITIES' REQUIREMENTS, NATIONAL BUILDING REGULATIONS, AND THE RELEVANT S.A.B.S. STANDARDS. THIS DRAWING TO BE READ IN CONJUNCTION WITH OTHER CONSULTANTS DRAWINGS, DETAILS, AND ALL RELEVANT SPECIFICATIONS OR SCHEDULES AS MAY BE ISSUED.

REVISIONS		
Rev	Description	Date


NOTES		



ROAD ACCIDENT FUND PRIVATE BAG X178
FACILITIES CENTURION
MANAGEMENT 0046
420 WHICH-HAZEL AVE SOUTH AFRICA
ECO GLADES 2 TEL : +27 12 621-1789
BLOK F teriakhi@raf.co.za
ECO PARK
CENTURION
www.raf.co.za

PROJECT NAME	
CAPE TOWN THIBAUT SQUARE	
SHEET NAME	

7th FLOOR		
DATE	SCALE	DRAWN BY
01/12/2022	1 : 100	Author
DRAWING/SHEET NUMBER	REVISION	
07		

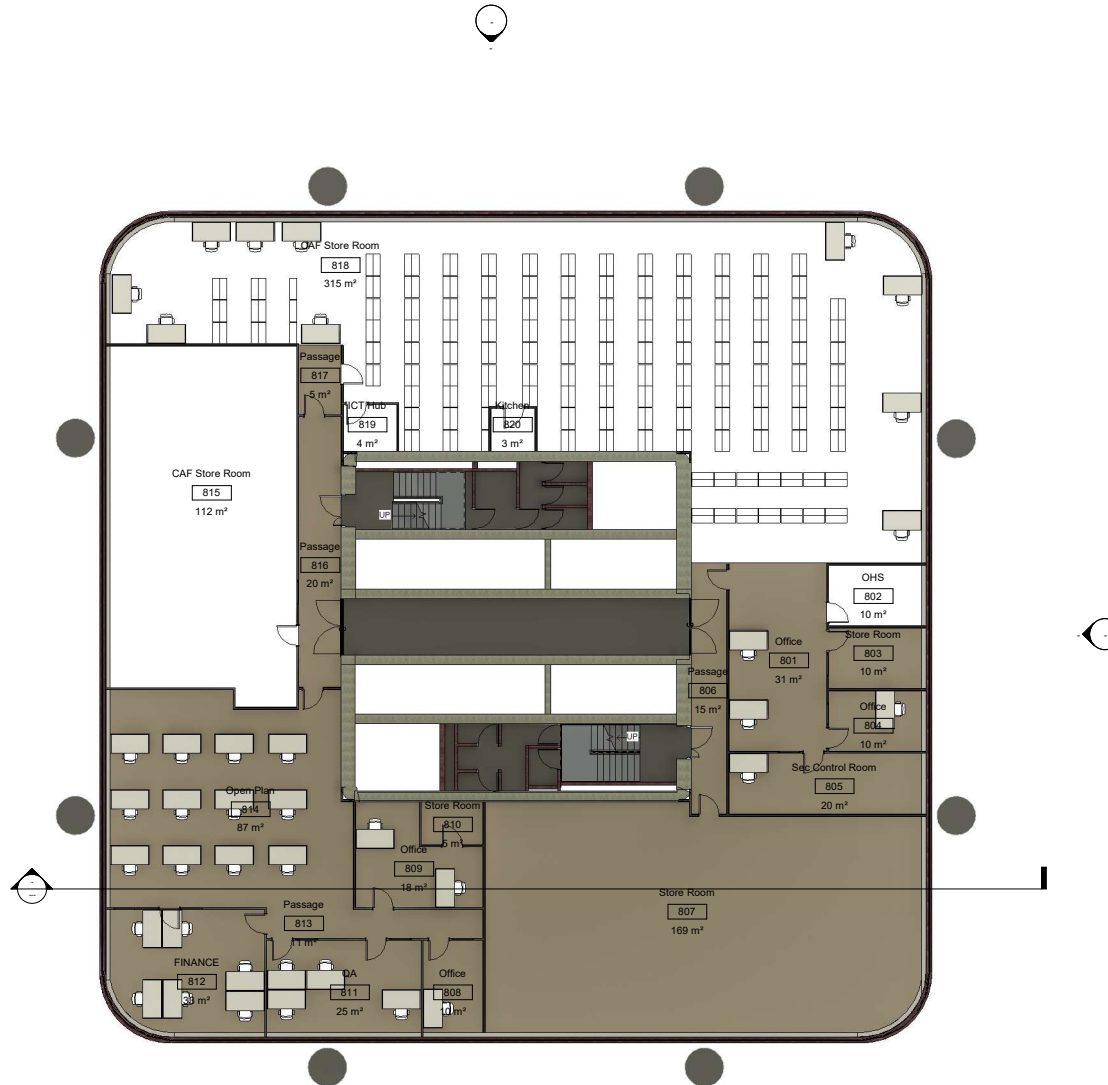

1 Level 8
1 : 100

COPYRIGHT AND RIGHT OF REPRODUCTION OF THIS DRAWING OR ANY PORTION THEREOF IS RESERVED. CONTRACTOR TO VERIFY ALL LEVELS, HEIGHTS, AND DIMENSIONS ON SITE AND CHECK SAME AGAINST DRAWING BEFORE PUTTING ANY WORK IN HAND. ANY DISCREPANCIES TO BE REPORTED IMMEDIATELY TO THE ARCHITECT FOR CLARIFICATION. THIS DRAWING IS NOT TO BE SCALED - FIGURED DIMENSIONS TO BE USED AT ALL TIMES. ALL WORK TO BE CARRIED OUT IN STRICT ACCORDANCE WITH THE LOCAL AUTHORITIES' REQUIREMENTS, NATIONAL BUILDING REGULATIONS, AND THE RELEVANT S.A.B.S. STANDARDS. THIS DRAWING TO BE READ IN CONJUNCTION WITH OTHER CONSULTANTS DRAWINGS, DETAILS, AND ALL RELEVANT SPECIFICATIONS OR SCHEDULES AS MAY BE ISSUED.

REVISIONS		
Rev	Description	Date

--	--	--

NOTES

--	--	--




ROAD ACCIDENT FUND PRIVATE BAG X178
FACILITIES CENTURION
MANAGEMENT 0046
420 WHICH-HAZEL AVE SOUTH AFRICA
ECO GLADES 2 TEL : +27 12 621-1789
BLOCK F teriakhi@raf.co.za
ECO PARK
CENTURION
www.raf.co.za

PROJECT NAME		
CAPE TOWN THIBAUT SQUARE		

SHEET NAME

8TH FLOOR		
-----------	--	--

DATE	SCALE	DRAWN BY
01/12/2022	1 : 100	Author
DRAWING/SHEET NUMBER	REVISION	
08		

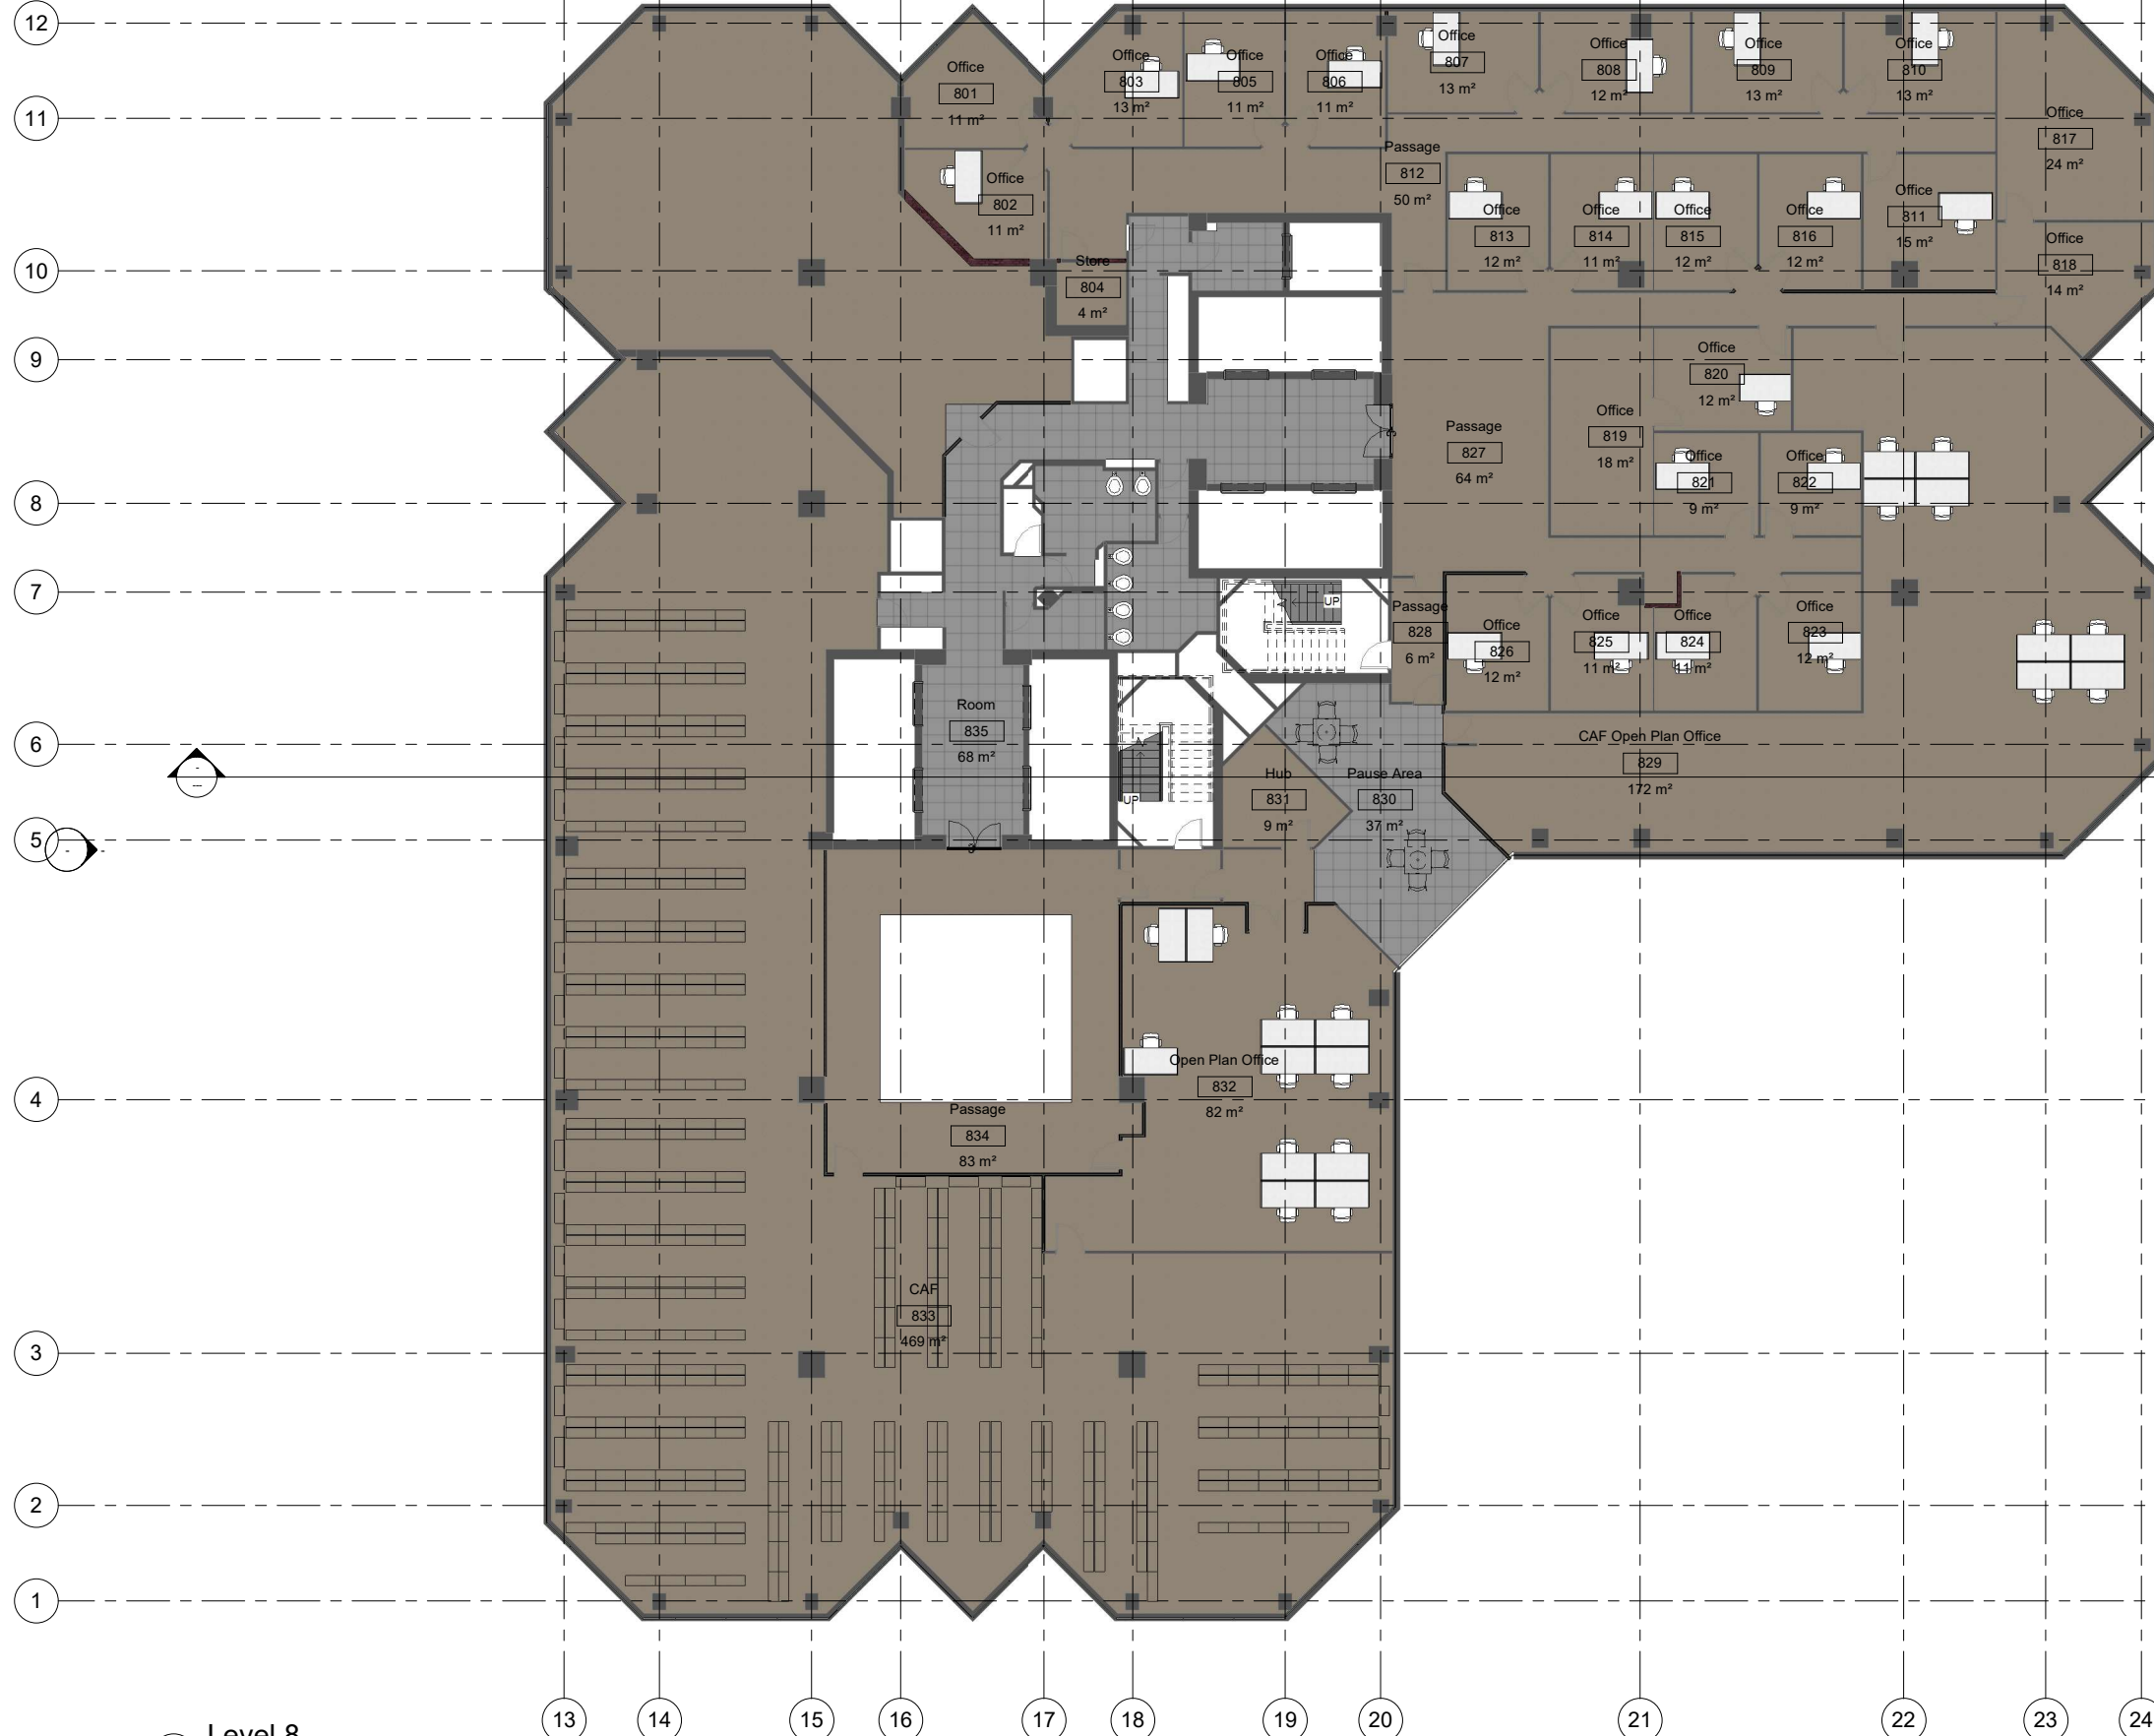

1 Level 8
1 : 100

COPYRIGHT AND RIGHT OF REPRODUCTION OF THIS DRAWING OR ANY PORTION THEREOF IS RESERVED. CONTRACTOR TO VERIFY ALL LEVELS, HEIGHTS, AND DIMENSIONS ON SITE AND CHECK SAME AGAINST DRAWING BEFORE PUTTING ANY WORK IN HAND. ANY DISCREPANCIES TO BE REPORTED IMMEDIATELY TO THE ARCHITECT FOR CLARIFICATION. THIS DRAWING IS NOT TO BE SCALED - FIGURED DIMENSIONS TO BE USED AT ALL TIMES. ALL WORK TO BE CARRIED OUT IN STRICT ACCORDANCE WITH THE LOCAL AUTHORITIES' REQUIREMENTS, NATIONAL BUILDING REGULATIONS, AND THE RELEVANT S.A.B.S. STANDARDS. THIS DRAWING TO BE READ IN CONJUNCTION WITH OTHER CONSULTANTS DRAWINGS, DETAILS, AND ALL RELEVANT SPECIFICATIONS OR SCHEDULES AS MAY BE ISSUED.

REVISIONS		
Rev	Description	Date
A	Rev 1	22/07/19

NOTES




ROAD ACCIDENT FUND PRIVATE BAG X178
FACILITIES CENTURION 0046
MANAGEMENT 420 WHICH-HAZEL AVE SOUTH AFRICA
ECO GLADES 2 TEL : +27 12 621-1789
BLOCK F tertiakh@raf.co.za
ECO PARK
CENTURION
www.raf.co.za

PROJECT NAME
DURBAN : EMBASSY
BUILDING

SHEET NAME
8th FLOOR

DATE	SCALE	DRAWN BY
31.03.2021	1 : 100	Author
DRAWING/SHEET NUMBER		REVISION
01		A

12
11
10
9
8
7
6
5
4
3
2
1

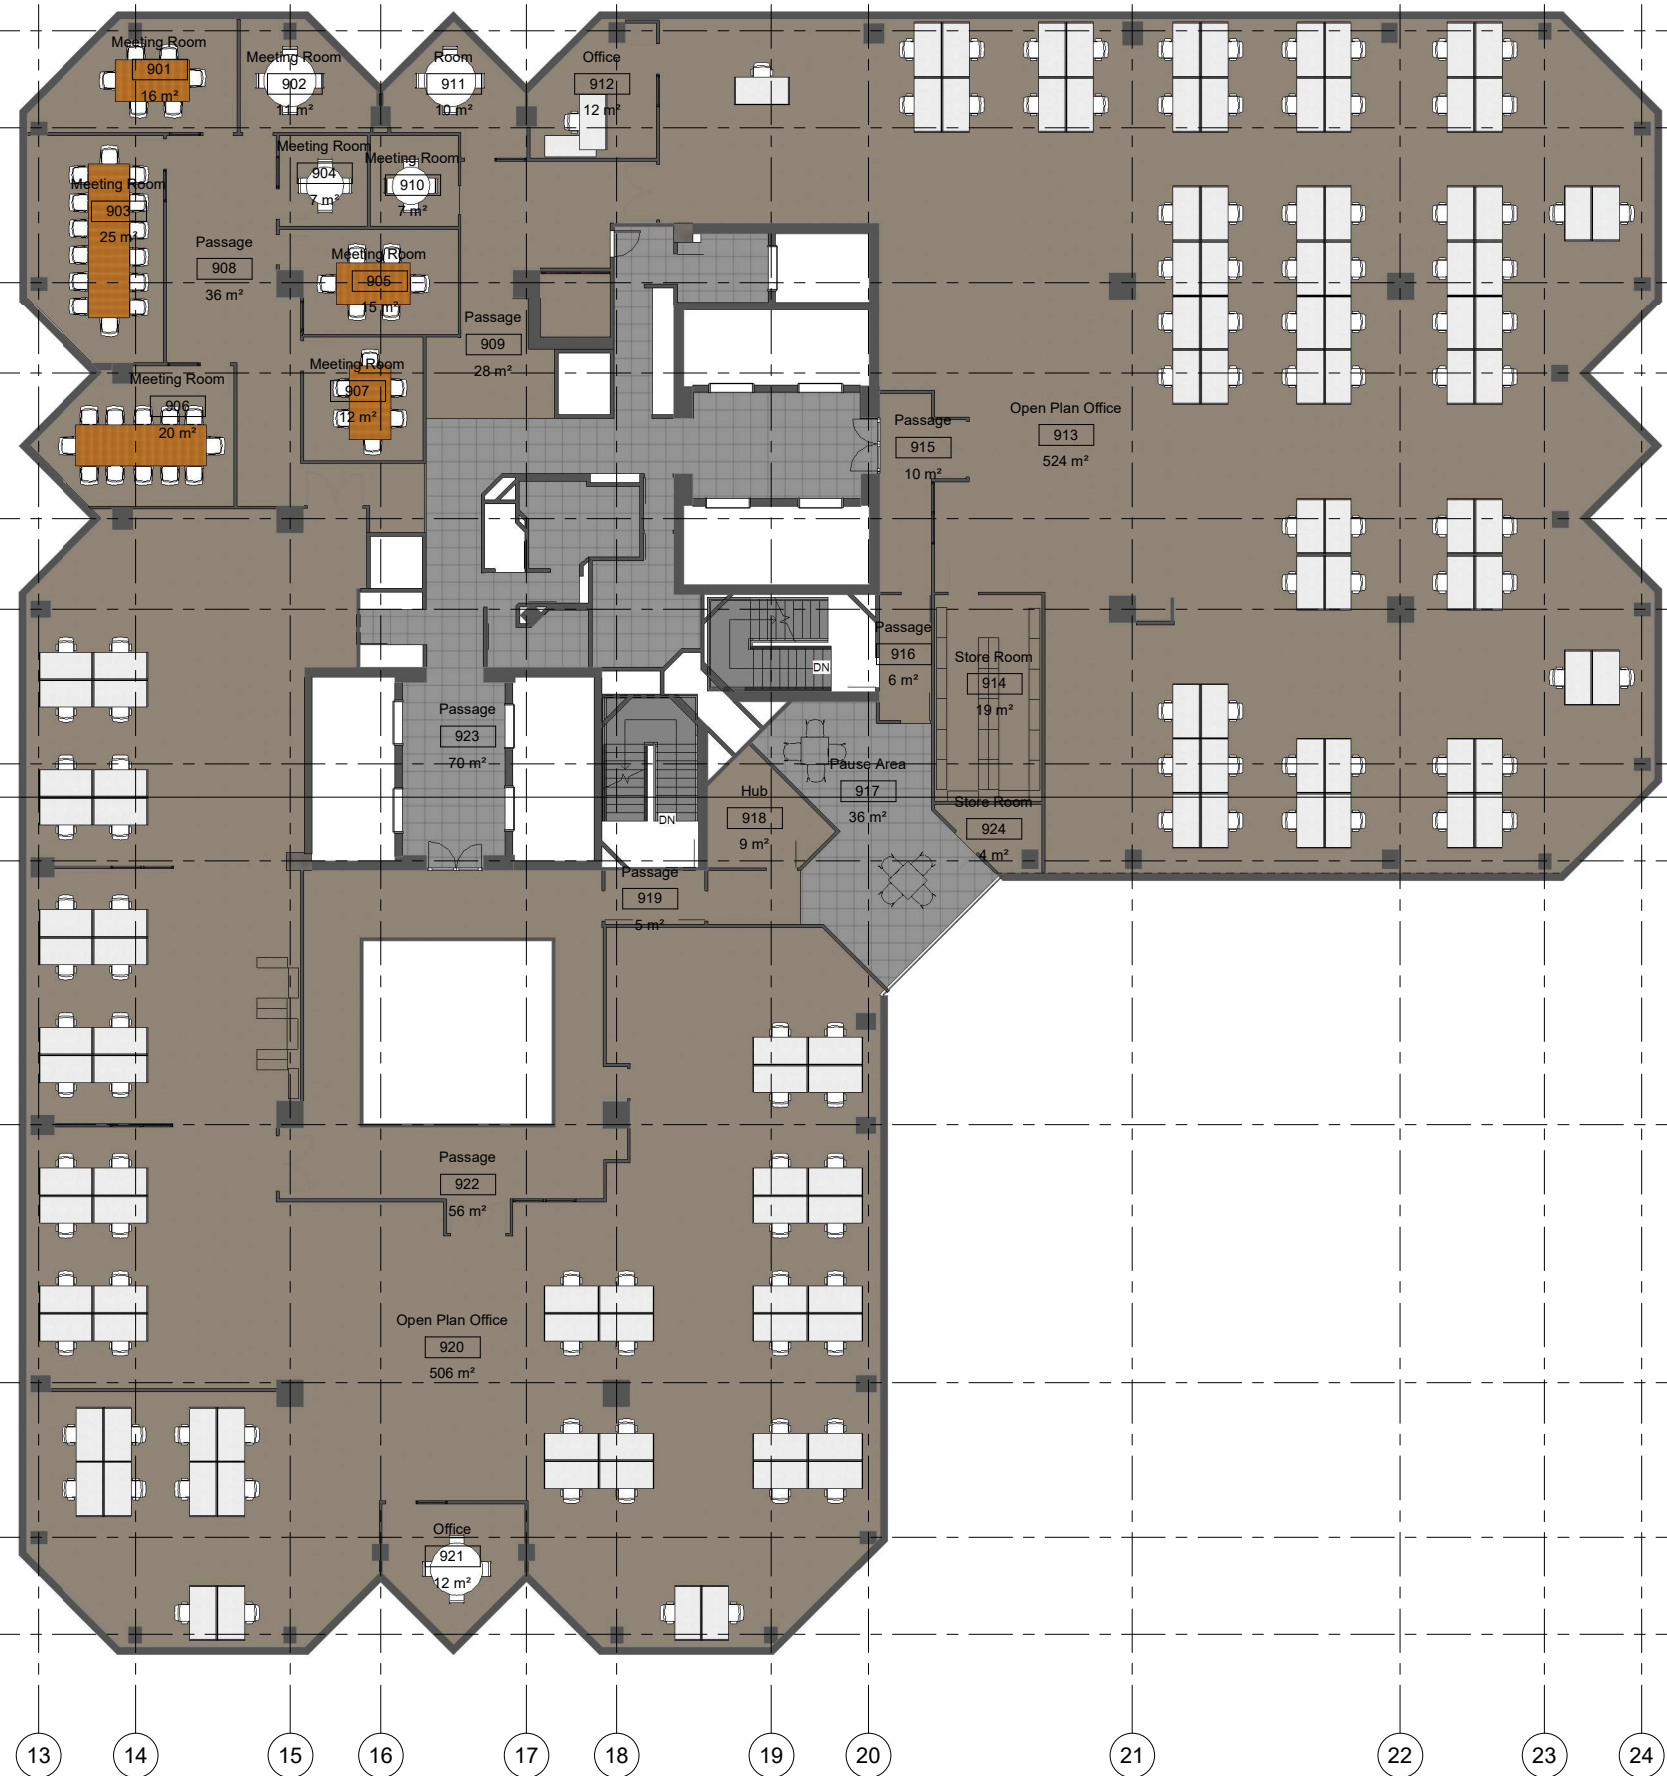

1 Level 9
1 : 100

COPYRIGHT AND RIGHT OF REPRODUCTION OF THIS DRAWING OR ANY PORTION THEREOF IS RESERVED. CONTRACTOR TO VERIFY ALL LEVELS, HEIGHTS, AND DIMENSIONS ON SITE AND CHECK SAME AGAINST DRAWING BEFORE PUTTING ANY WORK IN HAND. ANY DISCREPANCIES TO BE REPORTED IMMEDIATELY TO THE ARCHITECT FOR CLARIFICATION. THIS DRAWING IS NOT TO BE SCALED - FIGURED DIMENSIONS TO BE USED AT ALL TIMES. ALL WORK TO BE CARRIED OUT IN STRICT ACCORDANCE WITH THE LOCAL AUTHORITIES' REQUIREMENTS, NATIONAL BUILDING REGULATIONS, AND THE RELEVANT S.A.B.S. STANDARDS. THIS DRAWING TO BE READ IN CONJUNCTION WITH OTHER CONSULTANTS DRAWINGS, DETAILS, AND ALL RELEVANT SPECIFICATIONS OR SCHEDULES AS MAY BE ISSUED.

REVISIONS		
Rev	Description	Date

NOTES		




ROAD ACCIDENT FUND FACILITIES MANAGEMENT
420 WHICH-HAZEL AVE ECO GLADES 2 BLOCK F
CENTURION
www.raf.co.za

PRIVATE BAG X178 CENTURION 0046
SOUTH AFRICA
TEL : +27 12 621-1789
tertiakh@raf.co.za

PROJECT NAME		
DURBAN : EMBASSY BUILDING		

SHEET NAME		
9th FLOOR		

DATE	SCALE	DRAWN BY
31.03.2021	1 : 100	Author
DRAWING/SHEET NUMBER		REVISION
02		

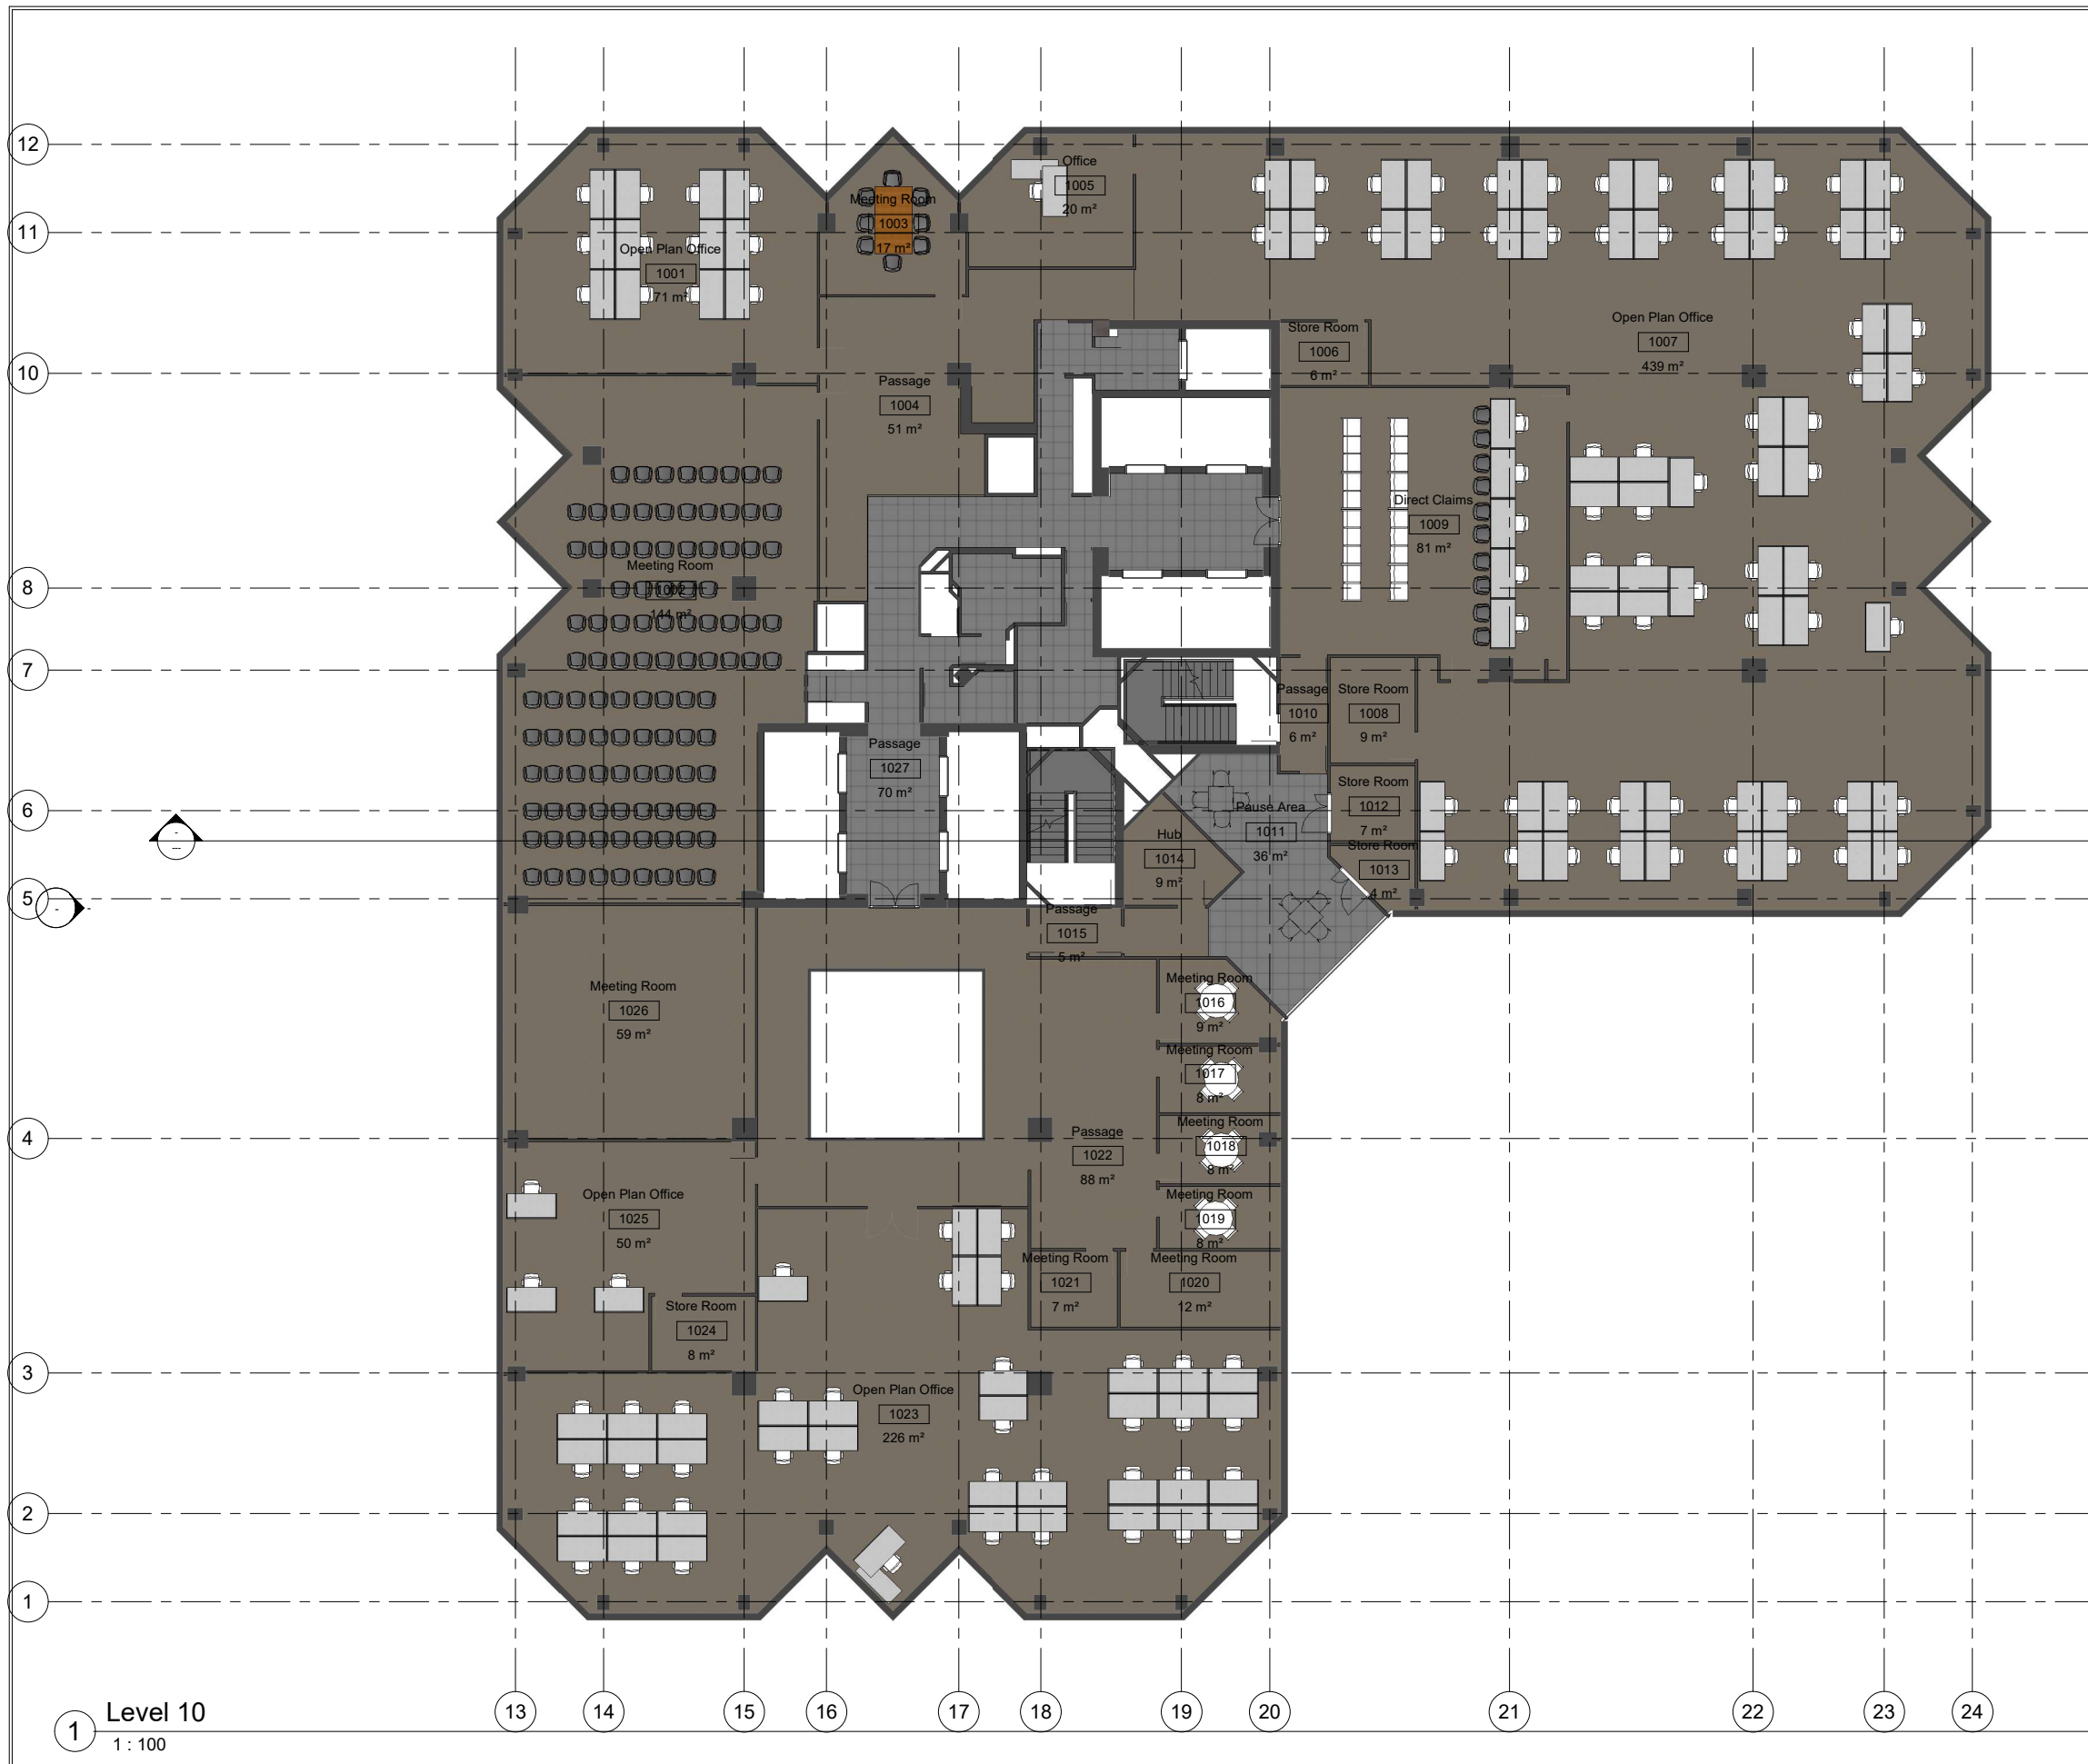

COPYRIGHT AND RIGHT OF REPRODUCTION OF THIS DRAWING OR ANY PORTION THEREOF IS RESERVED. CONTRACTOR TO VERIFY ALL LEVELS, HEIGHTS, AND DIMENSIONS ON SITE AND CHECK SAME AGAINST DRAWING BEFORE PUTTING ANY WORK IN HAND. ANY DISCREPANCIES TO BE REPORTED IMMEDIATELY TO THE ARCHITECT FOR CLARIFICATION. THIS DRAWING IS NOT TO BE SCALED - FIGURED DIMENSIONS TO BE USED AT ALL TIMES. ALL WORK TO BE CARRIED OUT IN STRICT ACCORDANCE WITH THE LOCAL AUTHORITIES' REQUIREMENTS, NATIONAL BUILDING REGULATIONS, AND THE RELEVANT S.A.B.S. STANDARDS. THIS DRAWING TO BE READ IN CONJUNCTION WITH OTHER CONSULTANTS DRAWINGS, DETAILS, AND ALL RELEVANT SPECIFICATIONS OR SCHEDULES AS MAY BE ISSUED.

REVISIONS		
Rev	Description	Date

NOTES		



ROAD ACCIDENT FUND PRIVATE BAG X178
FACILITIES CENTURION
MANAGEMENT 0046
420 WHICH-HAZEL AVE SOUTH AFRICA
ECO GLADES 2 TEL : +27 12 621-1789
BLOCK F terriakh@raf.co.za
ECO PARK
CENTURION
www.raf.co.za

PROJECT NAME		
DURBAN : EMBASSY BUILDING		

SHEET NAME		
10th FLOOR		

DATE	SCALE	DRAWN BY
31.03.2021	1 : 100	Author
DRAWING/SHEET NUMBER		REVISION
03		



COPYRIGHT AND RIGHT OF REPRODUCTION OF THIS DRAWING OR ANY PORTION THEREOF IS RESERVED. CONTRACTOR TO VERIFY ALL LEVELS, HEIGHTS, AND DIMENSIONS ON SITE AND CHECK SAME AGAINST DRAWING BEFORE PUTTING ANY WORK IN HAND. ANY DISCREPANCIES TO BE REPORTED IMMEDIATELY TO THE ARCHITECT FOR CLARIFICATION. THIS DRAWING IS NOT TO BE SCALED - FIGURED DIMENSIONS TO BE USED AT ALL TIMES. ALL WORK TO BE CARRIED OUT IN STRICT ACCORDANCE WITH THE LOCAL AUTHORITIES' REQUIREMENTS, NATIONAL BUILDING REGULATIONS, AND THE RELEVANT S.A.B.S. STANDARDS. THIS DRAWING TO BE READ IN CONJUNCTION WITH OTHER CONSULTANTS DRAWINGS, DETAILS, AND ALL RELEVANT SPECIFICATIONS OR SCHEDULES AS MAY BE ISSUED.

REVISIONS

Rev	Description	Date
-----	-------------	------

NOTES



ROAD ACCIDENT FUND PRIVATE BAG X178
FACILITIES CENTURION 0046
MANAGEMENT 420 WHICH-HAZEL AVE SOUTH AFRICA
ECO GLADES 2 TEL : +27 12 621-1789
BLOCK F teriakh@raf.co.za
ECO PARK
CENTURION
www.raf.co.za

PROJECT NAME


**DURBAN : EMBASSY
BUILDING**

SHEET NAME

12th FLOOR

DATE	SCALE	DRAWN BY
31.03.2021	1 : 100	Author
DRAWING/SHEET NUMBER		REVISION
05		

NOTES

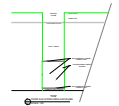


ROAD ACCIDENT FUND
FACILITIES
MANAGEMENT
420 WHICH-HAZEL AVE
ECO GLADES 2
BLOCK F
ECO PARK
CENTURION
www.raf.co.za

PROJECT NAME
DURBAN : EMBASSY BUILDING

SHEET NAME	
------------	--

GROUND FLOOR


DATE	SCALE	DRAWN BY
21.01.2020	1 : 100	Author
DRAWING/SHEET NUMBER		REVISION
06		

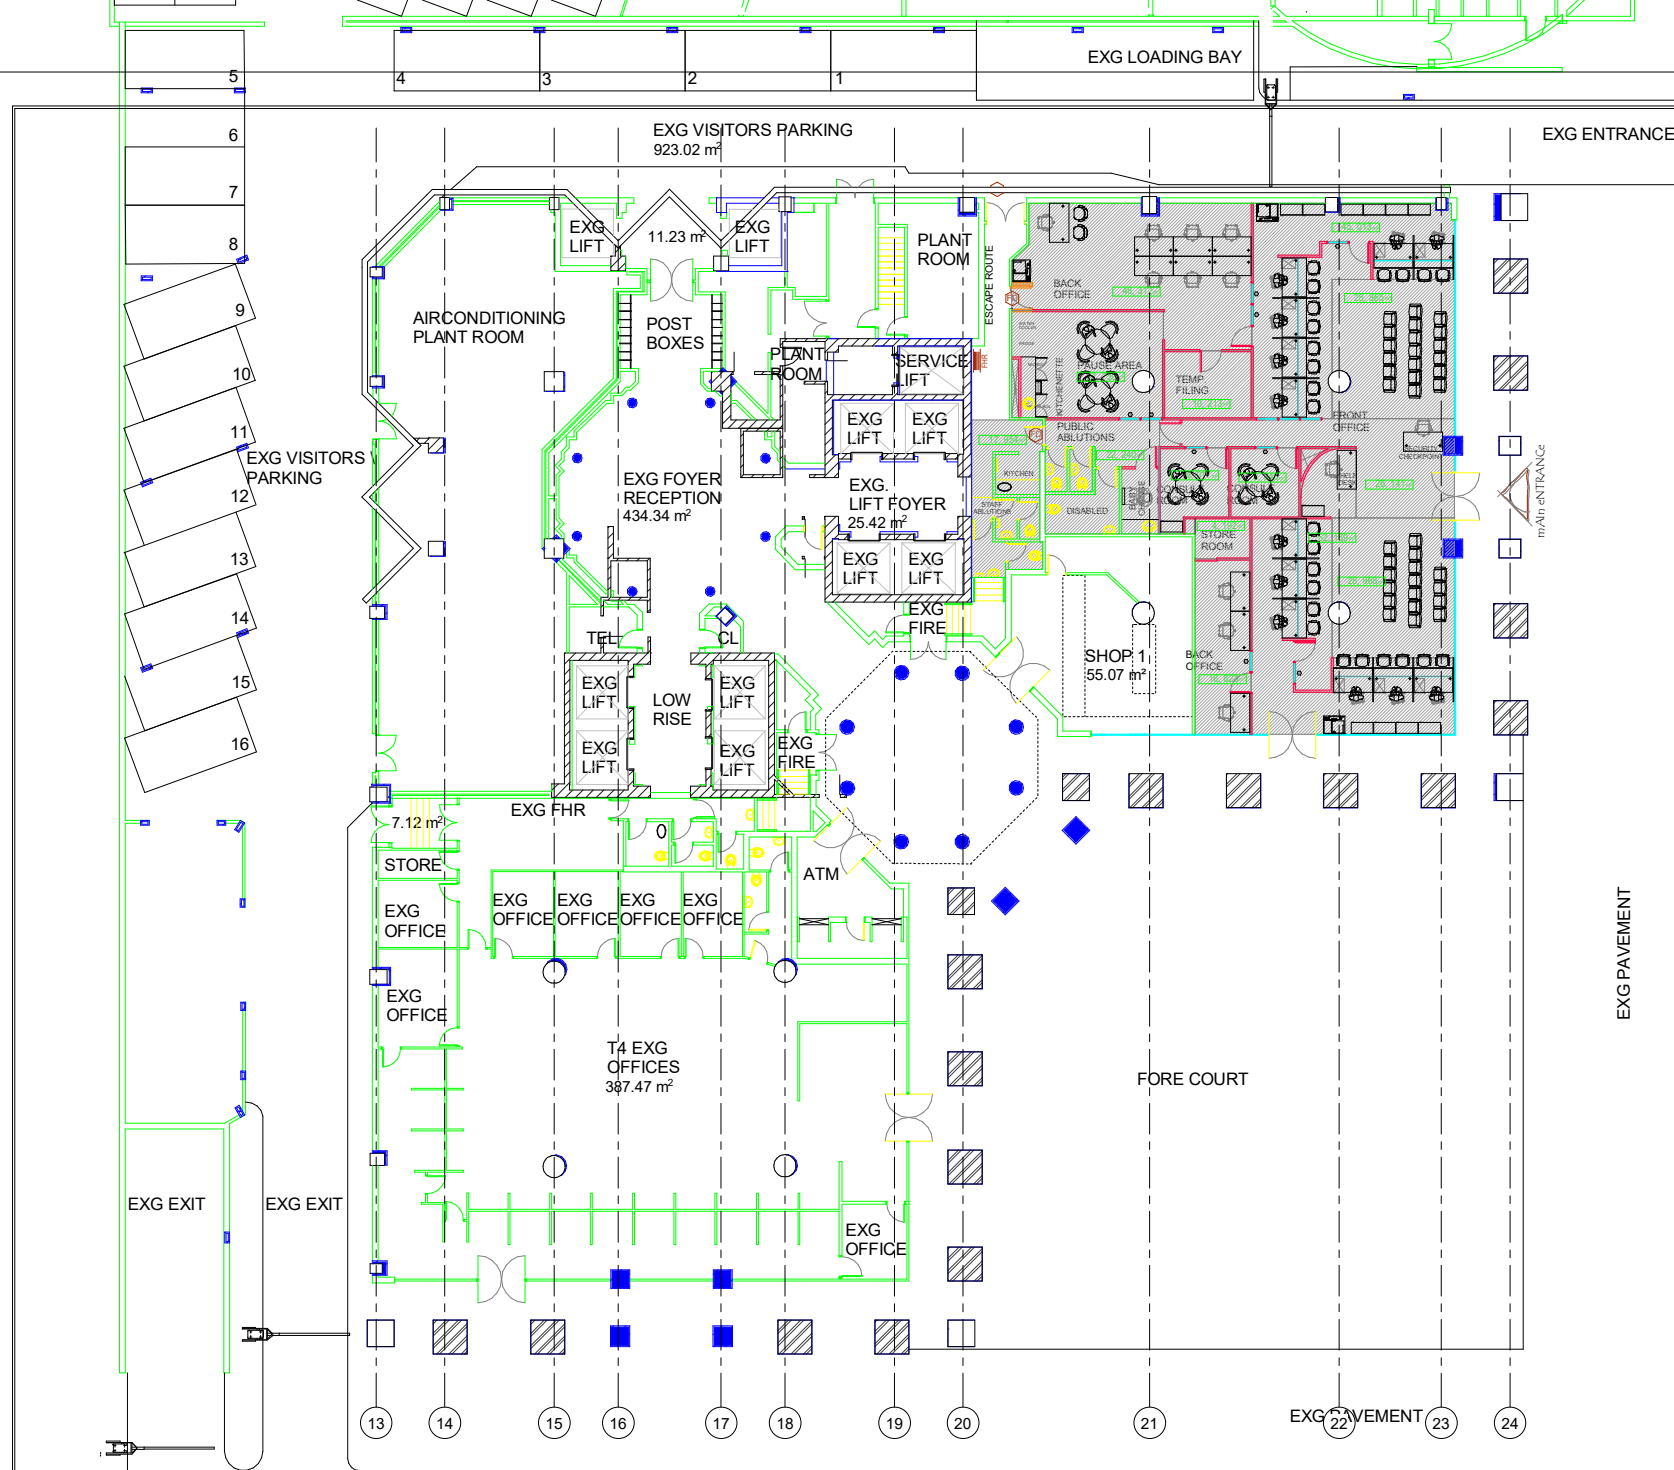

[illegible]

REVISIONS		
REV:	DESCRIPTION:	DATE:


NOTES:	

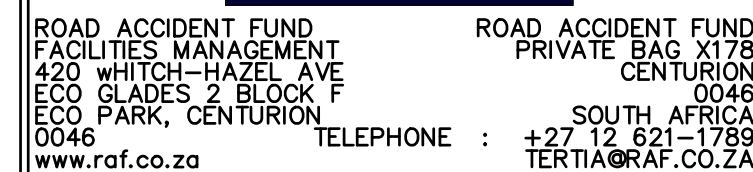

DRAWING TITLE:

FLOOR PLAN
AS-BUILT
PARTITION &
FURNITURE LAYOUT

PROJECT TITLE:			
CENTURION ECO GLADES BUILDING F GROUND FLOOR			
DATE:		SCALE:	DRAWN BY:
09.02.2023		1:50	TKH
DRAWING NUMBER:		SHEET NUMBER	REVISION:
EGF 000 MAS		01	00

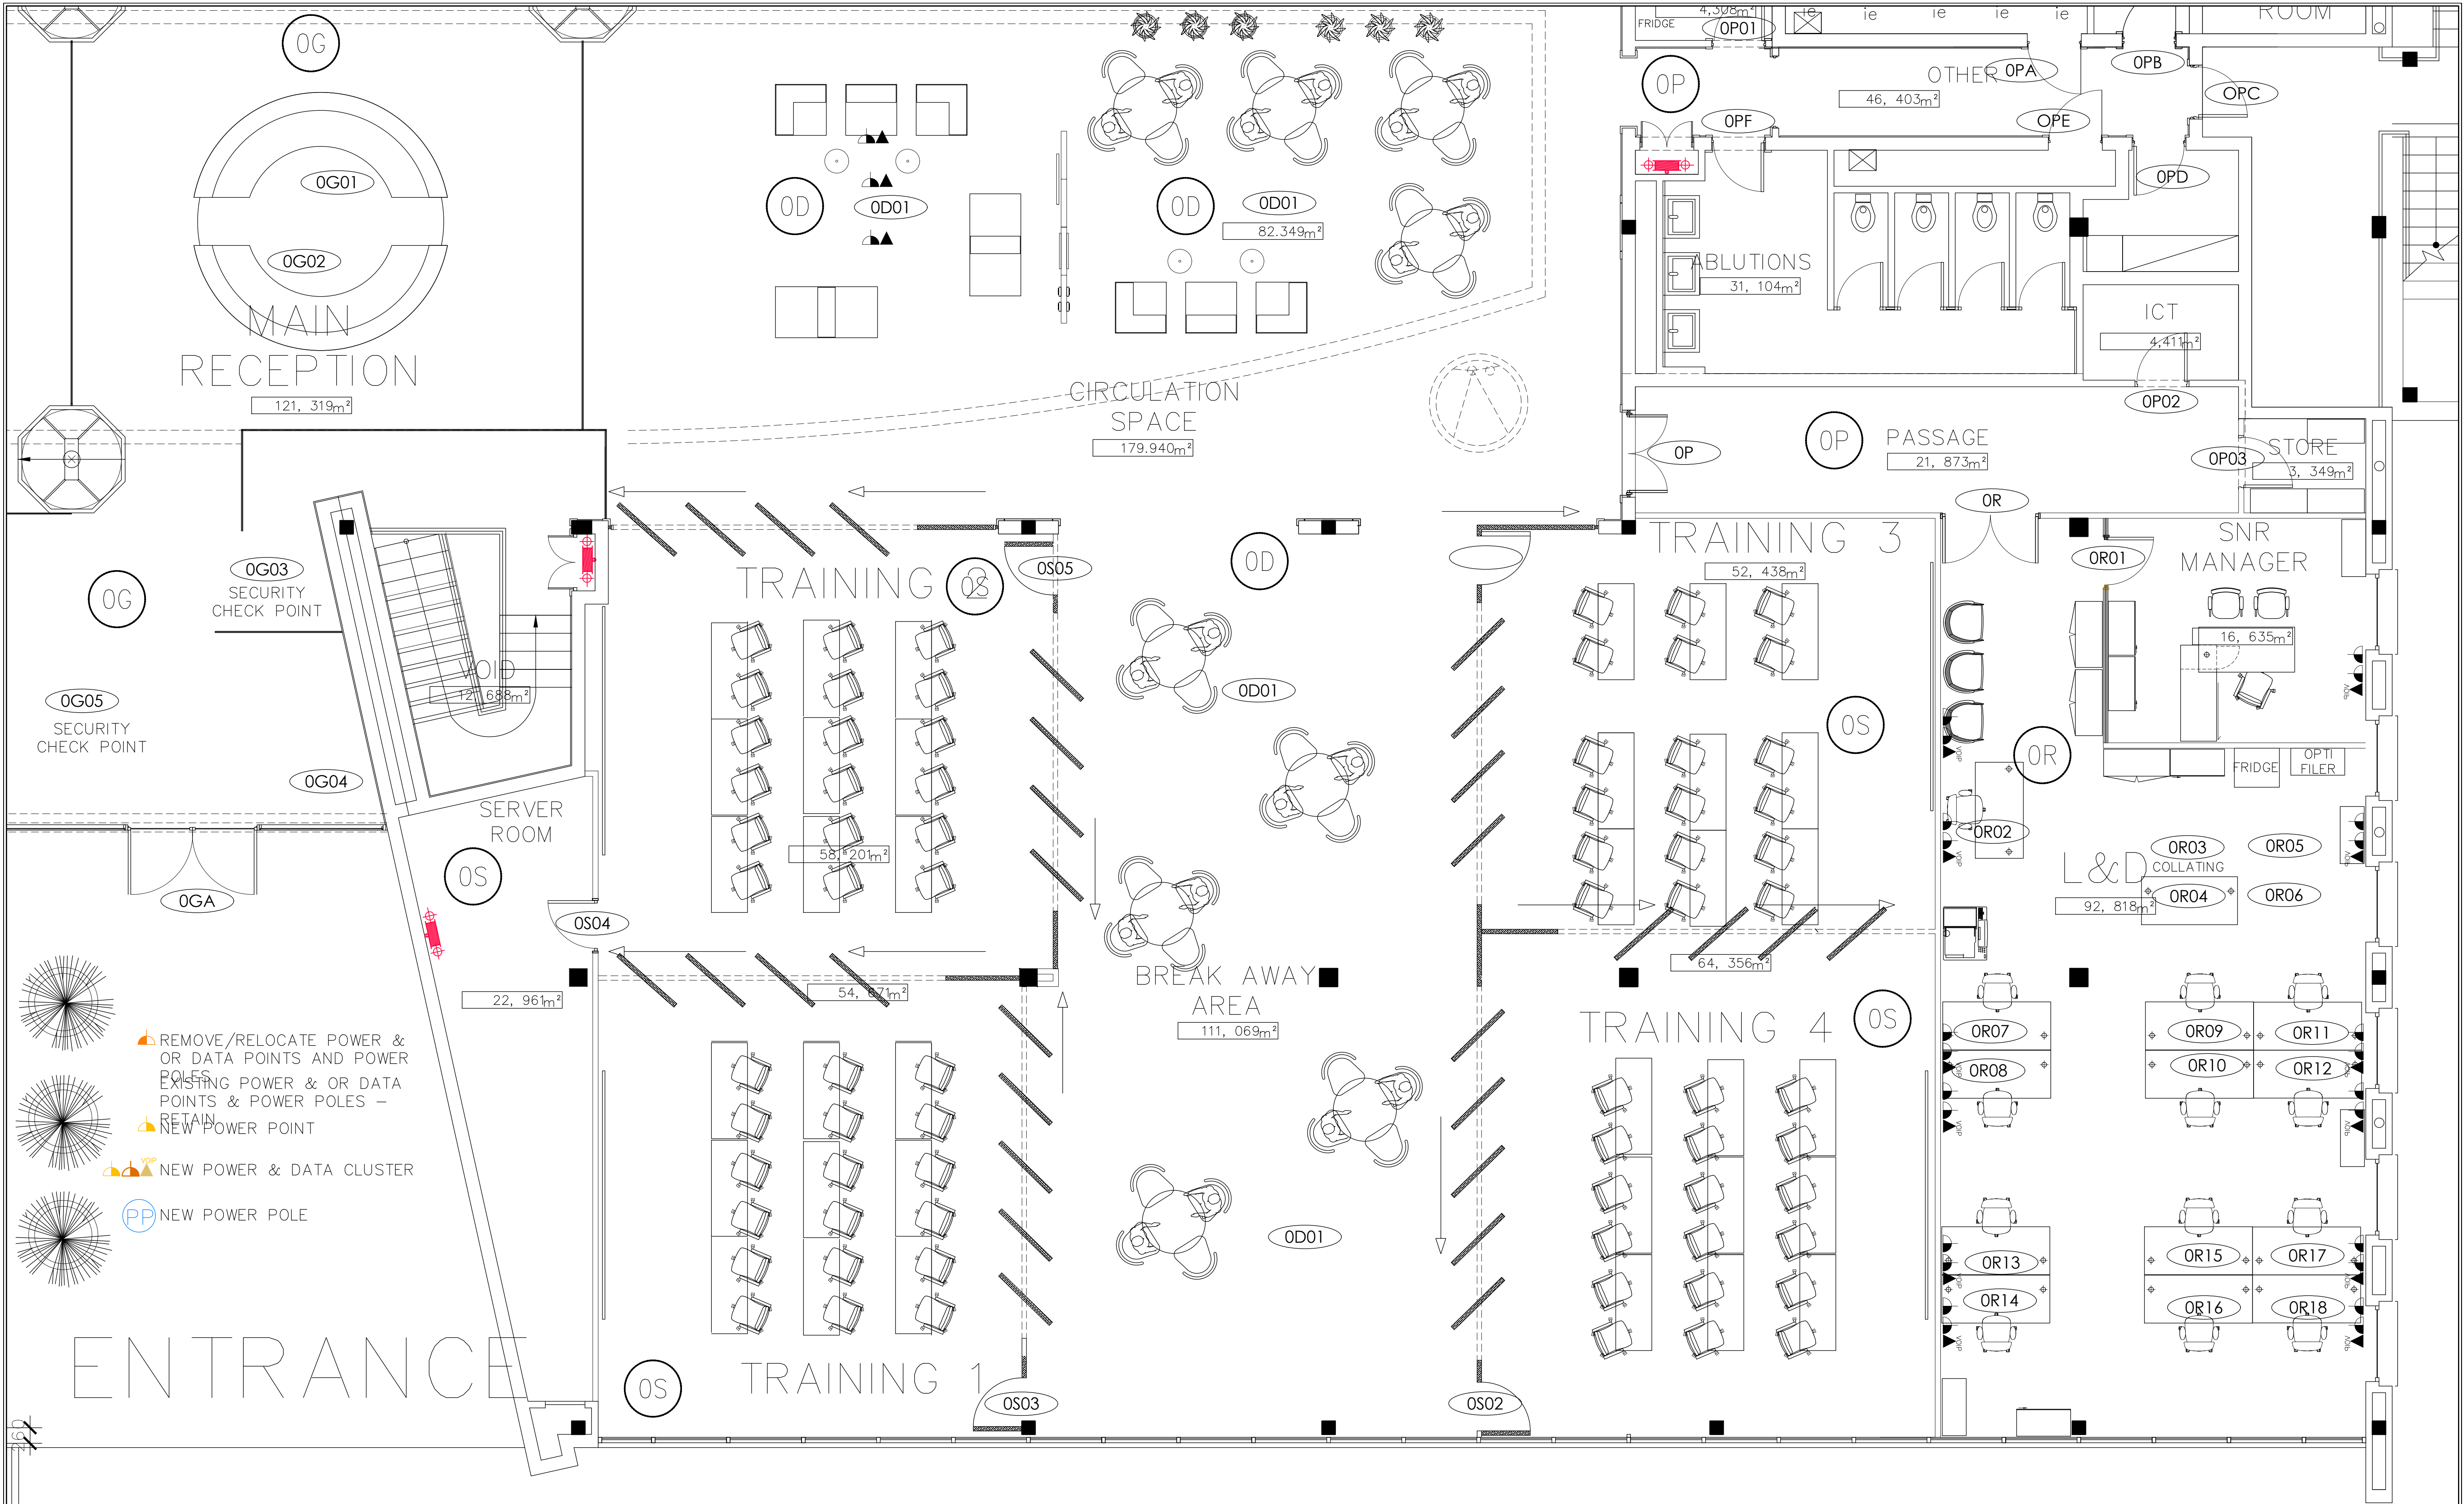

COPYRIGHT AND RIGHT OF REPRODUCTION OF THIS DRAWING OR ANY PORTION THEREOF IS RESERVED. CONTRACTOR TO VERIFY ALL LEVELS, HEIGHTS, AND DIMENSIONS ON SITE AND CHECK SAME AGAINST DRAWING BEFORE PUTTING ANY WORK IN HAND. ANY DISCREPANCIES TO BE REPORTED IMMEDIATELY TO THE ARCHITECT FOR CLARIFICATION. THIS DRAWING IS NOT TO BE SCALED - FIGURED DIMENSIONS TO BE USED AT ALL TIMES. ALL WORK TO BE CARRIED OUT IN STRICT ACCORDANCE WITH THE LOCAL AUTHORITIES' REQUIREMENTS, NATIONAL BUILDING REGULATIONS, AND THE RELEVANT S.A.B.S. STANDARDS. THIS DRAWING TO BE READ IN CONJUNCTION WITH OTHER CONSULTANTS DRAWINGS, DETAILS, AND ALL RELEVANT SPECIFICATIONS OR SCHEDULES AS MAY BE ISSUED.

REV.	REVISIONS DESCRIPTION	DATE

NOTES:




Road Accident Fund


ROAD ACCIDENT FUND
FACILITIES MANAGEMENT
420 WHITTON-RAZEL AVE
CENTURION 0046
ECO GLADES 2 BLOCK F
ECO PARK, CENTURION
0046
www.raf.co.za


ROAD ACCIDENT FUND
PRIVATE BAG X178
CENTURION 0046
SOUTH AFRICA
TELEPHONE : +27 12 621-1789
TERTIA@RAF.CO.ZA

DRAWING TITLE:
FLOOR PLAN AS-BUILT PARTITION & FURNITURE LAYOUT

PROJECT TITLE:		
CENTURION ECO GLADES BUILDING F GROUND FLOOR		
DATE:	SCALE:	DRAWN BY:
09.02.2023	1:50	TKH
DRAWING NUMBER:	SHEET NUMBER	REVISION:
EGF 000 MAS	01	00

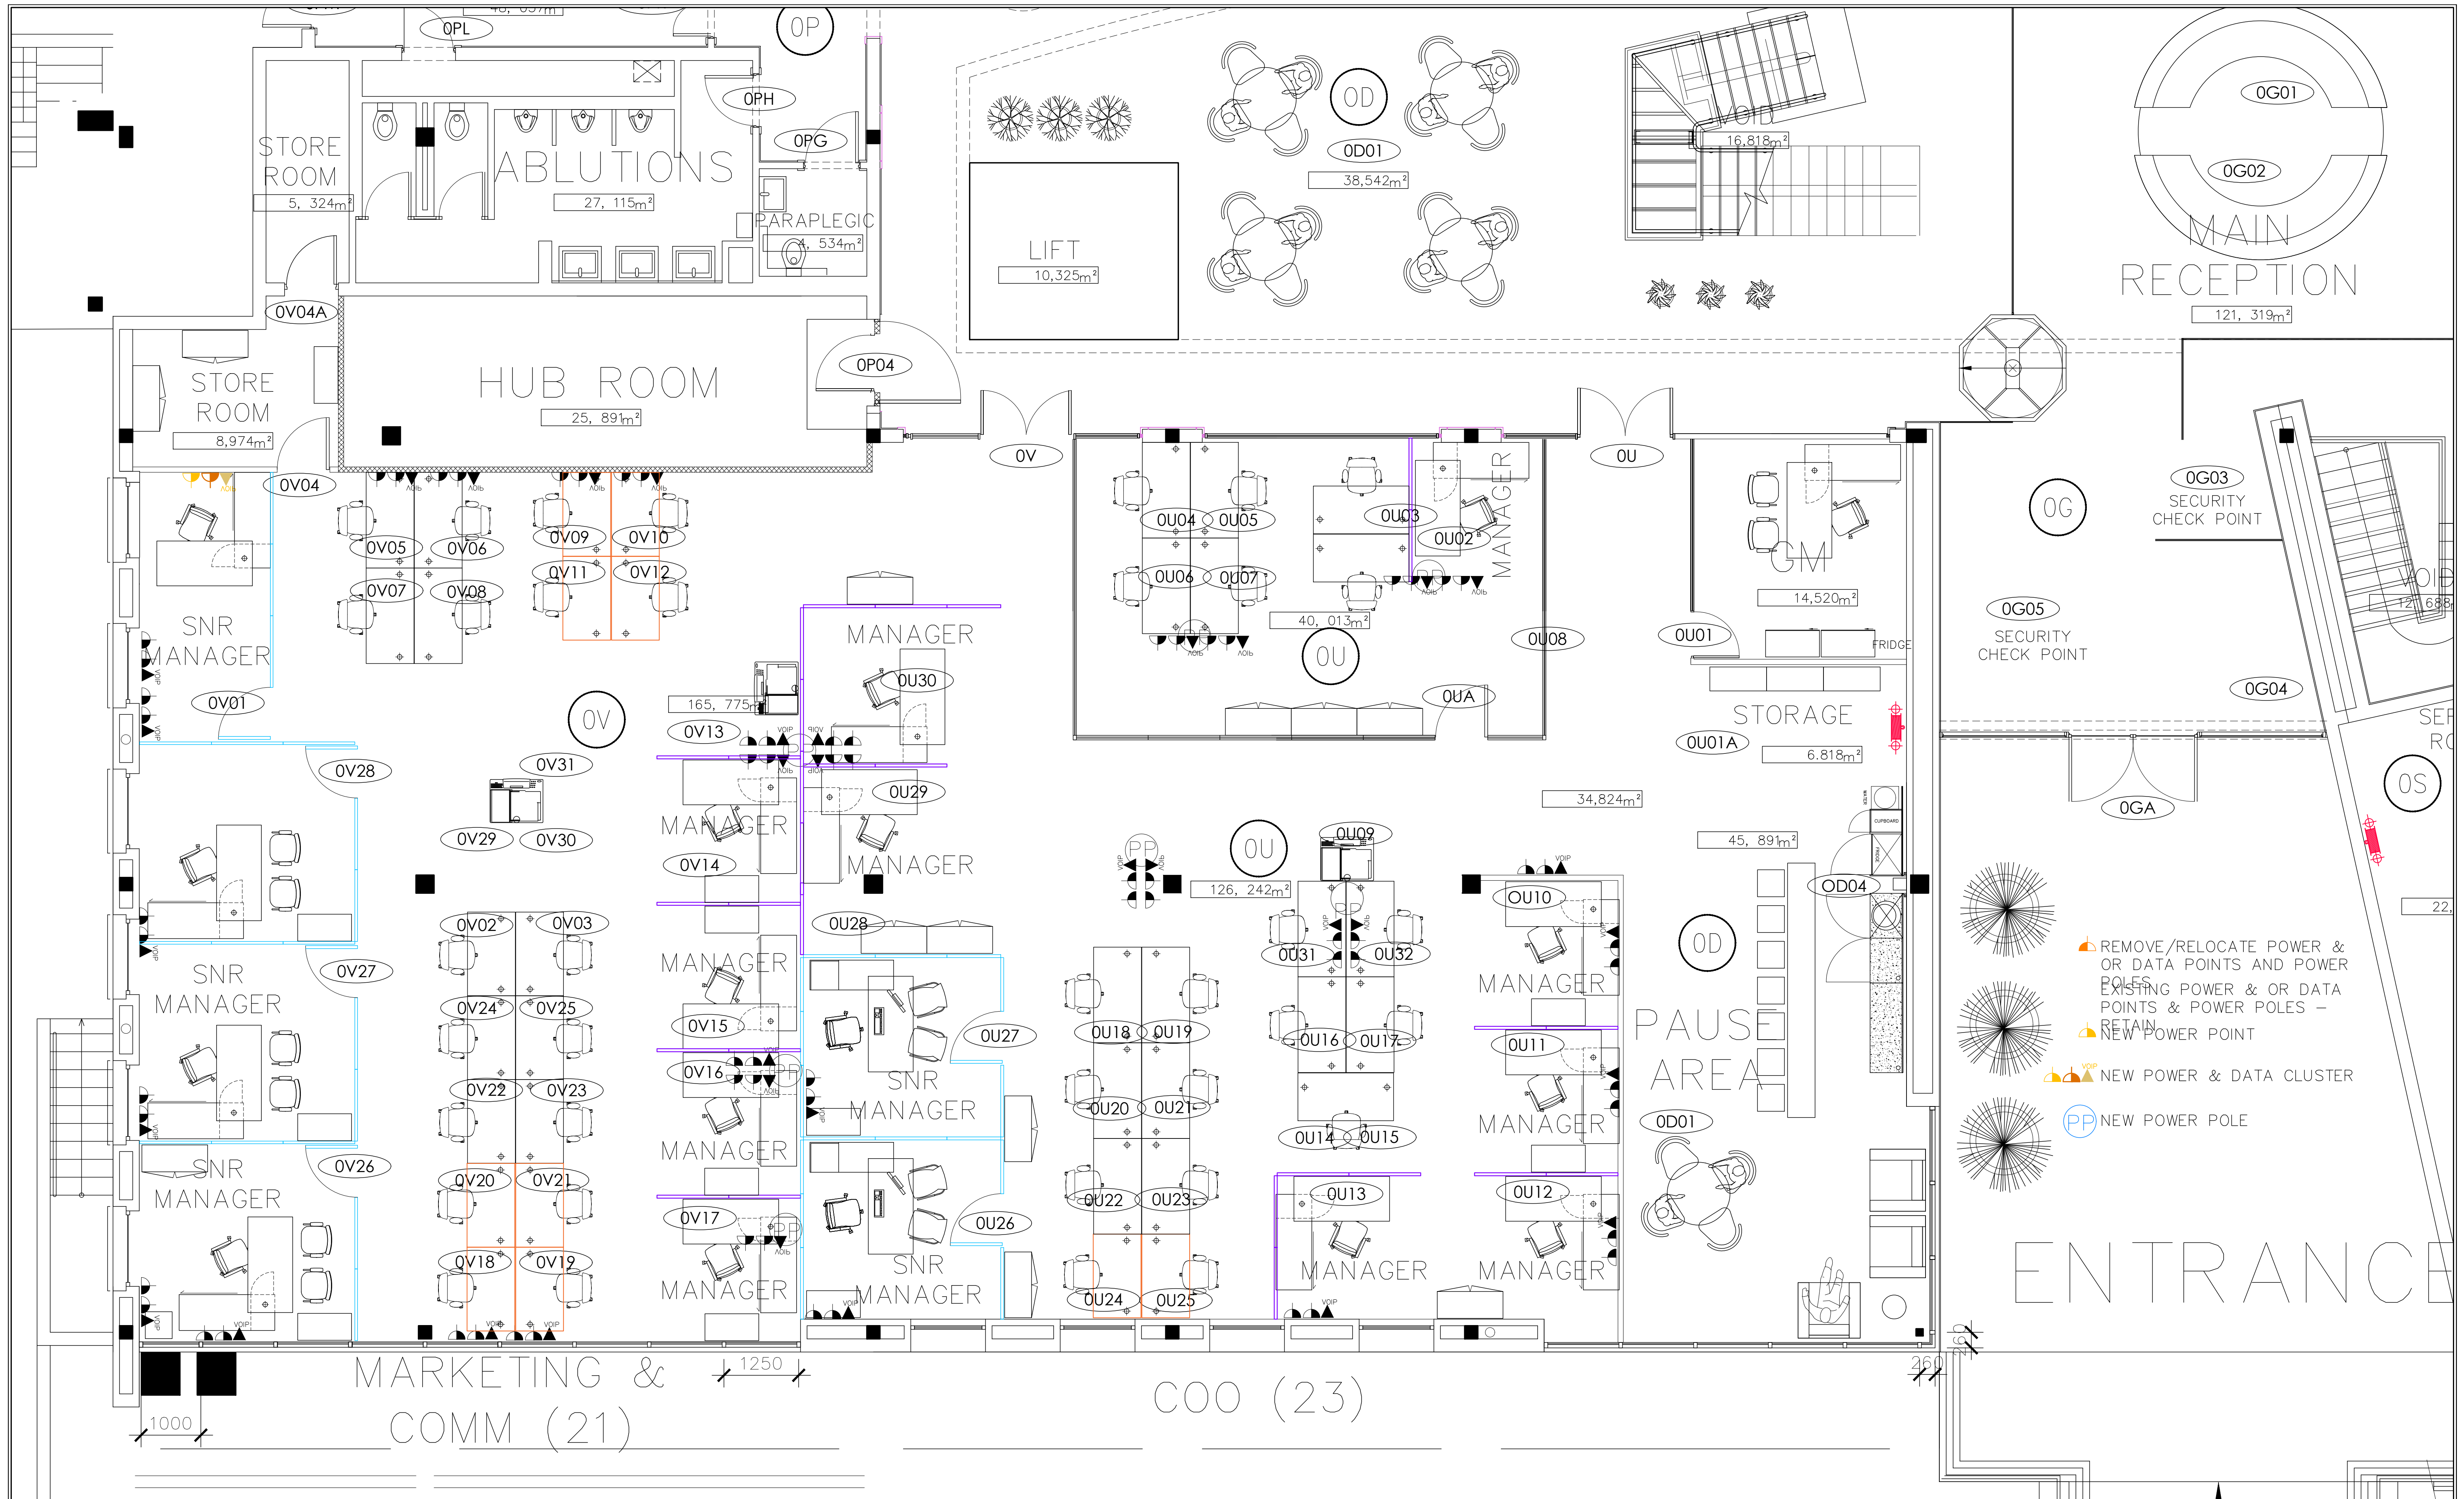

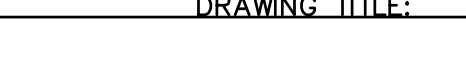COPYRIGHT AND RIGHT OF REPRODUCTION OF THIS DRAWING OR ANY PORTION THEREOF IS RESERVED. CONTRACTOR TO VERIFY ALL LEVELS, HEIGHTS, AND DIMENSIONS ON SITE AND CHECK SAME AGAINST DRAWING BEFORE PUTTING ANY WORK IN HAND. ANY DISCREPANCIES TO BE REPORTED IMMEDIATELY TO THE ARCHITECT FOR CLARIFICATION. THIS DRAWING IS NOT TO BE SCALED - FIGURED DIMENSIONS TO BE USED AT ALL TIMES. ALL WORK TO BE CARRIED OUT IN STRICT ACCORDANCE WITH THE LOCAL AUTHORITIES' REQUIREMENTS, NATIONAL BUILDING REGULATIONS, AND THE RELEVANT S.A.B.S. STANDARDS. THIS DRAWING TO BE READ IN CONJUNCTION WITH OTHER CONSULTANTS DRAWINGS, DETAILS, AND ALL RELEVANT SPECIFICATIONS OR SCHEDULES AS MAY BE	REV: REVISIONS DESCRIPTION: DATE:		NOTES:		 ROAD ACCIDENT FUND FACILITIES MANAGEMENT 420 WHITCH-HAZEL AVE ECO GLADES 2 BLOCK F ECO PARK, CENTURION 0046 www.rafa.co.za ROAD ACCIDENT FUND PRIVATE BAG X178 CENTURION 0046 SOUTH AFRICA +27 12 621-1789 TERTIA@RAF.CO.ZA	DRAWING TITLE: FLOOR PLAN AS-BUILT PARTITION & FURNITURE LAYOUT		PROJECT TITLE: CENTURION ECO GLADES BUILDING F GROUND FLOOR					
								DATE: 09.02.2023		SCALE: 1:50		DRAWN BY: TKH	
								DRAWING NUMBER: EGF 000 MAS		SHEET NUMBER: 01		REVISION: 00	

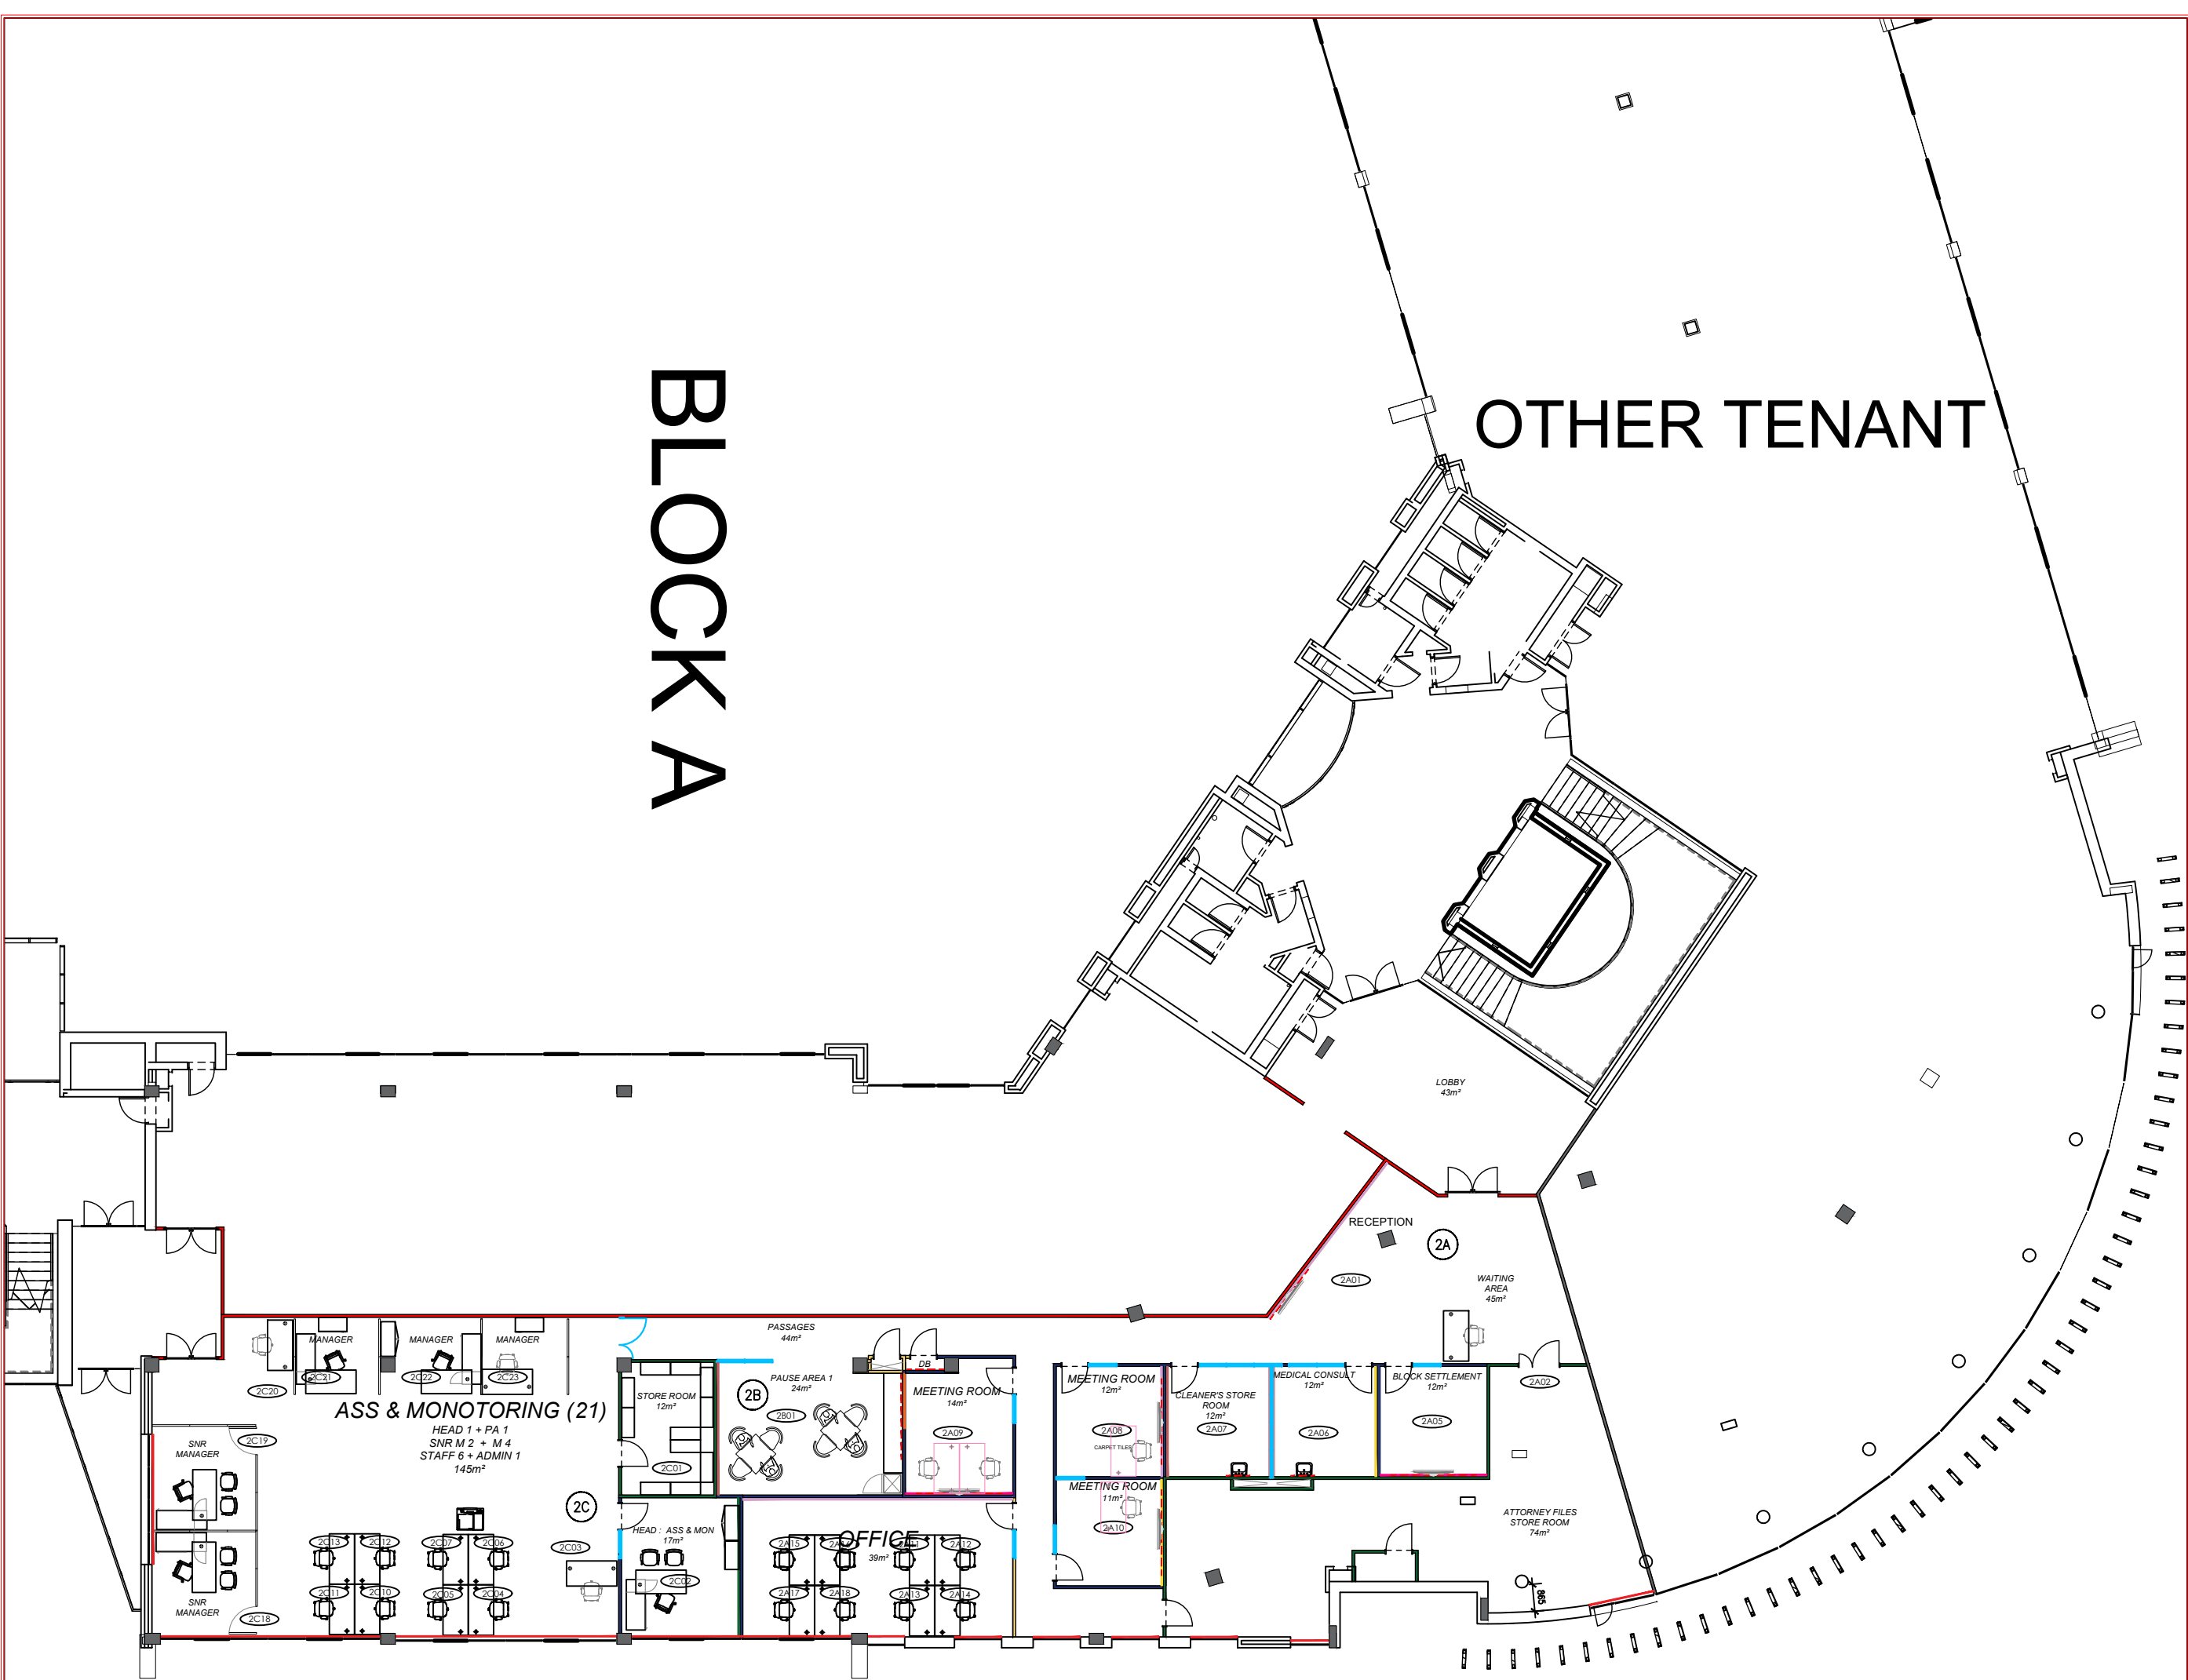

COPYRIGHT AND RIGHT OF REPRODUCTION OF THIS DRAWING OR ANY PORTION THEREOF IS RESERVED. CONTRACTOR TO VERIFY ALL LEVELS, HEIGHTS, AND DIMENSIONS ON SITE AND CHECK SAME AGAINST DRAWING BEFORE PUTTING ANY WORK IN HAND. ANY DISCREPANCIES TO BE REPORTED IMMEDIATELY TO THE ARCHITECT FOR CLARIFICATION. THIS DRAWING IS NOT TO BE SCALED - FIGURED DIMENSIONS TO BE USED AT ALL TIMES. ALL WORK TO BE CARRIED OUT IN STRICT ACCORDANCE WITH THE LOCAL AUTHORITIES' REQUIREMENTS, NATIONAL BUILDING REGULATIONS, AND THE RELEVANT S.A.B.S. STANDARDS. THIS DRAWING TO BE READ IN CONJUNCTION WITH OTHER CONSULTANTS DRAWINGS, DETAILS, AND ALL RELEVANT SPECIFICATIONS OR SCHEDULES AS MAY BE ISSUED.

REVISIONS		
REV.	DESCRIPTION	DATE


NOTES:



ROAD ACCIDENT FUND
FACILITIES MANAGEMENT
420 WHICH-HAZEL AVE
ECO GLADES 2 BLOCK F
CENTURION
www.raf.co.za

PRIVATE BAG X178
CENTURION
0046
SOUTH AFRICA
TELEPHONE : +27 12 621-1789
tertiakh@raf.co.za

PROJECT TITLE		
CENTURION ECO GLADES 1 BLOCK A FLOOR PLAN		
DRAWING TITLE		
SECOND FLOOR PARTITION LAYOUT FURNITURE LAYOUT ASSET LOCATIONS		
DATE	SCALE	DRAWN BY
18.09.2023	1:100	TKH
DRAWING NUMBER	SHEET NUMBER	REVISION
EGA 002 MAS	01	00

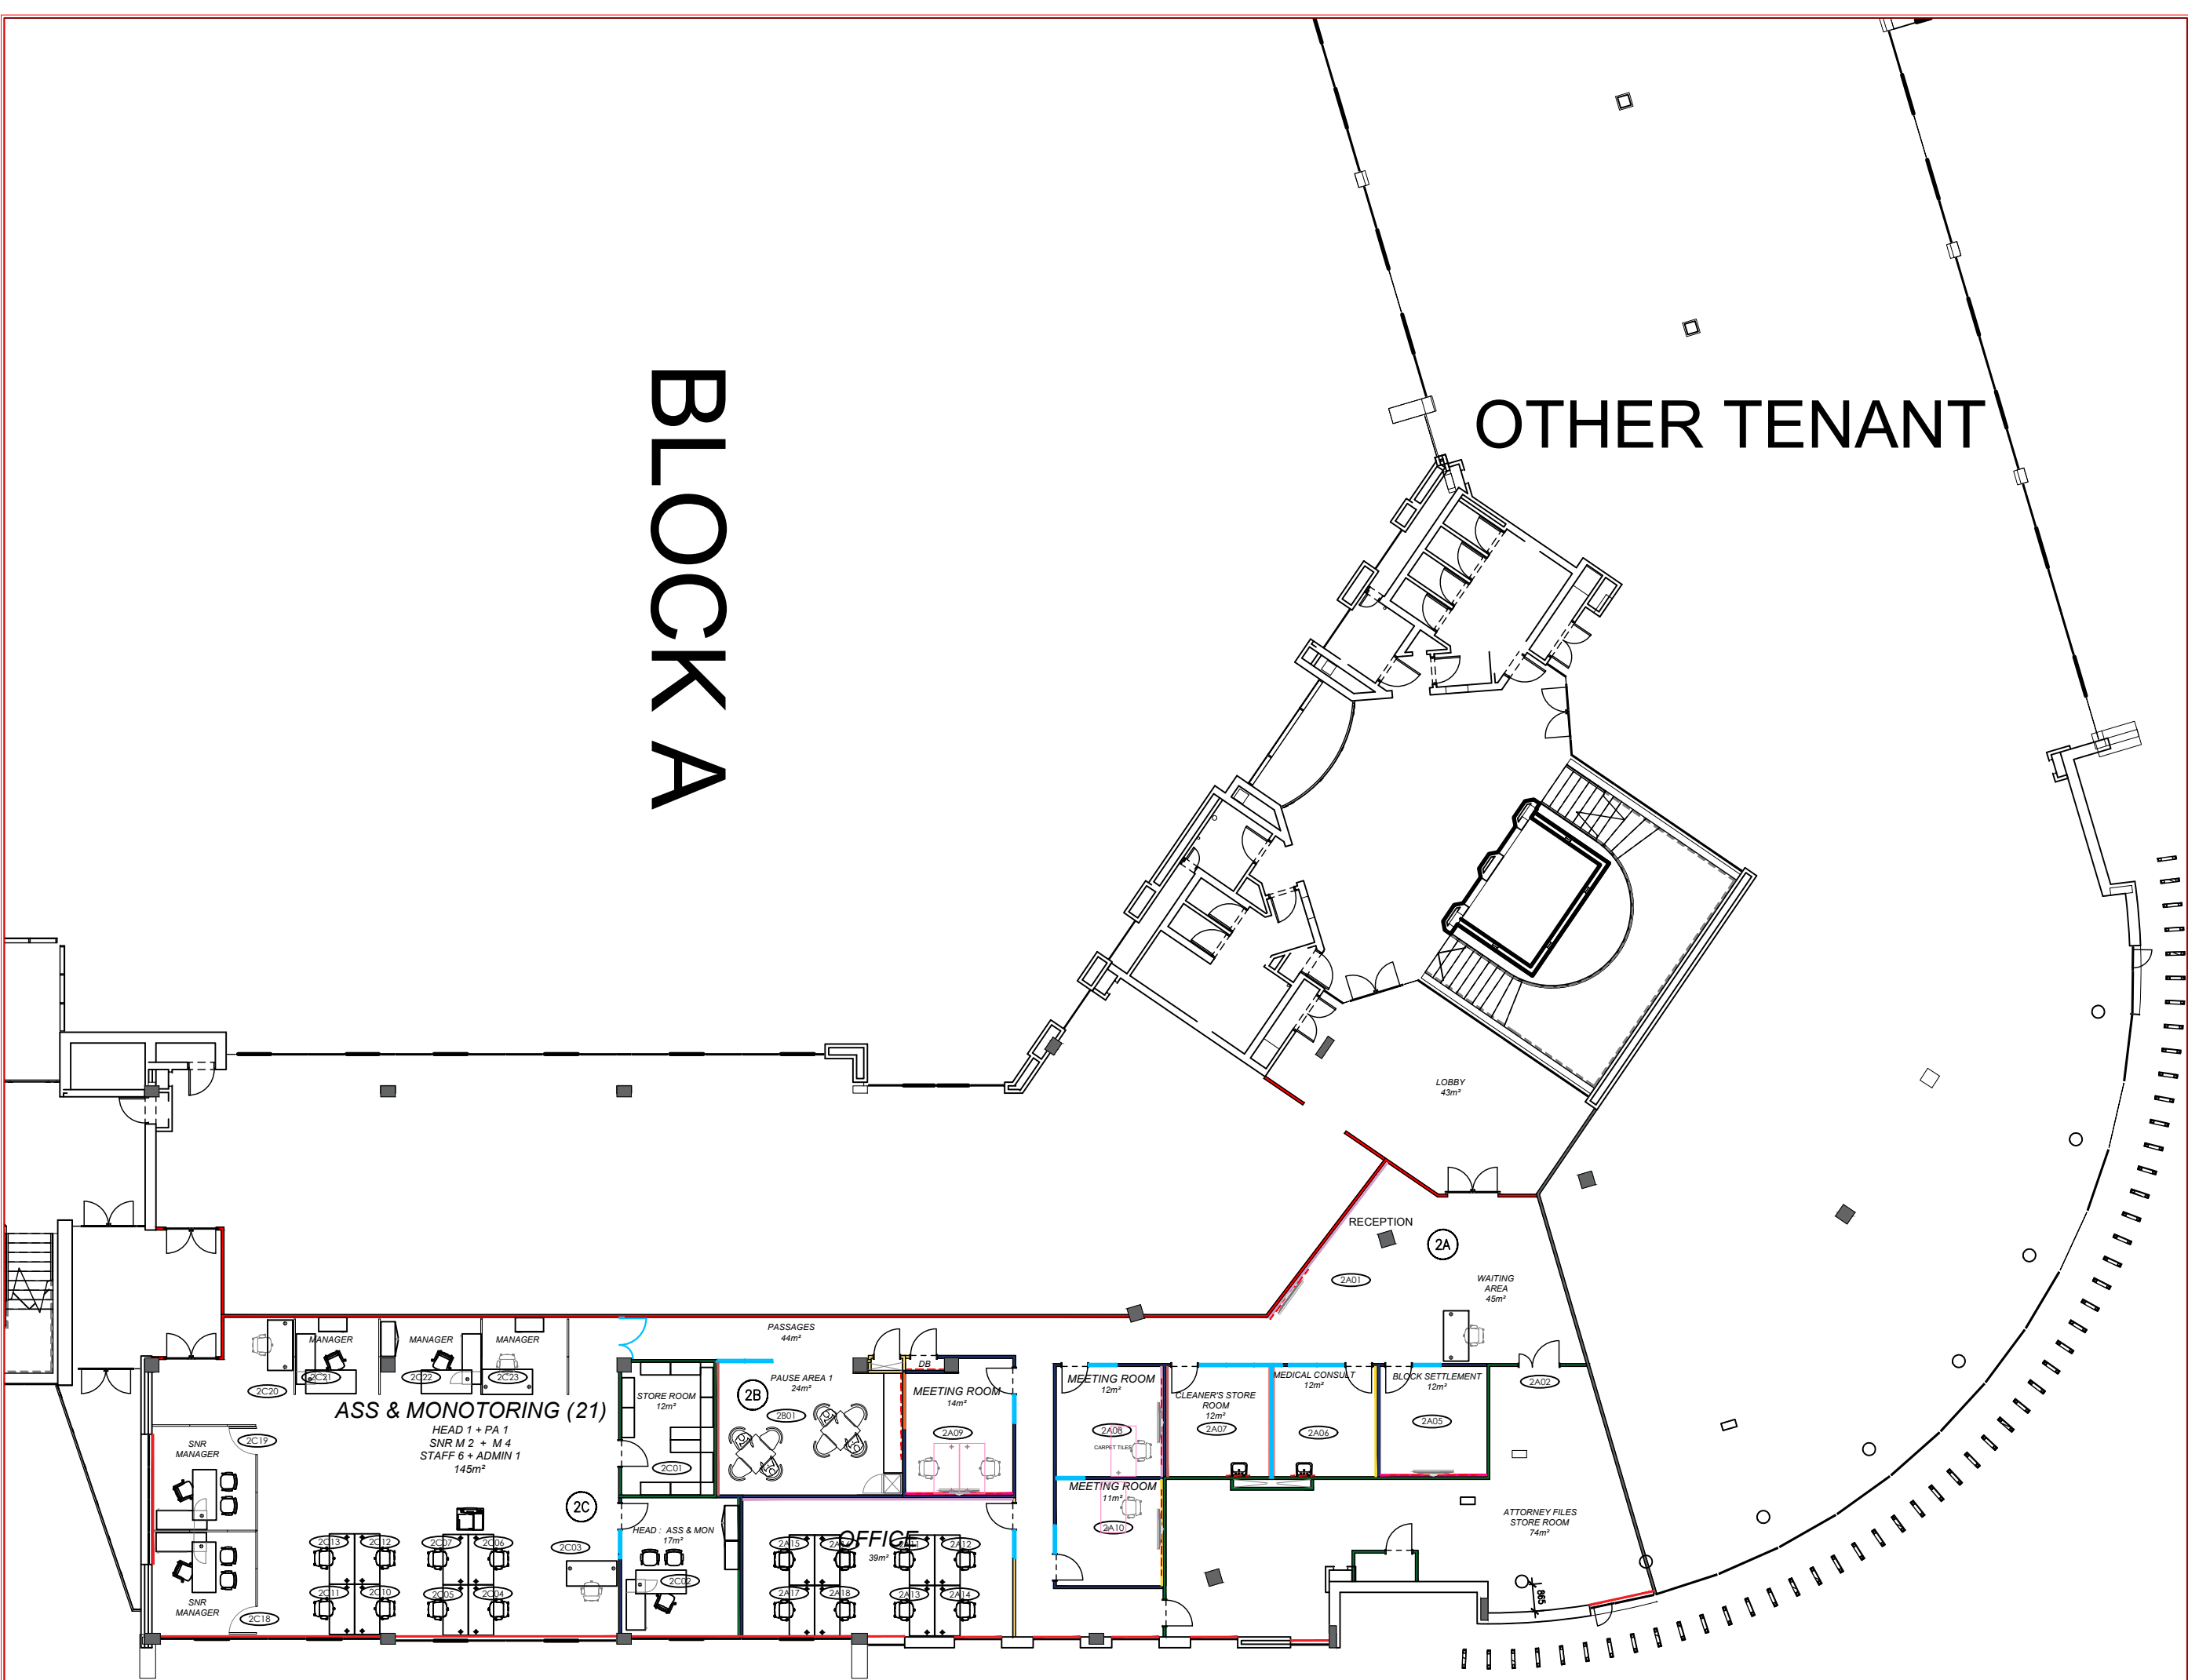

COPYRIGHT AND RIGHT OF REPRODUCTION OF THIS DRAWING OR ANY PORTION THEREOF IS RESERVED. CONTRACTOR TO VERIFY ALL LEVELS, HEIGHTS, AND DIMENSIONS ON SITE AND CHECK SAME AGAINST DRAWING BEFORE PUTTING ANY WORK IN HAND. ANY DISCREPANCIES TO BE REPORTED IMMEDIATELY TO THE ARCHITECT FOR CLARIFICATION. THIS DRAWING IS NOT TO BE SCALED - FIGURED DIMENSIONS TO BE USED AT ALL TIMES. ALL WORK TO BE CARRIED OUT IN STRICT ACCORDANCE WITH THE LOCAL AUTHORITIES' REQUIREMENTS, NATIONAL BUILDING REGULATIONS, AND THE RELEVANT S.A.B.S. STANDARDS. THIS DRAWING TO BE READ IN CONJUNCTION WITH OTHER CONSULTANTS DRAWINGS, DETAILS, AND ALL RELEVANT SPECIFICATIONS OR SCHEDULES AS MAY BE ISSUED.

REVISIONS		
REV.	DESCRIPTION	DATE

NOTES:



ROAD ACCIDENT FUND
FACILITIES MANAGEMENT
420 WHICH-HAZEL AVE
ECO GLADES 2 BLOCK F
CENTURION
www.raf.co.za

PRIVATE BAG X178
CENTURION
0046
SOUTH AFRICA
TELEPHONE : +27 12 621-1789
tertiakh@raf.co.za

PROJECT TITLE		
CENTURION ECO GLADES 1 BLOCK A FLOOR PLAN		
DRAWING TITLE		
SECOND FLOOR PARTITION LAYOUT FURNITURE LAYOUT ASSET LOCATIONS		
DATE	SCALE	DRAWN BY
18.09.2023	1:100	TKH
DRAWING NUMBER	SHEET NUMBER	REVISION
EGA 002 MAS	01	00