

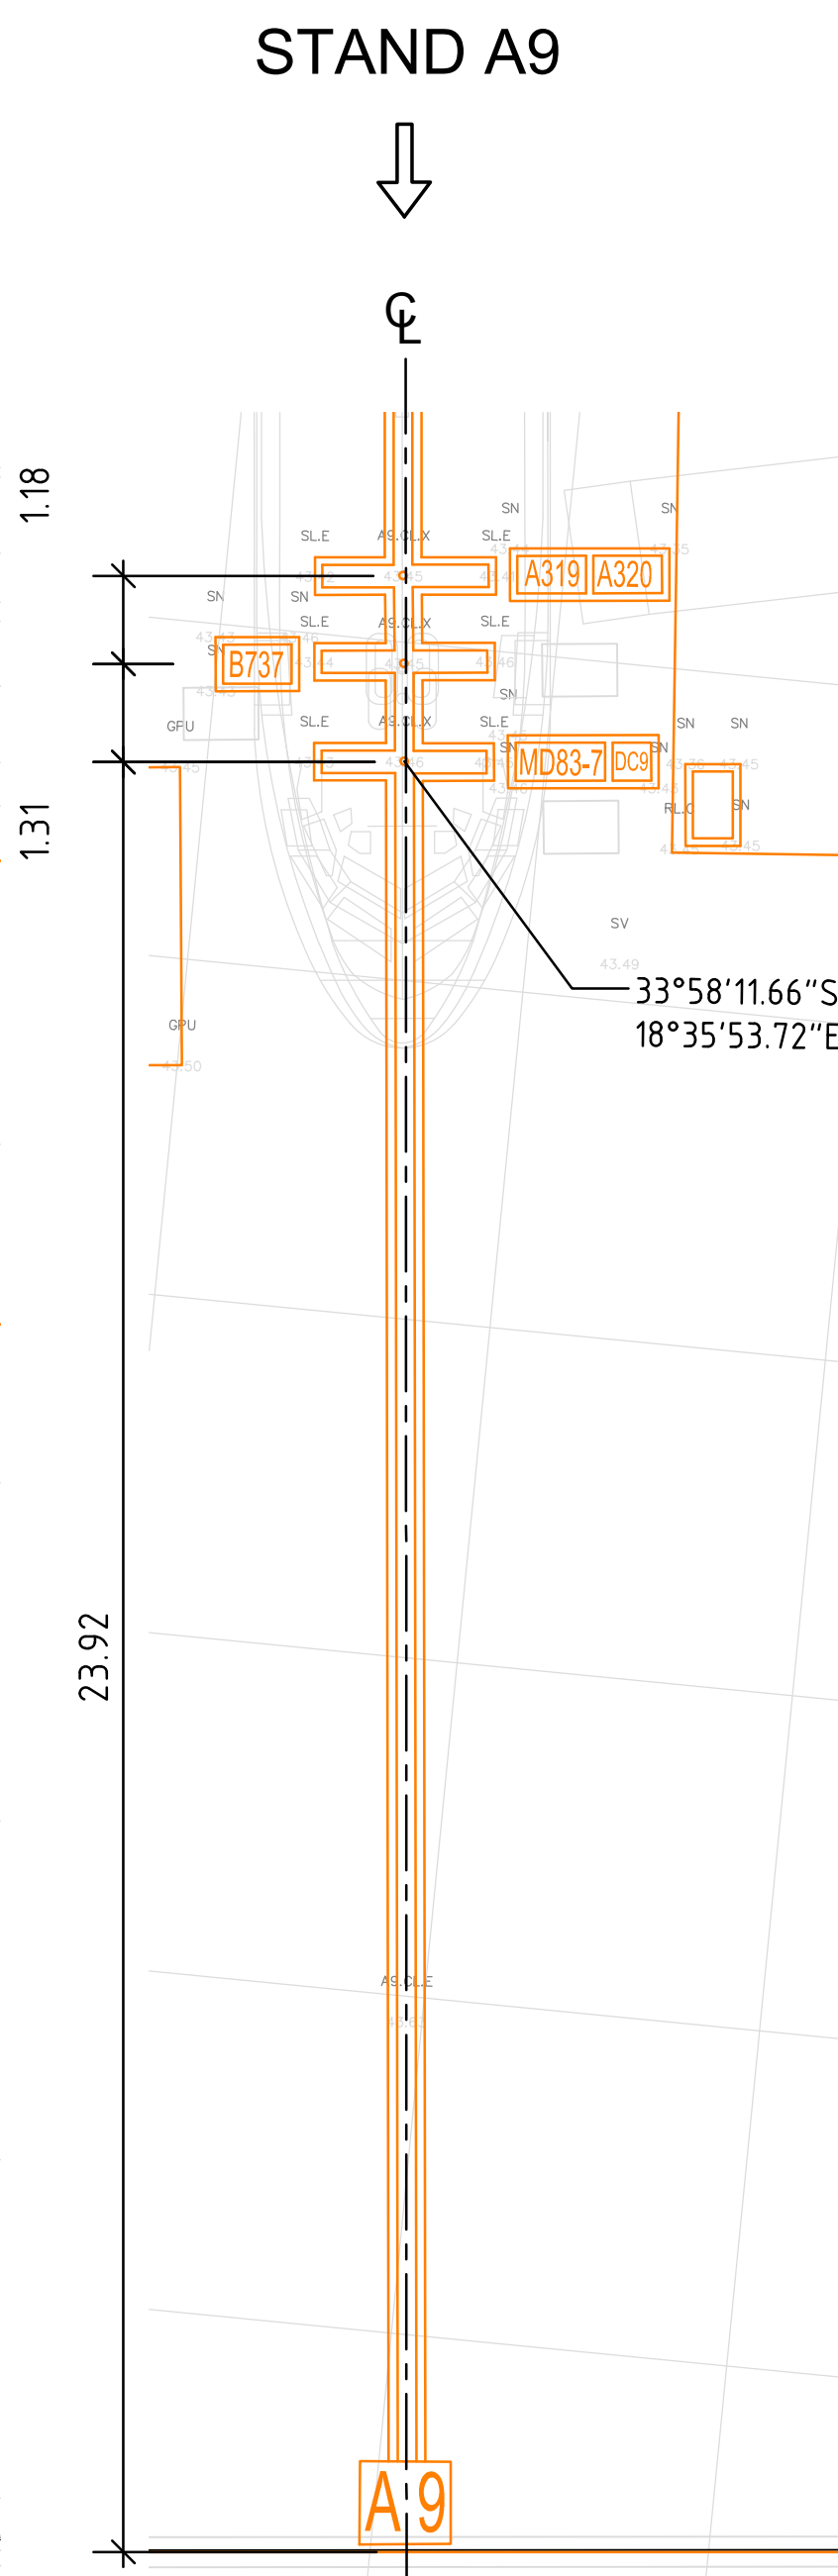
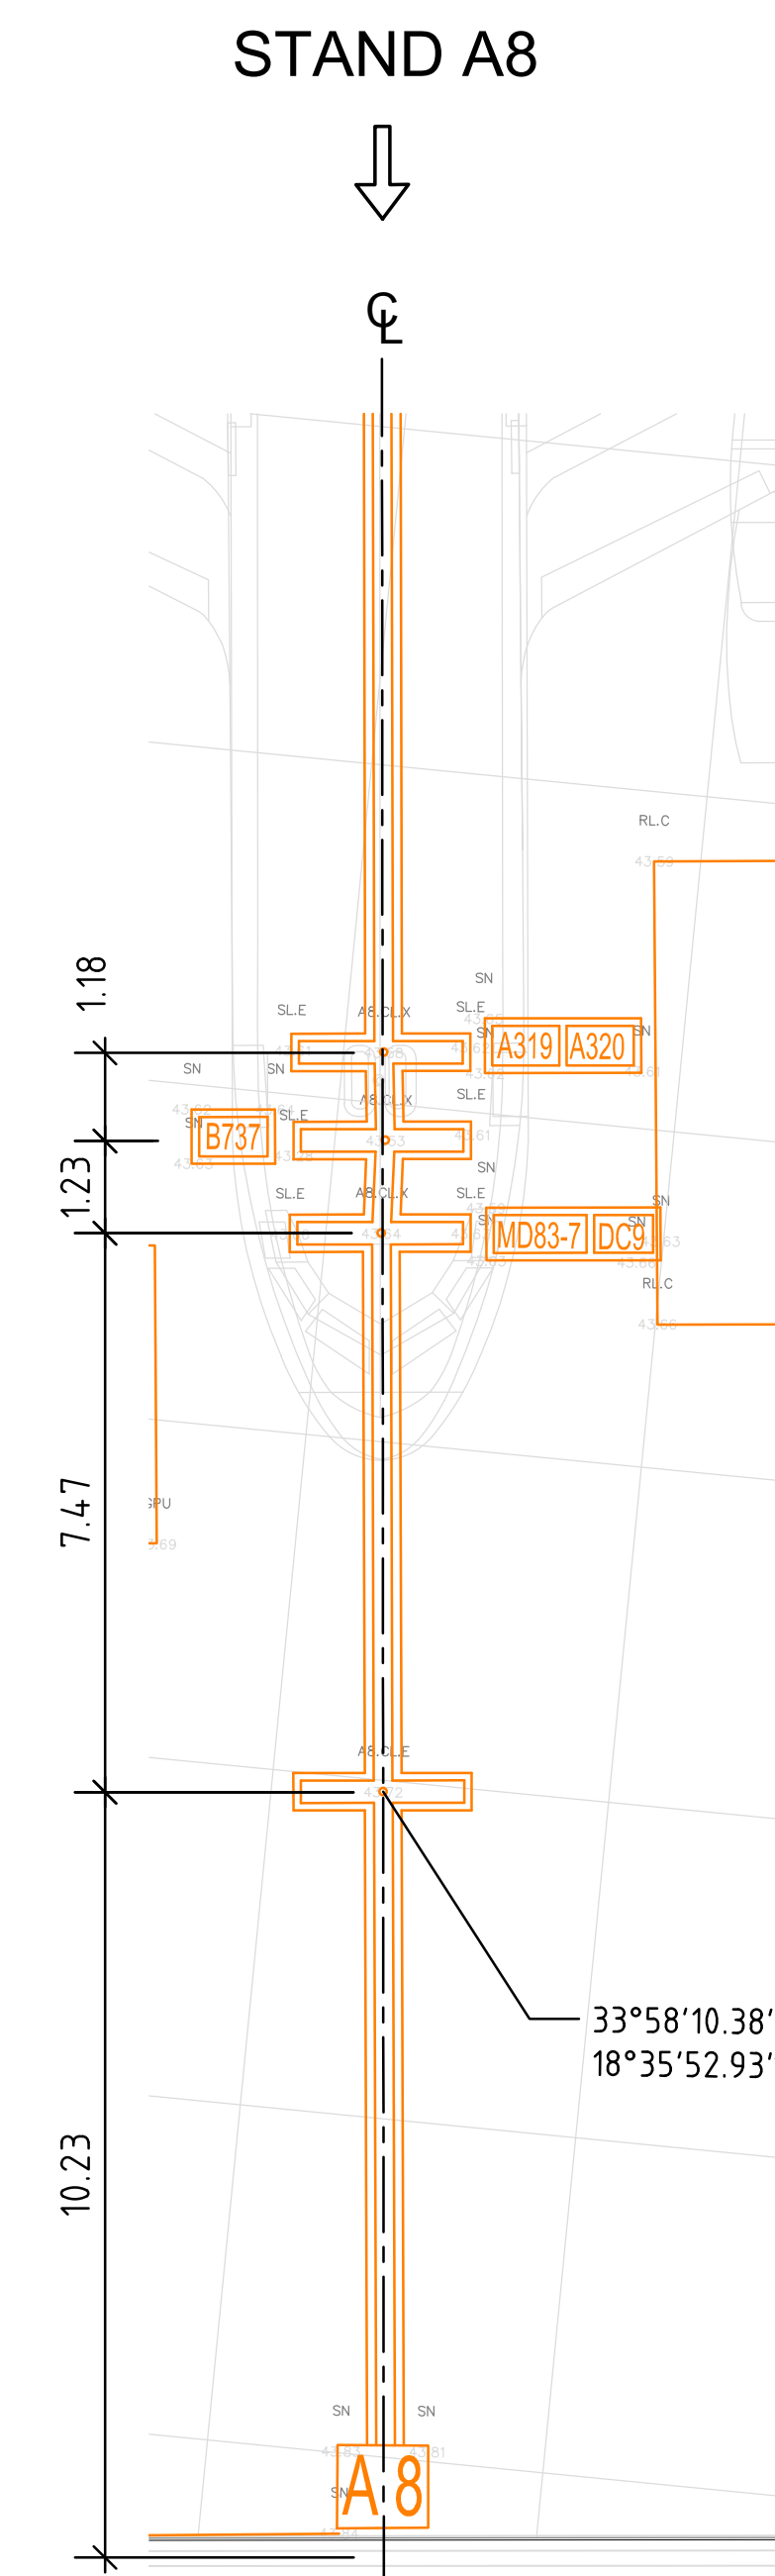
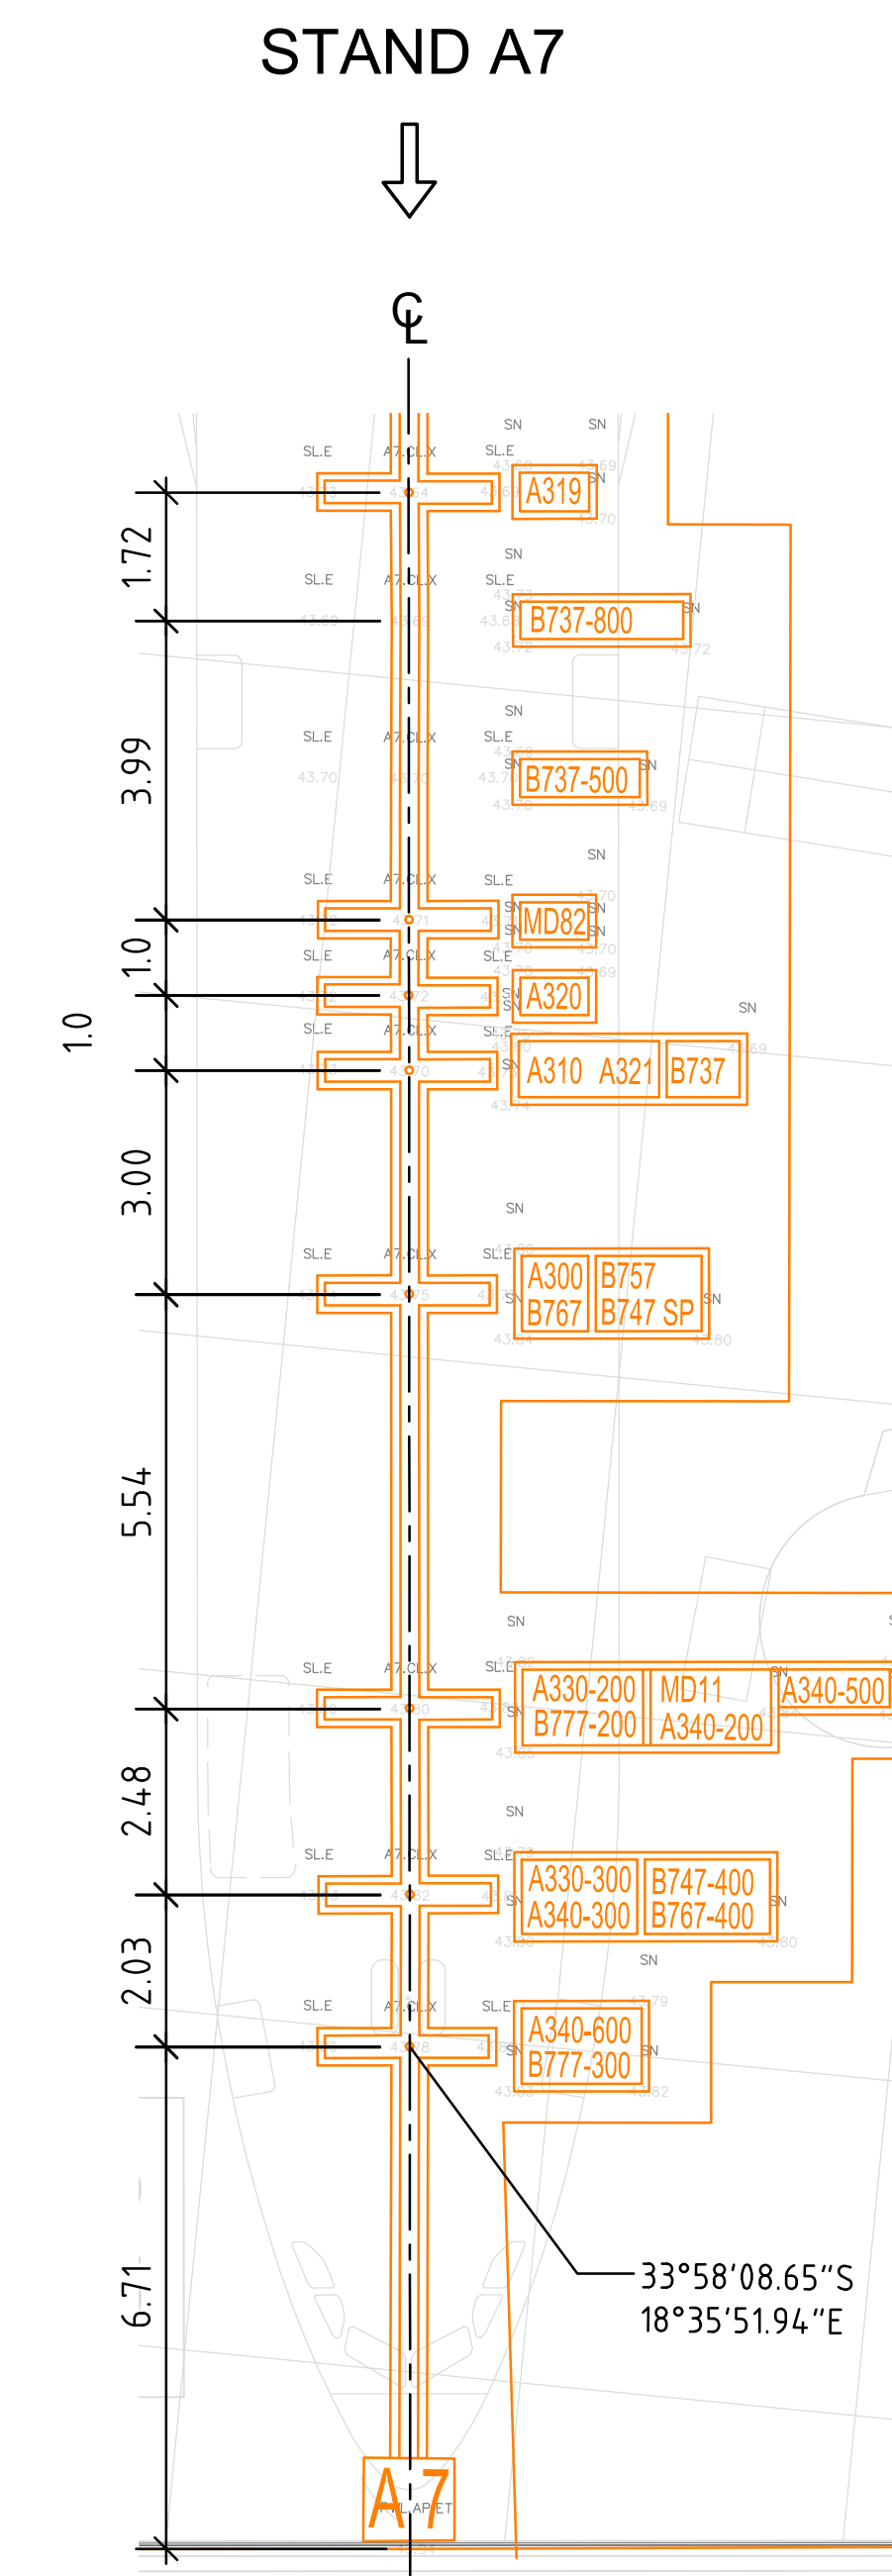
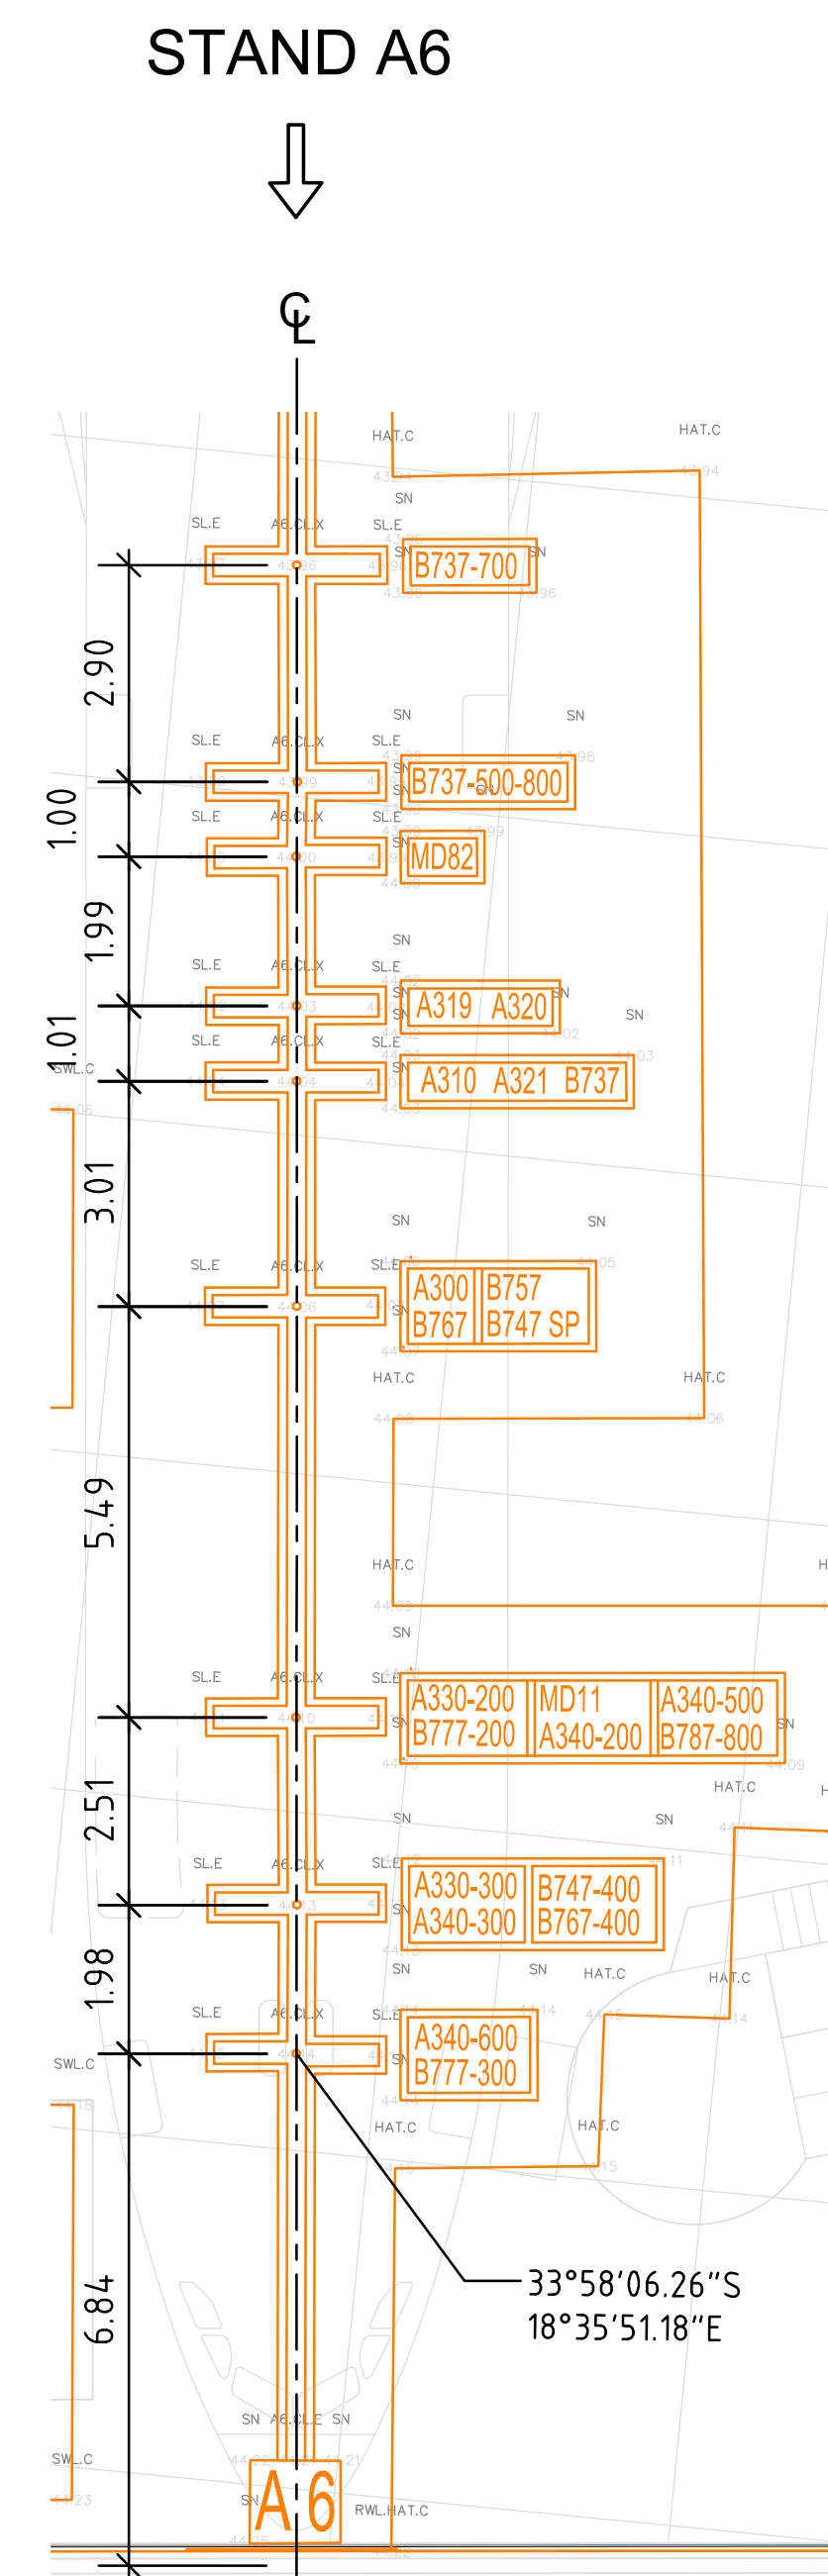
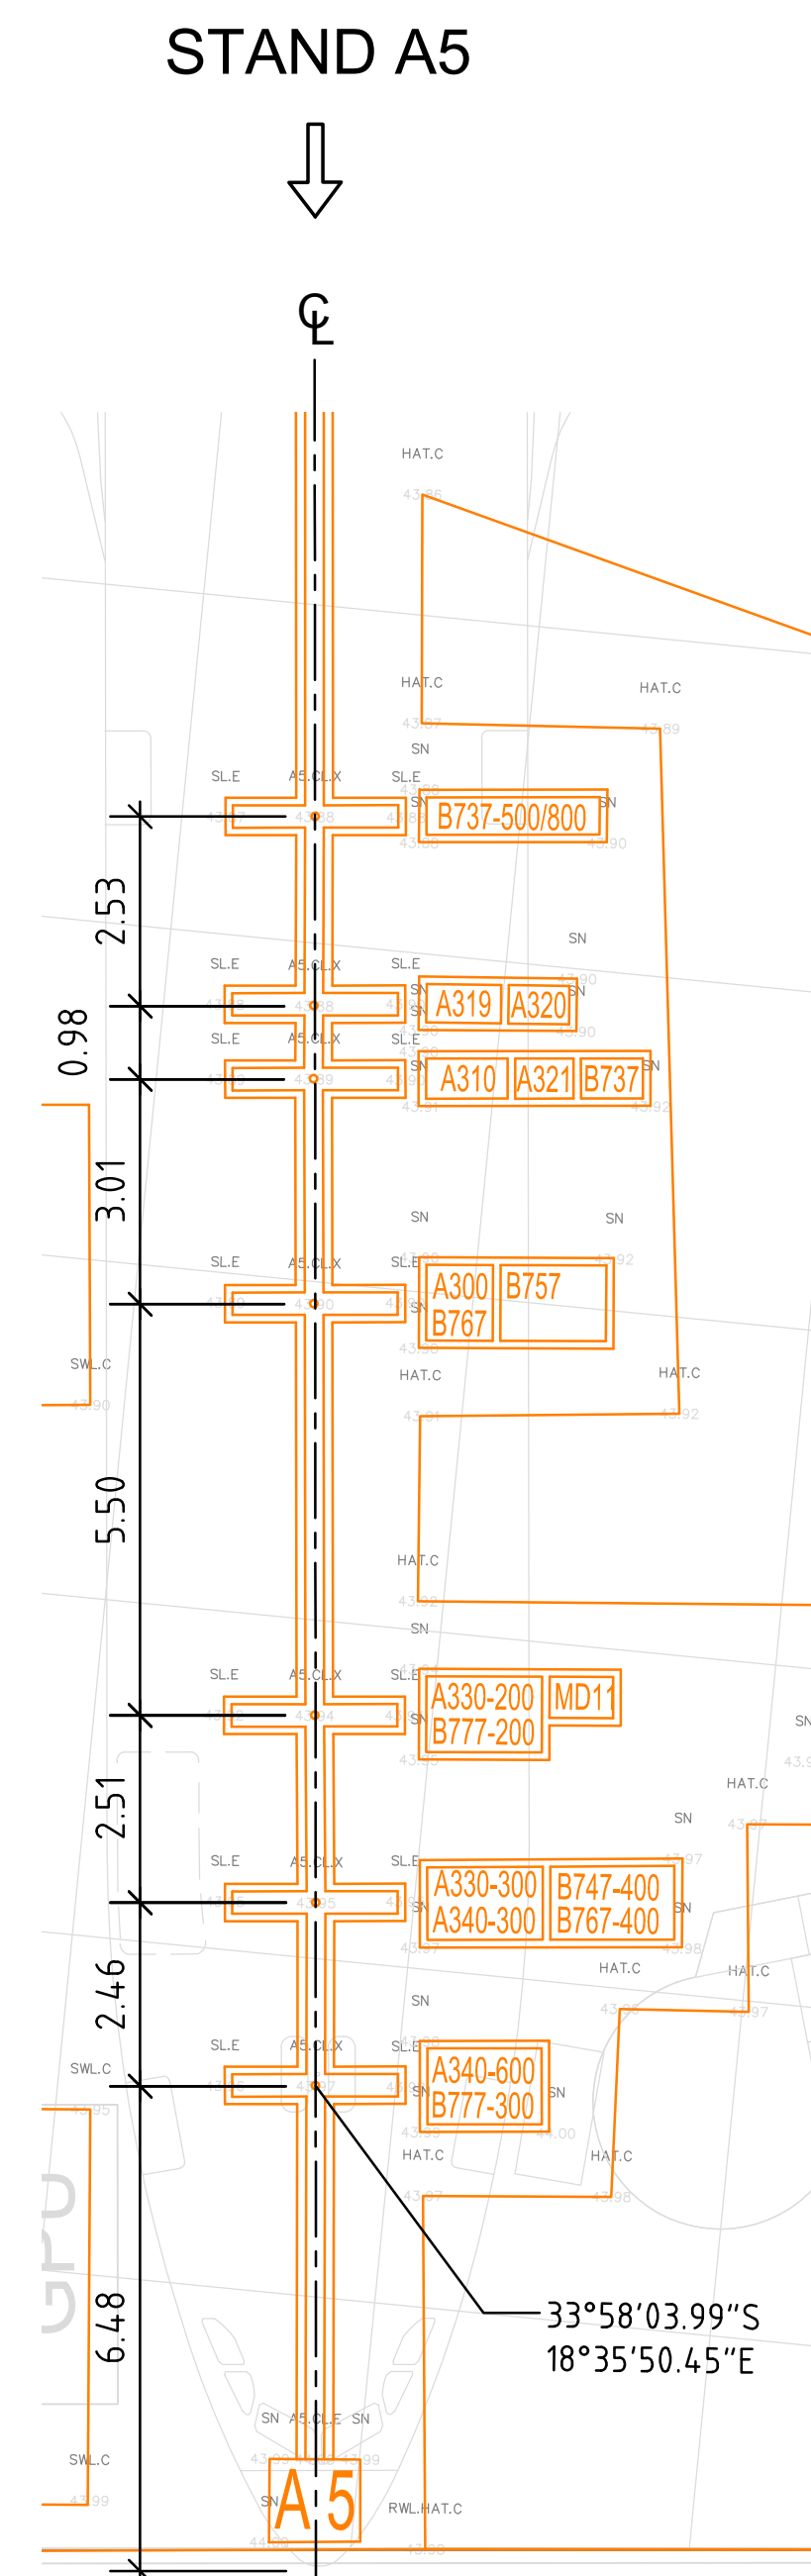
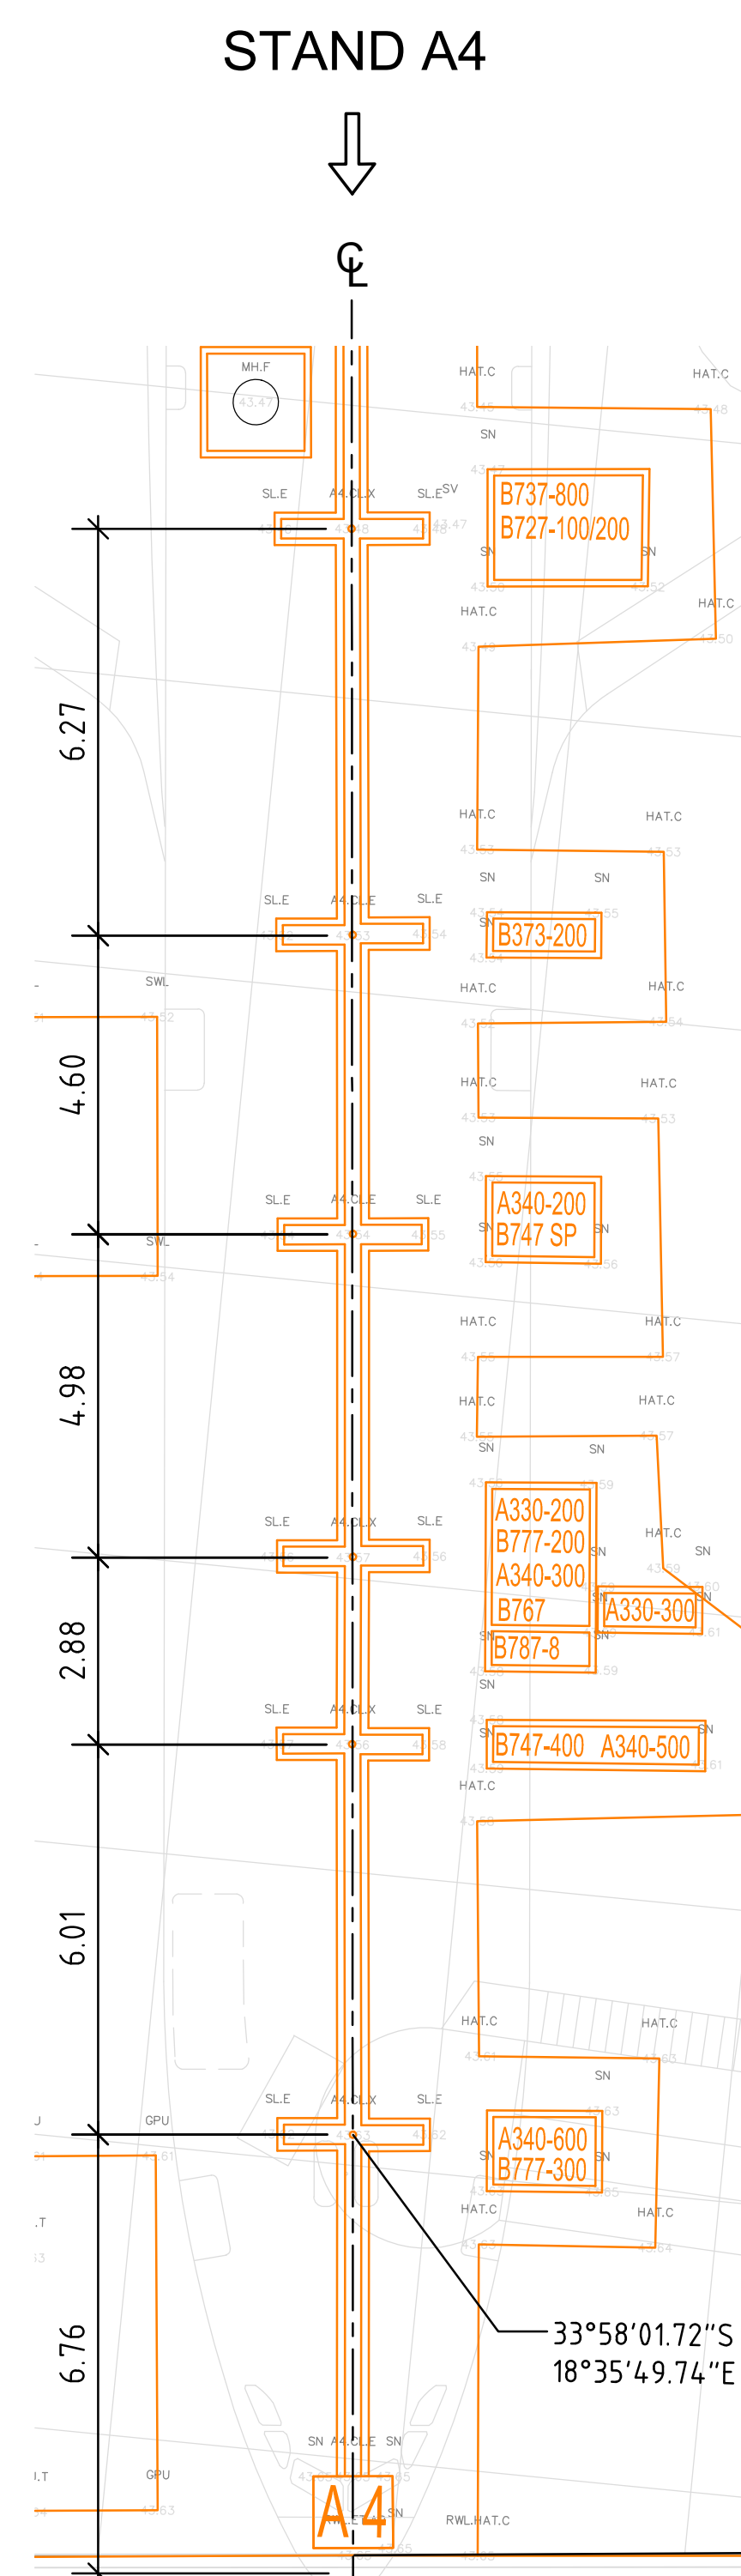


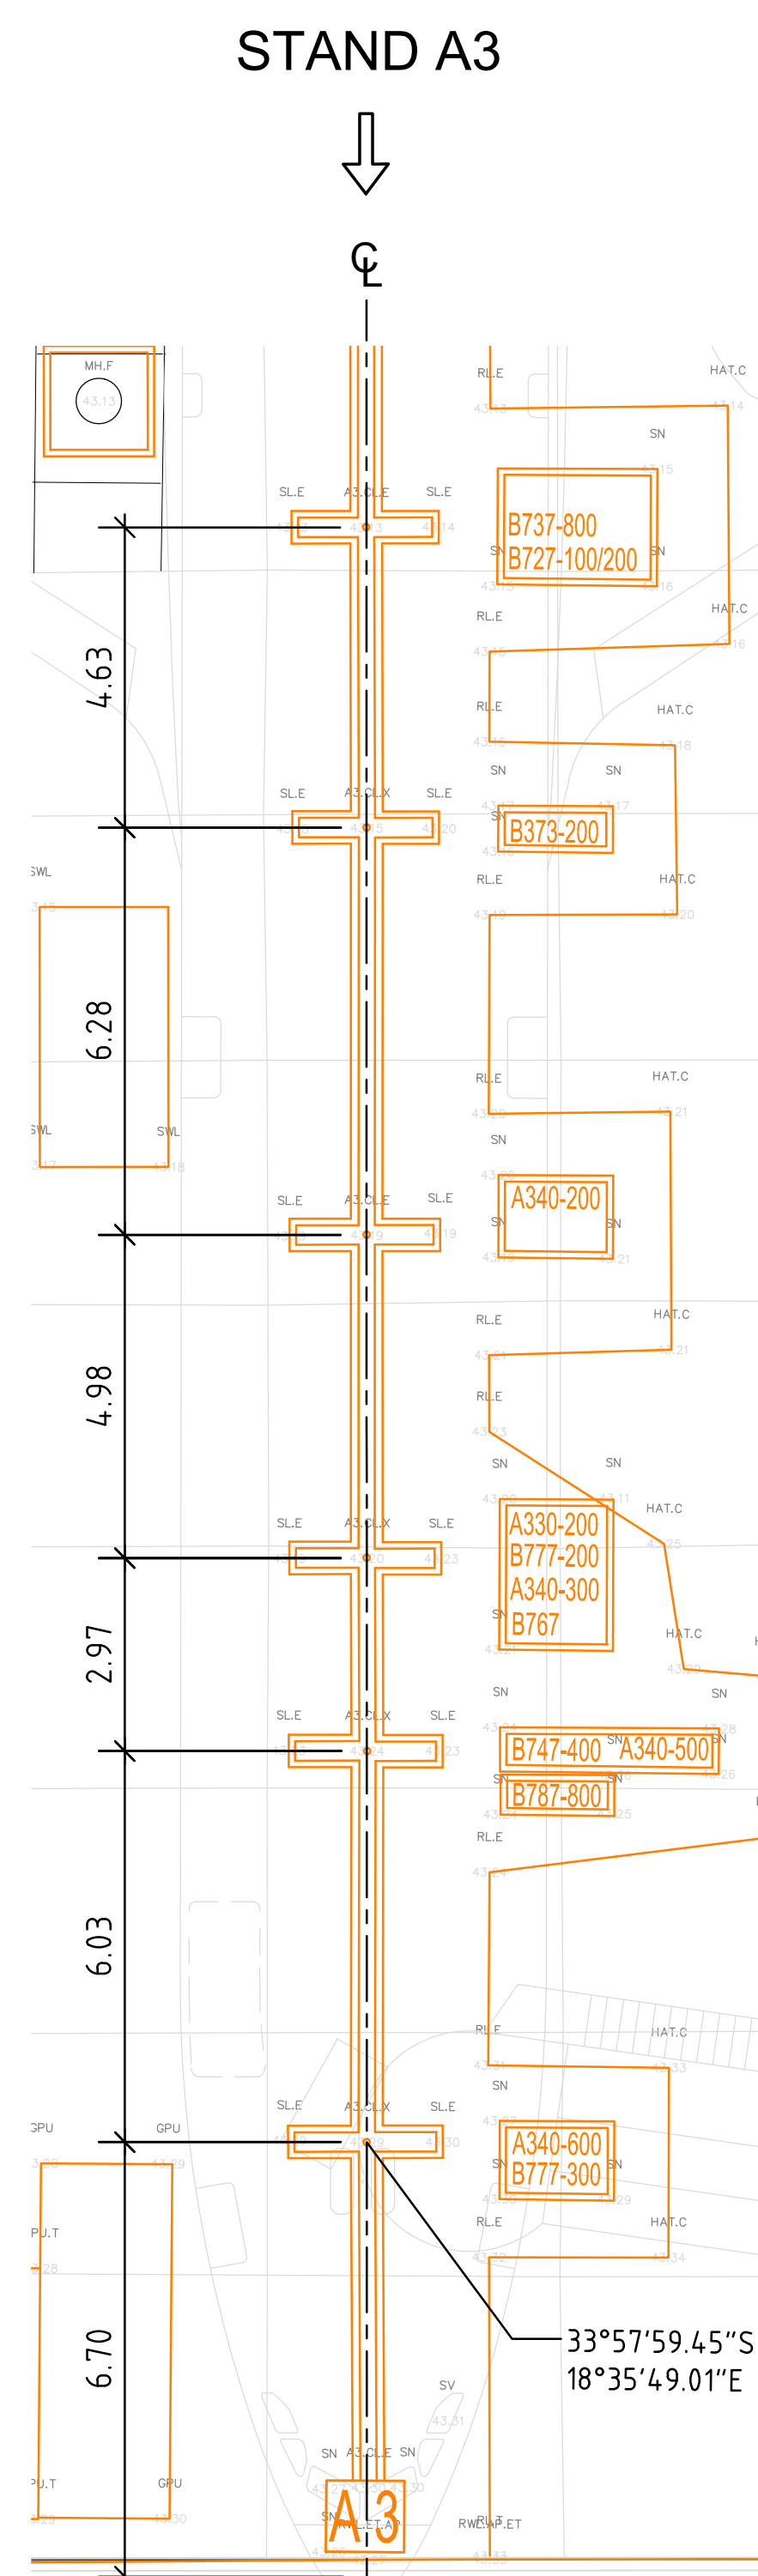

MULTIPLE MARSHALLER STOP LINE IDENTIFICATION
STANDS A3, A4, A5, A6, A7, A8 & A9
1:100

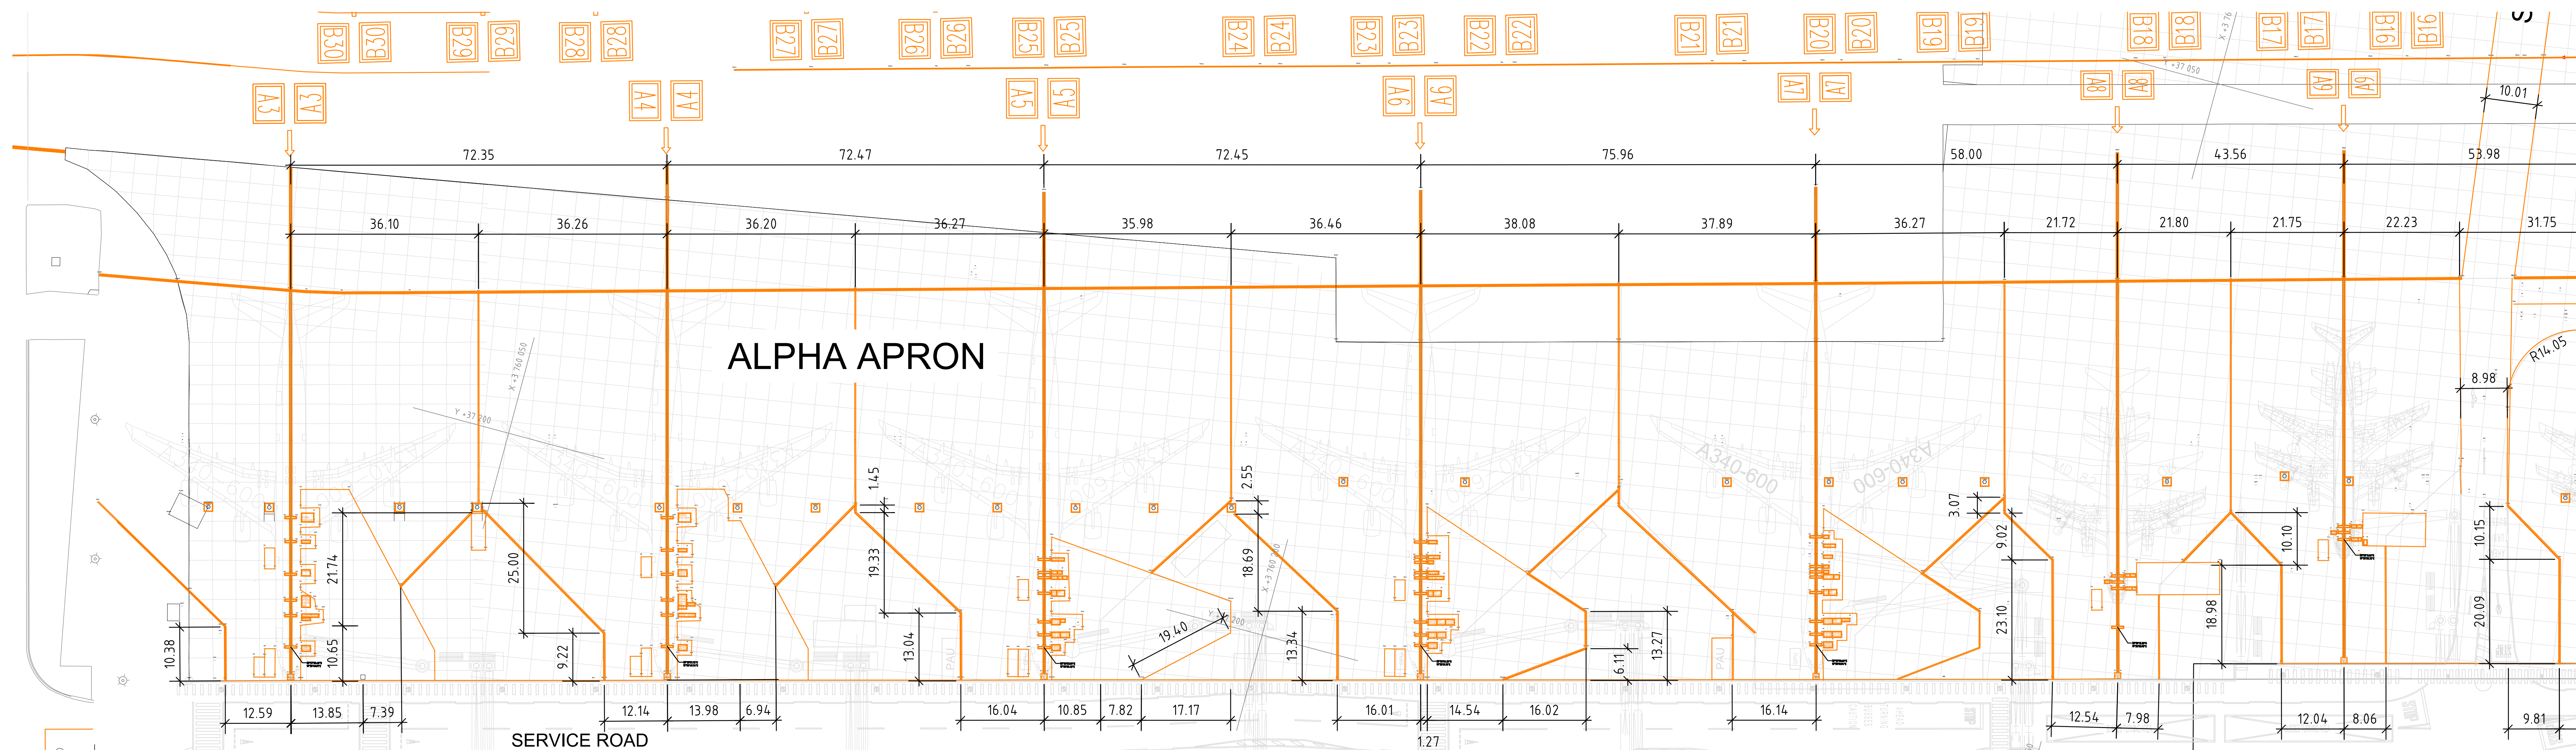

ALPHA APRON LAYOUT PLAN
STANDS A3, A4, A5, A6, A7, A8 & A9
1:500

NOTES

CO-ORDINATE LIST

CO-ORDINATE SYSTEM : WGS 84

NOTES

THE SURVEY INCLUDES ONLY VISIBLE SERVICES AND THEREFORE SHOULD BE CHECKED AGAINST LOCAL AIRPORT PUBLISHED PLANS.

THE POSITION OF PHYSICAL MARKERS MUST BE CORRELATED WITH THE MARKING DATA AS PROVIDED BY THE SURVEYOR'S OFFICE.

ALL SURVEY HEIGHTS AND POSITIONS ARE GIVEN IN METRIC UNITS.

ALL SURVEY POINTS SHOULD BE RECHECKED TO ENSURE ACCURACY.

THIS PLAN WAS COMPILED USING INFORMATION AND DATA FROM THE SURVEY ON THIS PLAN IS ALSO AVAILABLE IN PDF, DWG AND DGN FORMATS.

PRELIMINARY PLAN
SUBJECT TO FIELD CHECK

AMENDMENTS

NO.	DATE	DESCRIPTION
01	DEC 2015	REVISION NORTH & SOUTH BAY NUMBERS ADDED
02	NOV 2015	RECORD DRAWING
03	AUG 2015	PRELIMINARY LAYOUT FOR REVIEW

DESIGNED	DRAWN	CHECKED
J.P.	Z.R.	G.W.B.

CAPE TOWN INTERNATIONAL AIRPORT
AIRPORTS COMPANY SOUTH AFRICA

ACSA CAPE TOWN AIRPORT BASEPLAN
EXISTING APRON AND AIRCRAFT STANDS MARKINGS

ALPHA APRON A3 - A9 SHEET 4 OF 8

SATMAP SOLUTIONS cc
IN ASSOCIATION WITH
ROBIN PHARAOH & ASSOCIATES

57 BELPER ROAD WYNBERG 7808
P.O. BOX 2482 CLARENCH 7740
PHONE : 021 787 2225 FAX : 021 787 2083
E-MAIL : info@satmap.co.za

REGISTERED SURVEYORS & SURVEY TECHNICIANS

KFD WILKINSON CONSULTING ENGINEERS
12th FLOOR PICNIC PARK ROAD STAND STREET CAPE TOWN 8001
TEL (021) 425 1610 FAX (021) 425 1641 EMAIL: info@kfd.co.za

SCALE	DWG. NO.	REV
AS SHOWN	583/2_05	3