




LAYOUT PLAN
SCALE 1:500

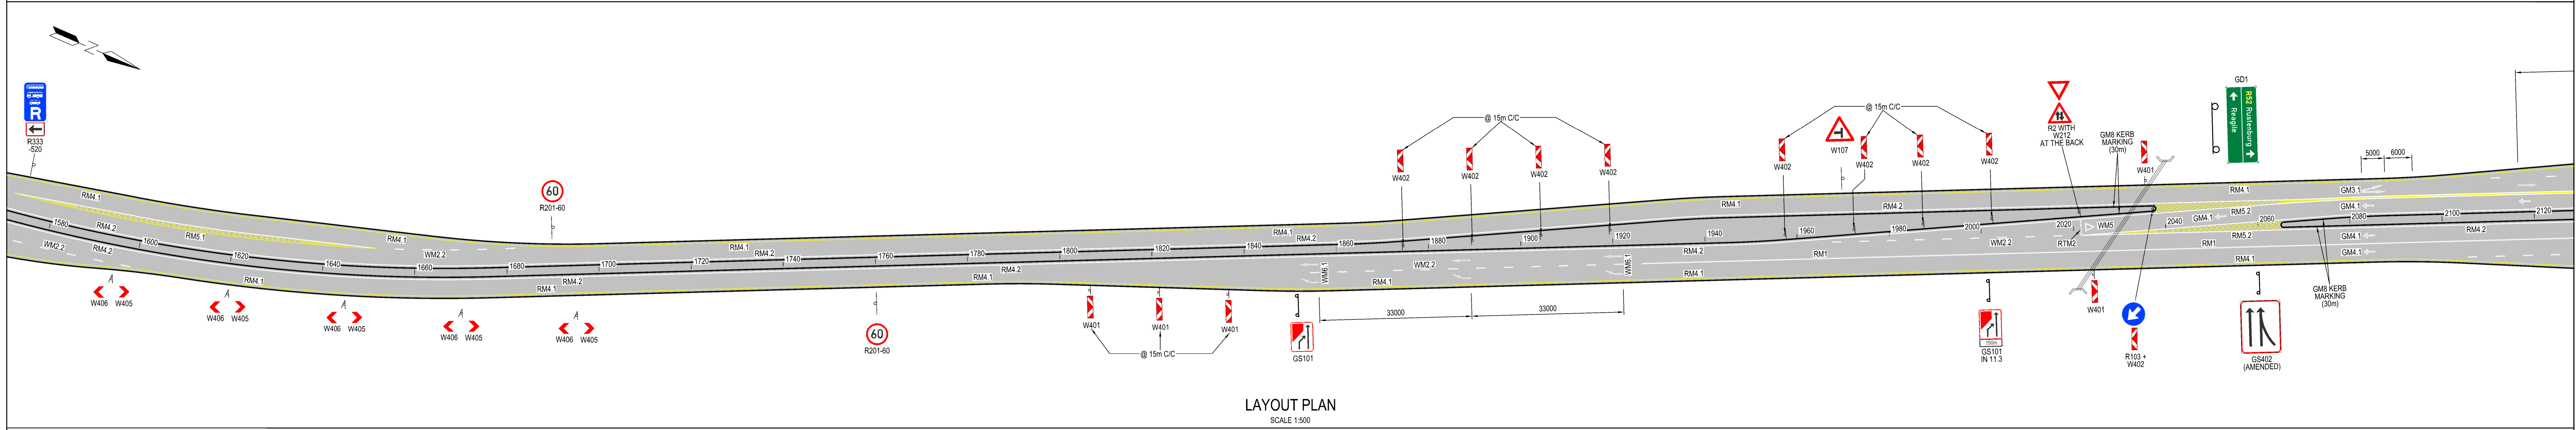

LAYOUT PLAN
SCALE 1:500

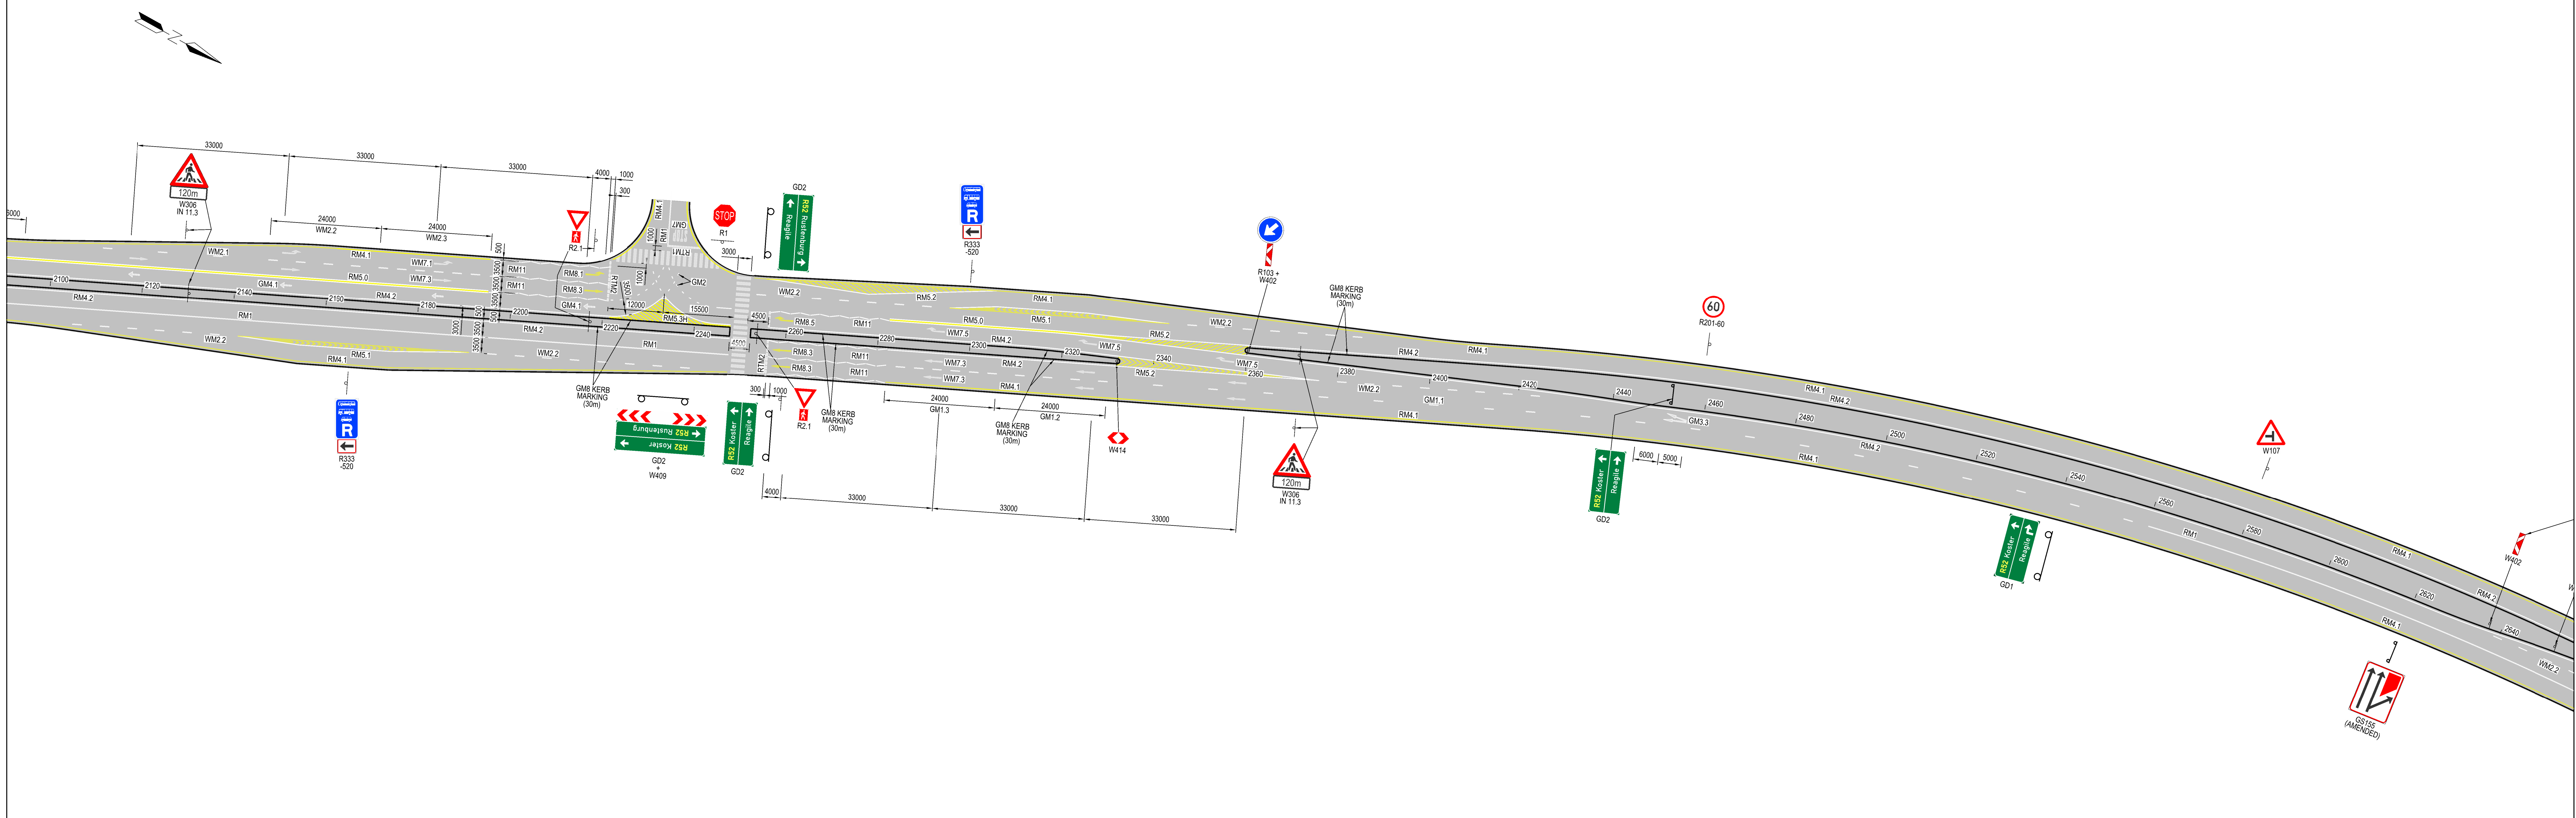

LAYOUT PLAN
SCALE 1:500

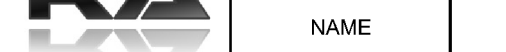			CONSTRUCTION RECORD (AS-BUILT)		 35A Piet Retief Street PO Box 802 Harrismith 9880 Tel: (058) 622 1297 Fax: 058 623 0827 E-mail: harrismith@ilifa.biz	 103 Maranata Ave Mosel Bay 6500 South Africa +27 44 690 4417 Moselbaai@Quantra.co.za	DESIGNED BY		CONSULTANT APPROVAL  Name : J.J. OLIVIER Prof. Reg. No. : 940253 Date : JUNE 2021	HEAD OFFICE 48 Tambotie Avenue Val de Grace Pretoria 0184 PO Box 415 Pretoria 0001 South Africa Tel: (012) 844 8000  BUILDING SOUTH AFRICA THROUGH BETTER ROADS NORTHERN REGION 38 Ida Street Menlo Park Pretoria 0081 Private Bag X17 Lynnwood Ridge 0040 Tel: (012) 426 6200	ACCEPTANCE THIS ACCEPTANCE IS FOR PROCEDURAL AND ADMINISTRATIVE REVIEW PURPOSES ONLY AND DOES NOT ATTRACT LEGAL LIABILITY OR LIABILITY OF ANY KIND FROM WHATSOEVER CAUSE OR HOWEVER ARISING for the SA NATIONAL ROADS AGENCY SOC LTD. Date:	PROJECT DESCRIPTION		PROJECT NUMBER		PLAN No. H17- 028-00-RR-RM02
			WORKS CONTRACT ENGINEER				R.052-030-2020/1									
			SANRAL PROJECT MANAGER				DRAWING LOCATION DATA									
			Name : J.J. OLIVIER Date : JUNE 2021				ROUTE SECTION DRAWING km DISTANCE DRAWING TYPE BRIDGE/STRUCTURE No. CONSULTANT DRAWING No. SANRAL DOCUMENT #		START R 052 03N 1140 ROADS - ANCILLARY WORKS H17- 028-00-RR-RM02 VER V1							
V1 June 2021 ORIGINAL VERSION			J.J. OLIVIER CONSULT. ENG.				DRAWING DESCRIPTION		R.052-030-2020/1							
No. DATE REVISION							ROAD MARKINGS AND ROAD SIGNS LAYOUT PLAN		END R 052 03N 2640							
							SCALE : 1:500		SHEET 02 OF 20							