


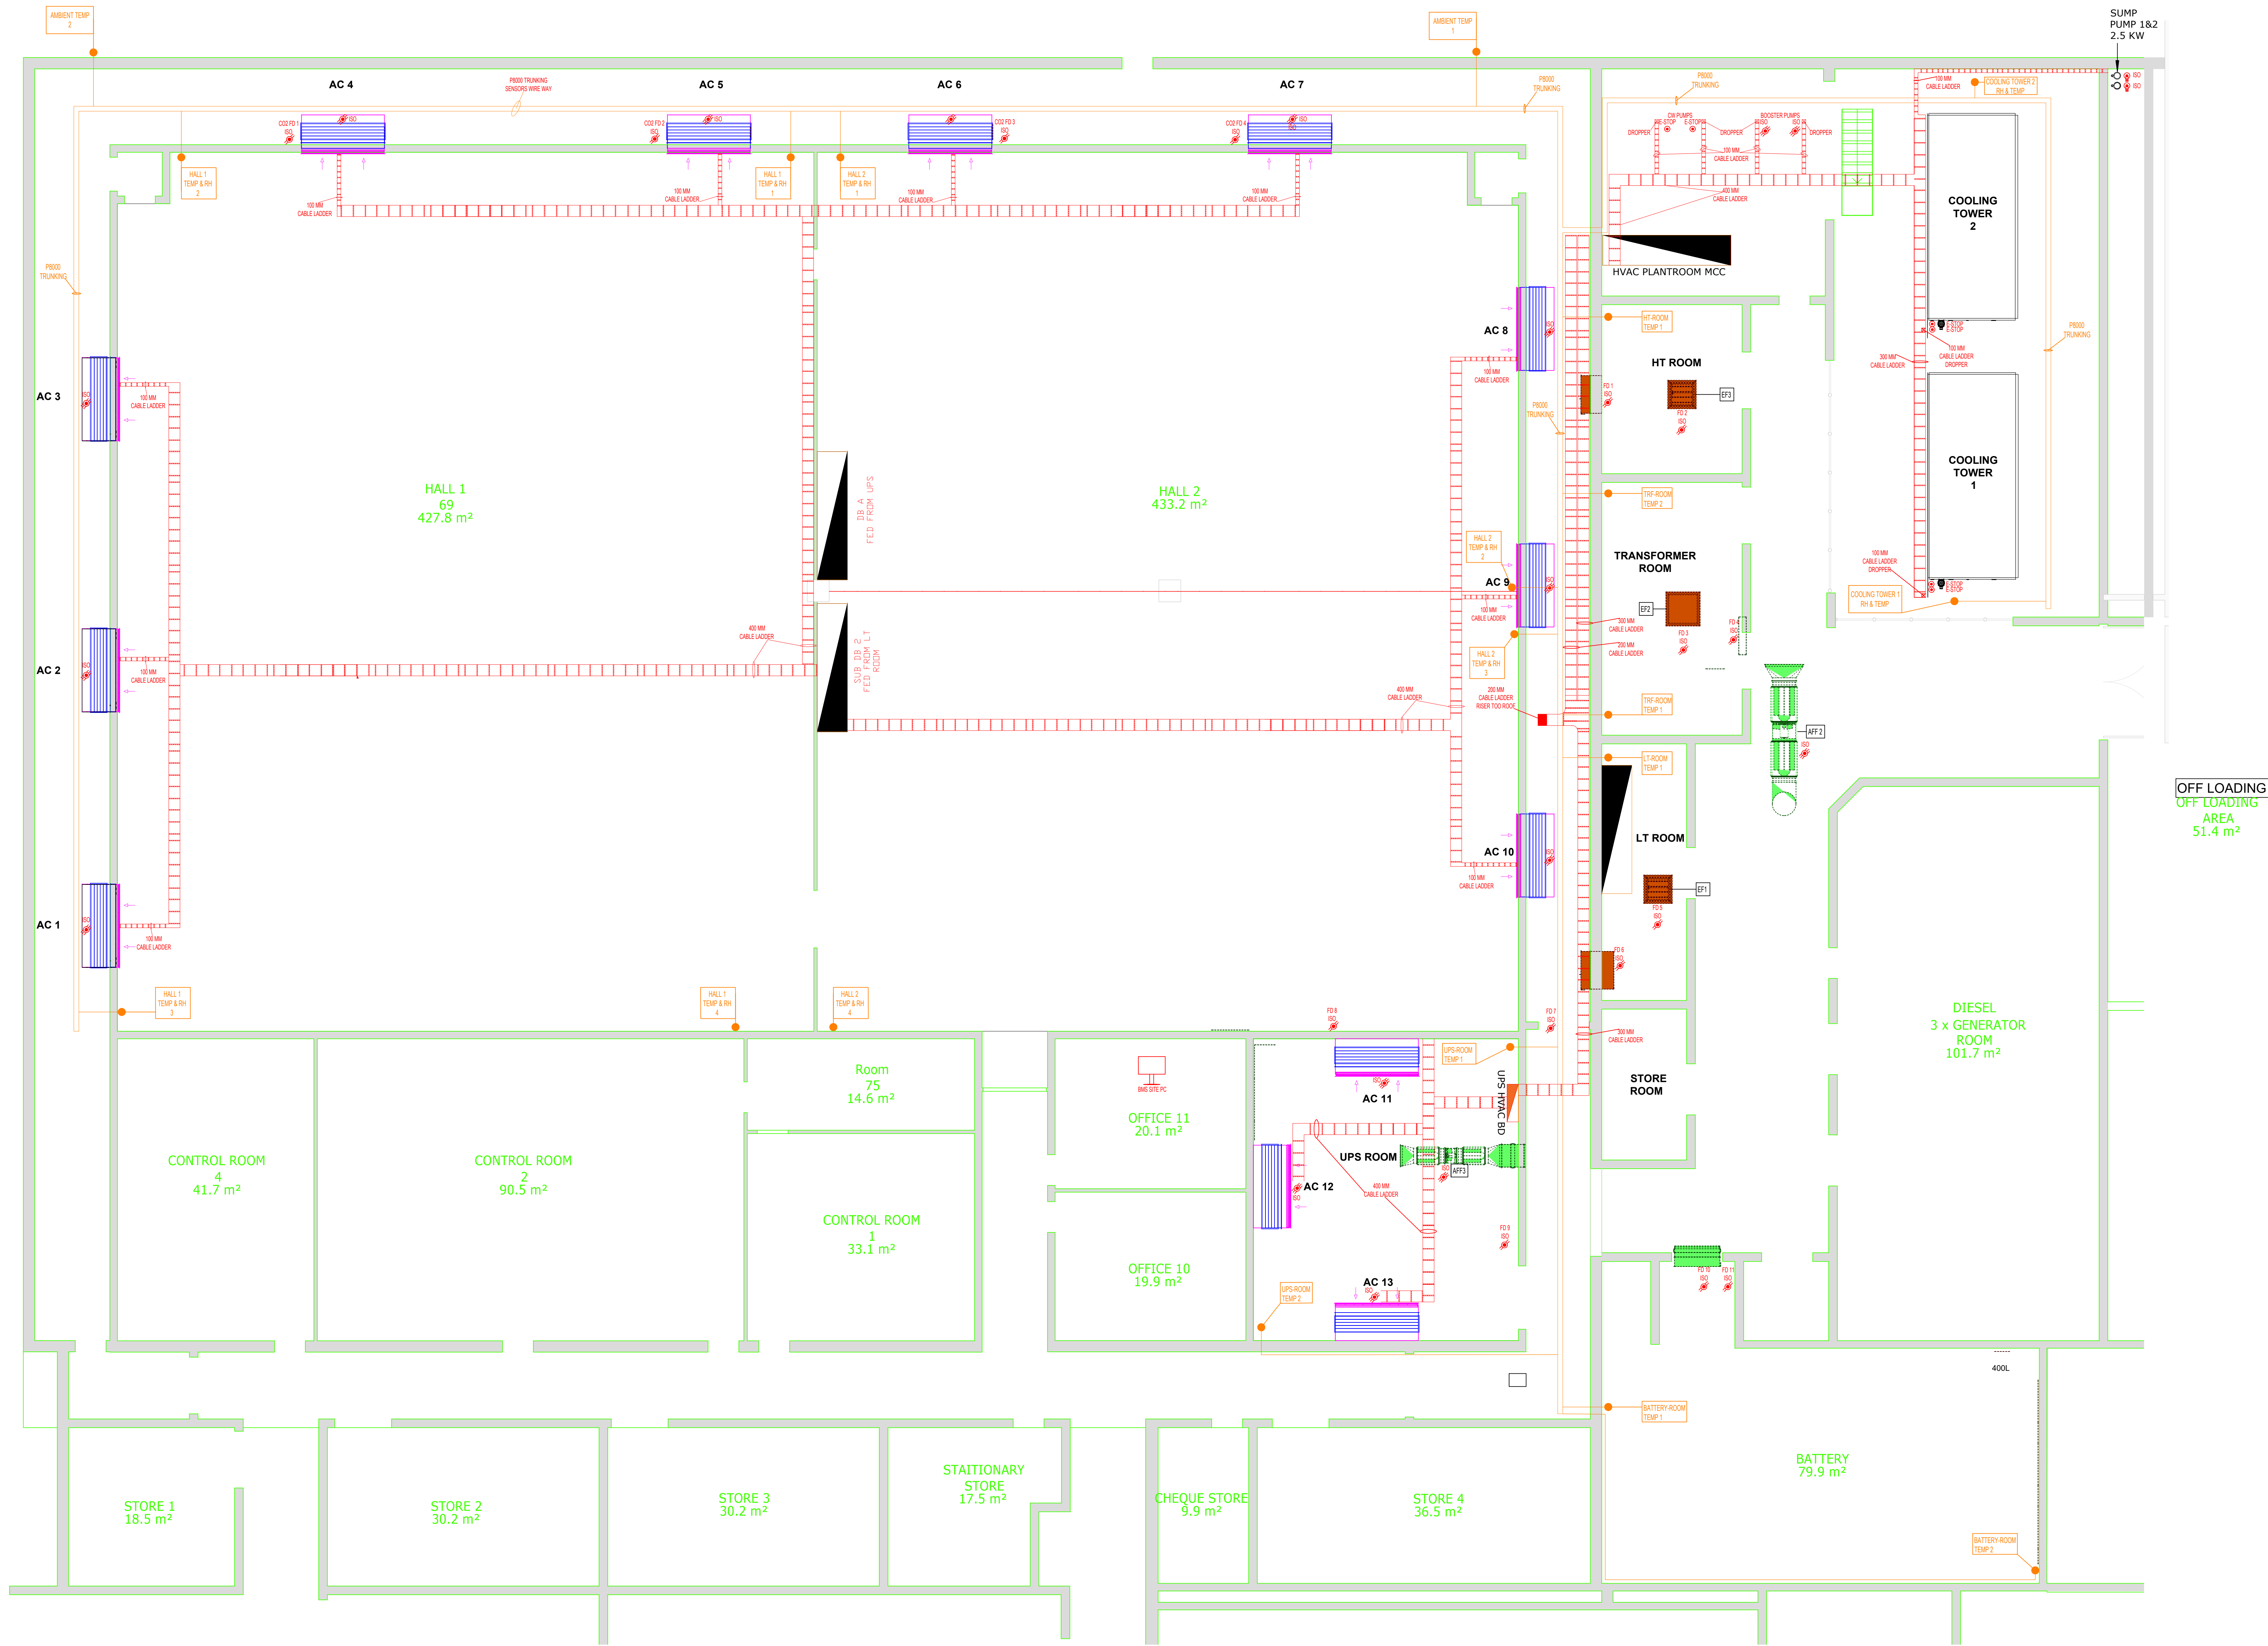

- NOTES:**
1. FOR GENERAL NOTES REFER TO DRAWING
 2. DRAWINGS ARE NOT TO BE SCALED. ALL LEVELS AND DIMENSIONS TO BE VERIFIED ON SITE PRIOR TO COMMENCEMENT OF WORKS. ANY DISCREPANCIES TO BE BROUGHT TO THE ENGINEERS ATTENTION IMMEDIATELY
 3. THIS DRAWING IS TO BE READ IN CONJUNCTION WITH ALL OTHER DRAWINGS, SCHEDULES AND SPECIFICATIONS RELATED TO THIS PROJECT.
 4. ALL BUILDING WORK AND MATERIALS ARE TO COMPLY WITH LOCAL AUTHORITY'S REQUIREMENTS AND ARE TO BE IN ACCORDANCE WITH SANS 10400 NATIONAL BUILDING REGULATIONS

- INDEX**
- EMERGENCY STOP
 - 1 PHASE ISOLATOR
 - 3 PHASE ISOLATOR
 - FIELD SENSOR PLACEMENT
 - WELDING SOCKET ISOLATOR
 - CABLE LADDER
 - P8000 TRUNKING

CONSULTING ENGINEER SIGNATURE: _____ DATE: _____
PROFESSIONAL REG.:

CLIENT SIGNATURE: _____ DATE: _____
CLIENT NAME:



CONSULTANT DETAILS:

Royal HaskoningDHV
Enhancing Society Together

Fountain Square
78 Kalkoen Street
Moument Park
Pretoria
Tel No. (087) 352-1500

CONTRACTOR DETAILS:

ben BOOYSEN
AIR-CONDITIONING
PLUMBING
ELECTRICAL
LEADERSHIP THROUGH SERVICE

27 Clough Street
Pietermaritzburg
KwaZulu Natal
+27 33 345 3135
admin@actionair.co.za

SERVICE:

ELECTRICAL HVAC

PROJECT NAME:

SITA DATA & SWITCHING CENTRE

SHEET TITLE:

GROUND FLOOR HVAC ELECTRICAL AND BMS

DATE: 2021-05-19	ACTION REF NO: 0001
PAPER SIZE: A1	DESIGNED BY: ROYAL HASKONING DHV
SCALE: 1 : 100	DRAWN BY: N. v.VOLLENSTEE
	CHECKED BY: D.BENDER

DRAWING NUMBER: 0001-GF-SPL-0101	REV:
----------------------------------	------

AS BUILT DRAWING