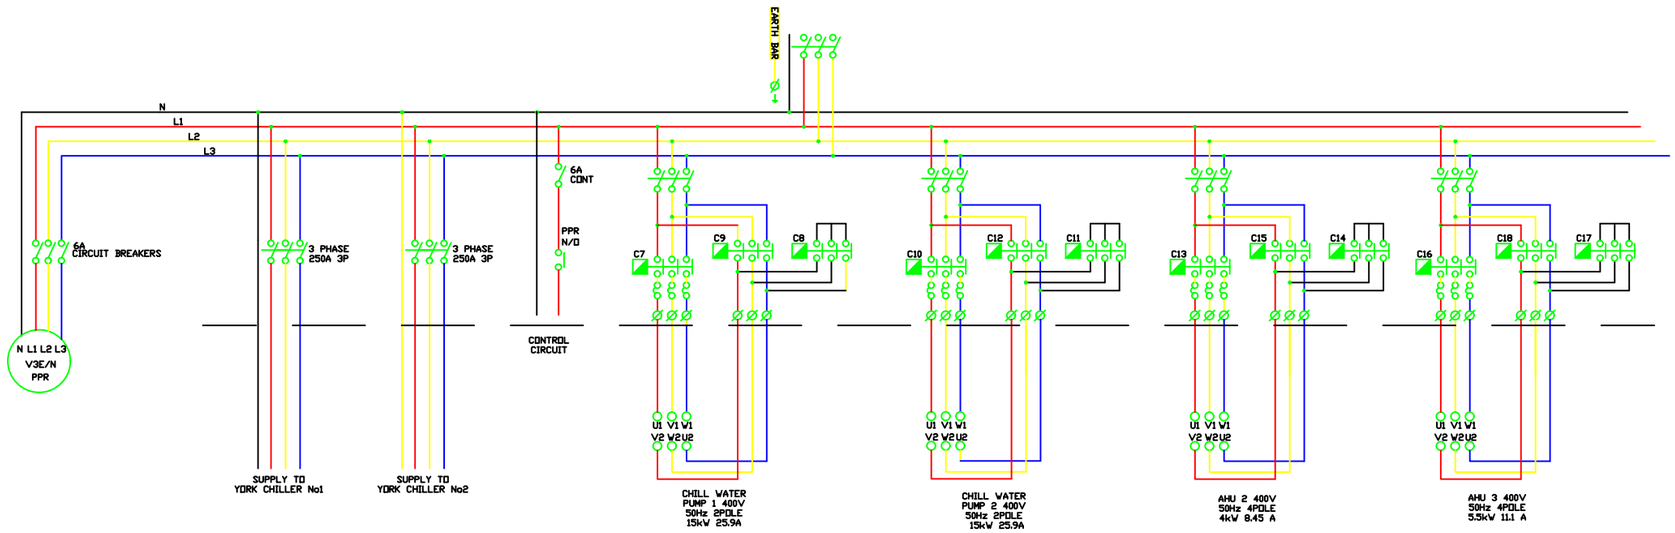

ENCLOSURE:
STEEL EPOXY COATED – ORANGE.
LOCKABLE HINGED DOOR.
ALL SWITCHES BEHIND DOOR. TRANSPARENT
CUT AWAY PERSPEX FOR CONTROLLER.
TOP ENTRY (MAINS)
TOP EXIT (SUPPLY, CONTROL)
DOOR LABELED
ALL OTHER SWITCH GEAR LABELED AND
MARKED ON LEGEND CARD.
NEUTRAL BAR INCLUDED.
EARTH BAR INCLUDED.
STANDARD TEST + SAFETY CERTIFICATE INCLUDED.

REVISIONS

REV	DATE	DRAWN	CHECKED	DESCRIPTION
1	03/05/07	DV	DV	AS BUILT UPDATE

NOTES

DRAWN

CLIENT

SITE

GEORGE
AIRPORT
AIR HANDLING SYSTEM

DESCRIPTION

MAIN DB POWER SCHEMATIC

Edition	0
material	1.6mm ELECTROGALV
Name	
	DIMENSIONS IN MILLIMETERS

Project No.

IF IN DOUBT ASK

CONFIDENTIAL

THIS DRAWING AND THE INTELLECTUAL PROPERTY RIGHTS THEREIN ARE THE PROPERTY OF LEGACY SWITCHBOARDS. THE DRAWING MAY ONLY BE USED FOR THE SPECIFIC PURPOSES FOR WHICH IT HAS BEEN SUPPLIED AND MUST BE RETURNED ON REQUEST.

LEGACY MARINE
(PTY) LTD S.A.

LEGACY
SWITCHBOARDS

DESIGNED BY DV	DATE 03/05/07
DETAILED BY DV	
APPROVED BY MB	SHEET No. 1 OF 3
DRAWING NO.	LSB6246/E01