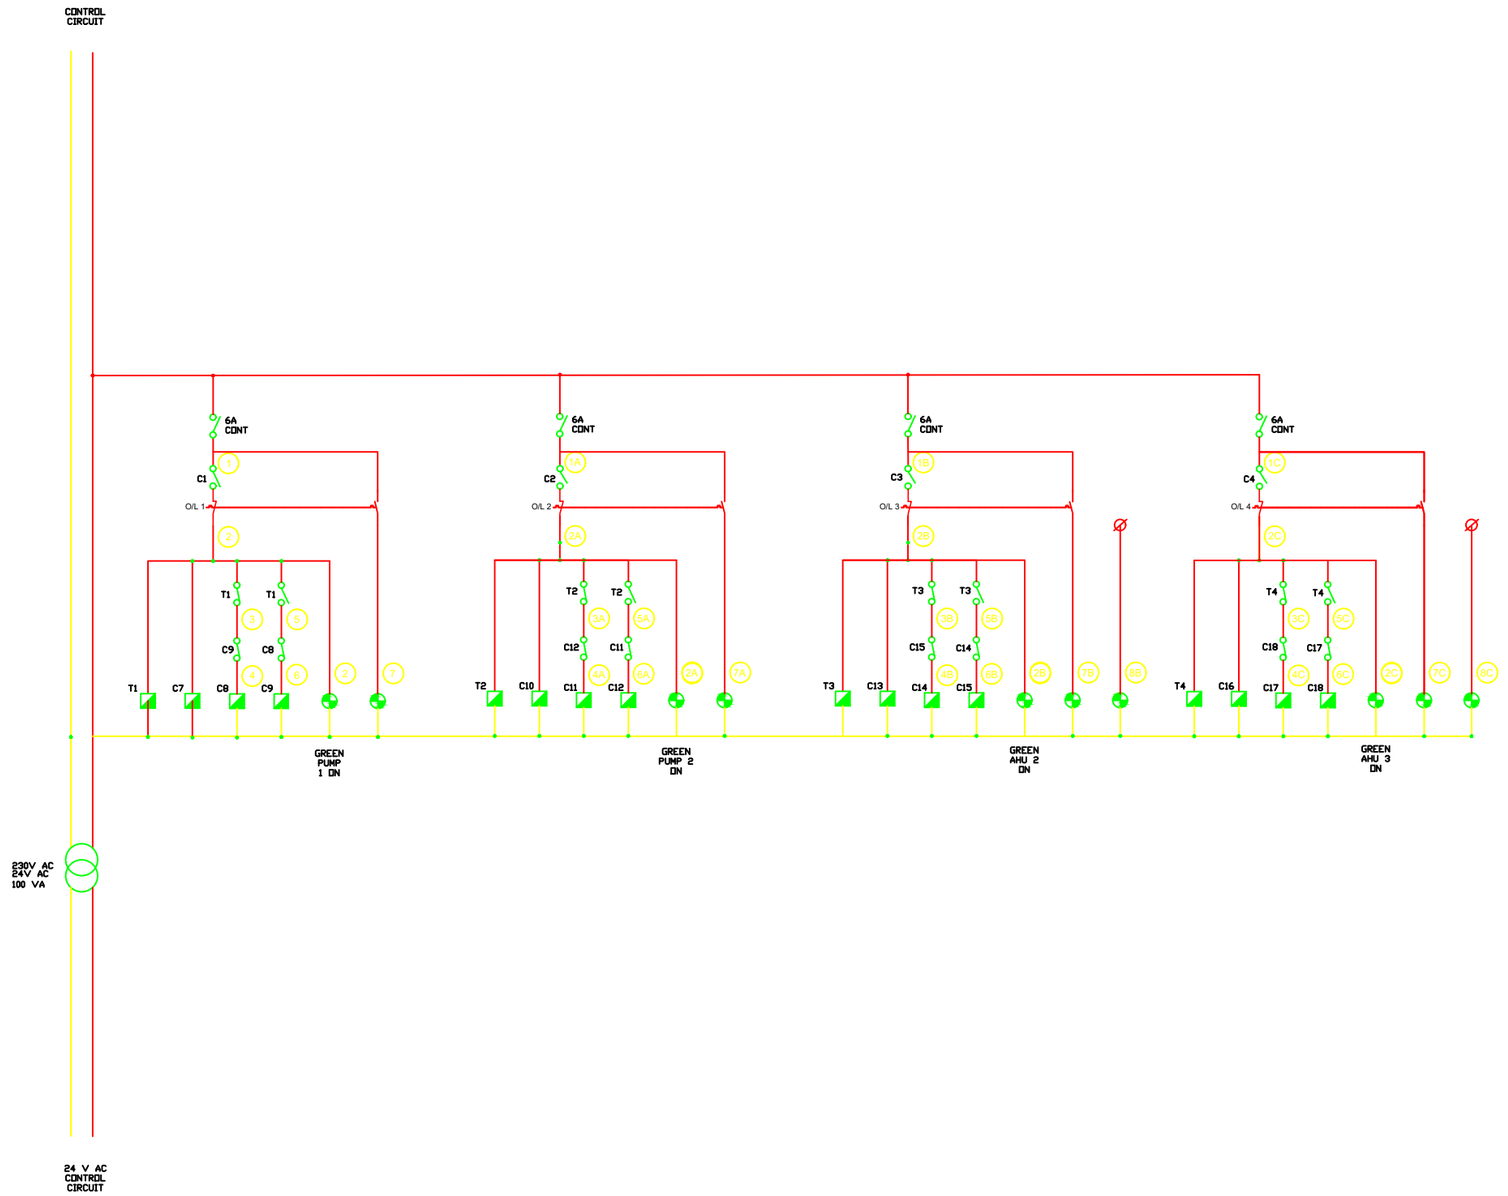

REVISIONS

REV	DATE	DRAWN	CHECKED	DESCRIPTION
1	19/05/07	DV	DV	AS BUILT UPDATE

NOTES

DRAWN

CLIENT

SITE

GEORGE AIRPORT

AIR HANDLING SYSTEM

DESCRIPTION

MAIN DB
STAR / DELTA
CONTROL
SCHEMATIC

Edition	0
material	1.6mm ELECTROGALV
Name	
	DIMENSIONS IN MILLIMETERS

Project No.

IF IN DOUBT ASK

CONFIDENTIAL

THIS DRAWING AND THE INTELLECTUAL PROPERTY RIGHTS THEREIN ARE THE PROPERTY OF LEGACY SWITCHBOARDS. THE DRAWING MAY ONLY BE USED FOR THE SPECIFIC PURPOSES FOR WHICH IT HAS BEEN SUPPLIED AND MUST BE RETURNED ON REQUEST.

LEGACY MARINE (PTY) LTD S.A.

LEGACY SWITCHBOARDS

DESIGNED BY	DV	DATE	03/05/07
DETAILED BY	DV		
APPROVED BY	MB	SHEET No.	2 OF 3

DRAWING NO.

LSB6246/E01