




LAYOUT PLAN
SCALE 1:500

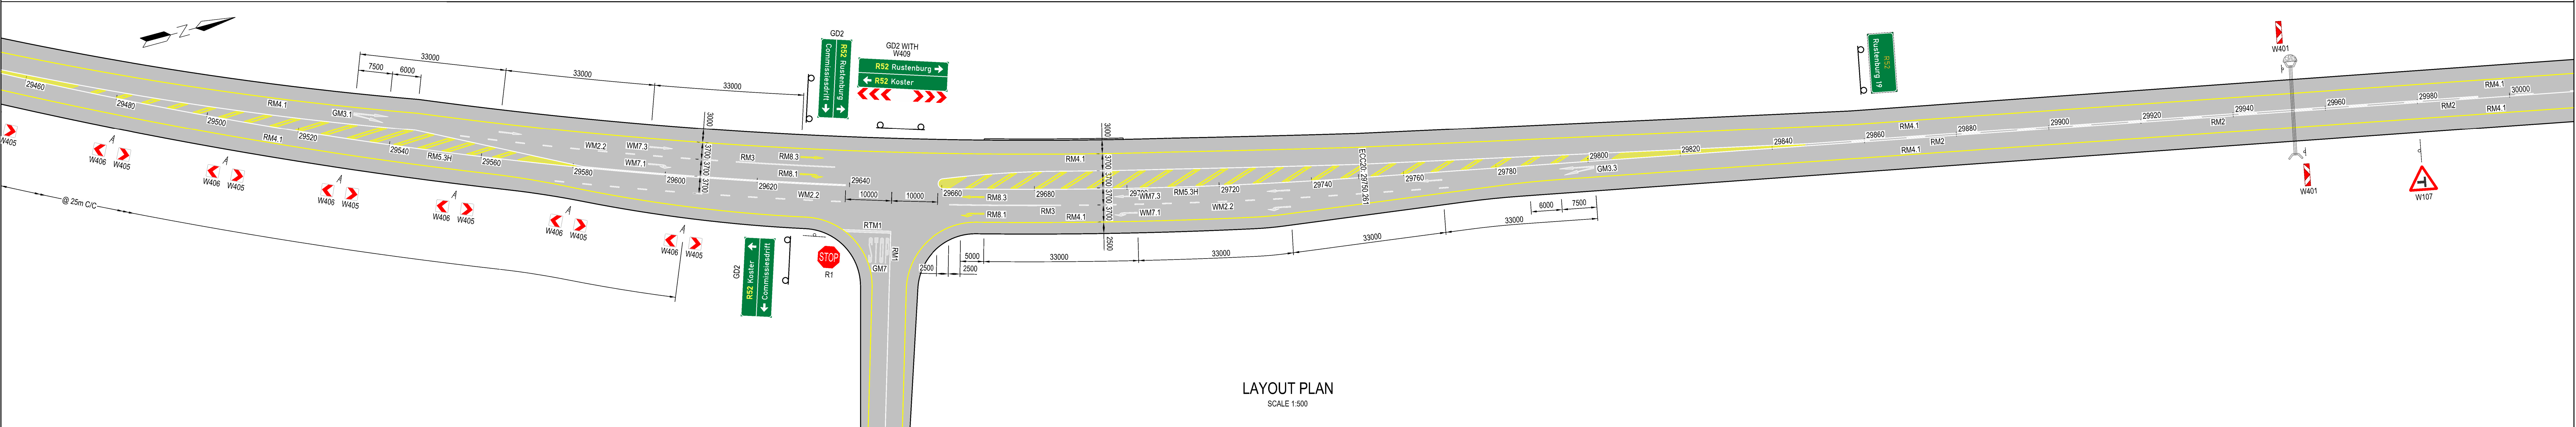

LAYOUT PLAN
SCALE 1:500

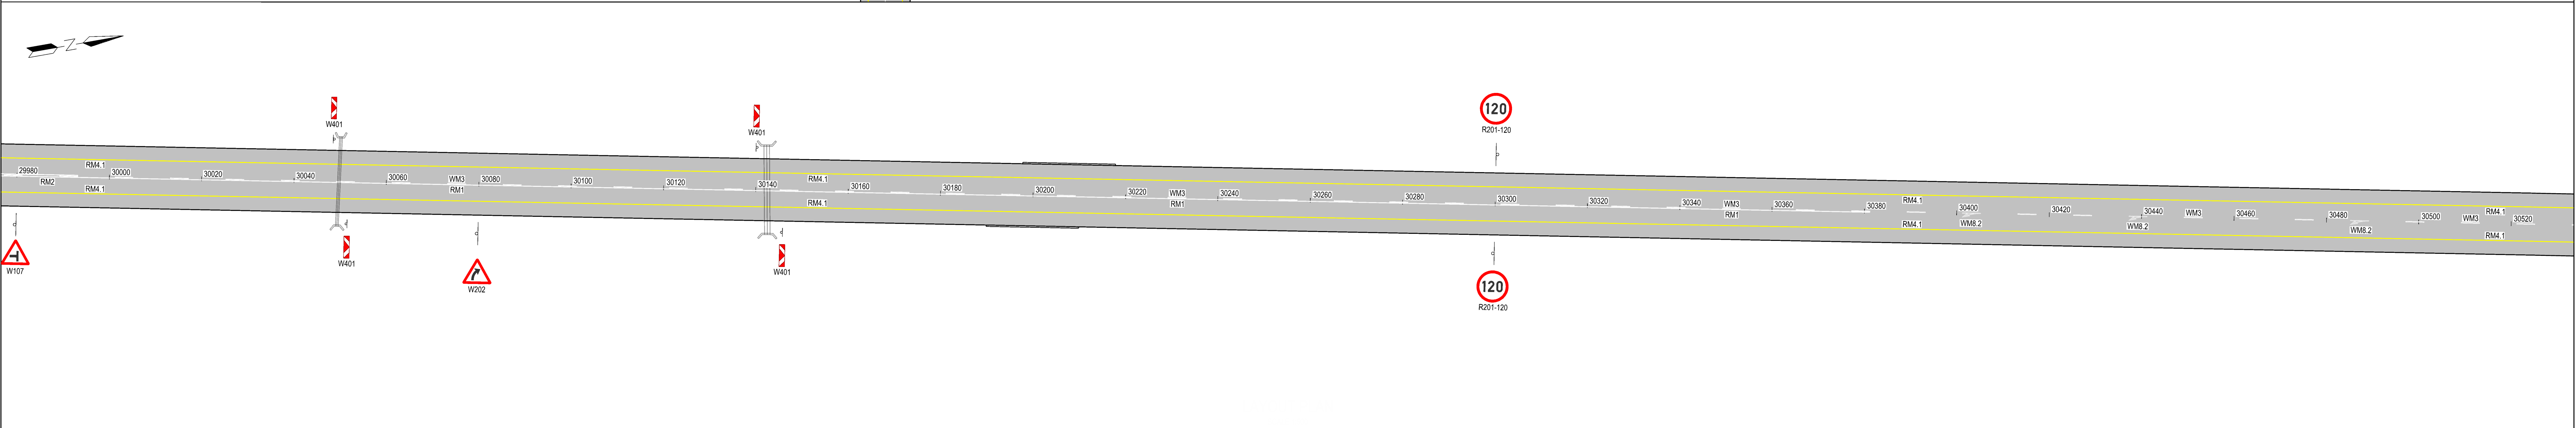

LAYOUT PLAN
SCALE 1:500

| | | | | | | | | | | | | | | | | | | | | | | | | | | | |
|--|--|-------------------------|--|--------------------------------|--|--|---|----------------------|--|---|--|---|--|---|--|--|--|--|--|------------------------|--|-------------------------|--|----------------|--|------------------|--|
| | | | | CONSTRUCTION RECORD (AS-BUILT) | | <div><div>35A Piet Retief Street PO Box 802 Harrismith 9880 Tel: (058) 622 1297 Fax: 058 623 0827 E-mail: harrismith@ilifa.biz</div><div><div>ilifa</div><div>AFRICA ENGINEERS</div></div></div> | <div><div>QUANTRA</div><div>CONSULTING SA Reg No: 2015/340071 / 07</div><div>103 Maranata Ave Mosser Bay 6500 South Africa +27 44 690 4417 Mosserbaai@Quantra.co.za</div></div> | DESIGNED BY | | CONSULTANT APPROVAL | | HEAD OFFICE | | <div><div>SANRAL</div><div>BUILDING SOUTH AFRICA THROUGH BETTER ROADS</div></div> | | NORTHERN REGION | | ACCEPTANCE | | PROJECT DESCRIPTION | | | | PROJECT NUMBER | | R.052-030-2020/1 | |
| | | WORKS CONTRACT ENGINEER | | NAME | | | | A.W. POORTMAN | |  | | 48 Tambolie Avenue Val de Grace Pretoria 0184 | | 38 Ida Street Menlo Park Pretoria 0081 | | THIS ACCEPTANCE IS FOR PROCEDURAL AND ADMINISTRATIVE REVIEW PURPOSES ONLY AND DOES NOT ATTRACT LEGAL LIABILITY OR LIABILITY OF ANY KIND FROM WHATSOEVER CAUSE OR HOWEVER ARISING | | DILPS: IMPROVEMENT ON NATIONAL ROUTE R52 SECTION 3 FROM KOSTER (KM 0.000) TO N4 RUSTENBURG (KM 38.700) | | | | DRAWING LOCATION DATA | | START | | END | |
| | | Name : | | Prof. Reg. No. : | | | | 20172990 (Candidate) | | Name : | | J.J. OLIVIER | | PO Box 415 Pretoria 0001 South Africa | | Private Bag X17 Lynnwood Ridge 0040 | | | | ROUTE | | R 052 | | R 052 | | | |
| | | Date : | | CHECKED BY | | | | | | Date : | | JUNE 2021 | | | | | | | | SECTION | | 03N | | 03N | | | |
| | | SANRAL PROJECT MANAGER | | NAME | | | | P.J.R. van WYK | | | | | | | | | | | | DRAWING km DISTANCE | | 28920 | | 31040 | | | |
| | | | | Prof. Reg. No. | | | | 2017306037 | | | | | | | | | | | | DRAWING TYPE | | ROADS - ANCILLARY WORKS | | | | | |
| | | | | DRAWN BY | | | | T.J. MOABI | | | | | | | | | | | | BRIDGE/STRUCTURE No. | | | | | | | |
| | | | | NAME | | | | | | | | | | | | | | | | CONSULTANT DRAWING No. | | H17- 028-00-RR-RM16 | | VER | | | |
| | | | | Date : | | | | | | | | | | | | | | | | SANRAL DOCUMENT # | | | | V1 | | | |
| | | | | | | | | | | | | | | | | | | | | | | | | | | | |
| | | | | | | | | | | | | | | | | | | | | | | | | | | | |
