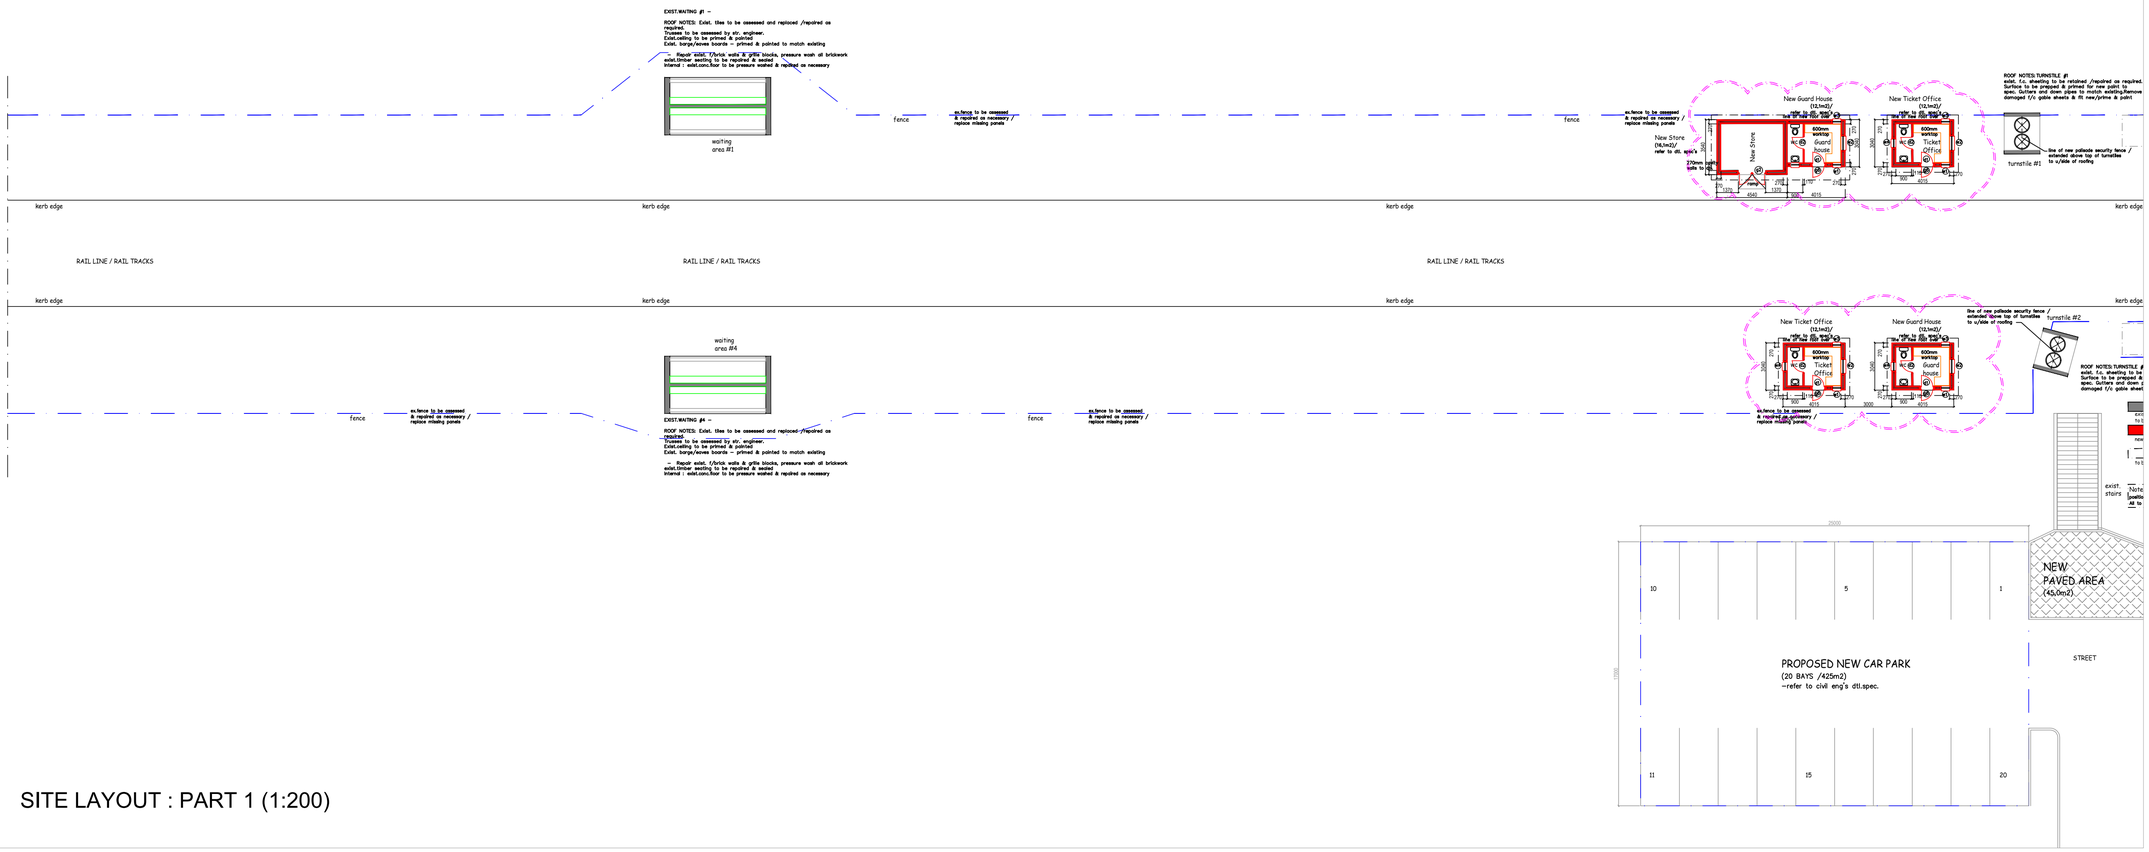

SITE LAYOUT : PART 1 (1:200)

SITE LAYOUT : PART 2 (1:200)

GENERAL NOTES :

1. The Contractor is responsible for the correct setting out of the buildings and all external and internal walls with particular reference to boundaries, building lines and setting out points.
2. The Contractor is to verify all levels, heights and dimensions on site and is to check these against the drawing before putting any work in hand.
3. The Contractor is to locate and identify existing services on the site and to protect these from damage throughout the duration of the contract.
4. Any errors, discrepancies or omissions are to be reported to the Architect immediately.
5. Contractor is to build in Approved D.P.C.'s, whether or not these are shown on drawings, to all external walls at each floor, beam or parapet level and to all windows, doors, grilles or other opening in external walls. Cavity walls to have stepped D.P.C.'s.
6. All queries arising from all the above must be reported to the Architects for clarification before any work is put in hand.
7. Do not scale this drawing; refer to figured dimensions only.

Revision Schedule

REV	NAME	DATE	DESCRIPTION
B		–	CONTAINERS INTO BRICKWORK

NOTES:

CLIENT:

PASSENGER RAIL AGENCY OF SOUTH AFRICA

PROJECT MANAGERS /IMPLEMENTATION:

DURAPI CONSULTING
Innovation. Value. Excellence

DISCIPLINE: (electrical / structural / architecture)

DURAPI CONSULTING
Innovation. Value. Excellence

	NAME	REG. NO.	SIGNATURE	DATE
DRAWN	J.Lopes	Pr.Arch 6718	–	15 /06/2022
DESIGNED	-		-	
CHECKED	J.Lopes	Pr.Arch 6718	–	15 /06/2022

PROJECT DESCRIPTION

PRASA East London - Berlin Corridor
Stations Upgrade - HIGHGATE STATION

DRAWING TITLE

DETAIL - SITE LAYOUT PLAN

STATUS LEGEND
I=INFORMATION
CV=CONCEPT AND VIABILITY
D=DESIGN DEVELOPMENT
T=TENDER
C=CONSTRUCTION
AB=AS BUILT

SHEET SIZE
A1

SCALE
1 : 200

DISCIPLINE	DRAWING NUMBER	STATUS	REVISION
ARCHITECTURE	EL/A - P006	T	B