


-6-

-7-

-8-

- FLANGED SABS 1123 RISING SPINDLE GATE VALVE
- FLANGED SABS 1123 PRESSURE REDUCING VALVE
- FLANGELESS BUTTERFLY VALVE
- FLANGELESS WAFFER CHECK VALVE
- VICTALIC COUPLING - DISMANTLING JOINT

ALL FLANGES TO BE SABS 1123-1600-3

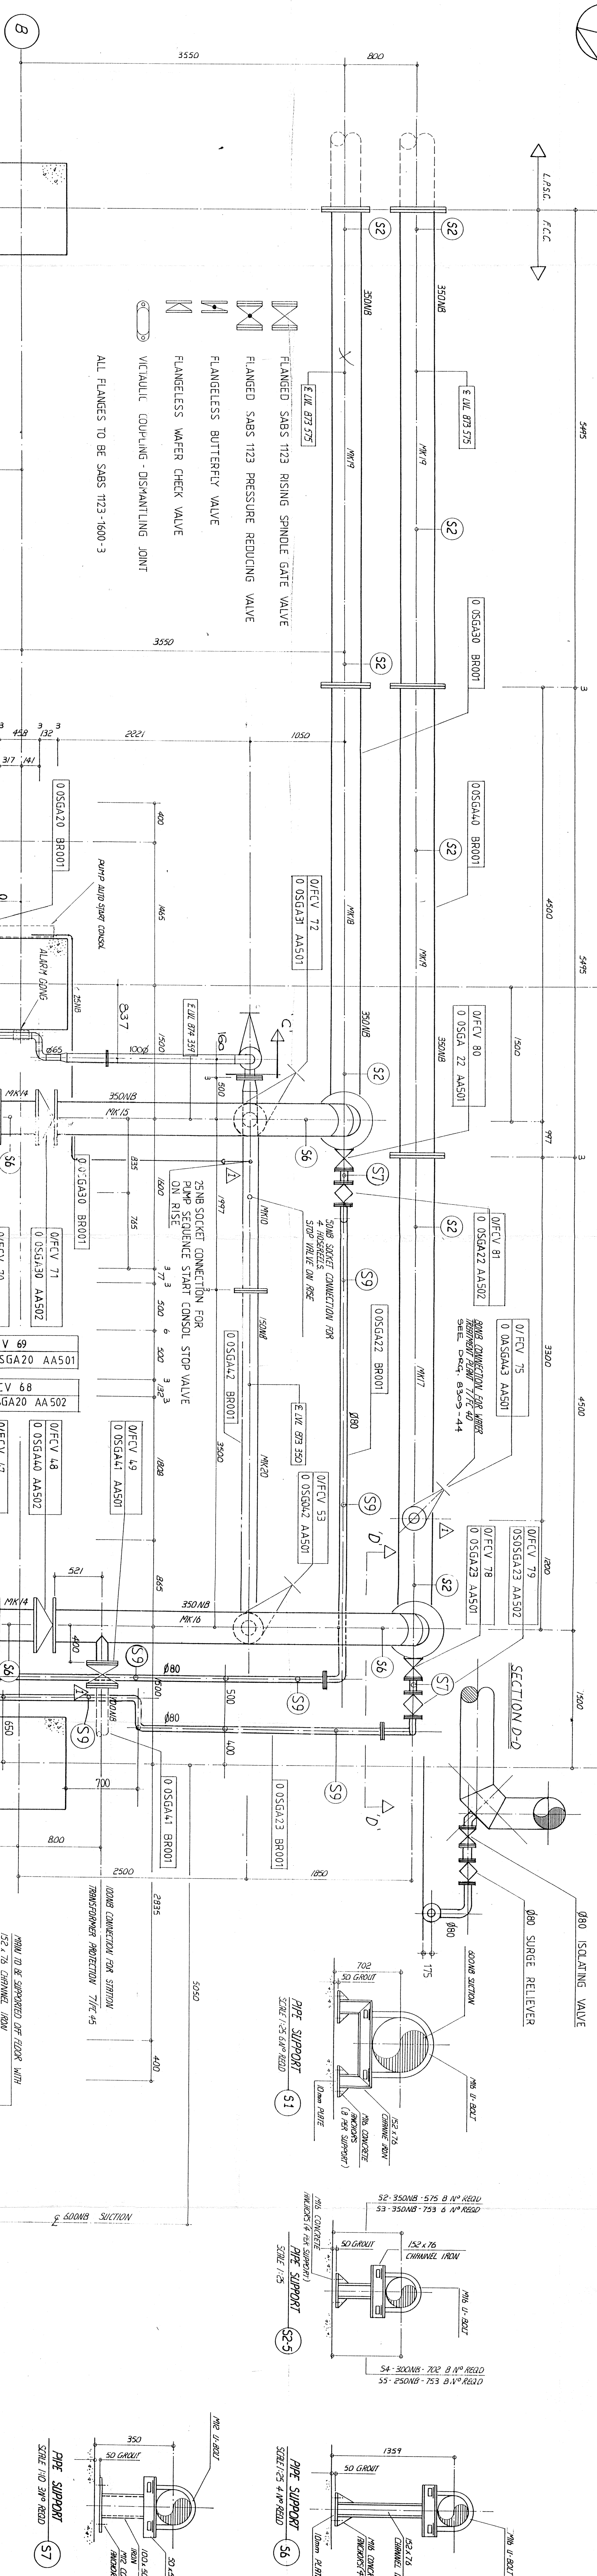

SECTION A-A
TYPICAL SECTION OF R/L BOUNDARY AND 250MM
RISING SPINDLE GATE VALVE. SCALE 1:25

VIEW D

VIEW E

VIEW F

VIEW GH

VIEW GI

VIEW GJ

VIEW KL

VIEW KM

VIEW KN

