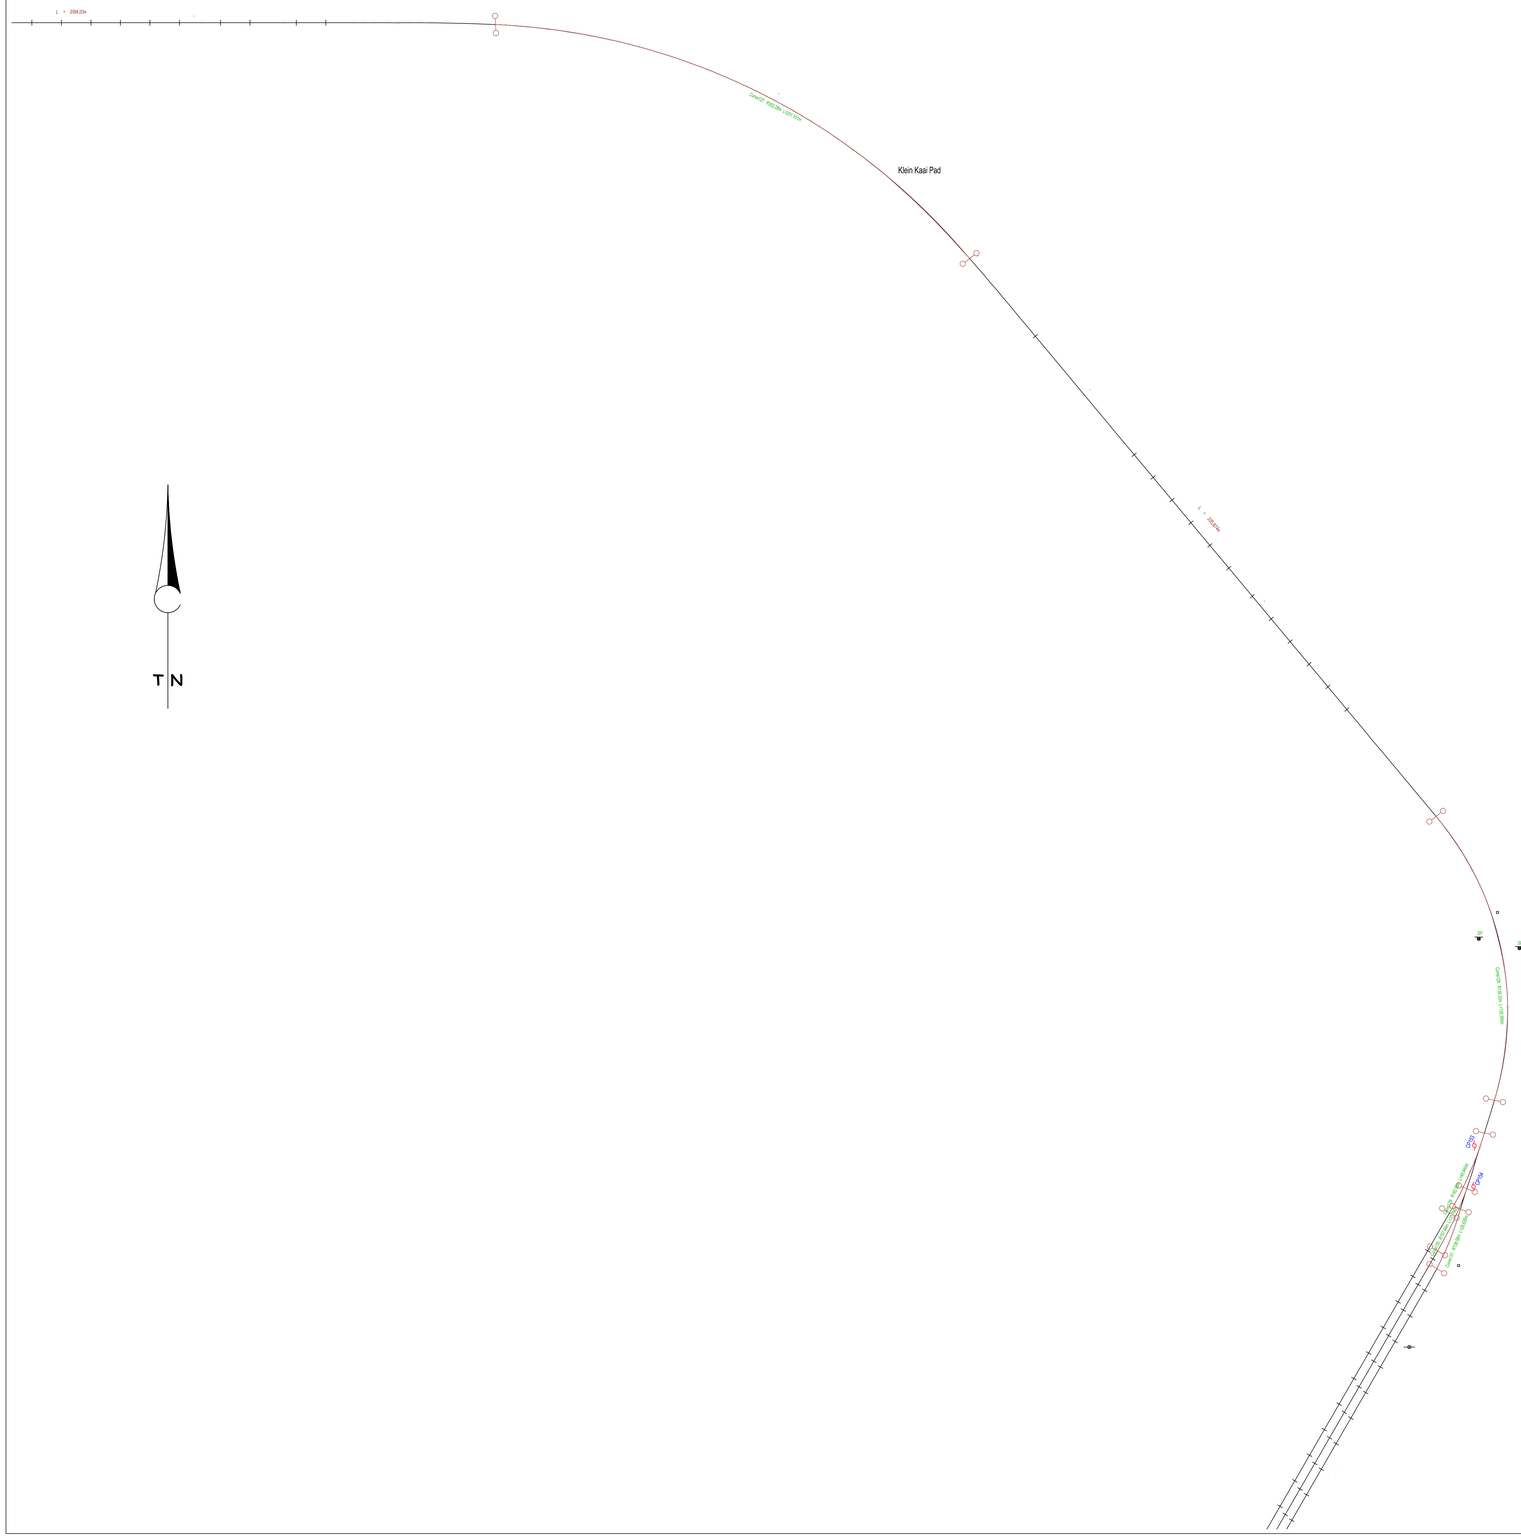

TRANSNET

Plan prepared for:
TRANSNET NATIONAL PORTS AUTHORITY
Mr. Basil Ngcobo
Tel: (035) 905-3985

LEGEND

- FH = FIRE HYDRANT
- CP = CHANGE POINT
- EP = ELECTRICITY POLE & No.
- MARKER PRIVATE
- ROBOT
- MAST & No.
- SP = SIGN POST
- MH = MAN HOLE
- LP = LIGHT POLE
- BEGINNING AND END OF CIRCULAR CURVE
- BEGINNING AND END OF TRANSITION
- STOP BLOCK
- WARNING BOARD
- STOP / NOTING BOARD

This Survey was conducted by Survey Technician:
S. W. Zungu
Reg No. 570669 & PST0111
Tel: (031) 361-3050
Cell: 083 250 9880
e-mail: siswe.zungu@transnet.net

As Built Drawing for Rail Yard

PORT of RICHARDS BAY

Compiled:	LSD	DATE: 2013-10-11
Checked:	SWZ	
For Area Manager:		
AMENDED:		
SYSTEM: WG 31°	SCALE : 1 / 1 000	

Plan prepared by:
TRANSNET PROPERTY
GEO-SPATIAL EASTERN REGION
1 MAHATMA GANDHI LIMEHILL ST
DURBAN *DOORNGATE*
4001 *4000*
Tel:(031) 361 2343
Fax:(031) 361 2341

PLAN No. RB_TNPA_RAIL YARD