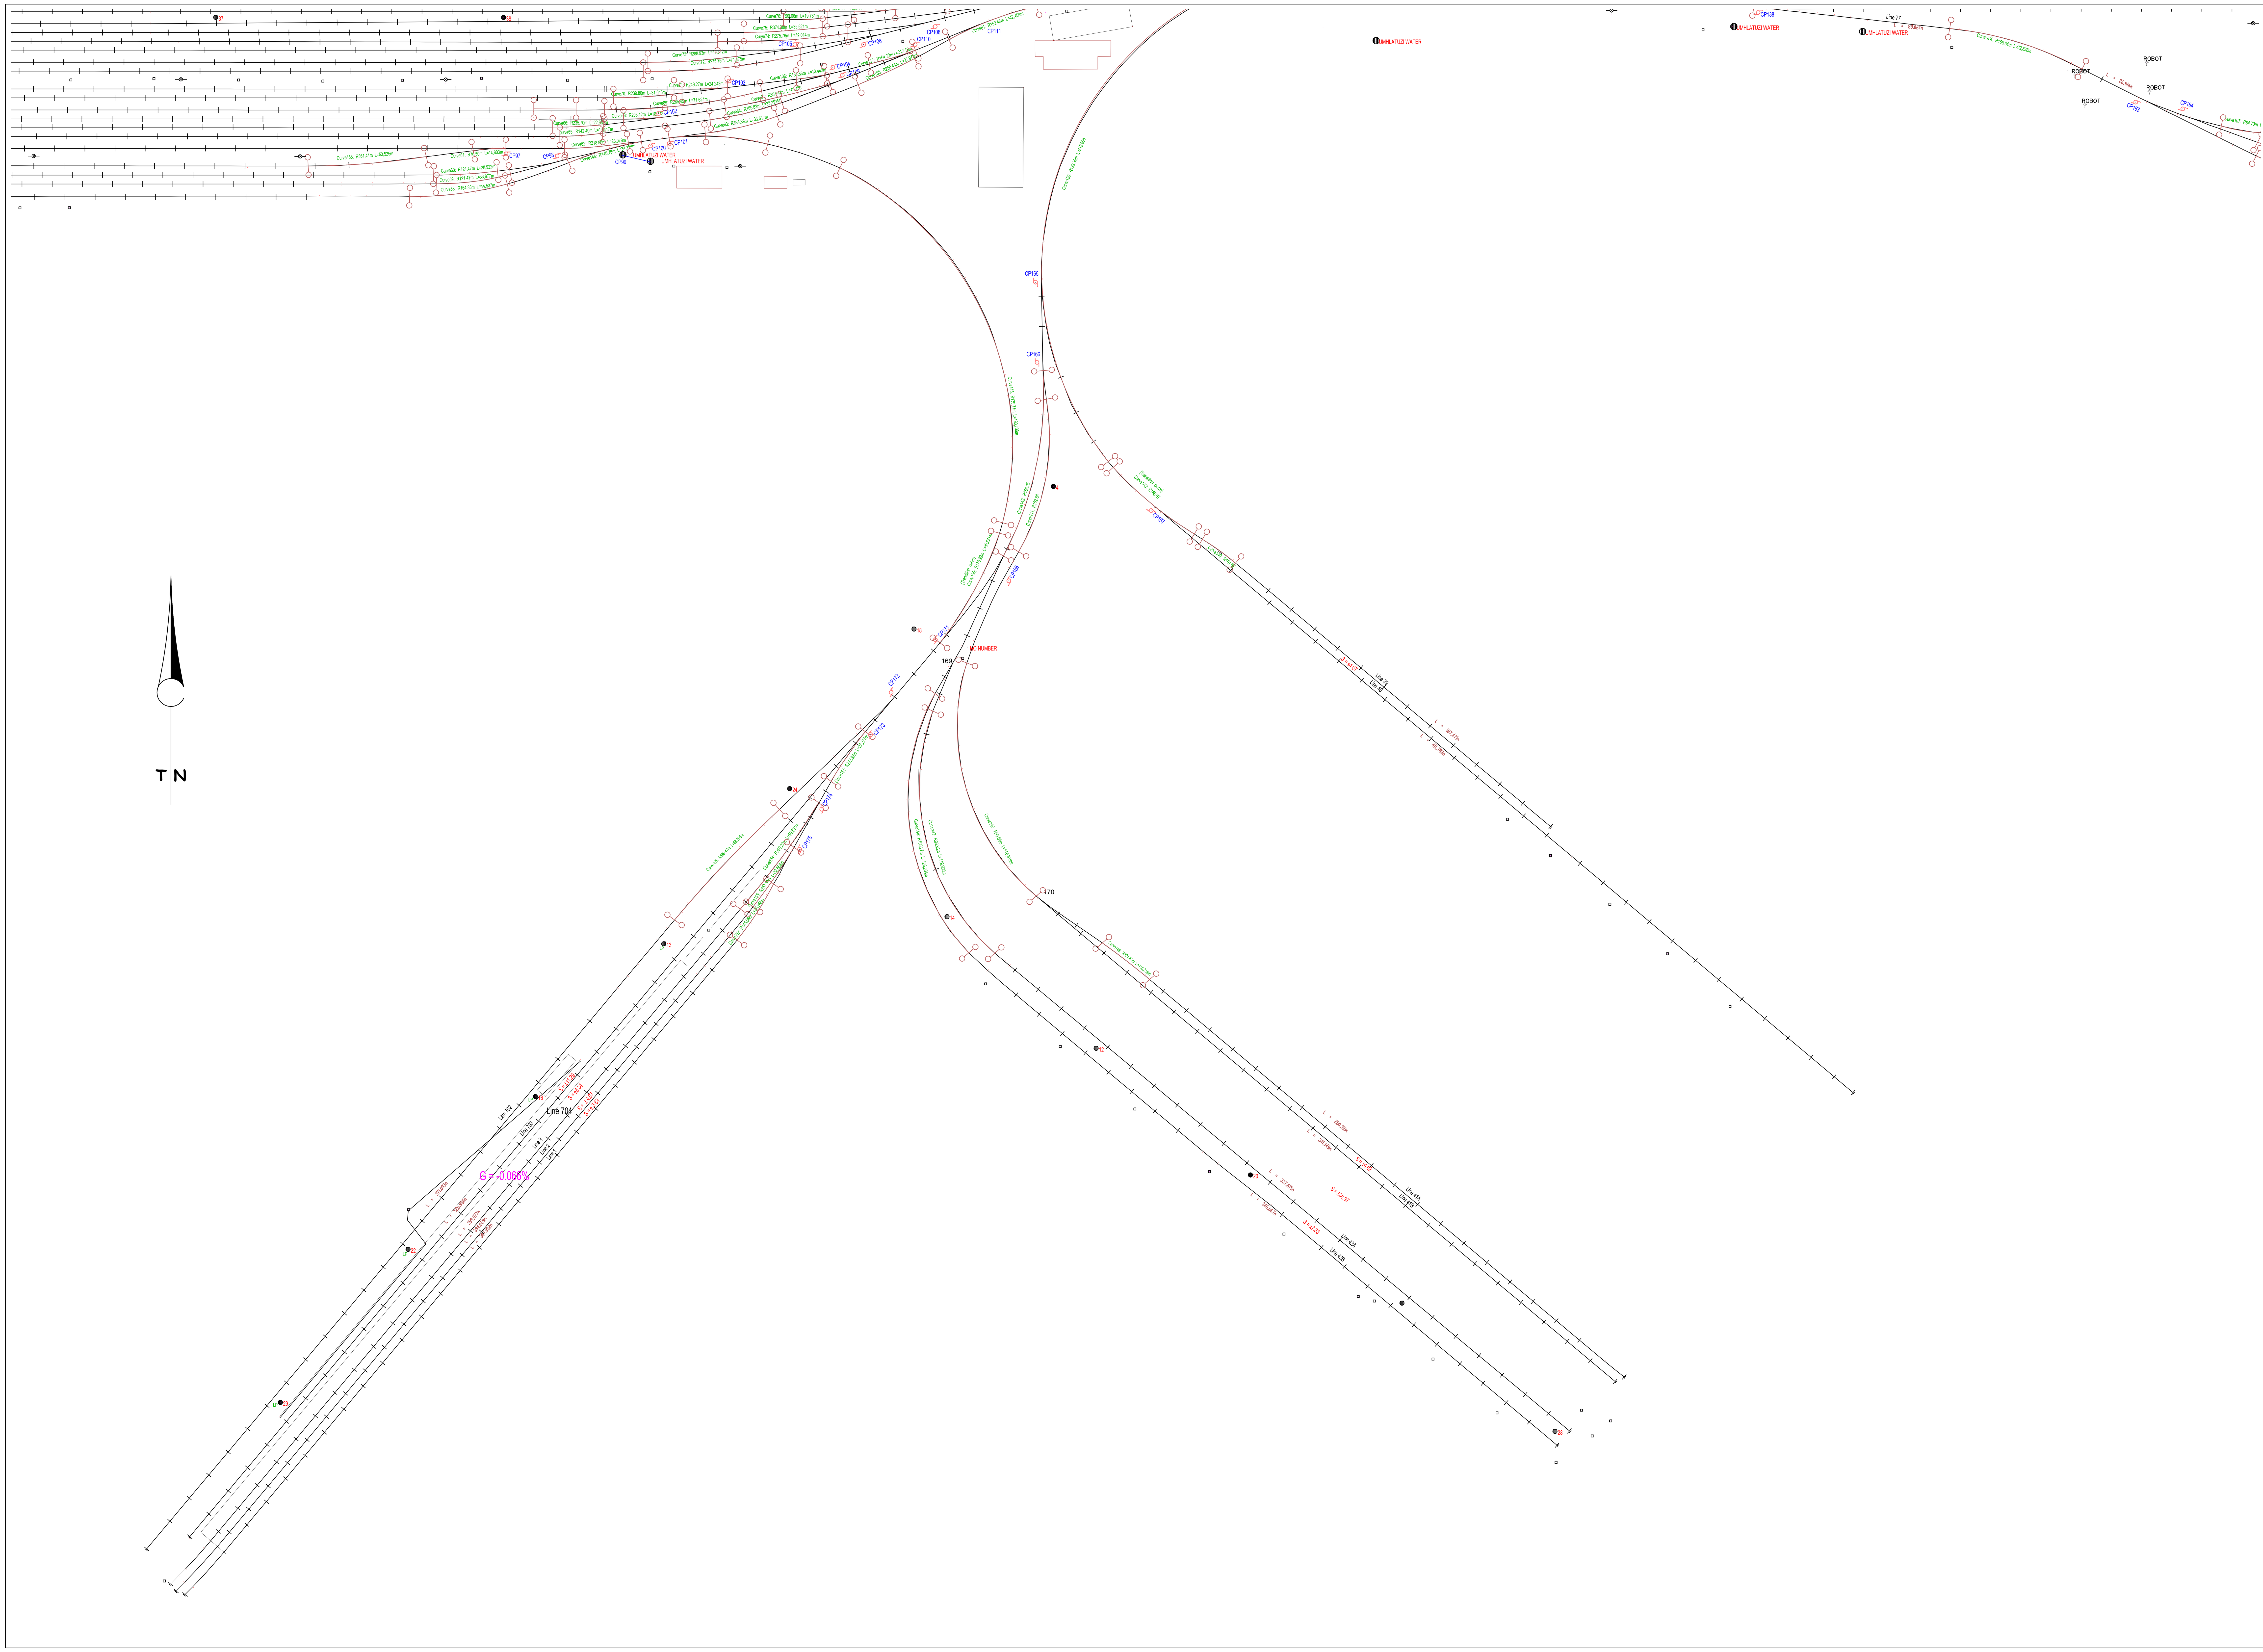

TRANSNET

Plan prepared for:
TRANSNET NATIONAL PORTS AUTHORITY
Mr. Basil Ngcobo
Tel: (035) 905-3985

LEGEND

FH = FIRE HYDRANT
CP = CHANGE POINT
EP = ELECTRICITY POLE & No.
MARKER PRIVATE
ROBOT
MAST & No.
SP = SIGN POST
MH = MAN HOLE
LP = LIGHT POLE
BEGINNING AND END OF CIRCULAR CURVE
BEGINNING AND END OF TRANSITION
STOP BLOCK
WARNING BOARD
STOP / NOTING BOARD

This Survey was conducted by Survey Technician:
S. W. Zungu
Reg No. ST0600 & PST0111
Tel: (031) 361-3030
Cell: 083 250 9880
e-mail: sizwe.zungu@transnet.net

As Built Drawing for Rail Yard

PORT of RICHARDS BAY

Compiled: LSD	DATE: 2013-10-11
Checked: SWZ	
For Area Manager:	
AMENDED:	
SYSTEM: WG 31°	SCALE : 1 / 1 000

Plan prepared by:
TRANSNET PROPERTY
GEO-SPATIAL: EASTERN REGION
202 ANTON LEMBEDE ST DURBAN 4001
P.O.Box 61577 BISHOPSGATE 4008
Fax:(031) 361 2343
Tel:(031) 361 2341

PLAN No. RB_TNPA_RAIL YARD