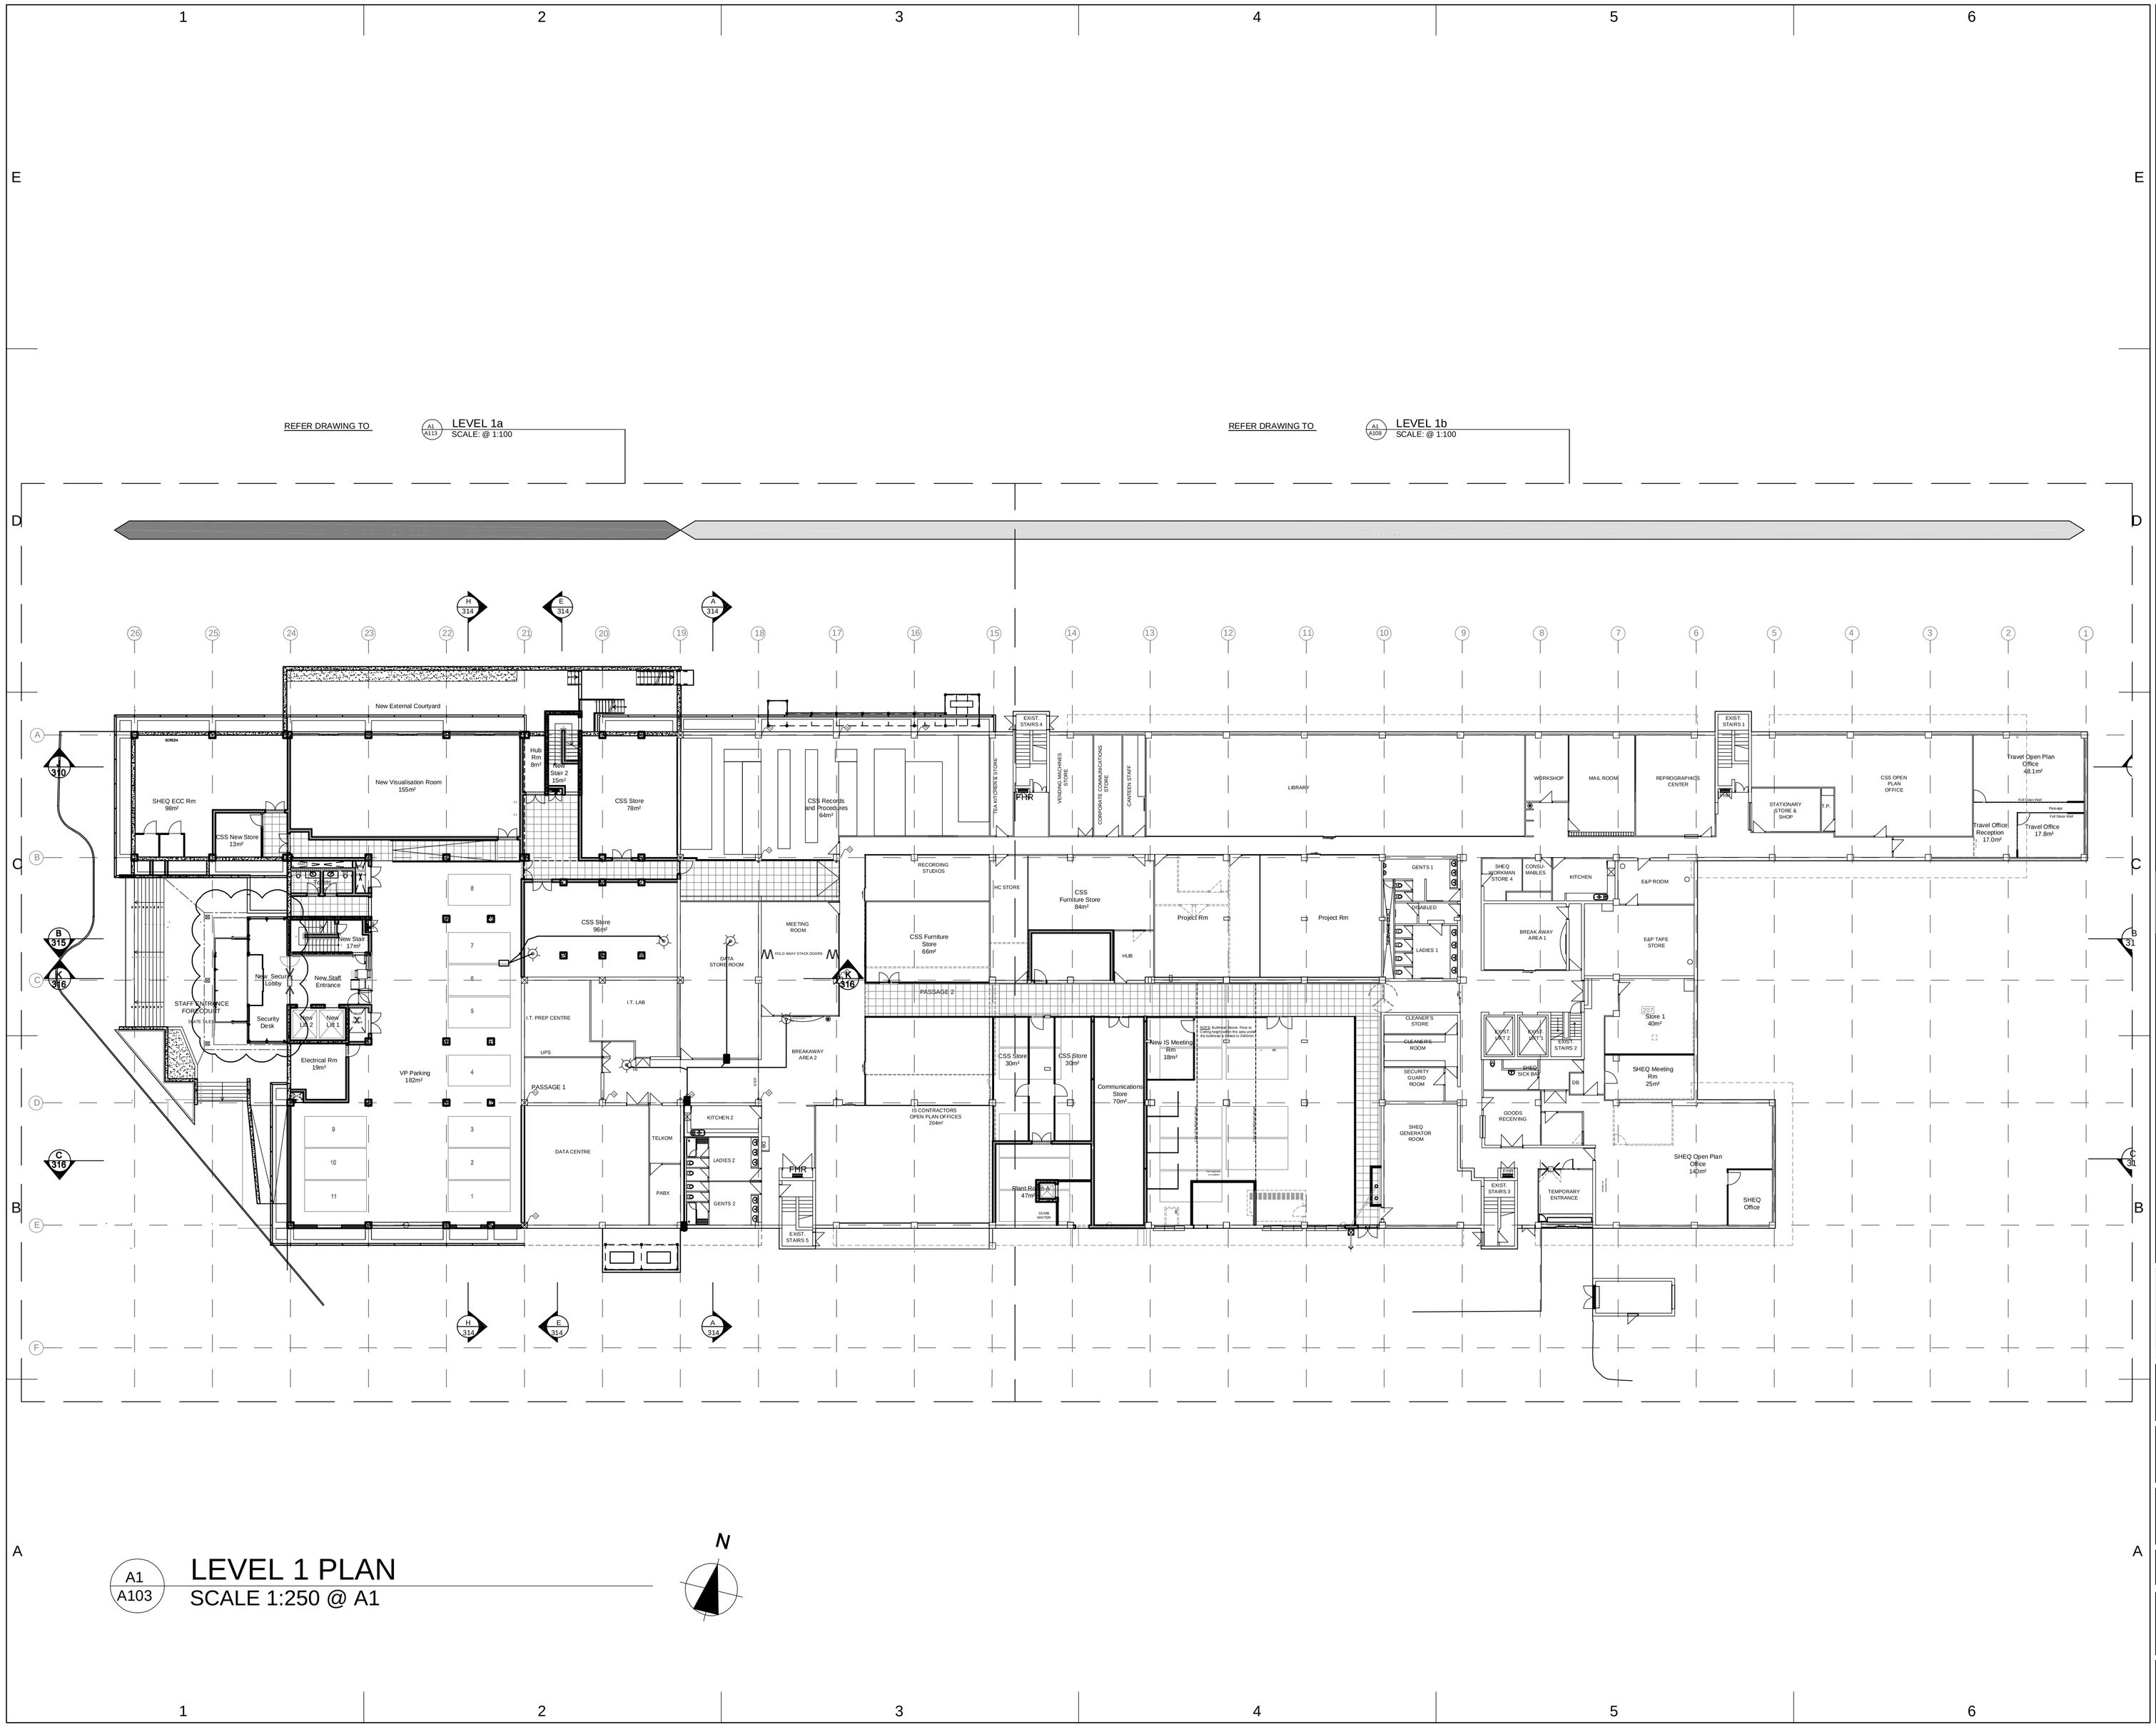

A1 A103

LEVEL 1 PLAN

SCALE 1:250 @ A1

N

NOTE:

1. THIS DESIGN IS COPYRIGHT AND REMAINS THE PROPERTY OF THE ARCHITECT.
2. ALL WORK TO BE CARRIED OUT IN STRICT ACCORDANCE TO MUNICIPAL AND NATIONAL BUILDING REGULATIONS.
3. ALL RELEVANT DETAILS, LEVELS AND DIMENSIONS TO BE CHECKED ON SITE BEFORE COMMENCING WITH ANY WORK.
4. ALL DISCREPENCIES TO BE REPORTED TO THE ARCHITECT IMMEDIATELY, WORK TO PROCEED ONCE THE PROBLEM HAS BEEN RESOLVED.
5. DRAWING NOT TO BE SCALED.

REVISIONS

REV.	DATE	REVISION DETAILS	BY
U	08.12.17	INCREASE SIZE OF TRAVEL OFFICE.	RM
V	09.02.02	ISSUED OUT TO ALL CONSULTANTS FOR INFORMATION FOLLOWING SPACE PLANNING REVISIONS.	KT
-	10.03.03	REVISIONS TO STAFF ENTRANCE, ISSUED TO COUNCIL	SD

'AS BUILT' DRAWINGS

BP NO. 0666/2008

ERF NO. 19801(3471)

' AS - BUILT' DRAWINGS DISCLAIMER :

'AS - BUILT' DRAWINGS ARE COPIES OF THE LAST DRAWINGS ISSUED FOR CONSTRUCTION TO THE CONTRACTOR AND INCLUDE, WHERE RELEVANT, INFORMATION DERIVED FROM OTHER ISSUED CONTRACT INSTRUCTIONS REGARDING THE WORKS. ALTHOUGH EVERY CARE IS EXPENDED BY ACG ARCHITECTS & DEVELOPMENT PLANNERS CC IN PREPARING THEM AND THEY ARE PROVIDED TO OUR CLIENT IN GOOD FAITH, 'AS - BUILT' DRAWINGS ARE NOT SURVEY DRAWINGS AND SHOULD NOT BE SCALED IN PREFERENCE TO FIGURED DIMENSIONS. NEITHER THE DIMENSIONS NOR THE LEVELS DEPICTED ON THE DRAWINGS HAVE BEEN VERIFIED BY ON - SITE SURVEY OR MEASUREMENT. 'AS - BUILT' DRAWINGS ARE ISSUED TO OUR CLIENT STRICTLY FOR INFORMATION ONLY AND NO LIABILITY WILL BE ACCEPTED BY ACG ARCHITECTS & DEVELOPMENT PLANNERS CC EITHER FOR ANY CONCEQUENCES OF THE USE OF DRAWINGS FOR ANY OTHER PURPOSE , OR FOR ANY USE OF THE DRAWINGS BY A PARTY OTHER THAN OUR CLIENT. SHOULD FUTURE REPAIRS , ADDITIONS OR ALTERATIONS BE UNDERTAKEN TO THE BUILDING DEPICTED ON THE DRAWINGS , THE SERVICES OF A PROFESSIONAL LAND SURVEYOR SHOULD BE UTILISED TO CONFIRM ALL DETAILS , DIMENSIONS AND LEVELS DEPICTED THEREON.

acg architects
398 ALBERT ROAD
SALT RIVER CIRCLE
PO BOX 70 WOODSTOCK 7925
TEL.: +27 21 448 6615
FAX.: +27 21 448 6621
E-MAIL: acg@archplan.co.za

CLIENT:
PETRO SA

PROJECT:	PROJECT NO.:
PETRO SA OFFICE EXTENSION	0628

DRAWING TITLE:
LEVEL 1 PLAN
EXTENSION & EXISTING

DRAWN:	CHECKED:	DATE FIRST ISSUED:
KT	AS	07/11/29

DOCUMENT STATUS:
FOR INFORMATION

DISCIPLINE:	DRAWING NUMBER:	REVISION:
A	103	-