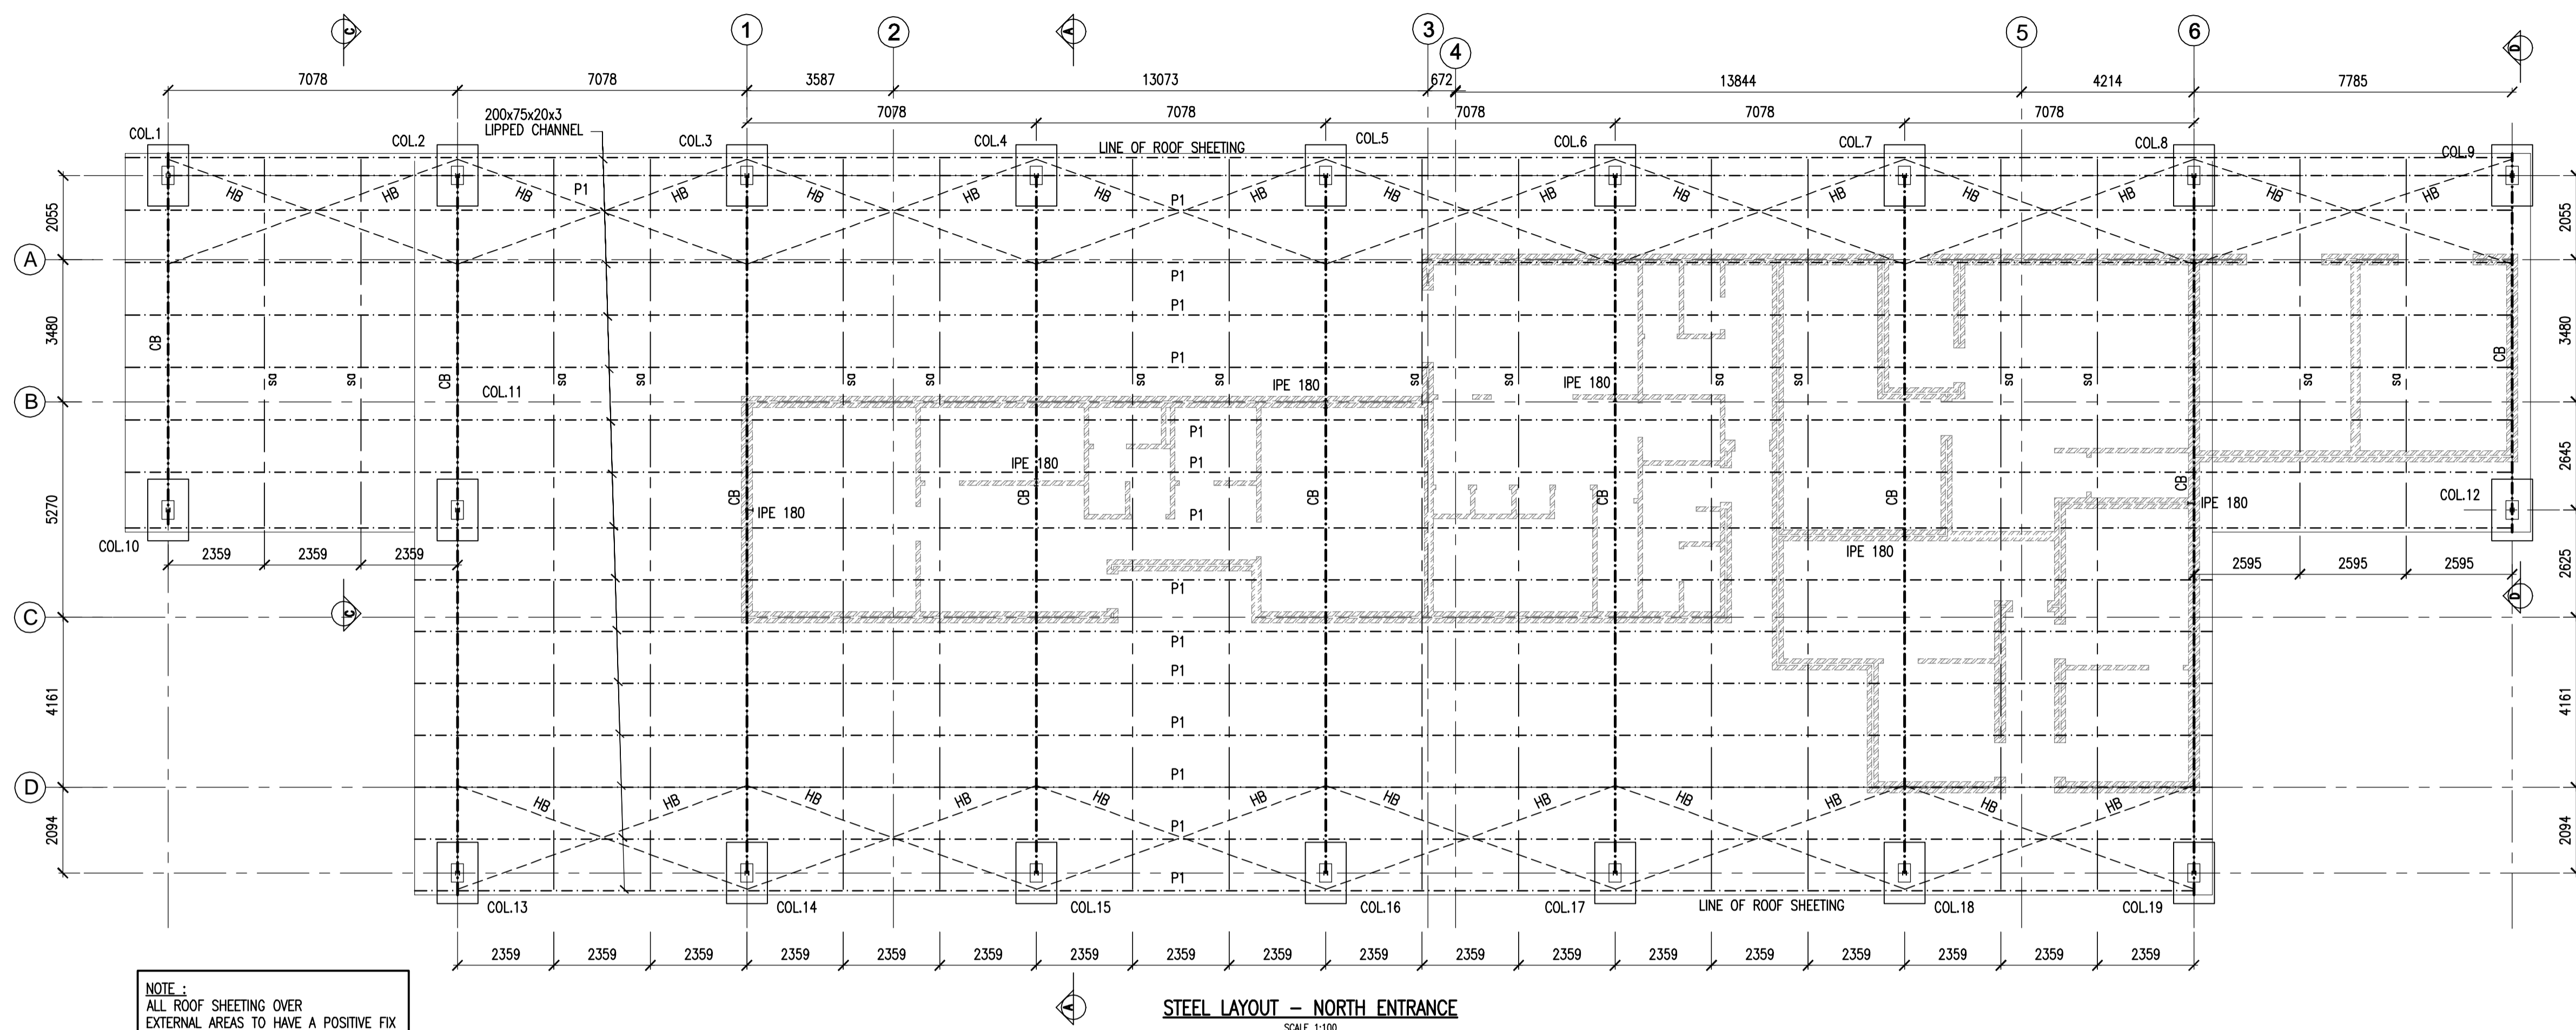


DRAWING NUMBER
H500204 1 124 G DE 0008 01 04 TP

 

DO NOT SCALE - IF IN DOUBT, ASK




NOTE :
ALL ROOF SHEETING OVER
EXTERNAL AREAS TO HAVE A POSITIVE FIX
TO THE STRUCTURE.

SCHEDULE OF STEEL MEMBER SIZES		
MARK	MEMBER	SECTION SIZE
P	PURLIN	200x75x20x3 CLC
HB	HORIZONTAL BRACING	70x70x6 L
sa	SAG ANGLE	40x40x3 L
CR	CURVED BEAM	305x165x41 L

COLUMN AND BASE SCHEDULE				
Column Number	Column Size	Base Size	Top Level Base	Top Level Column
1 to 19	450x300	1500x1000x750	41.262	44.086

						EPCM CONSULTANT: TRANSNET PROJECTS				ORIGINATOR: WSP STRUCTURES AFRICA			
						TITLE	NAME	SIGNATURE	DATE	TITLE	NAME	SIGNATURE	DATE
						LEAD DES. ENG.				DRAWN	SVH		08 06 30
04	FOR RECORD	SVH	WJ	010.02.09		ENG. COORD.				CHECKED	WJ		08 06 30
03	FOR CONTRACTORS MARK-UP	SVH	WJ	09.12.02		ENG. MANAGER				ENG. COORD.			
02	PURLINS SPACING REVISED & SAG	KG	WJ	08.10.08		AREA MANAGER				DISCIP. ENG.			
	ANGLES REMOVED. POSTS ADDED.			08.10.08		PROJECT MGR.				ENG. MANAGER			
01	LEVELS REVISED	KG	WJ	08.09.22		DIVISION				AREA MANAGER			
00	FOR CONSTRUCTION	KG	WJ	AE 08.06.30		DIV.	TITLE	NAME	SIGNATURE	DATE			
NO.	DESCRIPTION	BY	CHK'D	APP'D	DATE								
REVISIONS / ISSUE AUTHORIZATION										PR. ENG. / PR. TECH.			
										NAME: A ELLMER		DATE	
										SIGNATURE		080604	
This Document including all design and information therein is Confidential Intellectual Property of Transnet and/or HMG JV. Copyright and all other rights are reserved by Transnet and/or HMG JV. This Document may only be used for its intended purpose.										REG. NUMBER: 780374			
										SCALE:		OR AS NOTED	

503516-PEP-ST-01									
									
PORT OF NGQURA – PORT INFRASTRUCTURE									
PORT BUILDINGS : (NPA)									
PORT ENTRANCE PLAZA									
NORTH ENTRANCE CANOPY									
STEEL & CONCRETE LAYOUTS & DETAILS (1 of 2)									
PROJECT NUMBER	DVI	FBS	DIS	TYPE	DRG. NO.	SHT.	REV.	ID	
H500204	1	124	C	DE	0008	01	04	TP	
SIZE:A1 DATE: \$DATE\$									